


repairs to 54, 2019



Marked in black, location of Bay windows to be replaced (one above another)

Marked in red:
All external elevations to be scaffolded & windows repaired plus access required from the street and courtyards of two neighbours (54A Tavant St. and 61 Maltravers St.)

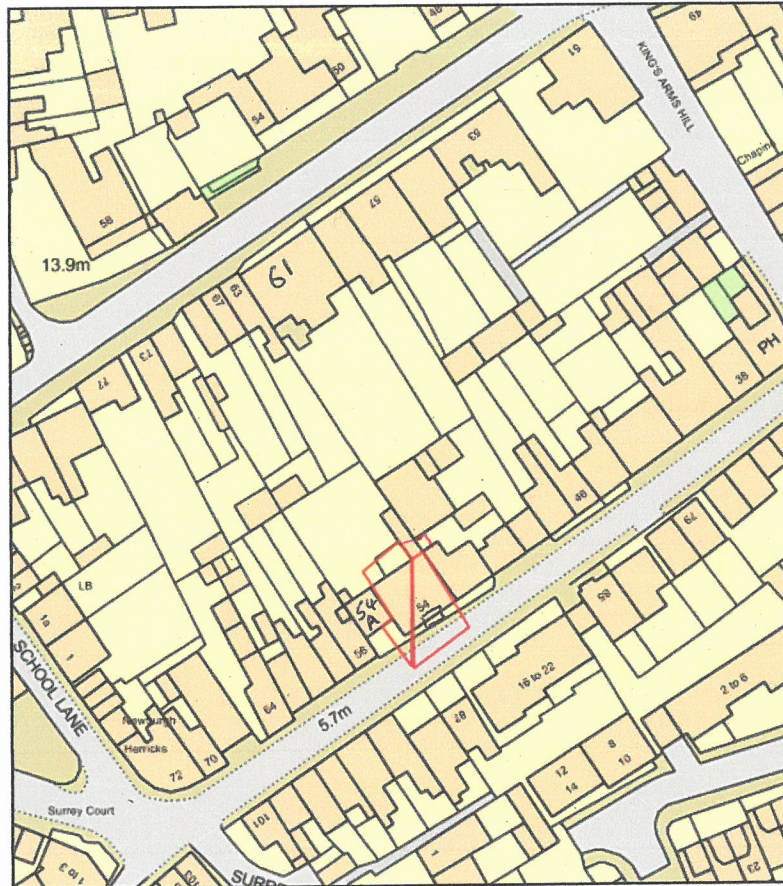

0 50
Metres



Plan Produced for: Andy Waite & Karine Suhrbier
Date Produced: 03 Aug 2018
Plan Reference Number: TQRQM18215135006978
Scale: 1:1250 @ A4