


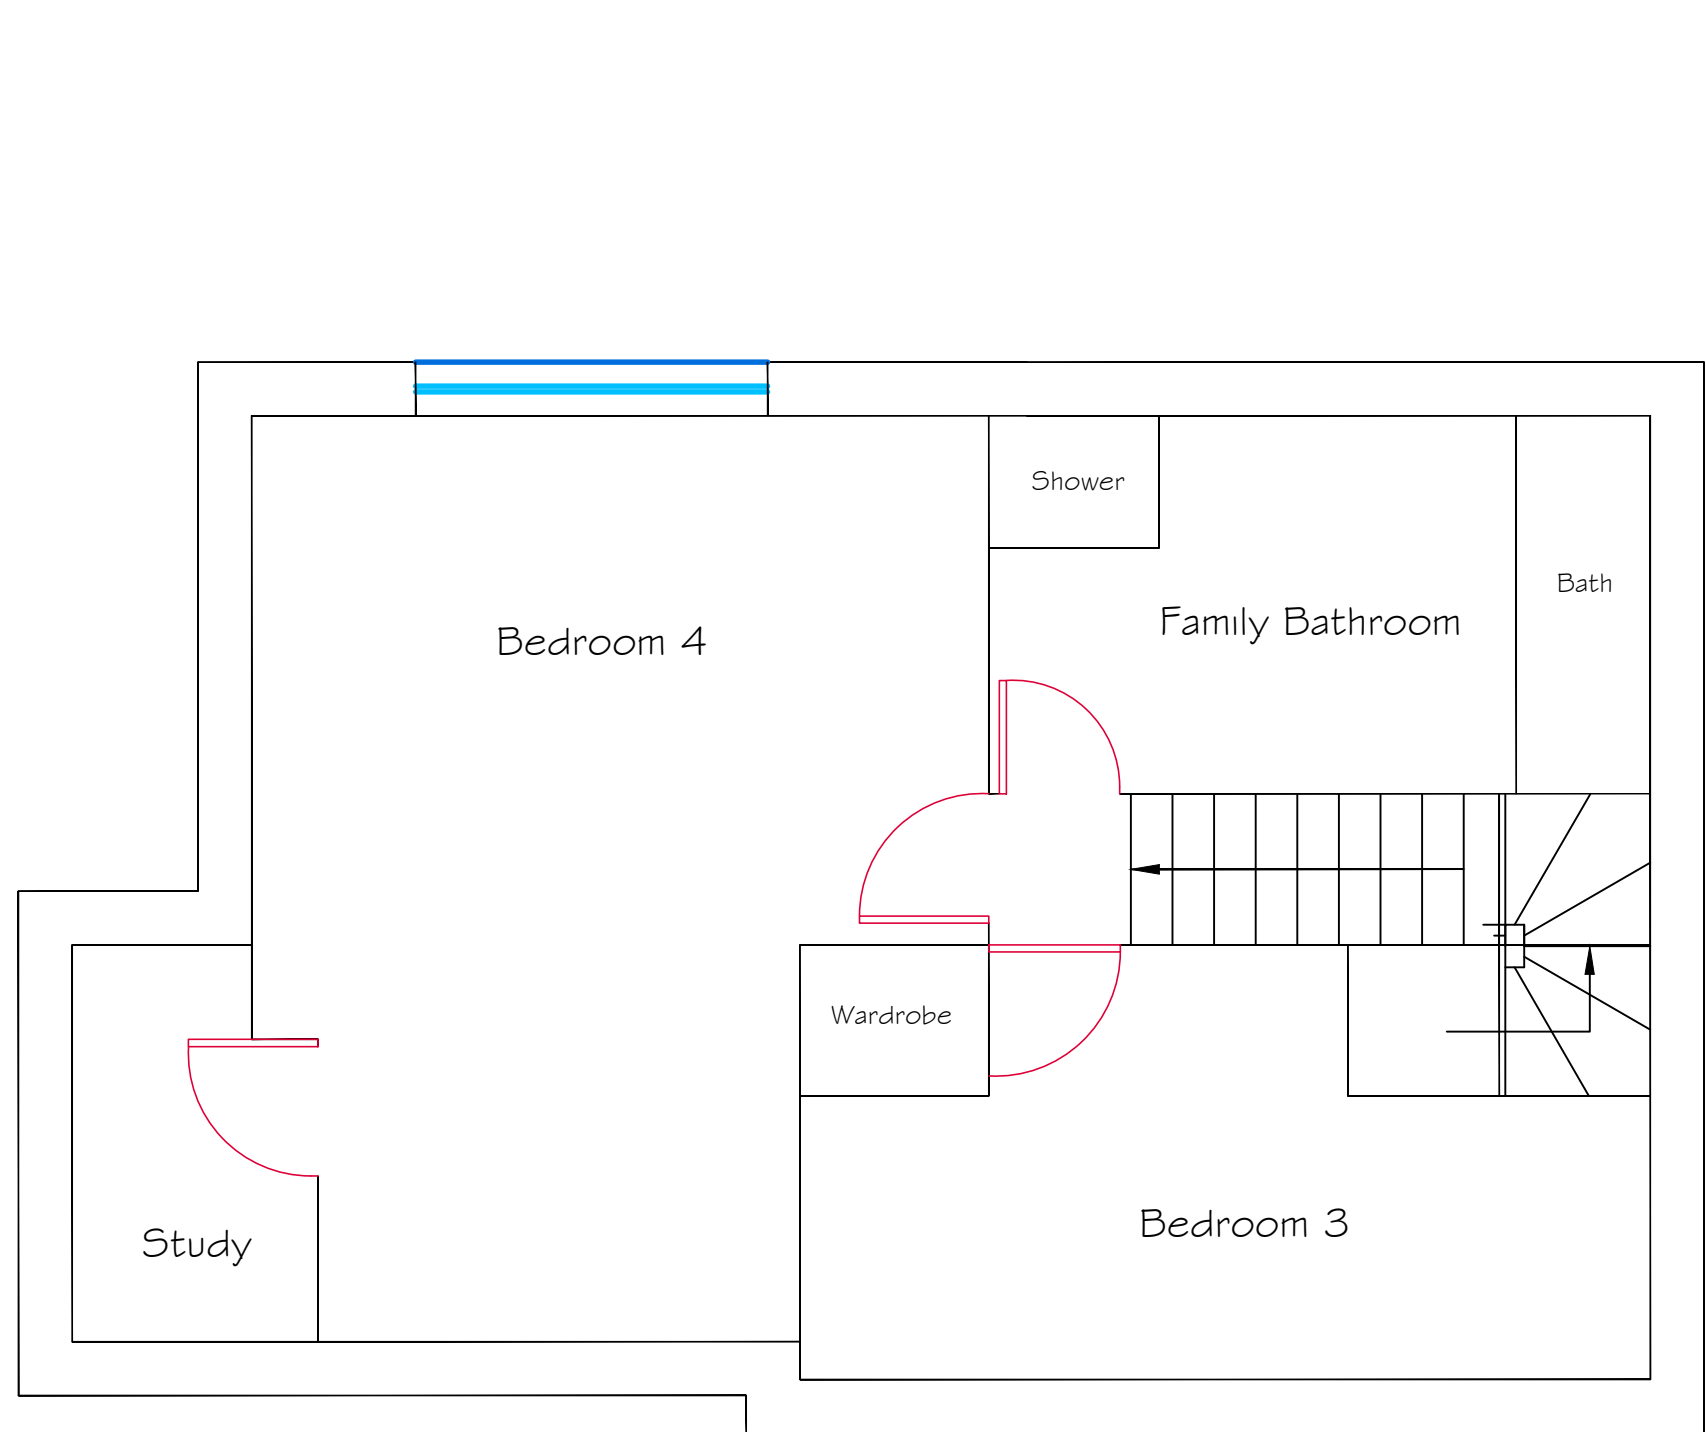


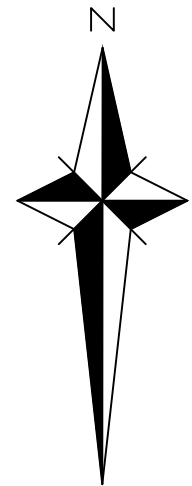

Existing 1st Floor Plan

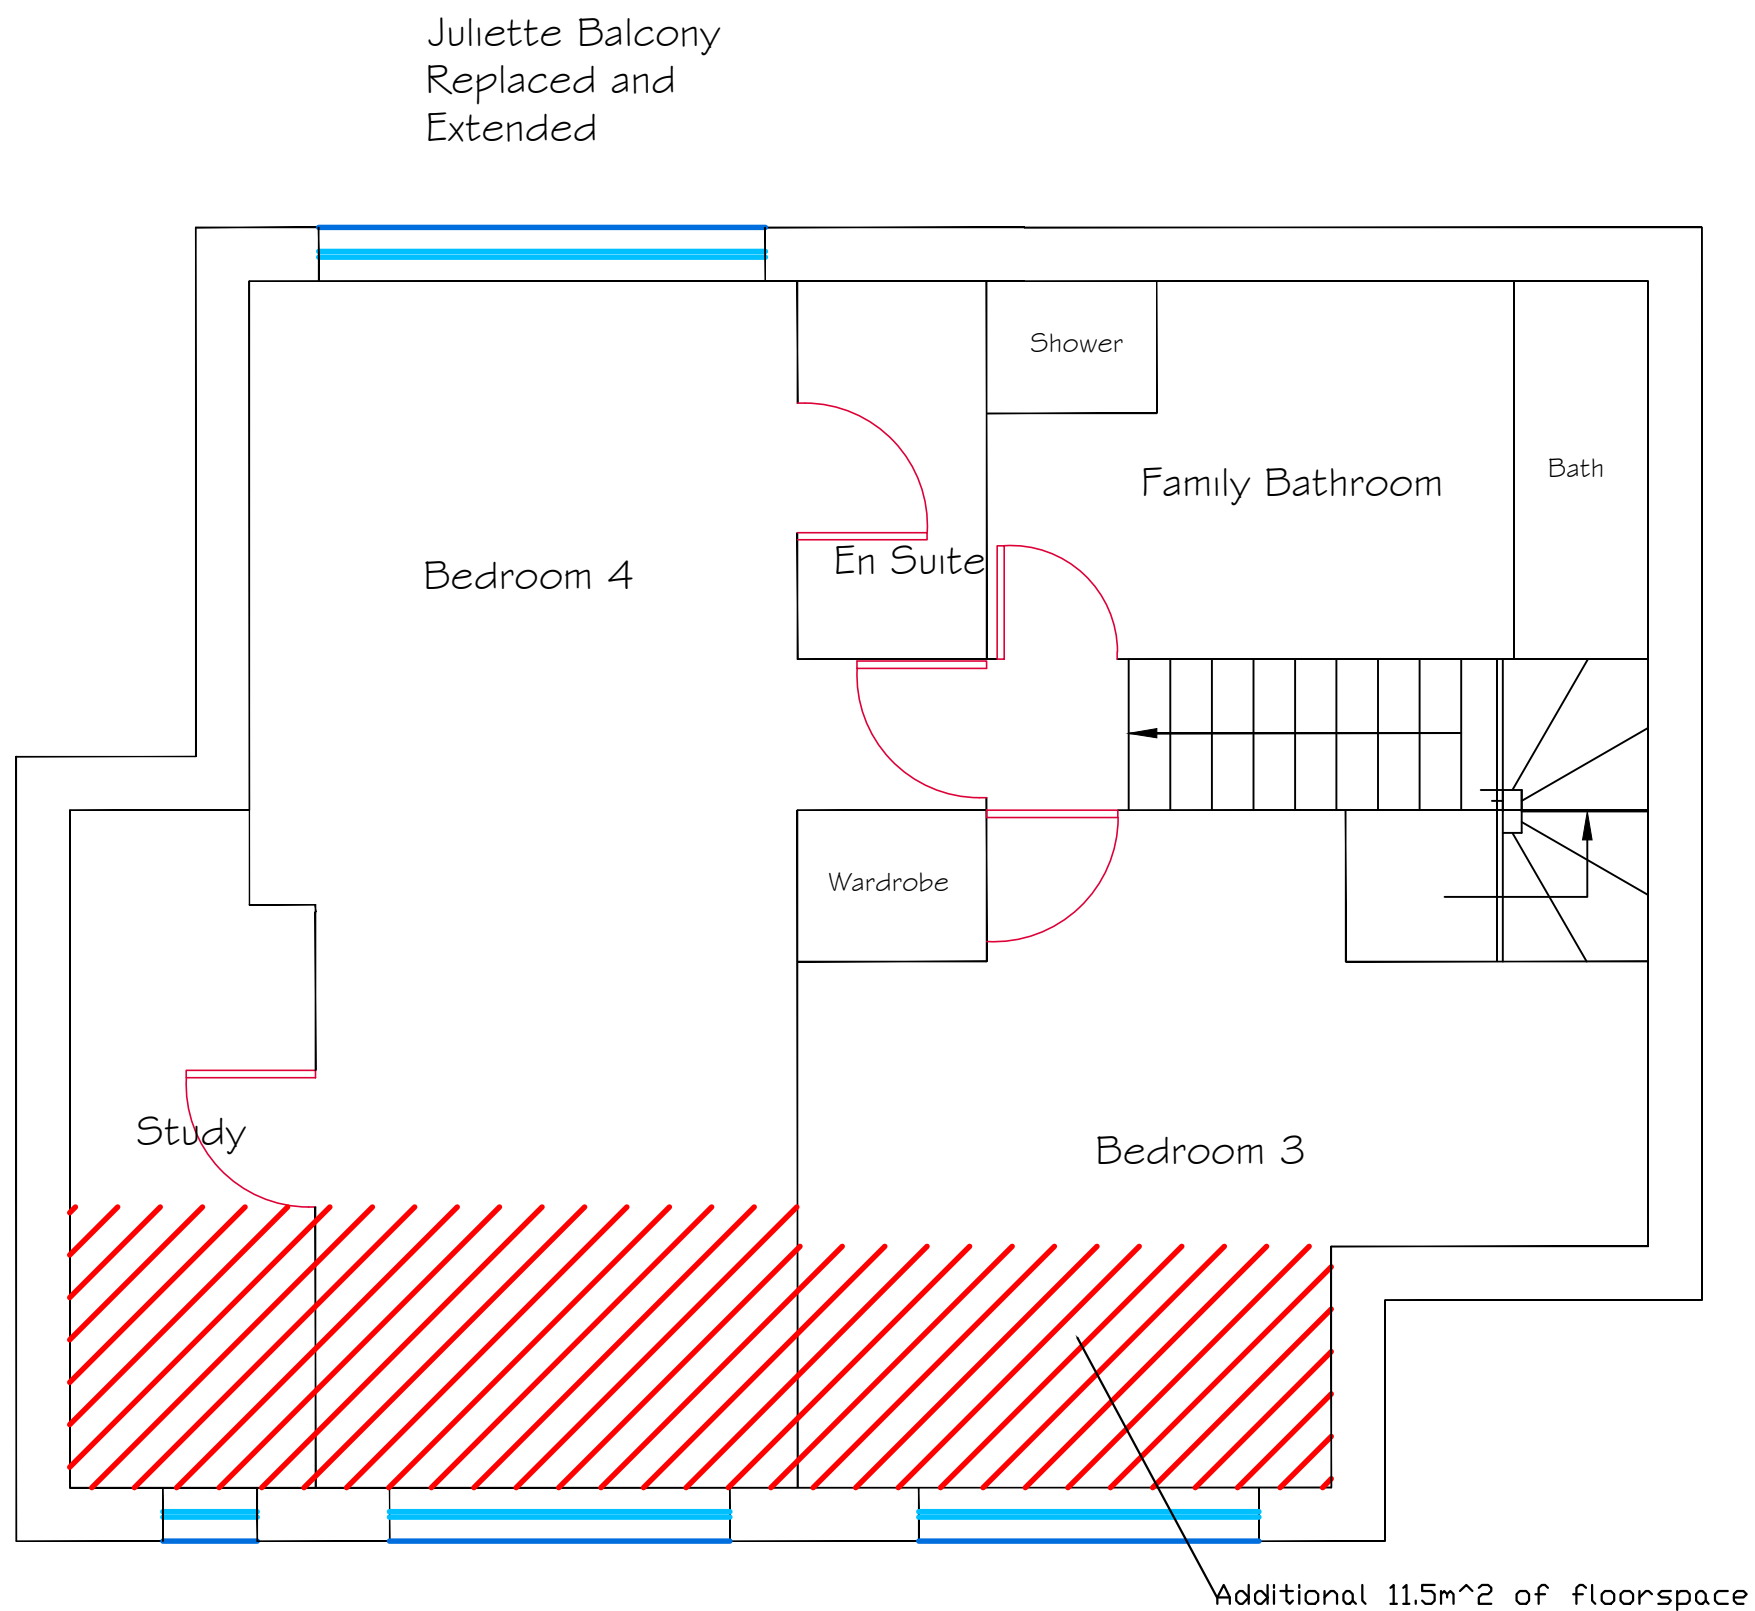

Proposed 1st Floor Plan

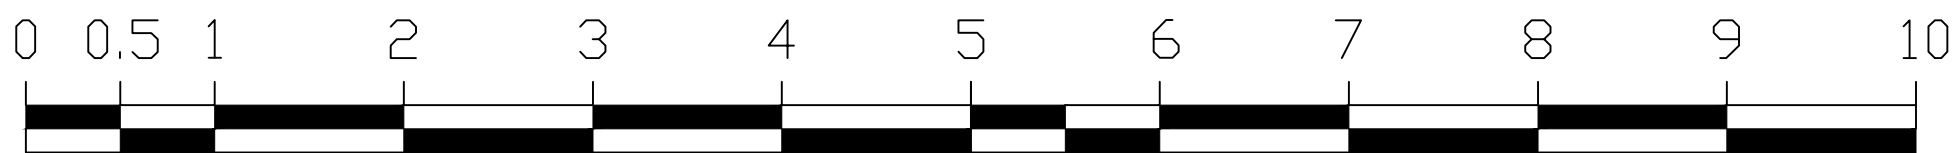

SCALE 1:50

- GENERAL NOTES
1. The location, size, depth and identification of existing services that may be shown or referred to on this drawing have been assessed from non intrusive observations , record drawings or the like. The contractor shall safely carry out intrusive investigations, trial holes or soundings prior to commencing work to satisfy himself that it is safe to proceed and that the assessments are accurate. any discrepancies shall be notified to gta prior to works commencing.
 2. Tender or billing drawings shall not be used for construction or the ordering of materials.
 3. Do not scale. All dimensions and levels to be site confirmed.
 4. This drawing shall be read in conjunction with all relevant architects, consultants drawings and specifications, together with H&S plan requirements
 5. Copyright : This drawing must not be copied, amended nor reproduced without the prior written agreement of gta.
 6. All drawings specifications and recommendations made by gta are subject to Local Authority and other relevant Statutory Authorities approval. Any works or services made abortive due to the client proceeding prior to these approvals is considered wholly at the Clients risk. gta hold no responsibility for resulting abortive works or costs.

B	Amended as per Comments	08.11.2018	ART	LS	
A	Amended as per Comments	08.08.2018	ART	LS	
-	INITIAL ISSUE	06.08.2018	ART	LS	
Rev	Amendments	Date	Dsn	Chk	
Status					
PRELIMINARY					
Client					
Architect					
Project					
PROPOSED FIRST FLOOR					
Title					
42 FITZALAN ROAD ARUNDEL					
Date		Scale @ A1			
JUL 2018		1:40			
Clients Ref.		Project Ref.			
 Gloucester House, 66a Church Walk, Burgess Hill, West Sussex, RH15 9AS Tel:01444 871444 Fax:01444 871401 Web: www.gtacivils.co.uk					
Drawing Number				Rev.	
101				A	