


Notes

THIS DRAWING IS THE COPYRIGHT OF VIVID DESIGN STUDIO LTD AND MUST NOT BE COPIED, ALTERED OR REPRODUCED IN ANY WAY NEITHER PASSED TO A THIRD PARTY WITHOUT THEIR WRITTEN PERMISSION.

DIMENSIONS TO BE CHECKED ON SITE BEFORE COMMENCING WORK AND ANY DISCREPANCIES SHALL BE REPORTED TO THE DESIGNER. FIGURED DIMENSIONS MUST BE TAKEN IN PREFERENCE TO SCALED DIMENSIONS.


| Rev:- | Description:-                                  | Date:-   | Chkd by:- |
|-------|------------------------------------------------|----------|-----------|
| A     | Amended courtyard boundaries to match red line | 18/01/21 |           |

Red line matches site plans as ownership of the site

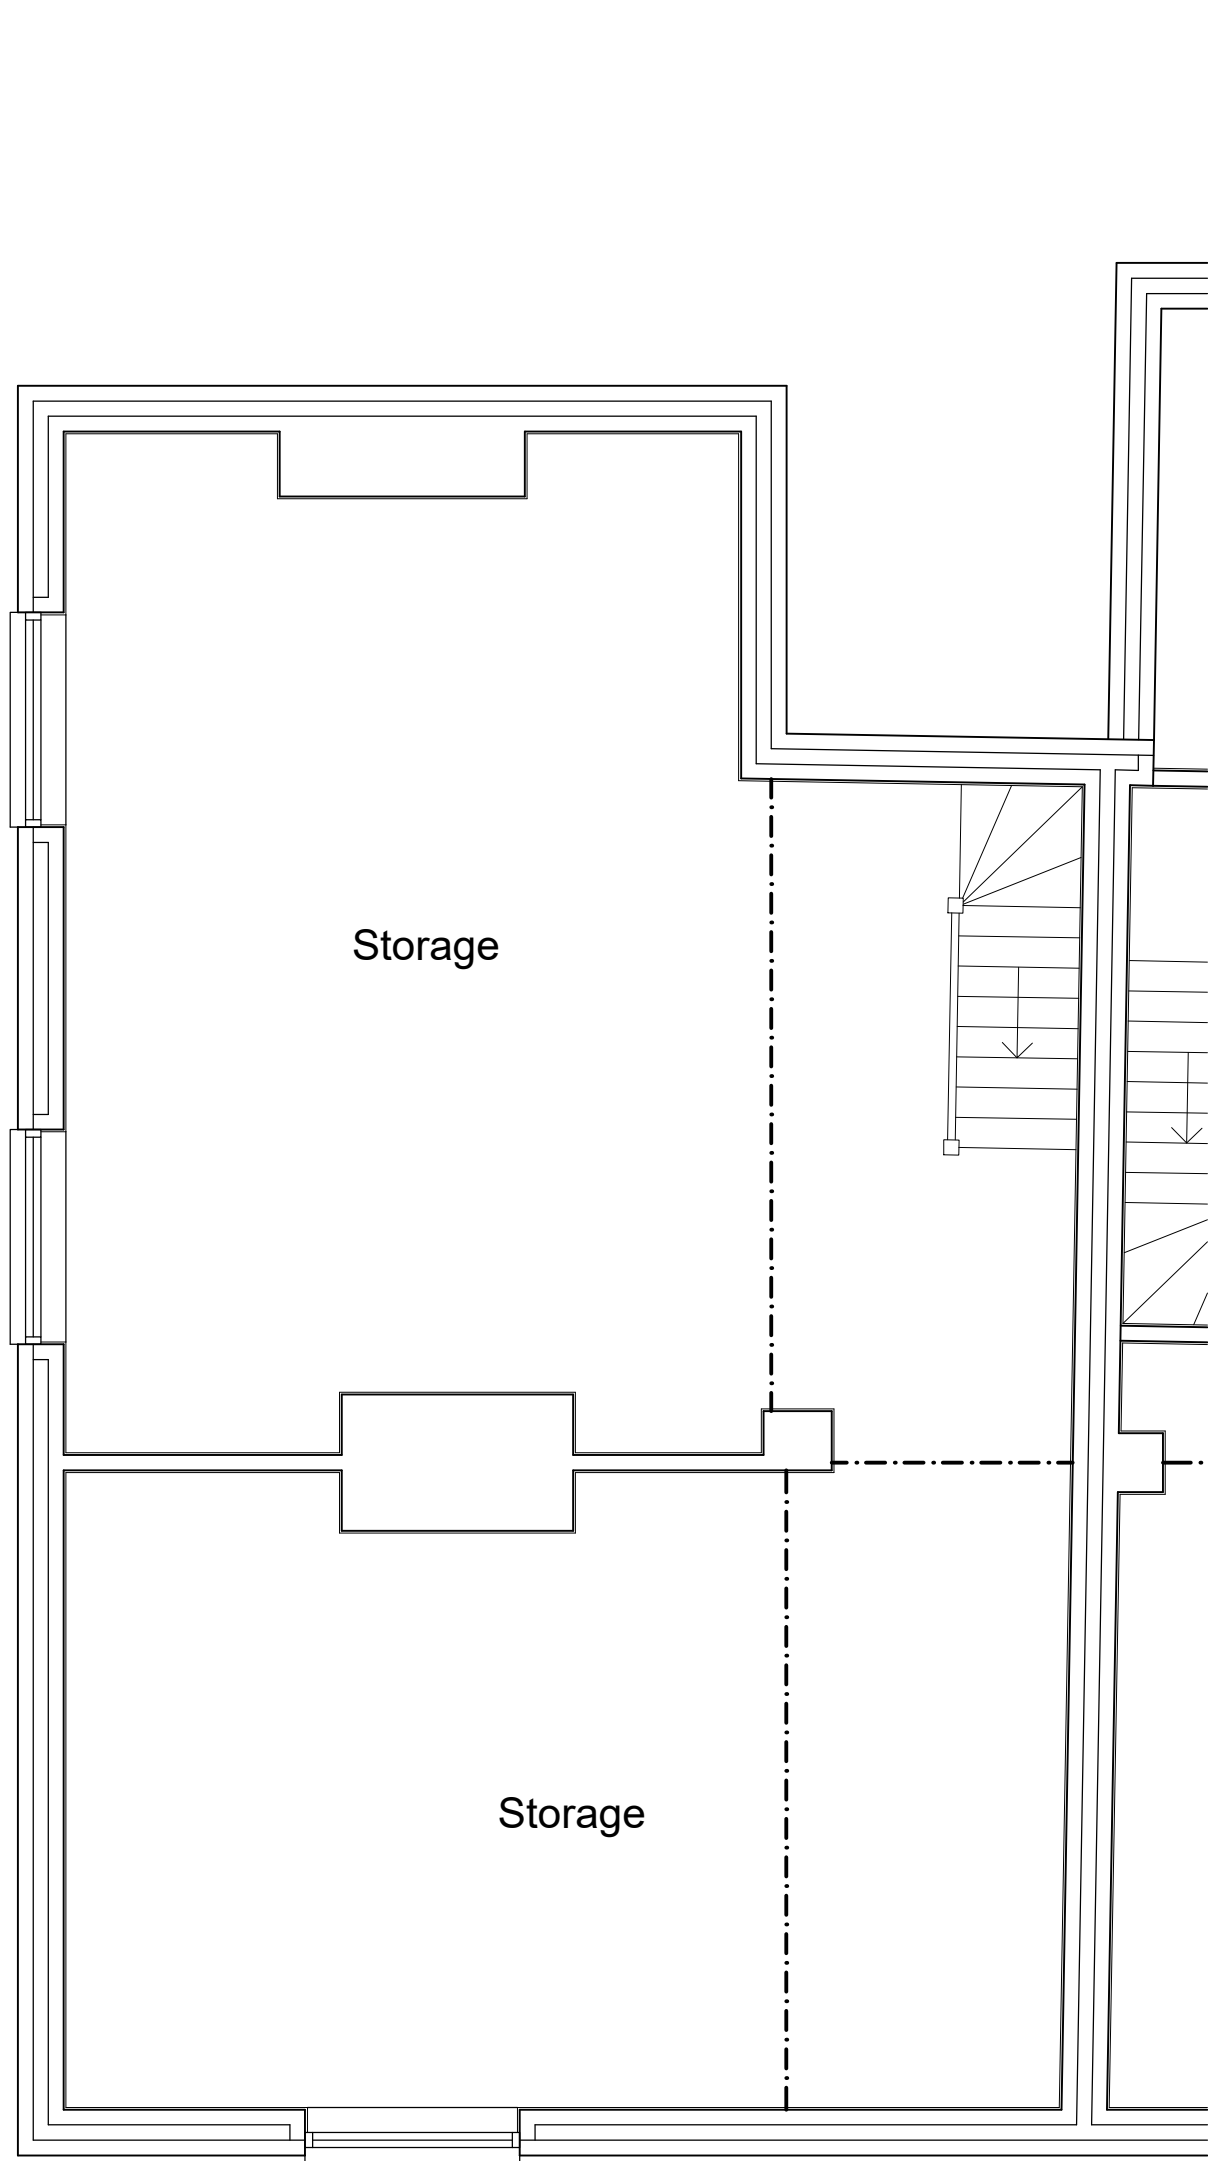


No.1

PROPOSED BASEMENT FLOOR PLAN (1:50)

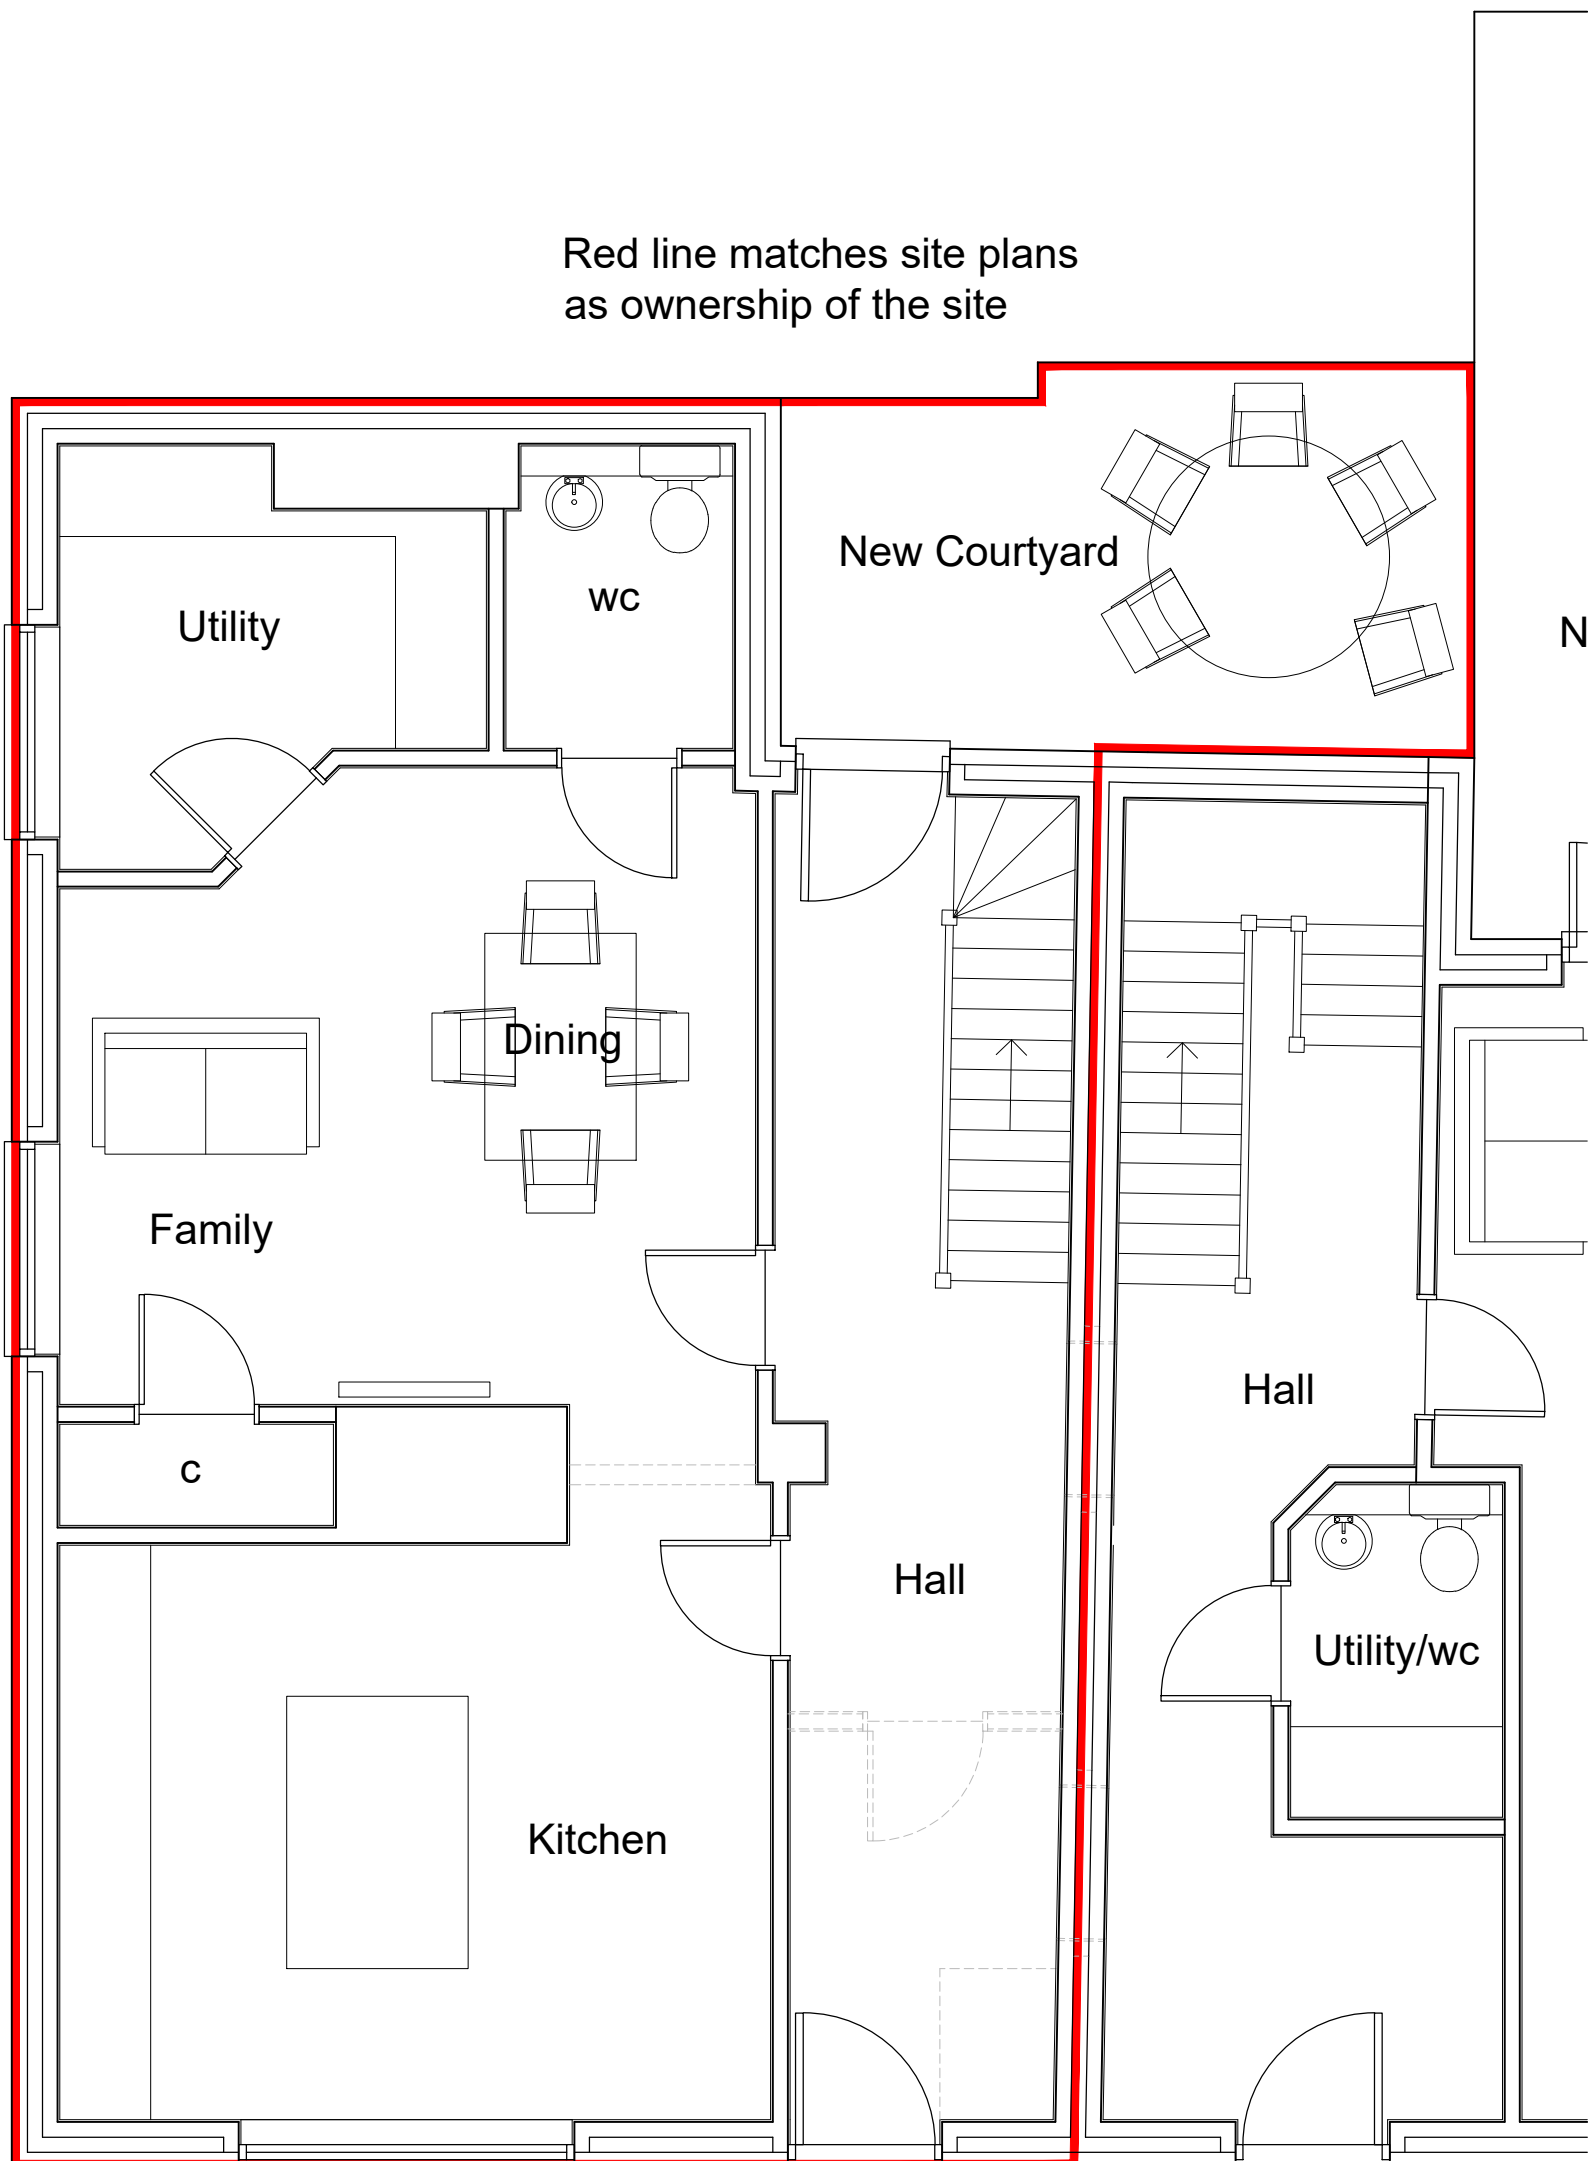

No.1

PROPOSED GROUND FLOOR PLAN (1:50)

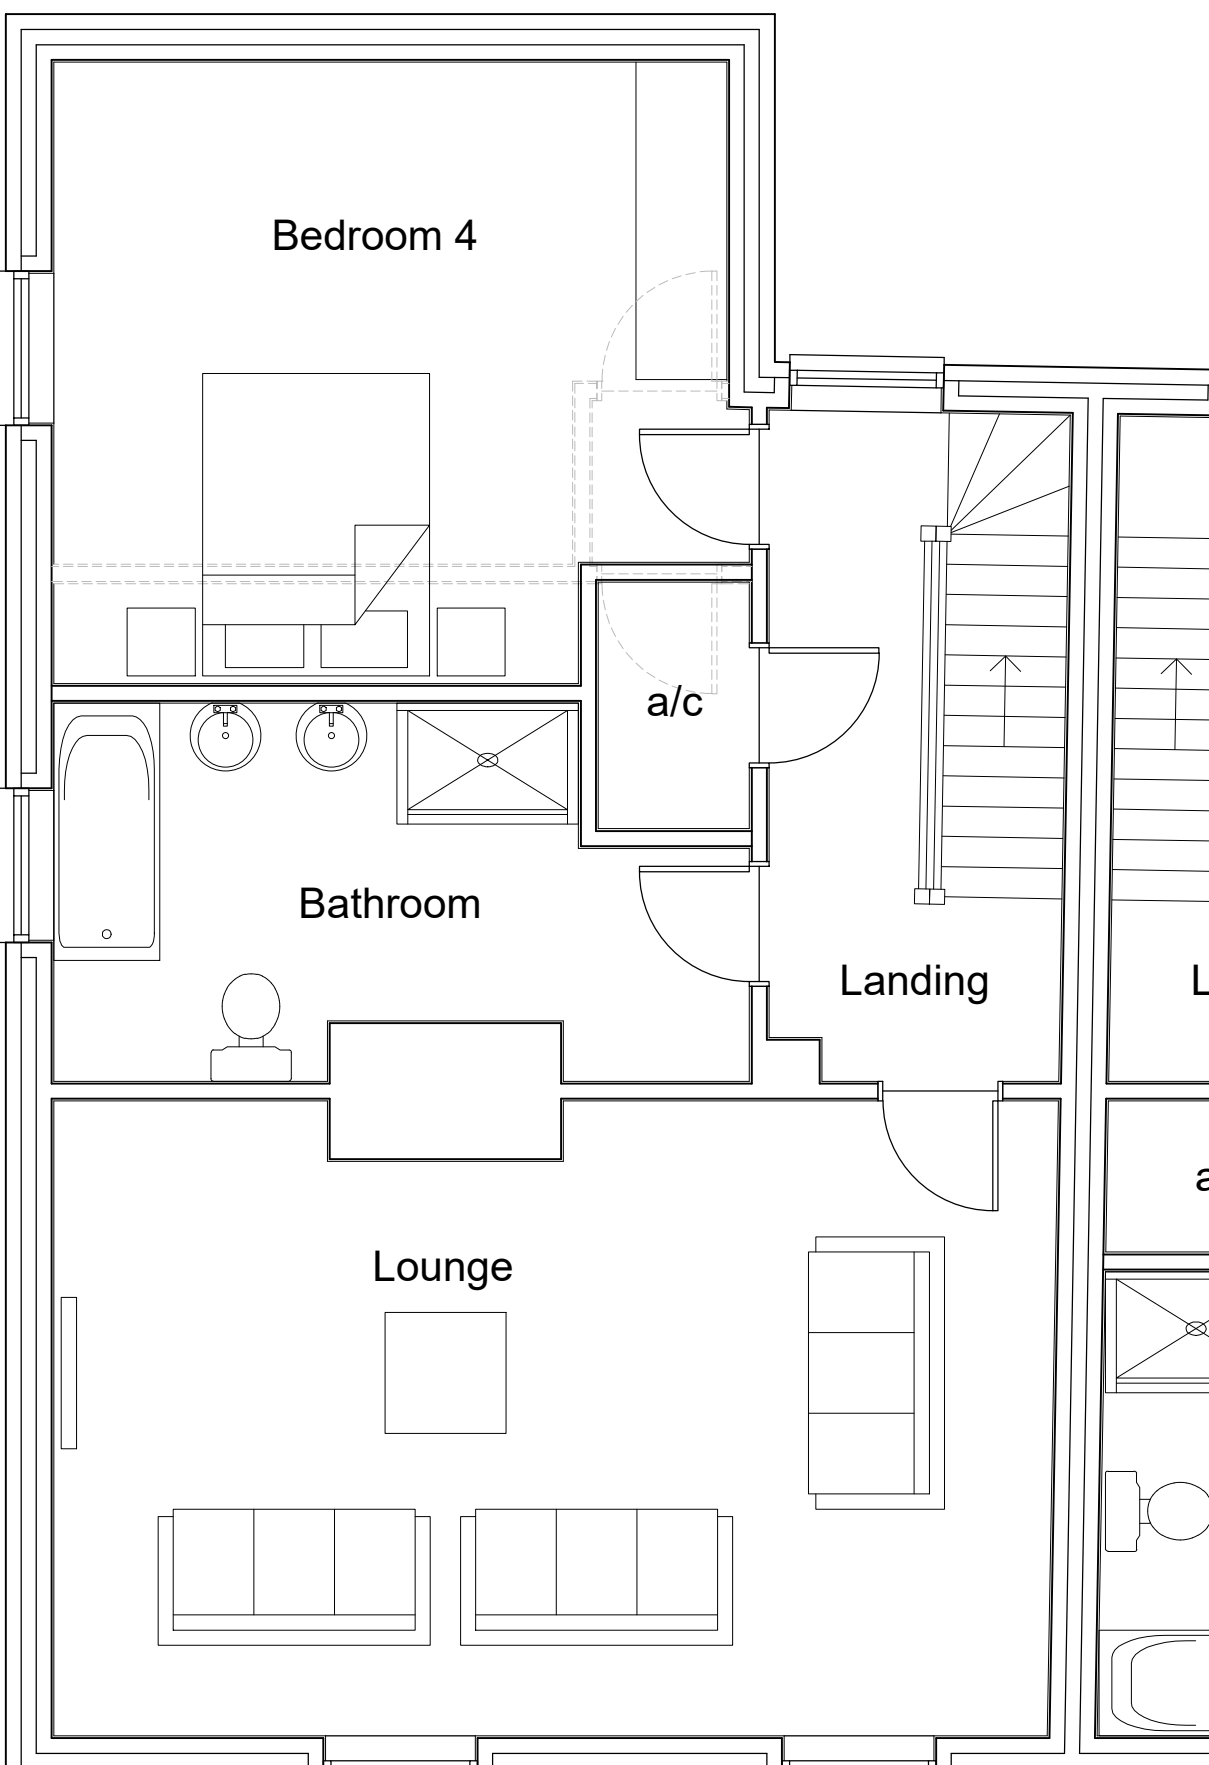

No.1

PROPOSED FIRST FLOOR PLAN (1:50)




No.1

PROPOSED SECOND FLOOR PLAN (1:50)



The Barn, Calcot Mount Business Park, Calcot Lane, Curdridge, Southampton, Hampshire, SO32 2BN  
Tel: 01489 786670  
Email: info@vividdesignstudio.co.uk  
Website: www.vividdesignstudio.co.uk

|              |                                                           |
|--------------|-----------------------------------------------------------|
| Project:-    | Old Bank House<br>1 High Street<br>Arundel<br>West Sussex |
| Title:-      | Proposed Floor Plans                                      |
| Client:-     | Moor Construction Ltd                                     |
| Scale:-      | 1:50 (@A1)                                                |
| Drawn By:-   | PJD                                                       |
| Checked By:- | PJD                                                       |
| Date:-       | 10/11/20                                                  |
| Date:-       | 10/11/20                                                  |
| Job.No:-     | 200042                                                    |
| Drg.No:-     | 06                                                        |
| Rev:-        | A                                                         |

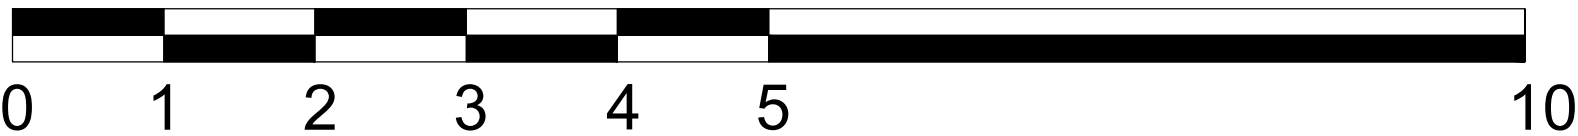

SCALE BAR 1:50