



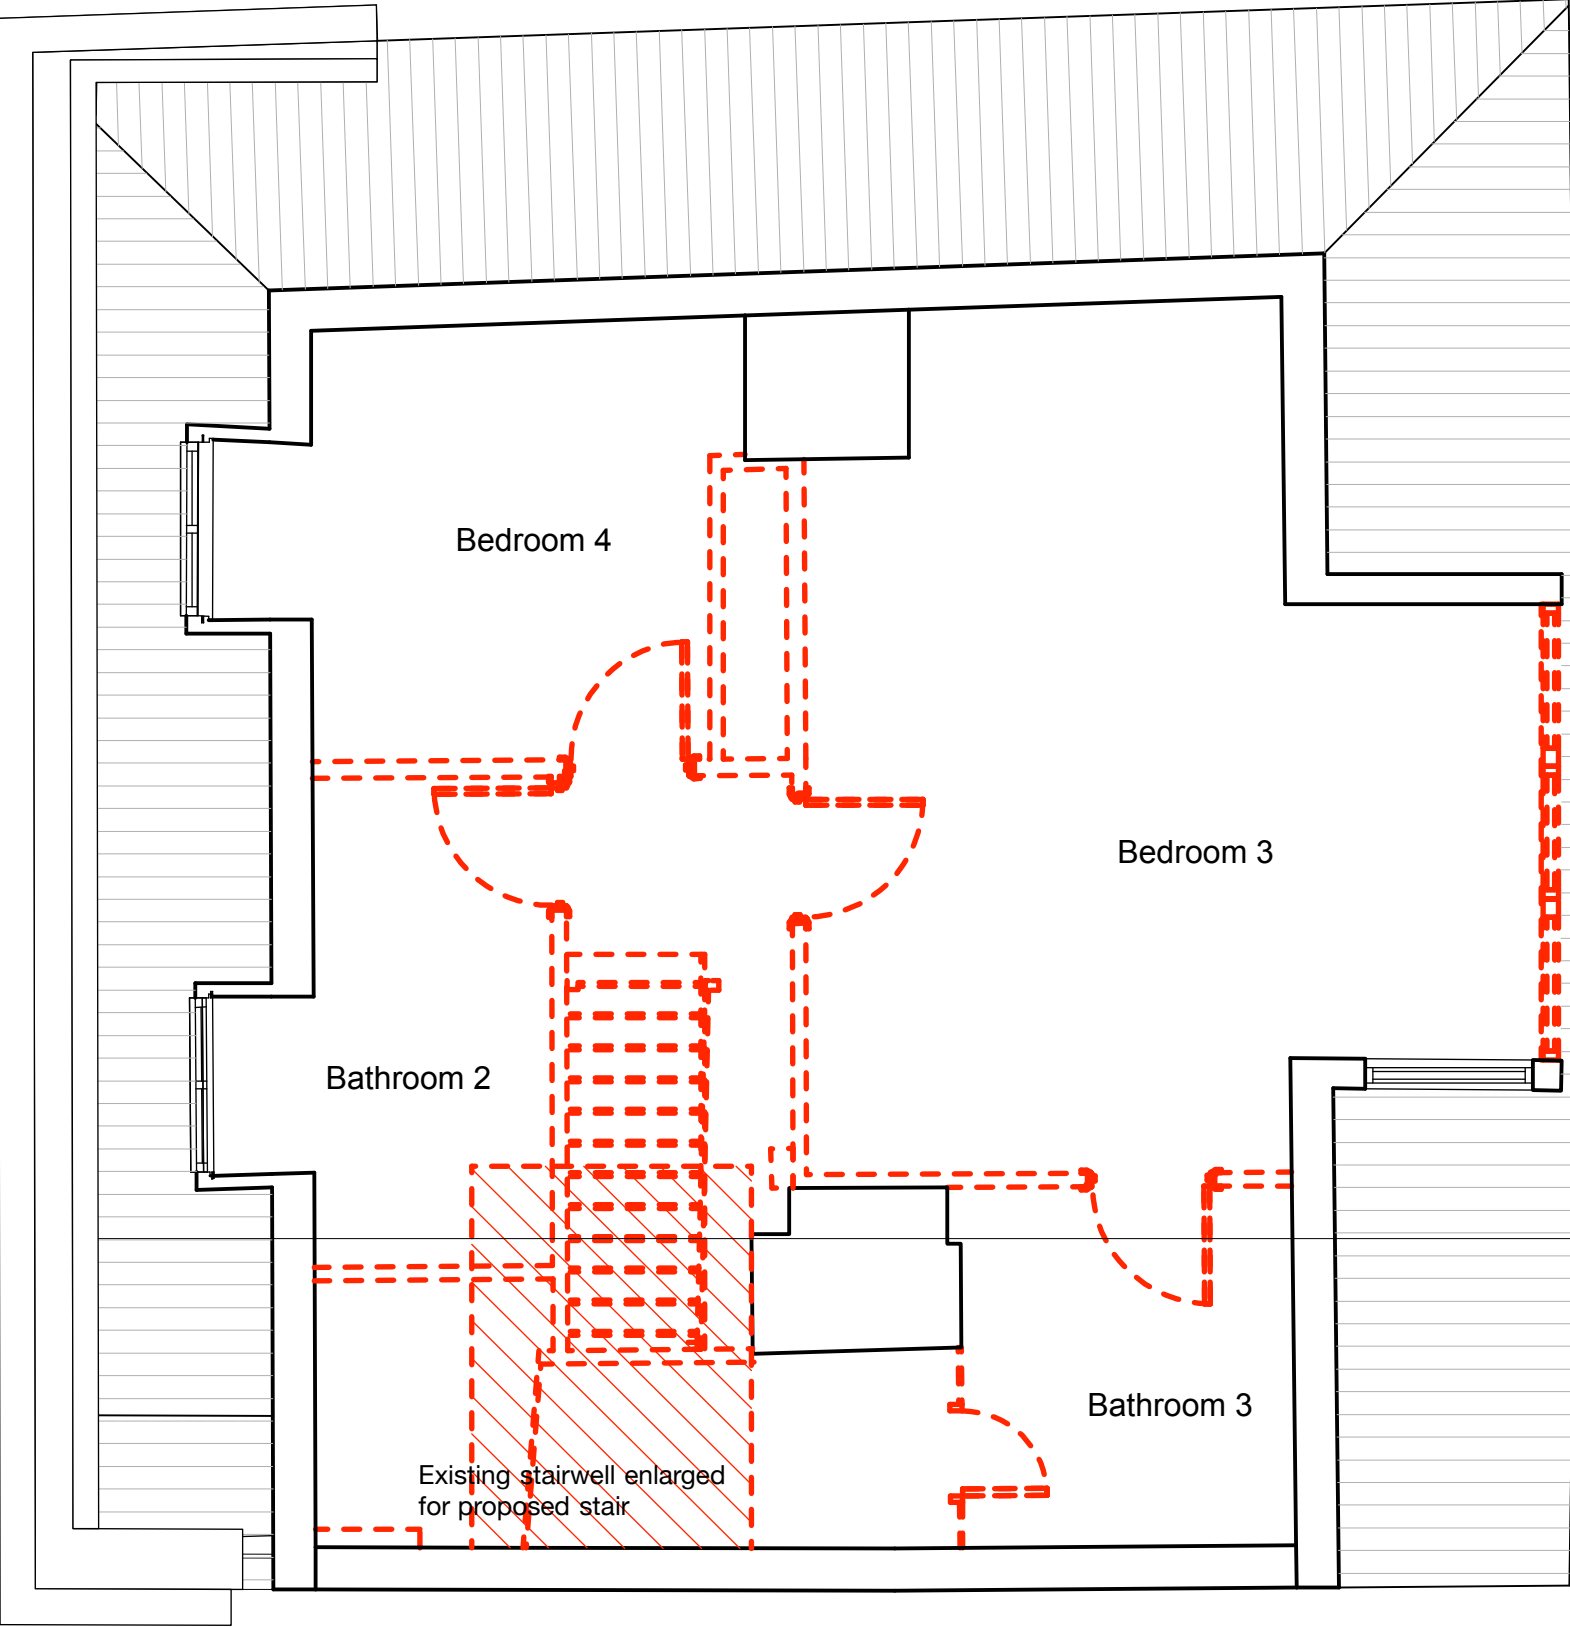

Key:

Demolitions

Removal of Floor

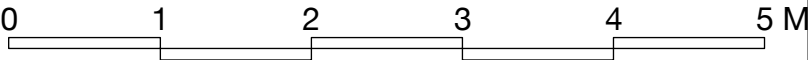

- GENERAL NOTES
- This drawing is the copyright of Haines Phillips Architects.
 - Do not scale from this drawing. Use figured dimensions only.
 - This drawing must not be used for land transfer purposes, or for construction purposes unless accompanied by an Architect's Instruction.

DRAWING ISSUE STATUS		
ISSUE	STATUS	COMMENT
P	PRELIMINARY	For comment and review
PL	PLANNING	Planning/Listed Building Application
BR	BUILDING REGS	Building Regs Application
T	TENDER	For pricing purposes only
C	CONSTRUCTION	For procurement & construction
FC	FINAL CONSTRUCTION	Record drawings on completion
L	LEGAL	Conveyancing or other legal purposes

REVISIONS		
REV	DATE	NOTES

HAINES
PHILLIPS
ARCHITECTS

Tankerton Works

12 Argyle Walk

London WC1H 8HA

t

020 7833 9324

f

020 7837 2864

e

office@hainesphillips.co.uk

JOB TITLE

31 Maltravers Street, Arundel

DRAWING TITLE

Attic Plan
Demolitions

DRAWN

PC

DATE

18.11.19

SCALE

1:50@A3

JOB NR

4120

DRAWING NO.

DM 006

ISSUE

PL

REVISION