


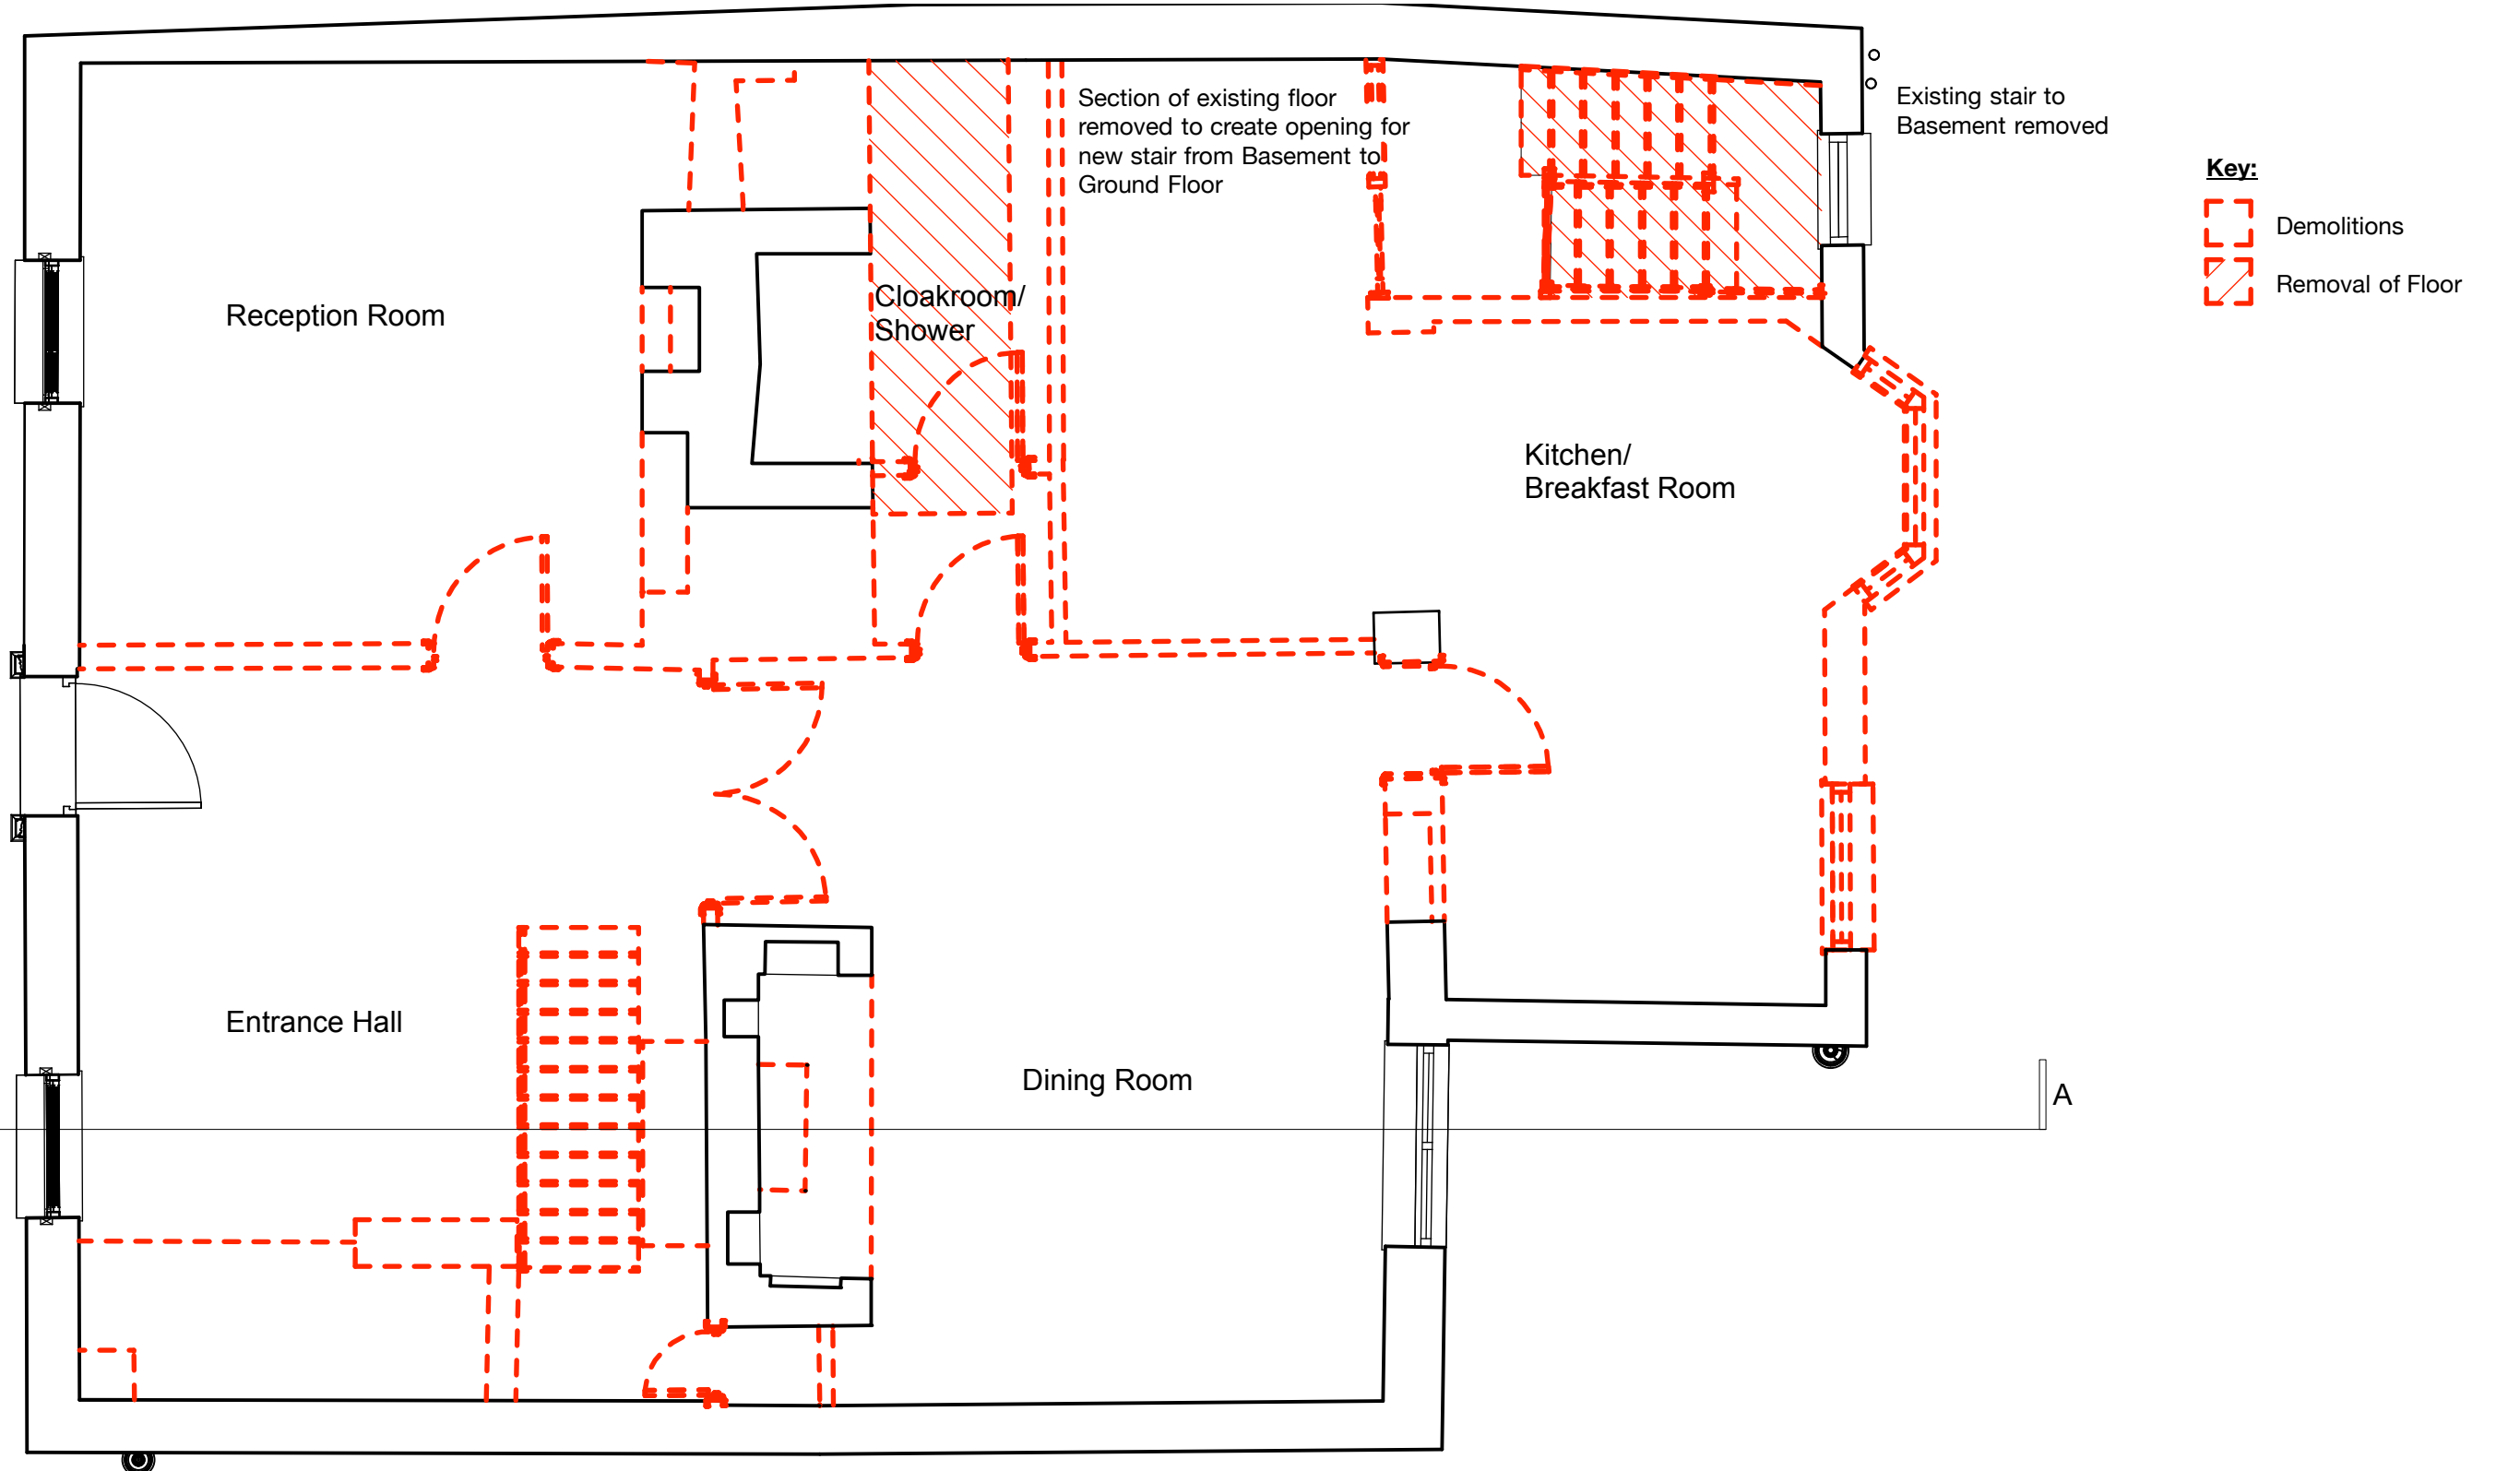

Key:

 Demolitions

 Removal of Floor

GENERAL NOTES - This drawing is the copyright of Haines Phillips Architects. - Do not scale from this drawing. Use figured dimensions only. - This drawing must not be used for land transfer purposes, or for construction purposes unless accompanied by an Architect's Instruction.	DRAWING ISSUE STATUS <table><thead><tr><th>ISSUE</th><th>STATUS</th><th>COMMENT</th></tr></thead><tbody><tr><td>P</td><td>PRELIMINARY</td><td>For comment and review</td></tr><tr><td>PL</td><td>PLANNING</td><td>Planning/Listed Building Application</td></tr><tr><td>BR</td><td>BUILDING REGS</td><td>Building Regs Application</td></tr><tr><td>T</td><td>TENDER</td><td>For pricing purposes only</td></tr><tr><td>C</td><td>CONSTRUCTION</td><td>For procurement & construction</td></tr><tr><td>FC</td><td>FINAL CONSTRUCTION</td><td>Record drawings on completion</td></tr><tr><td>L</td><td>LEGAL</td><td>Conveyancing or other legal purposes</td></tr></tbody></table>	ISSUE	STATUS	COMMENT	P	PRELIMINARY	For comment and review	PL	PLANNING	Planning/Listed Building Application	BR	BUILDING REGS	Building Regs Application	T	TENDER	For pricing purposes only	C	CONSTRUCTION	For procurement & construction	FC	FINAL CONSTRUCTION	Record drawings on completion	L	LEGAL	Conveyancing or other legal purposes	REVISIONS <table><thead><tr><th>REV</th><th>DATE</th><th>NOTES</th></tr></thead><tbody></tbody></table>	REV	DATE	NOTES	HAINES PHILLIPS ARCHITECTS Tankerton Works 12 Argyle Walk London WC1H 8HA  020 7833 9324  020 7837 2864  office@hainesphillips.co.uk	JOB TITLE 31 Maltravers Street, Arundel DRAWING TITLE Ground Floor Plan Demolitions <table><thead><tr><th>DRAWN</th><th>DATE</th><th>SCALE</th></tr></thead><tbody><tr><td>PC</td><td>18.11.19</td><td>1:50@A3</td></tr></tbody></table> <table><thead><tr><th>JOB NR</th><th>DRAWING NO.</th><th>ISSUE</th><th>REVISION</th></tr></thead><tbody><tr><td>4120</td><td>DM 004</td><td>PL</td><td></td></tr></tbody></table>	DRAWN	DATE	SCALE	PC	18.11.19	1:50@A3	JOB NR	DRAWING NO.	ISSUE	REVISION	4120	DM 004	PL	
ISSUE	STATUS	COMMENT																																											
P	PRELIMINARY	For comment and review																																											
PL	PLANNING	Planning/Listed Building Application																																											
BR	BUILDING REGS	Building Regs Application																																											
T	TENDER	For pricing purposes only																																											
C	CONSTRUCTION	For procurement & construction																																											
FC	FINAL CONSTRUCTION	Record drawings on completion																																											
L	LEGAL	Conveyancing or other legal purposes																																											
REV	DATE	NOTES																																											
DRAWN	DATE	SCALE																																											
PC	18.11.19	1:50@A3																																											
JOB NR	DRAWING NO.	ISSUE	REVISION																																										
4120	DM 004	PL																																											