


- Health & Safety**
It is the responsibility of the Client to ensure compliance with the Construction (Design & Management) Regulations 2015. The Regulations impose obligations and responsibilities on Clients, Designers and Contractors. Additional responsibilities are imposed on those acting as Principal Designer, Principal Contractor, Designer and Contractor. Additional information regarding the obligations and responsibilities can be discussed with Caldotec Ltd or the Principal Designer.

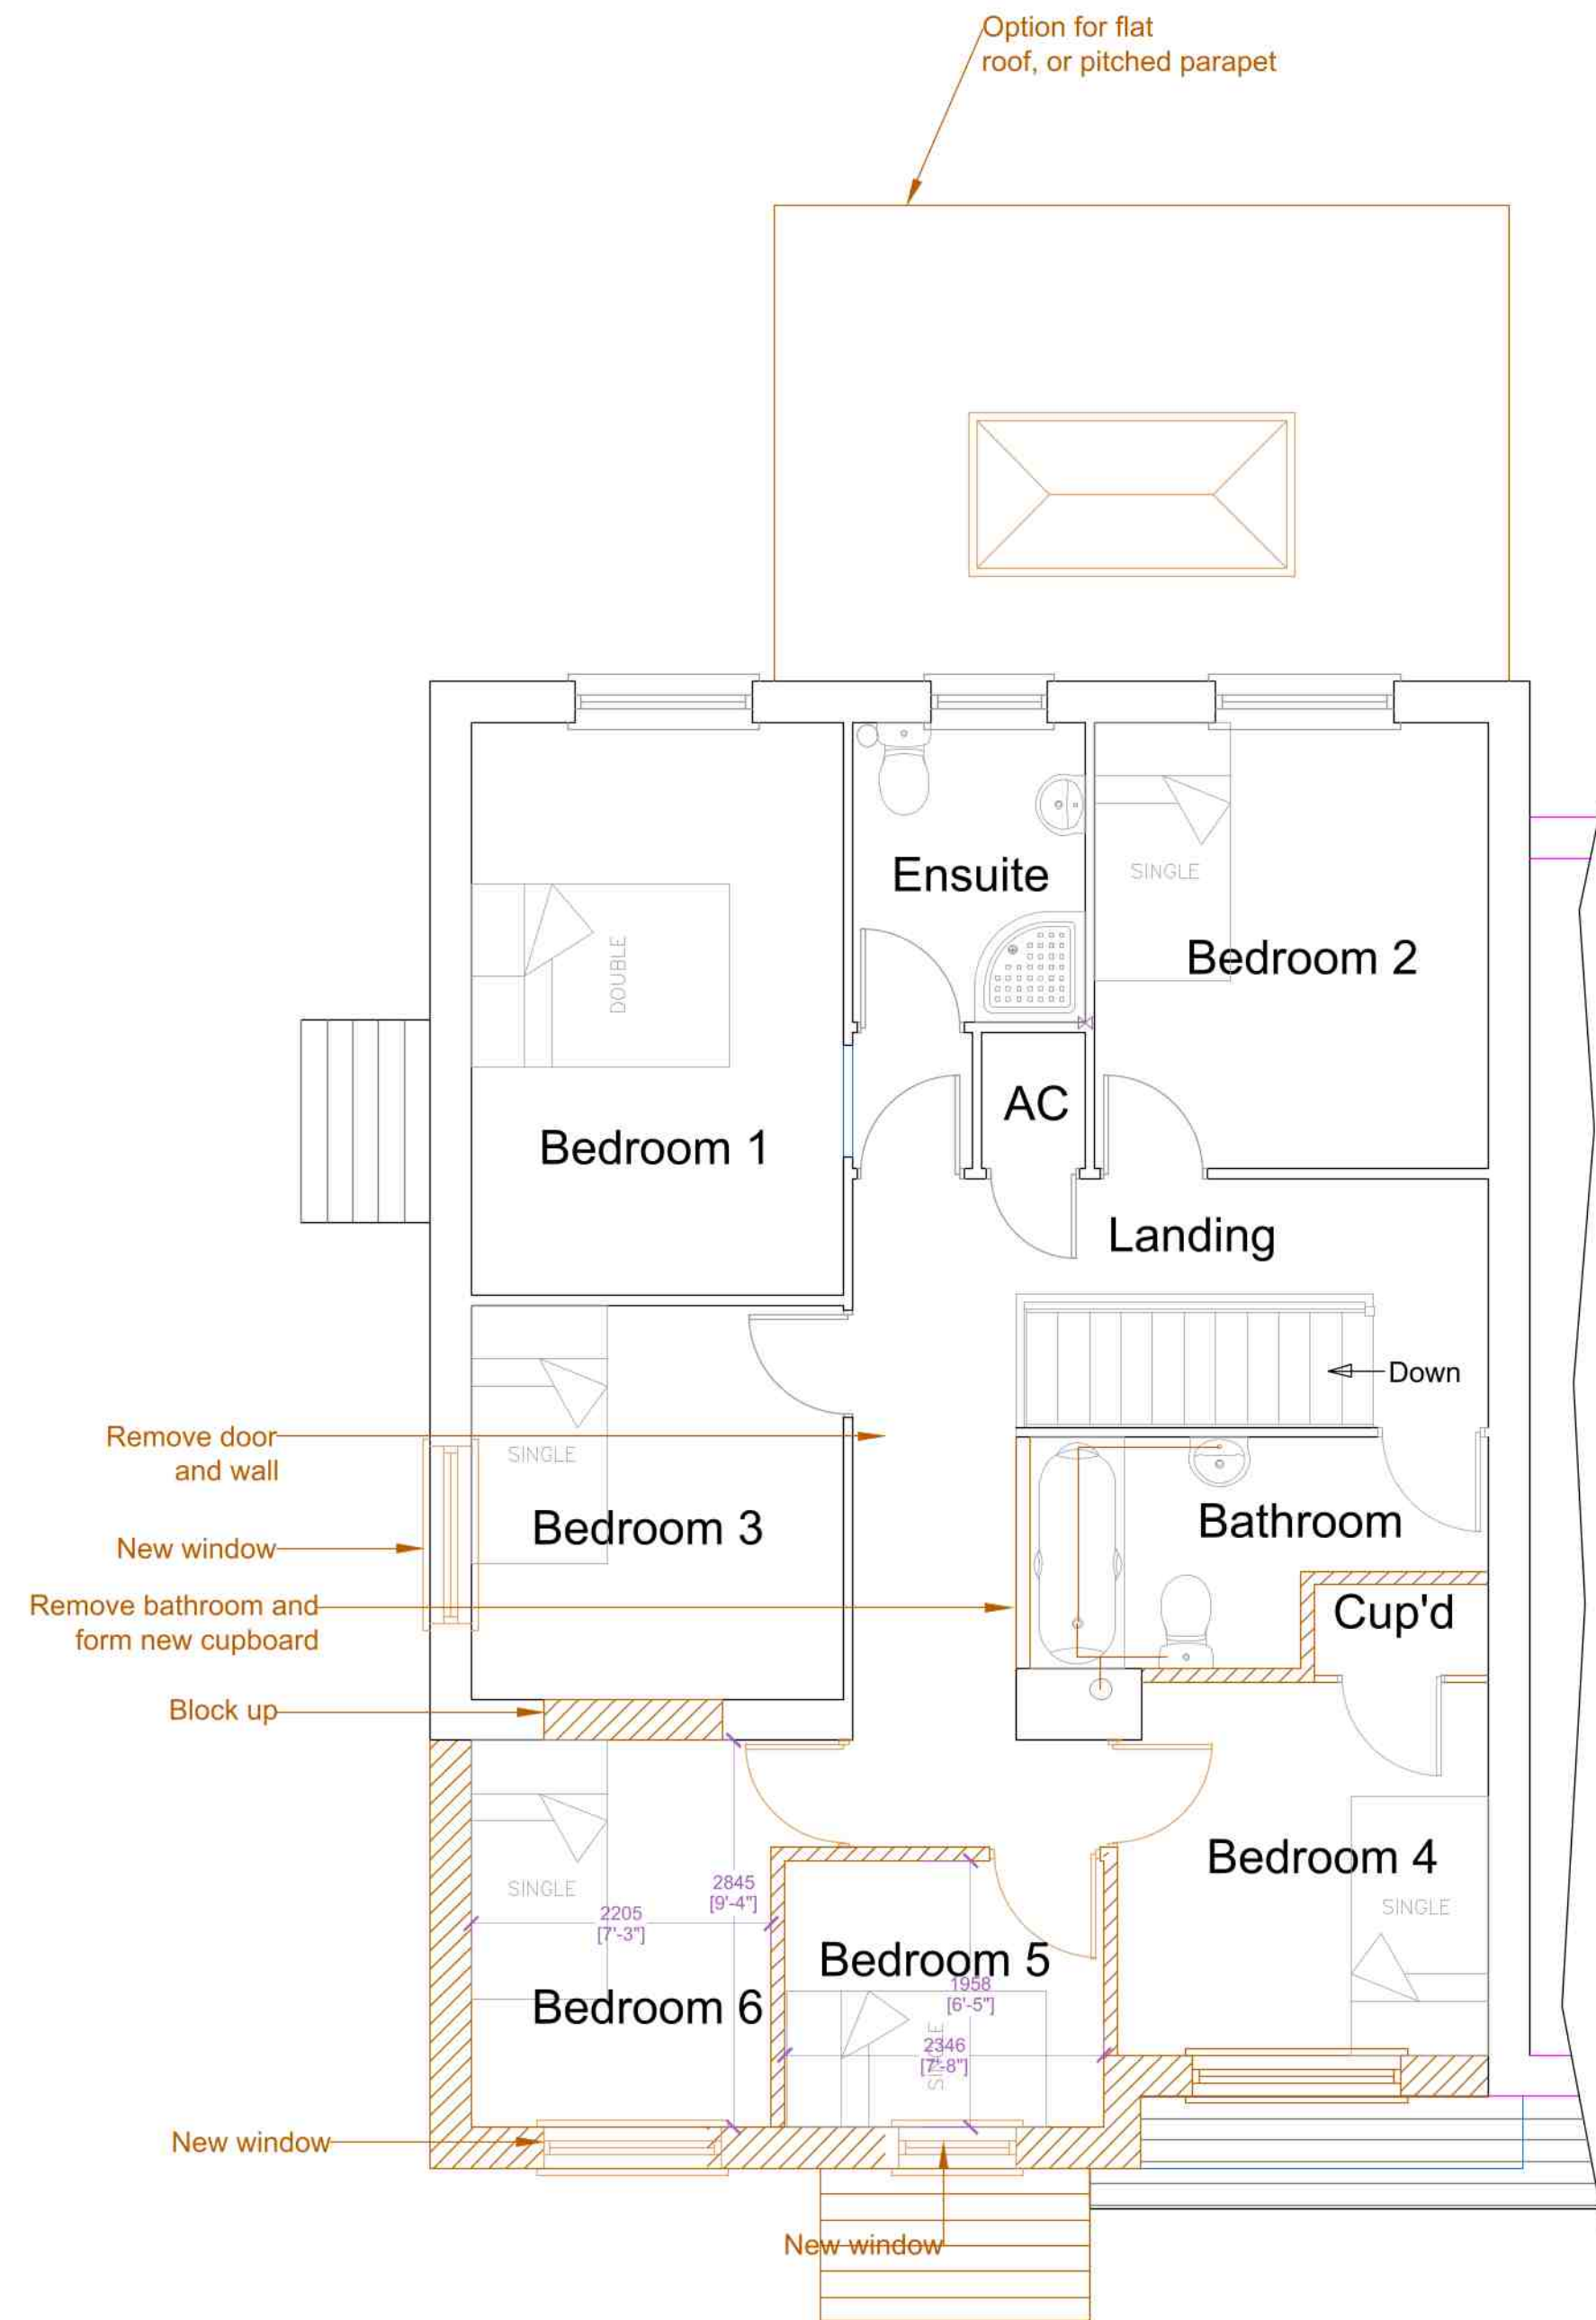

Proposed First Floor Plan

Liz Galloway
Design & Health & Safety
Consultancy

Issued for:
Discussion
Planning Application X
Building Control
Construction Issue
As Built

Proposed Floor Plans

Client Bradley
Site Address
4 Penfolds Place
Arundel
West Sussex
BN18 9SA

Printed	As Shown on A1
Date	07/07/21
Drawing Number	20044/02r1