


* RED LINE SHOWN ON DRAWING INDICATES OUTLINE OF PREVIOUSLY APPROVED SCHEME

Scale in Metres

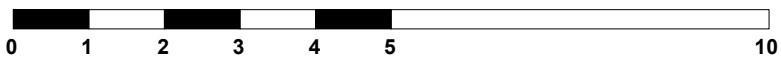

Project: Queens Lane Arundel BN18 9JN		Michael Forward, ARB, RIBA 150 Earlsfield Road, London, SW18 3DT Tel: 07773967775	
Drawing Title: Proposed West Elevation			
Scale 1:100@ A4	Date 05/05/2025	Drawn MF	Checked MF
Drawing Number N/A	Rev.	Project Number 1024	