


11 MOUNT PLEASANT ARUNDEL BN18 98D

INDICATIVE BLOCK PLAN

SCALE 1:100

17

ARUN DISTRICT COUNCIL		
No.	AB	8 10
SUBSTITUTION		
Received	25-3-10	

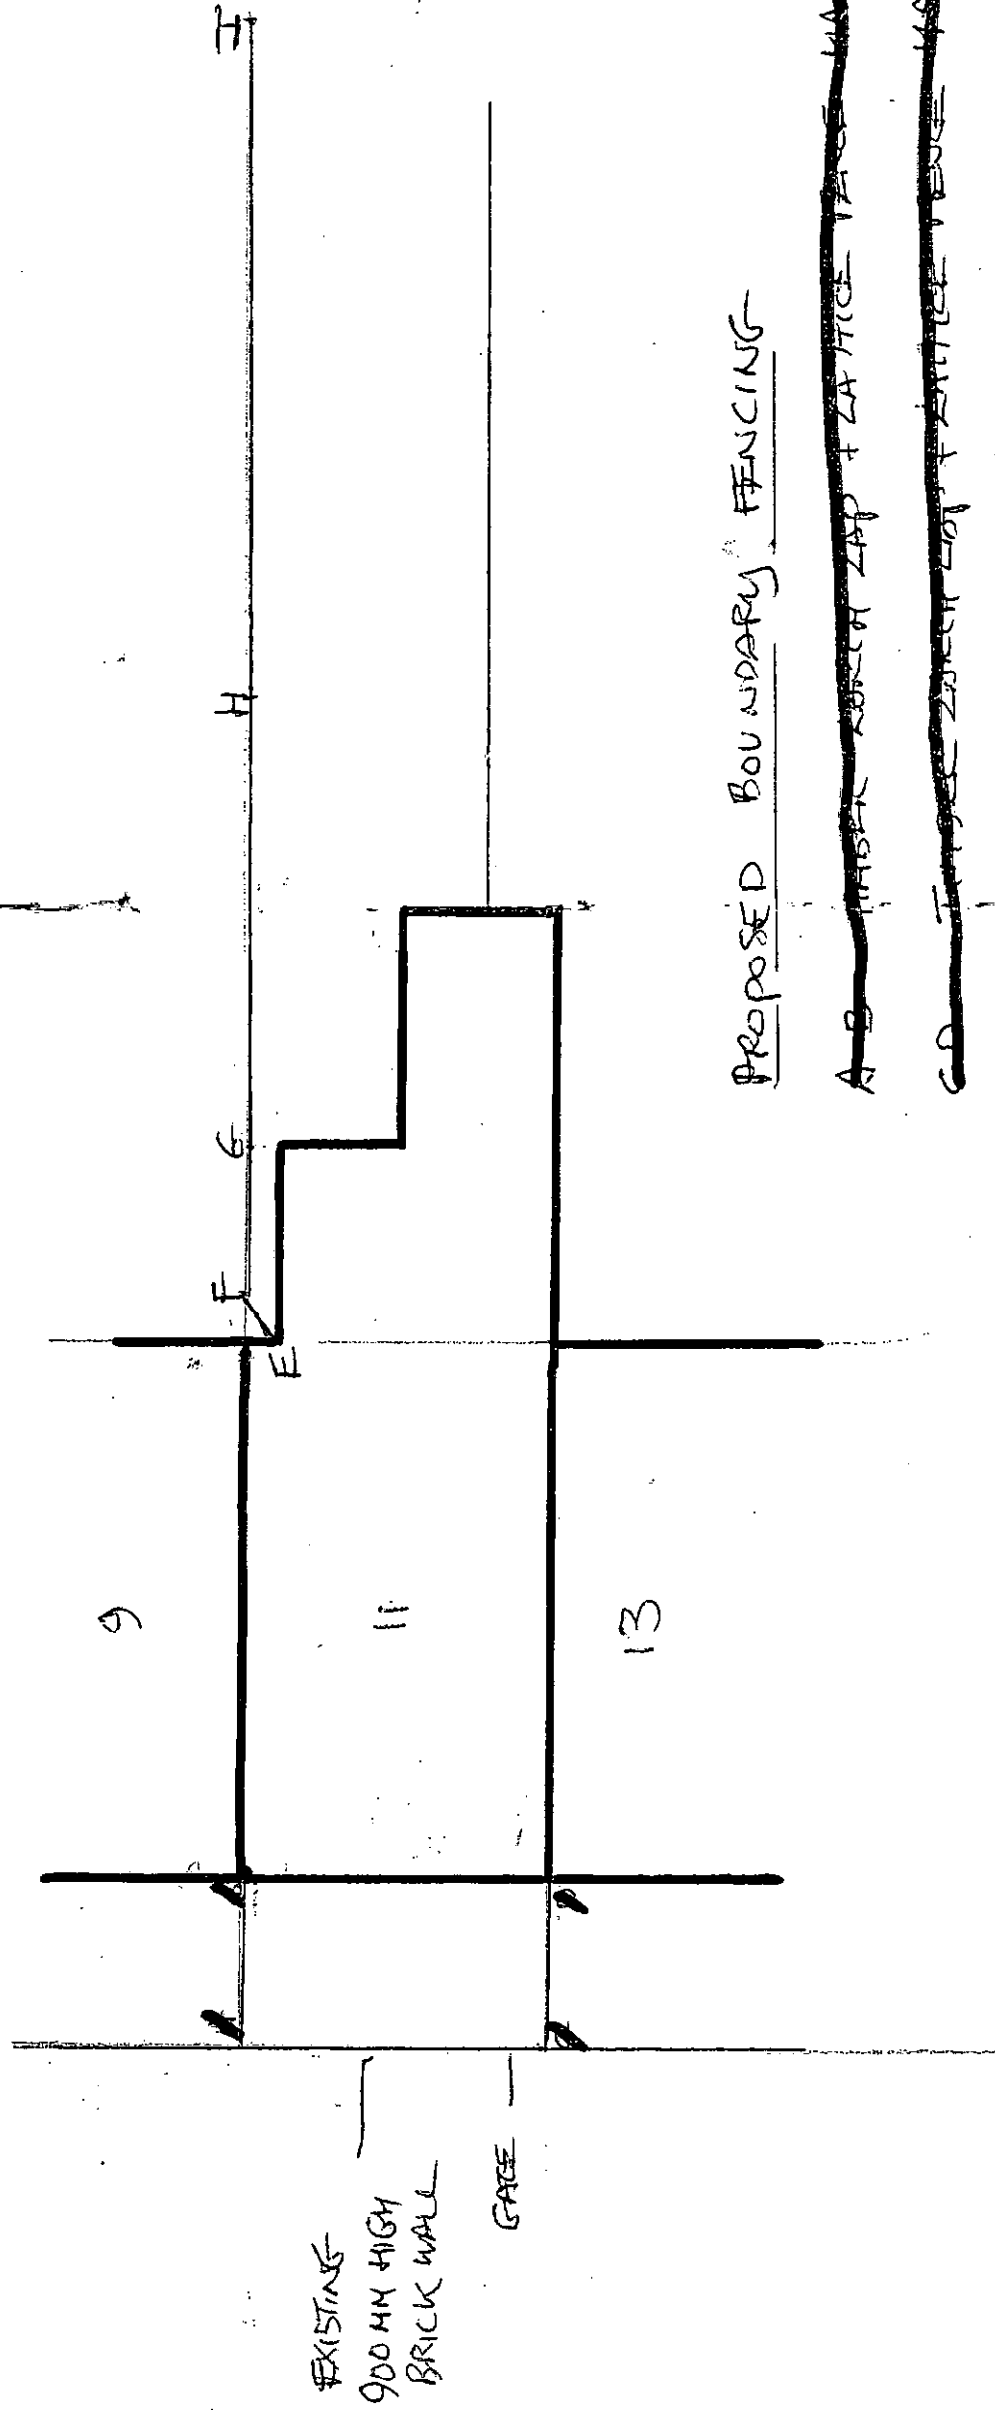

PROPOSED BOUNDARY FENCING-

~~AB~~ 1.6M HIGH - LENGTH 0.5M TIMBER CLOSE BOARDED 1.5M

~~CD~~ 1.9M HIGH - LENGTH 2.0M TIMBER CLOSE BOARDED + LATTICE 1.5M

EF 1.6M HIGH - LENGTH 0.5M TIMBER CLOSE BOARDED

FG 1.9M HIGH - LENGTH 2.0M TIMBER CLOSE BOARDED + LATTICE

GH AS F-G BUT LENGTH 5.8M

HI 8.8M LONG 1.55M HIGH TIMBER LATTICE.