




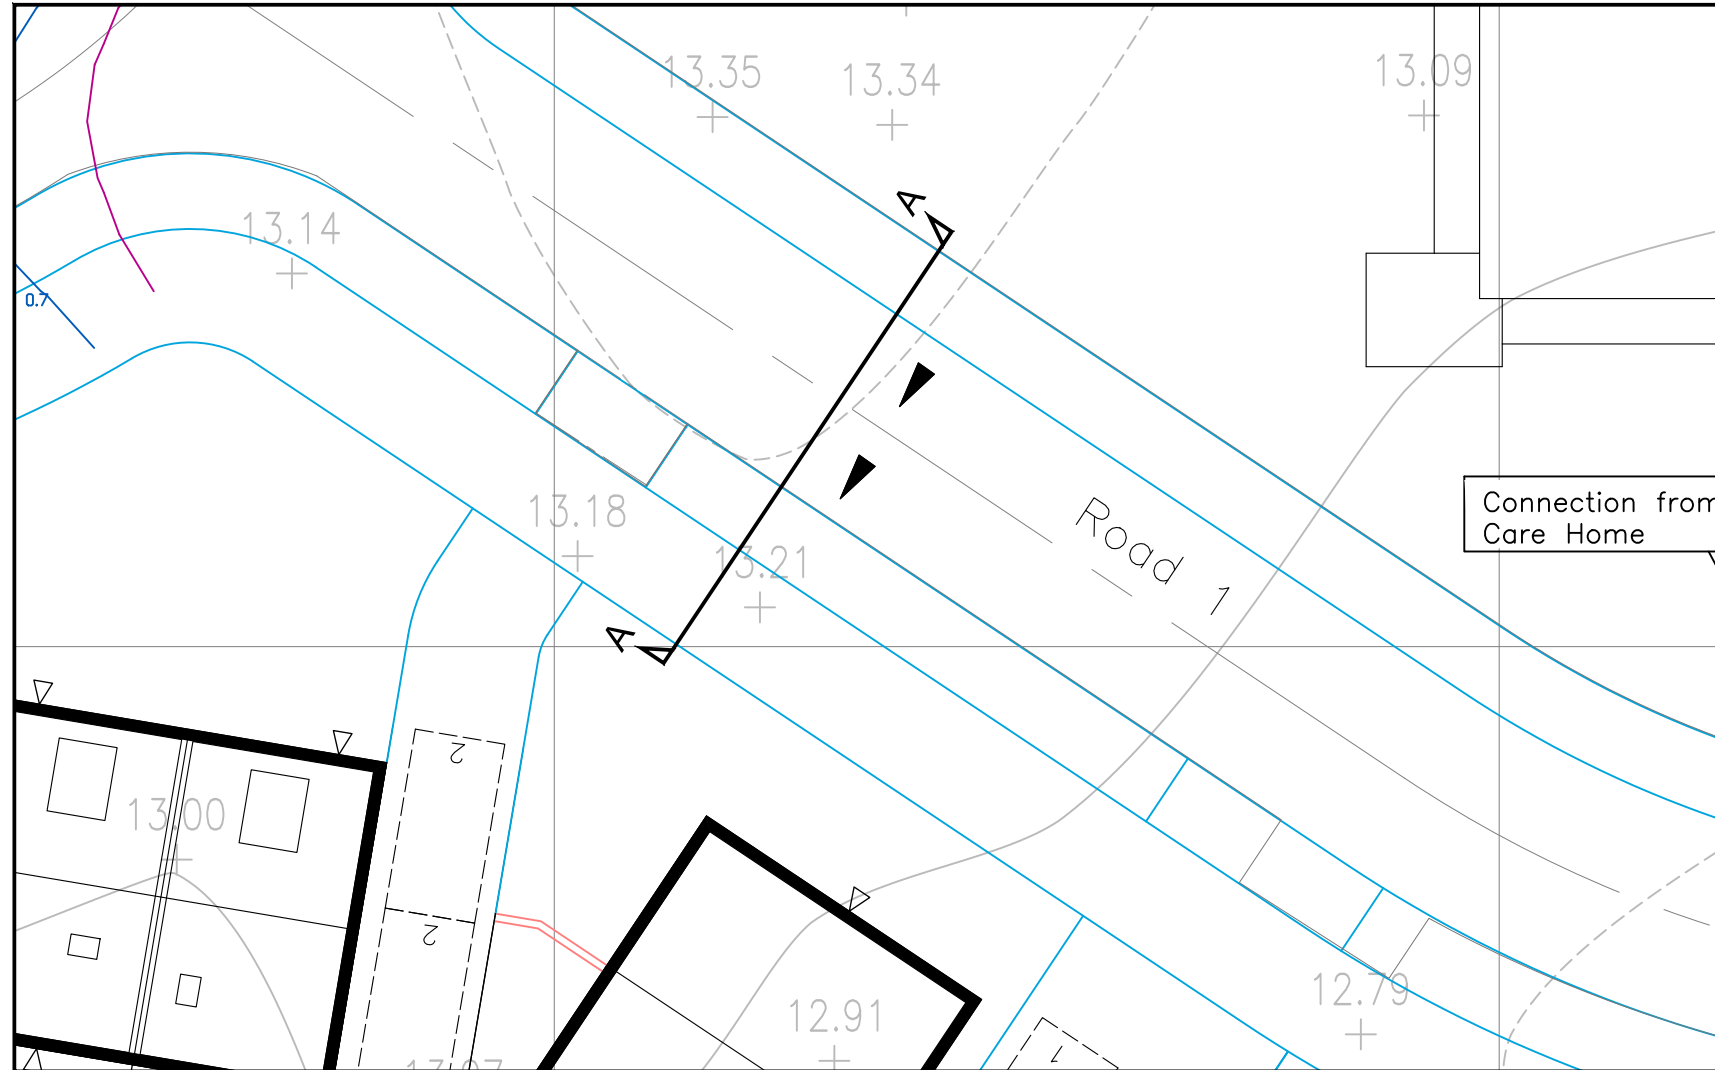


PLAN
Scale 1:200

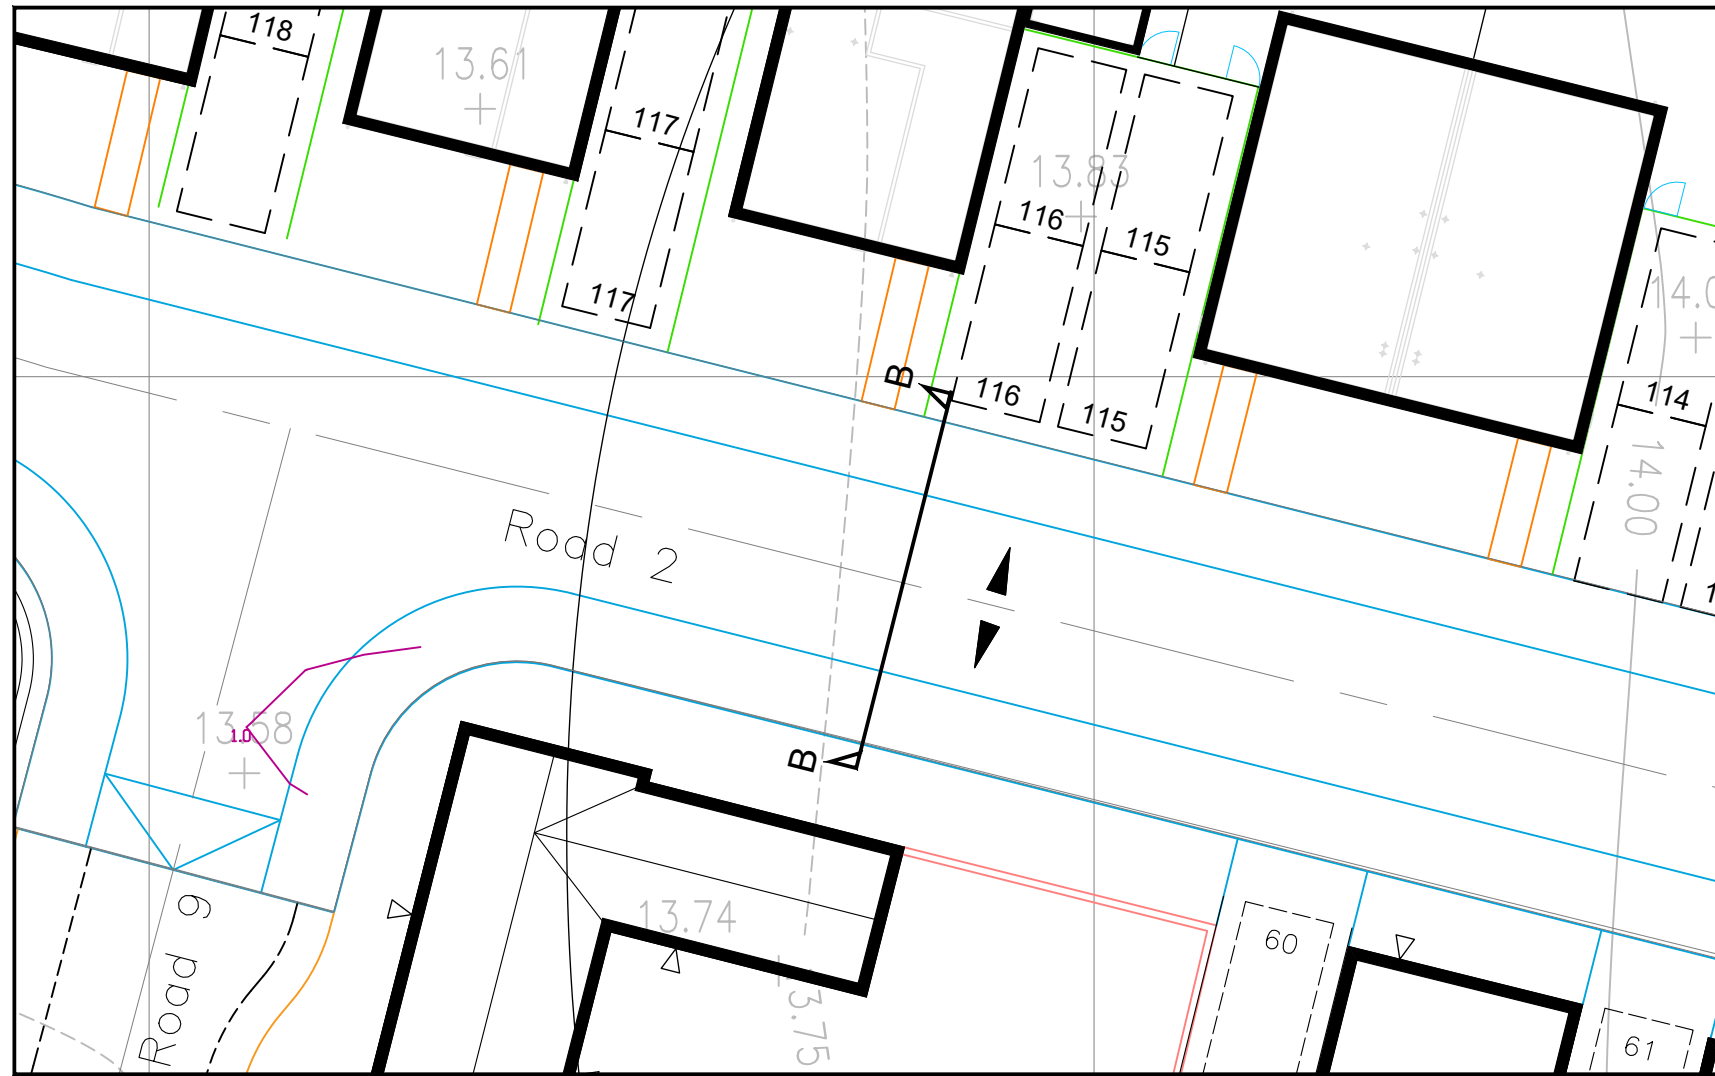


PLAN
Scale 1:200

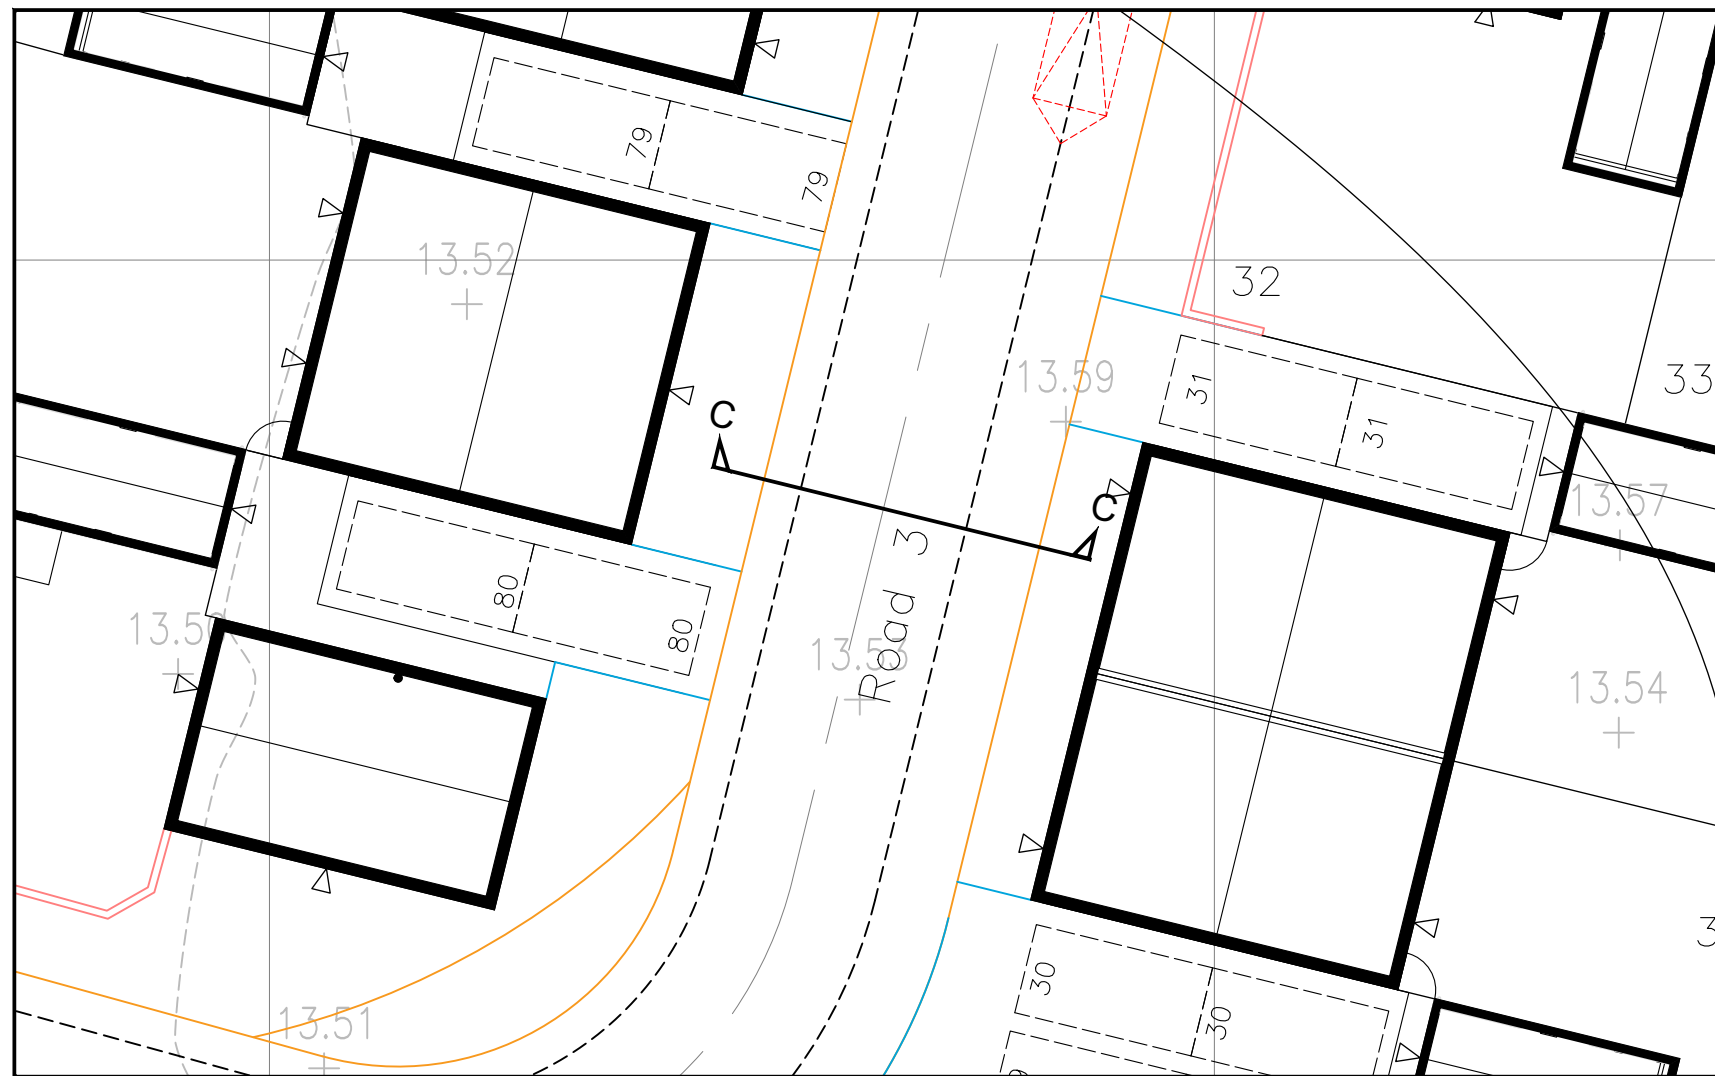


PLAN
Scale 1:200

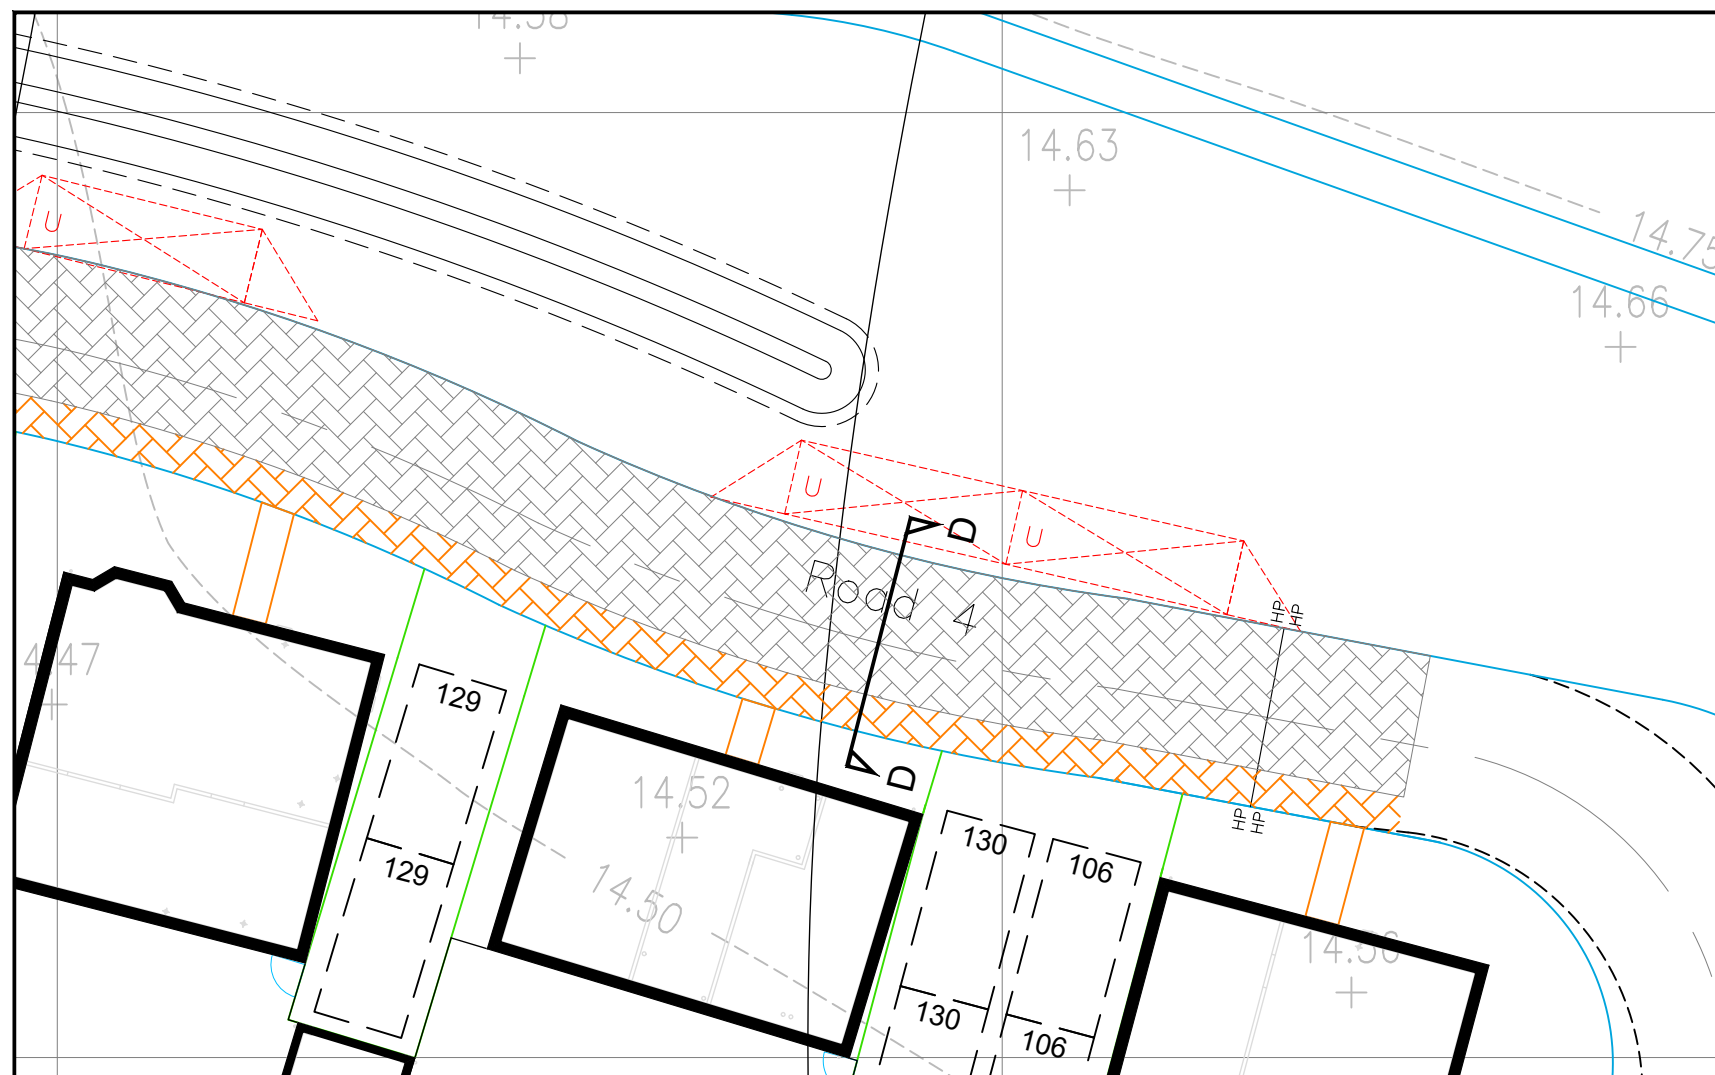


PLAN
Scale 1:200

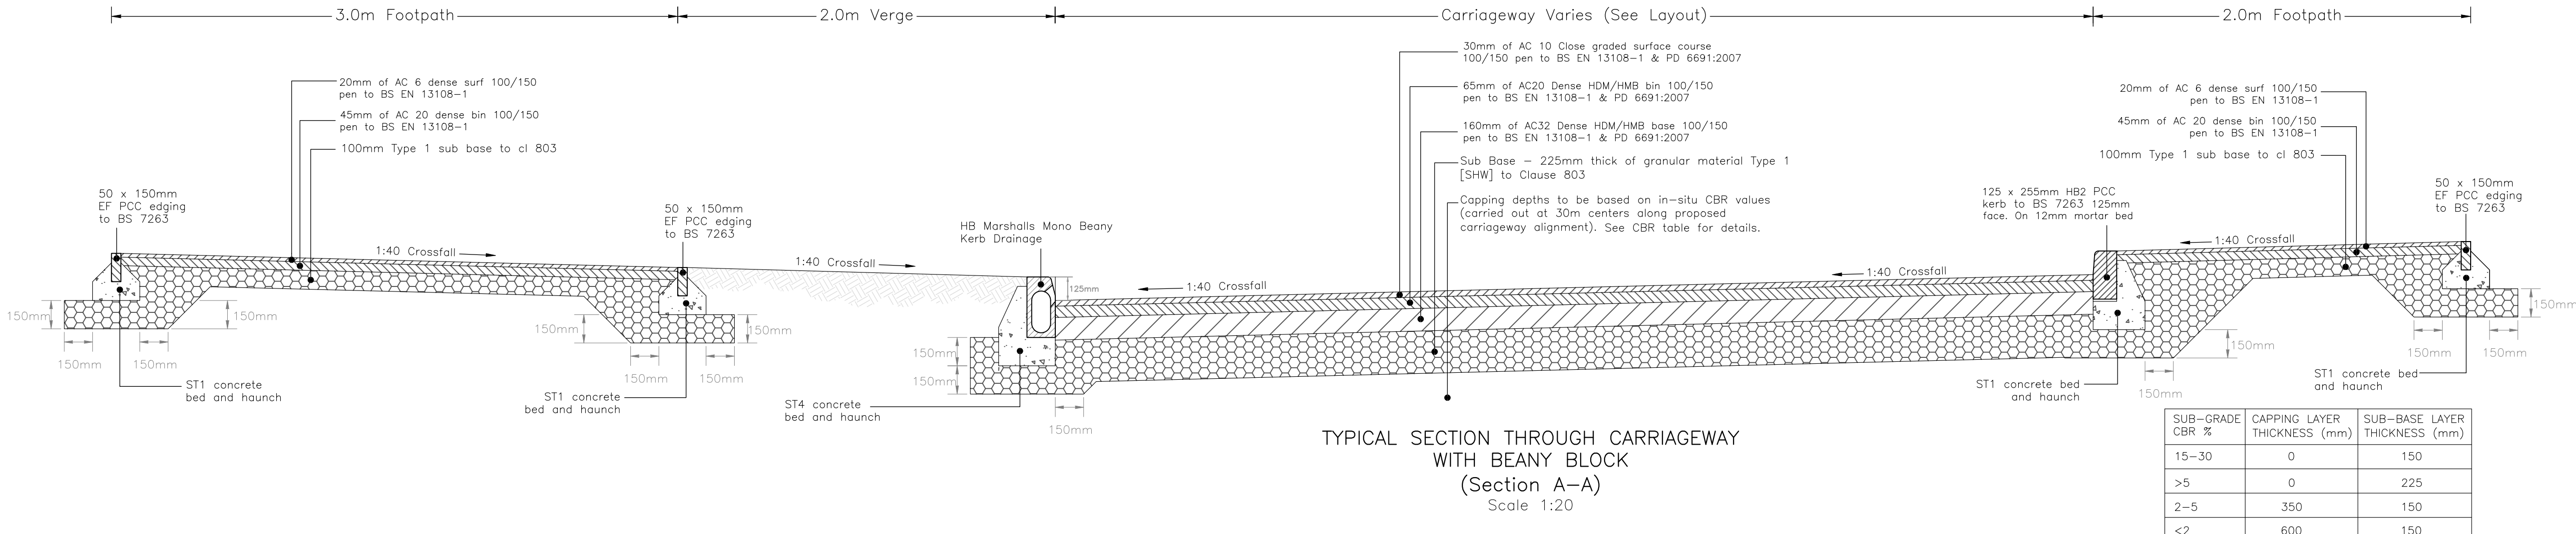

TYPICAL SECTION THROUGH CARRIAGEWAY WITH BEANY BLOCK (Section A-A)
Scale 1:20

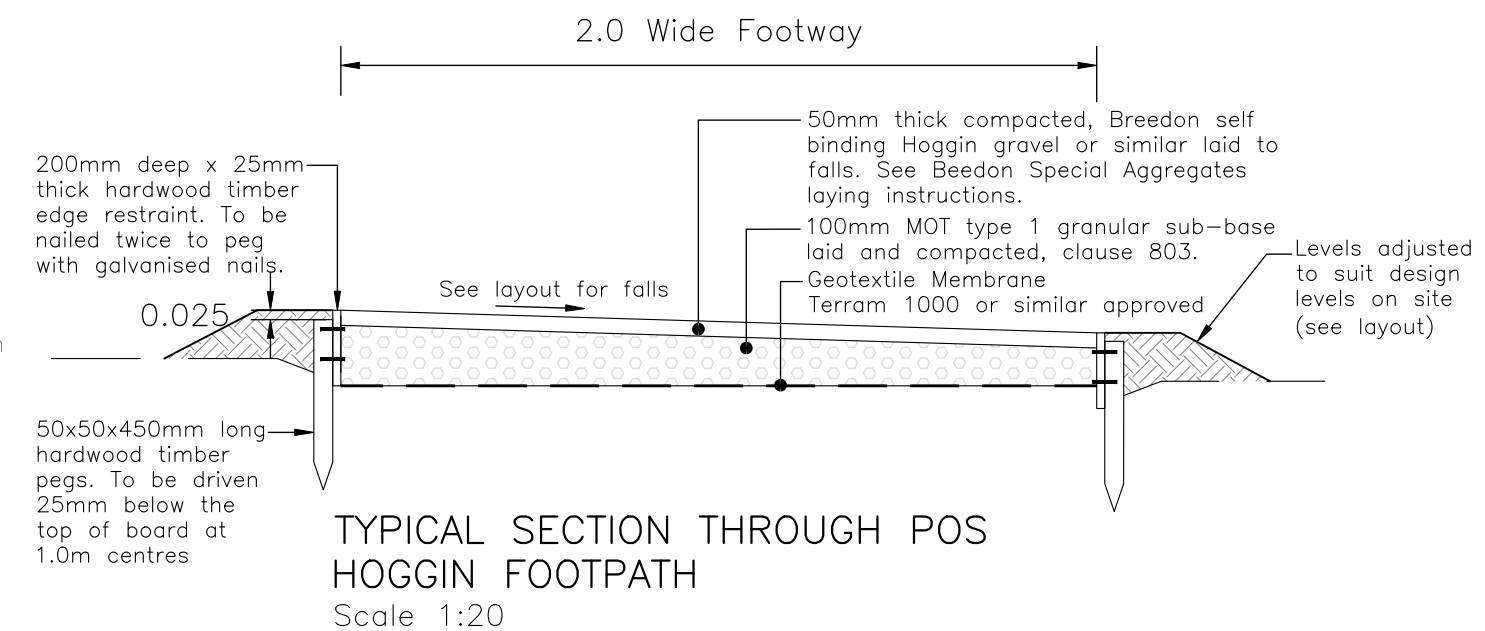


TYPICAL SECTION THROUGH POS HOGGIN FOOTPATH
Scale 1:20

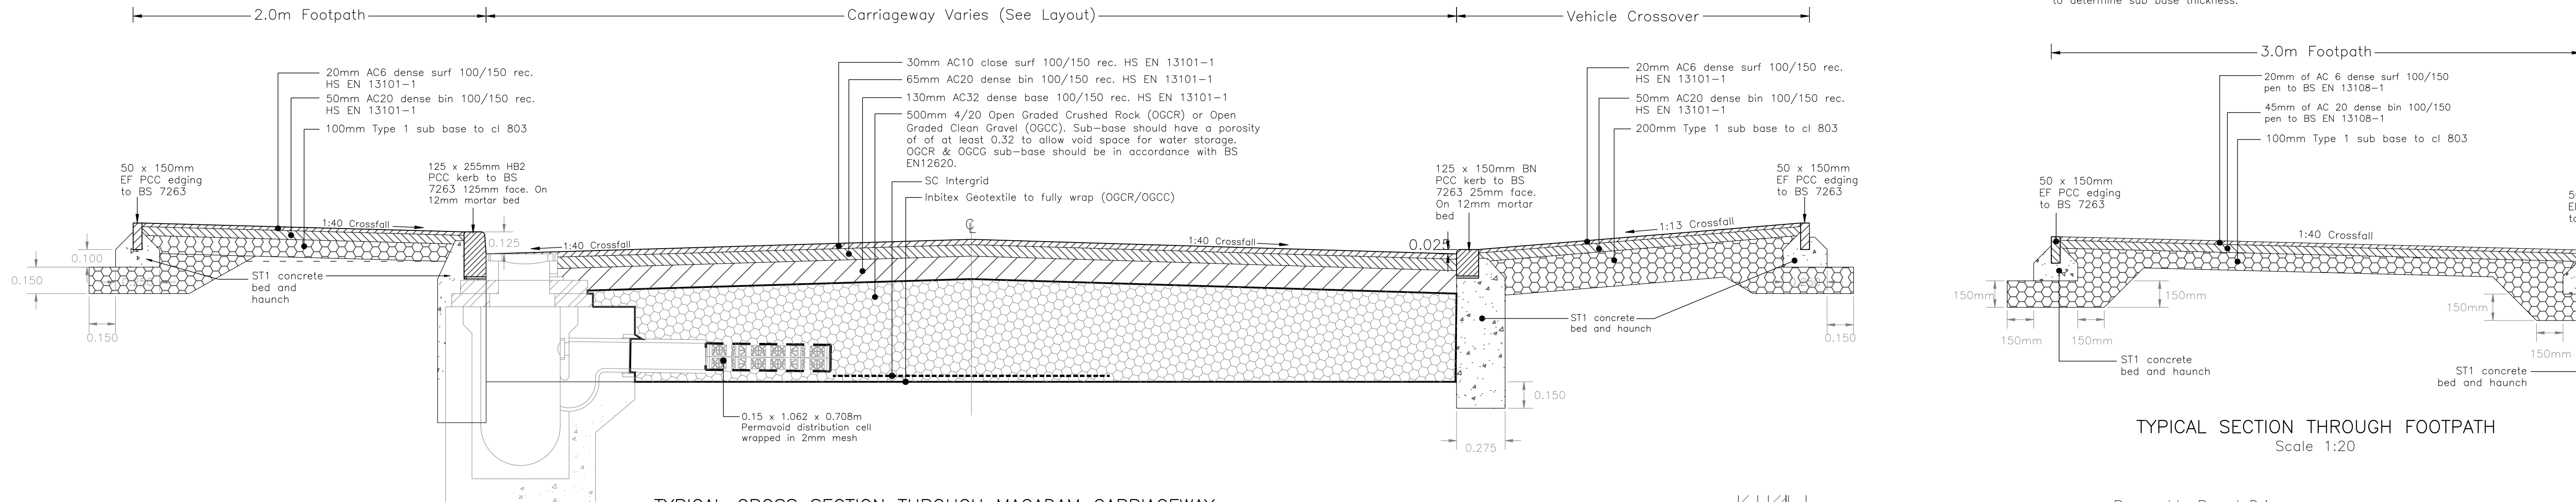


TYPICAL CROSS SECTION THROUGH MACADAM CARRIAGEWAY WITH PERMEABLE SUB BASE (Section B-B)
Scale 1:20


TYPICAL SECTION THROUGH FOOTPATH
Scale 1:20

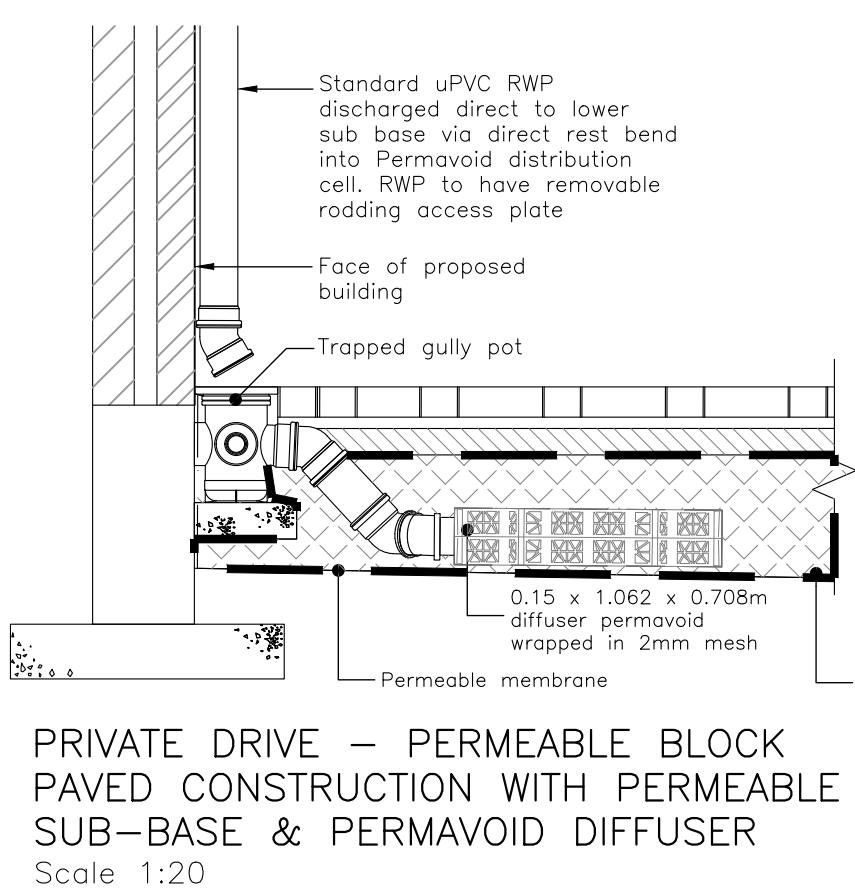


PRIVATE DRIVE - PERMEABLE BLOCK PAVED CONSTRUCTION WITH PERMEABLE SUB-BASE & PERMAVOID DIFFUSER
Scale 1:20

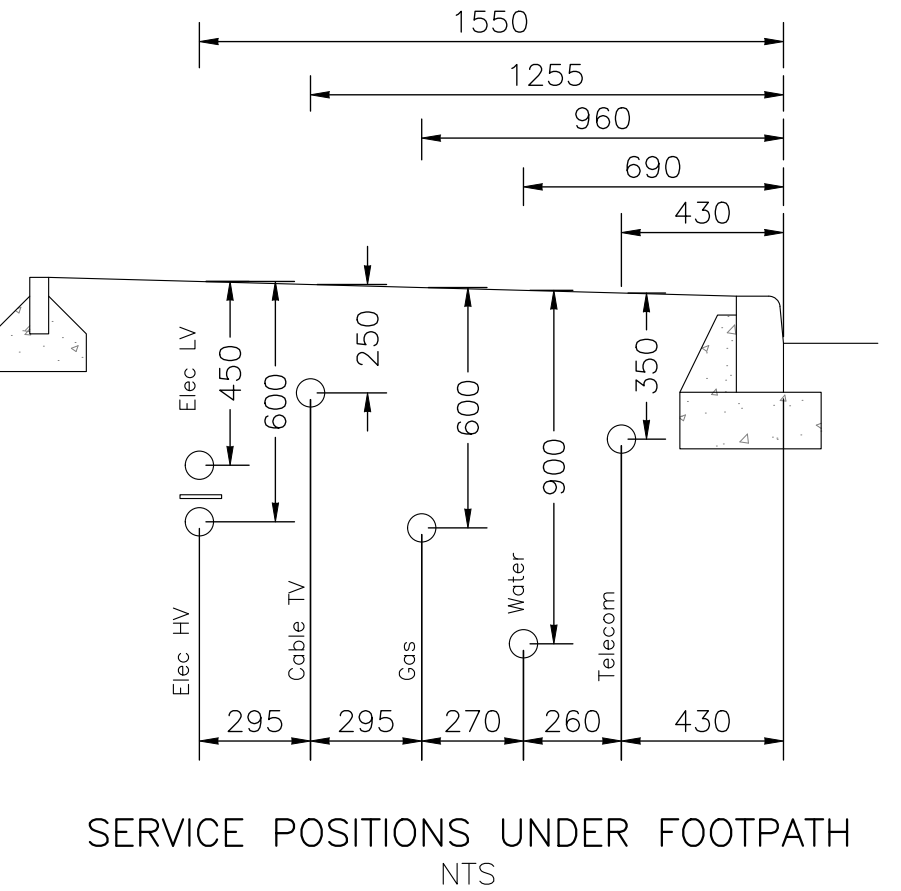


SERVICE POSITIONS UNDER FOOTPATH
NTS

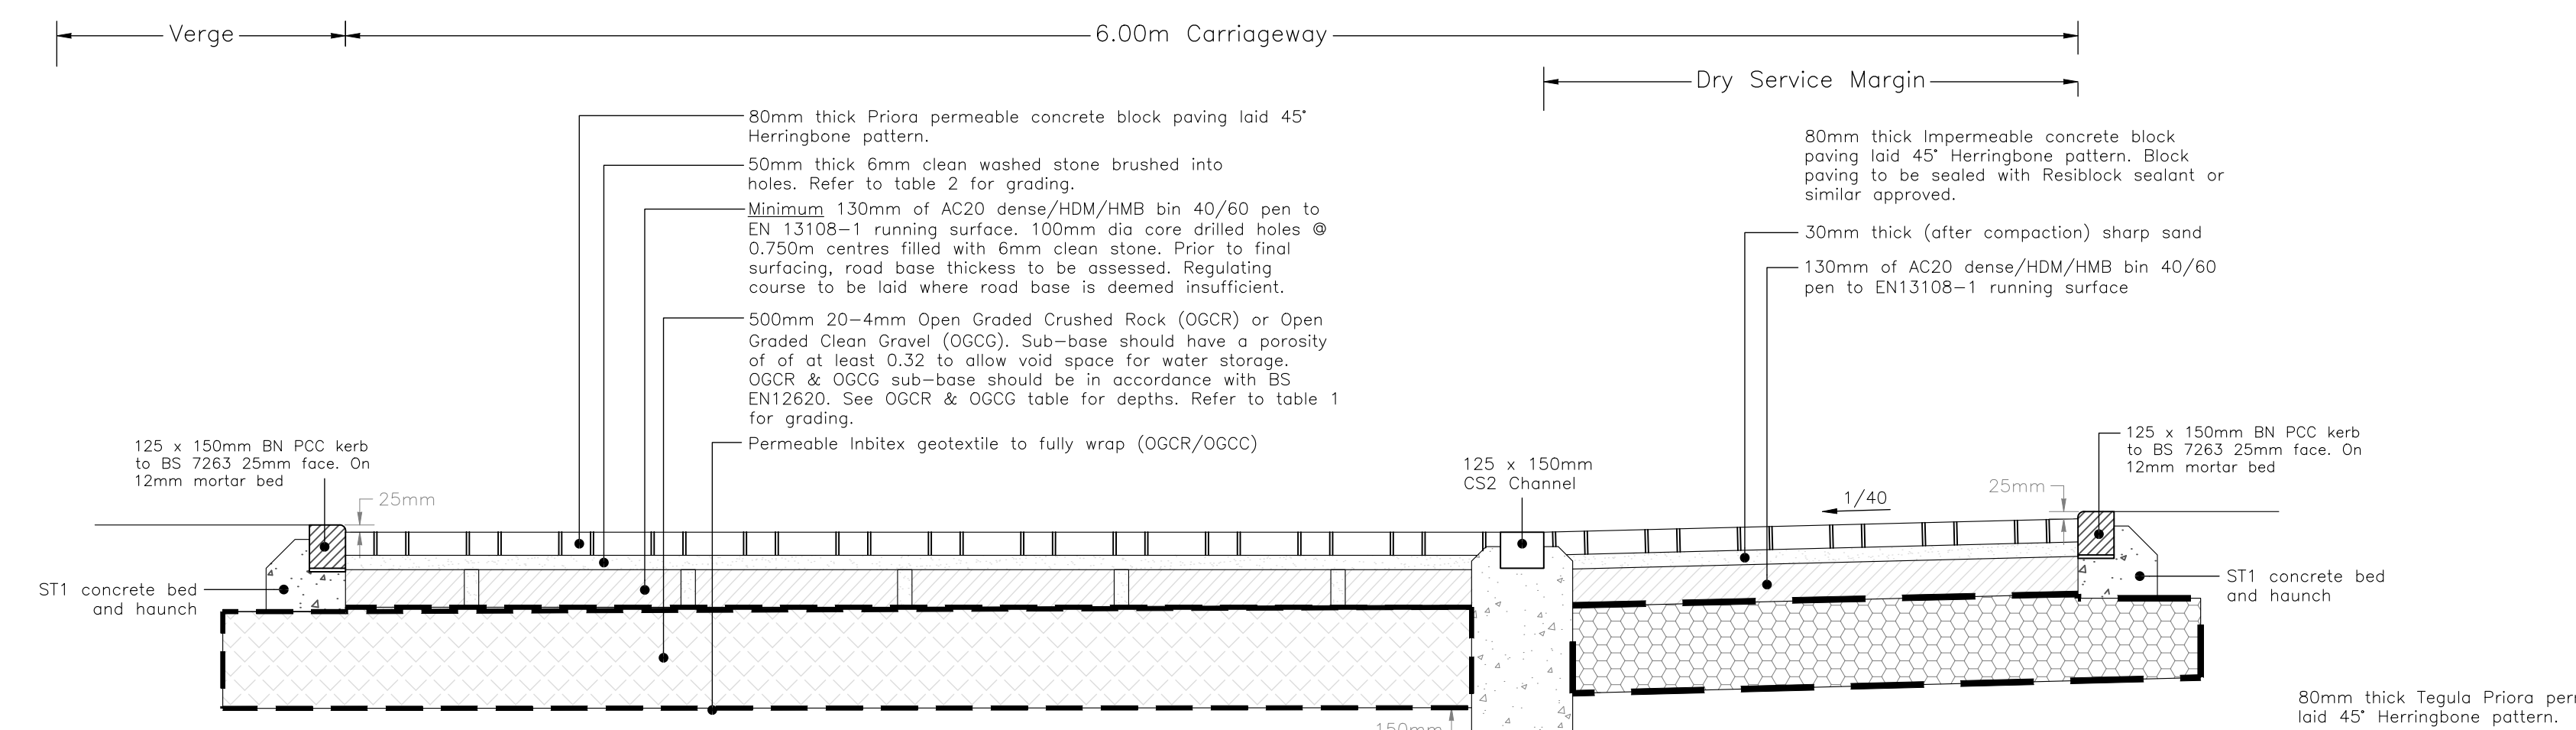


PERMEABLE BLOCK PAVED ROAD WITH DRY SERVICE MARGIN (Section C-C)
Scale 1:20

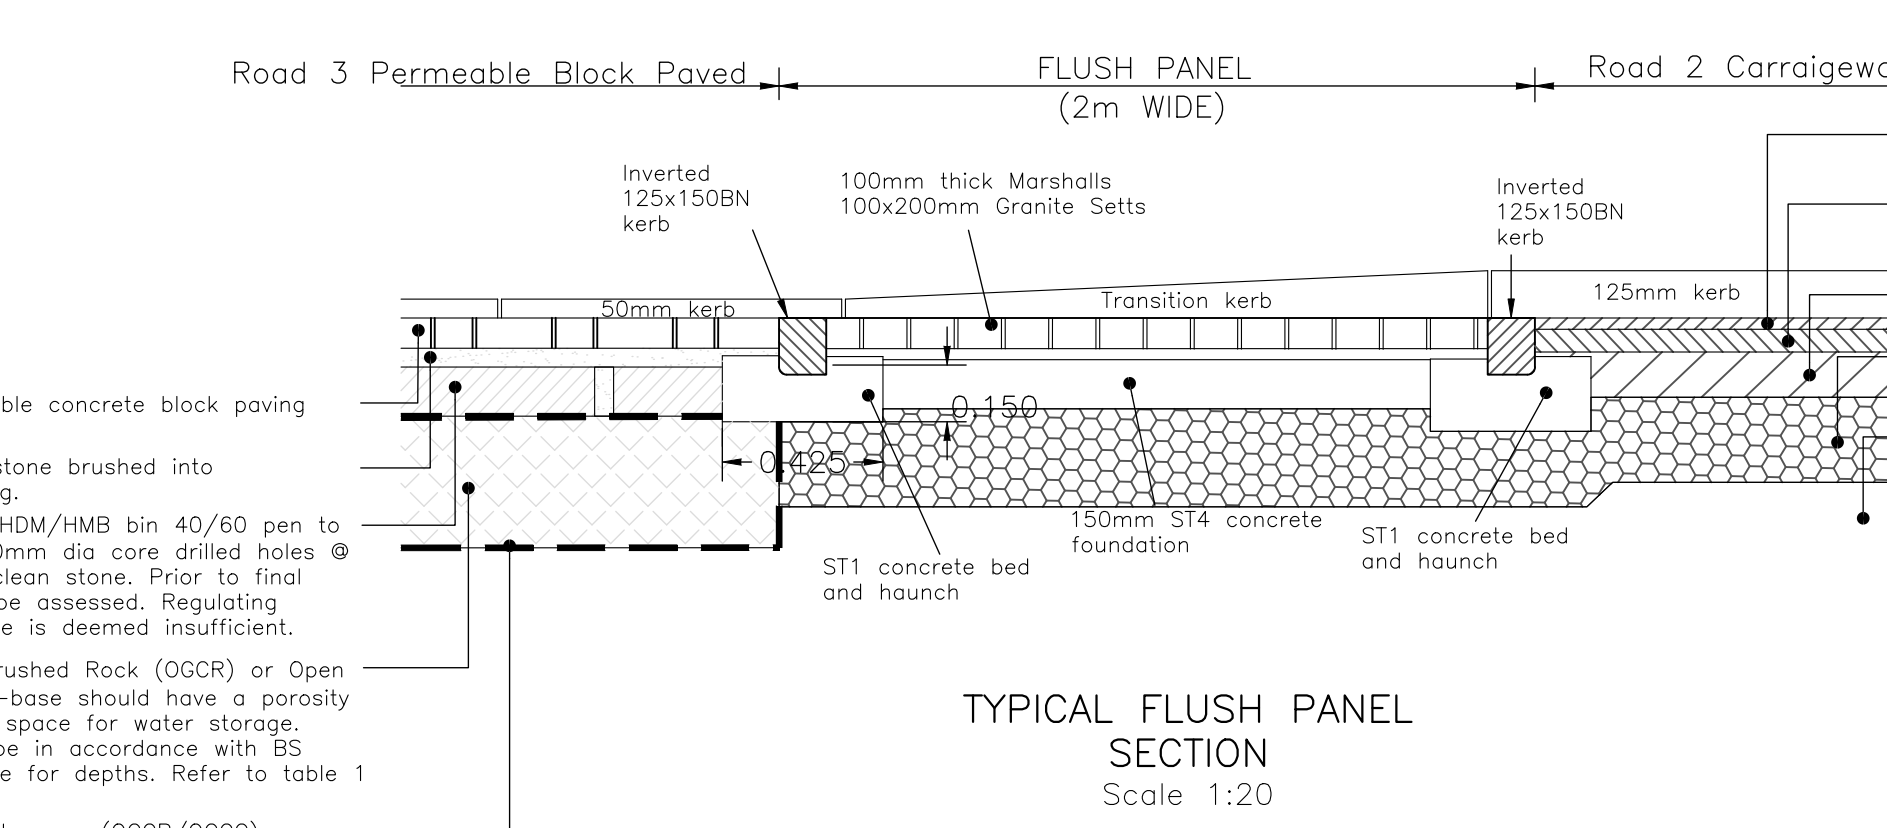


TYPICAL FLUSH PANEL SECTION
Scale 1:20

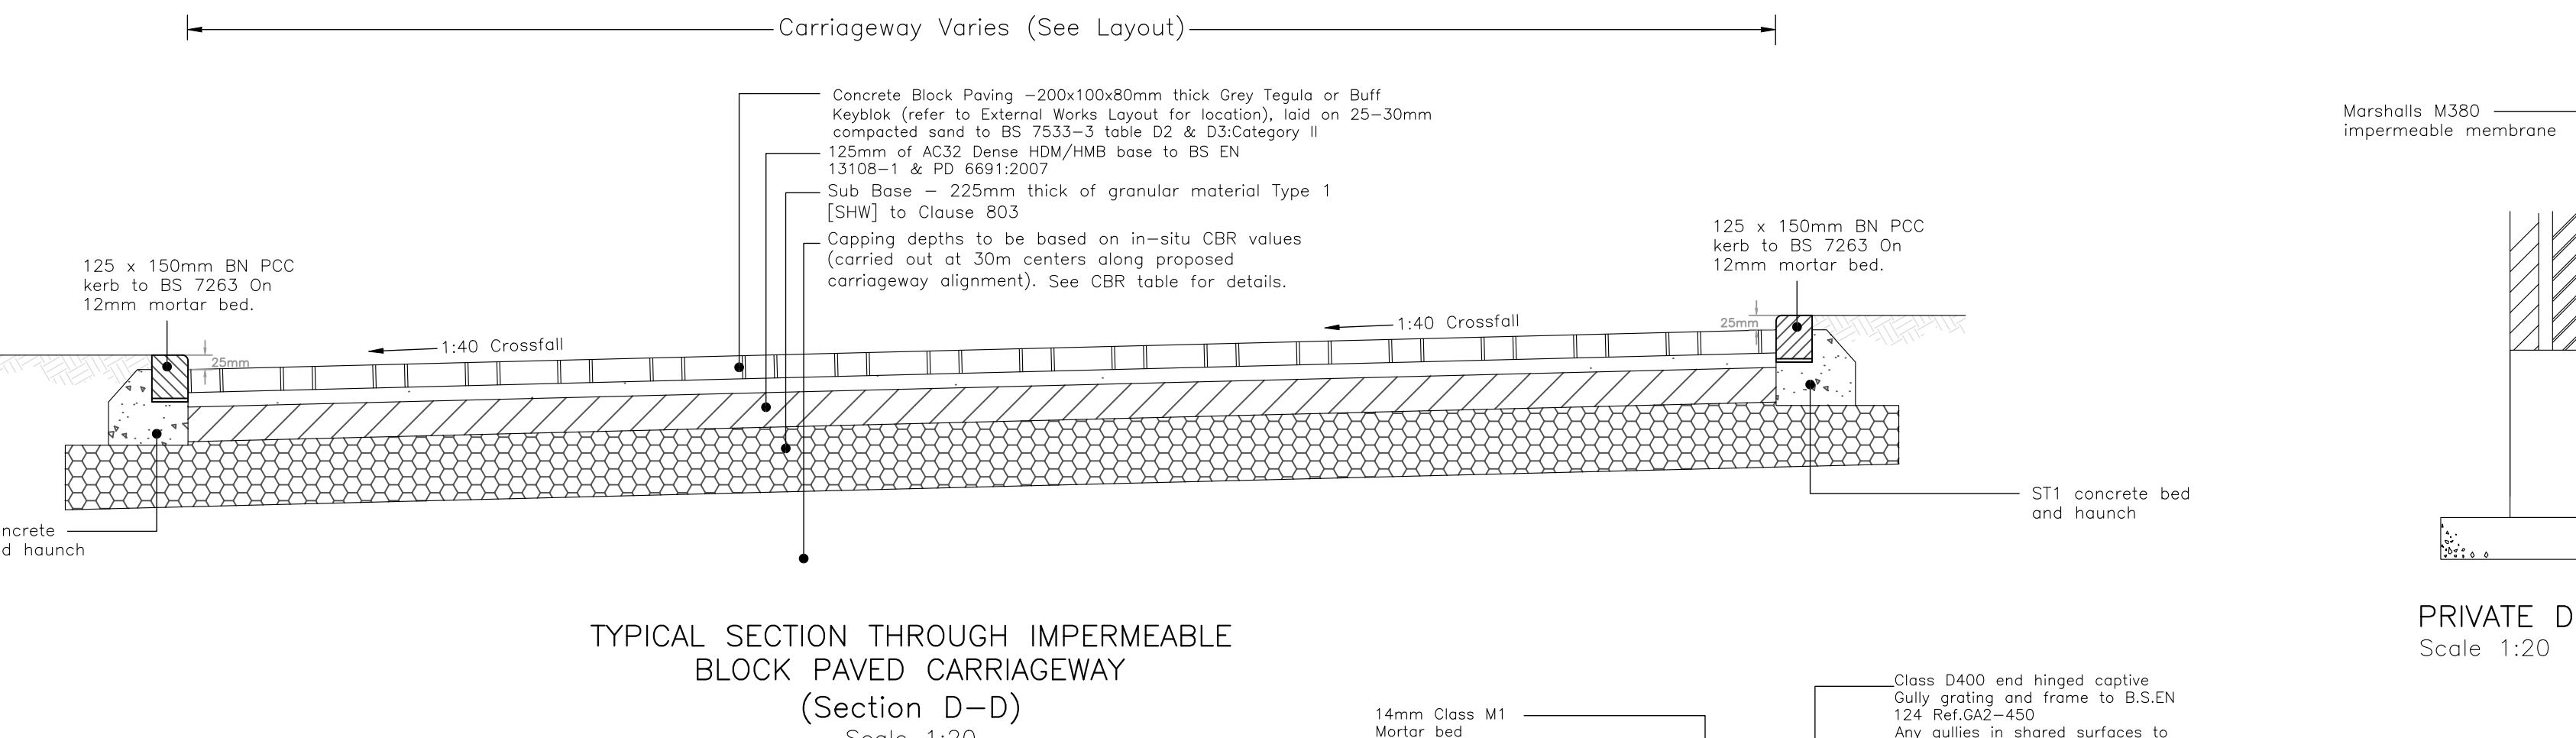


TYPICAL SECTION THROUGH IMPERMEABLE BLOCK PAVED CARRIAGEWAY (Section D-D)
Scale 1:20

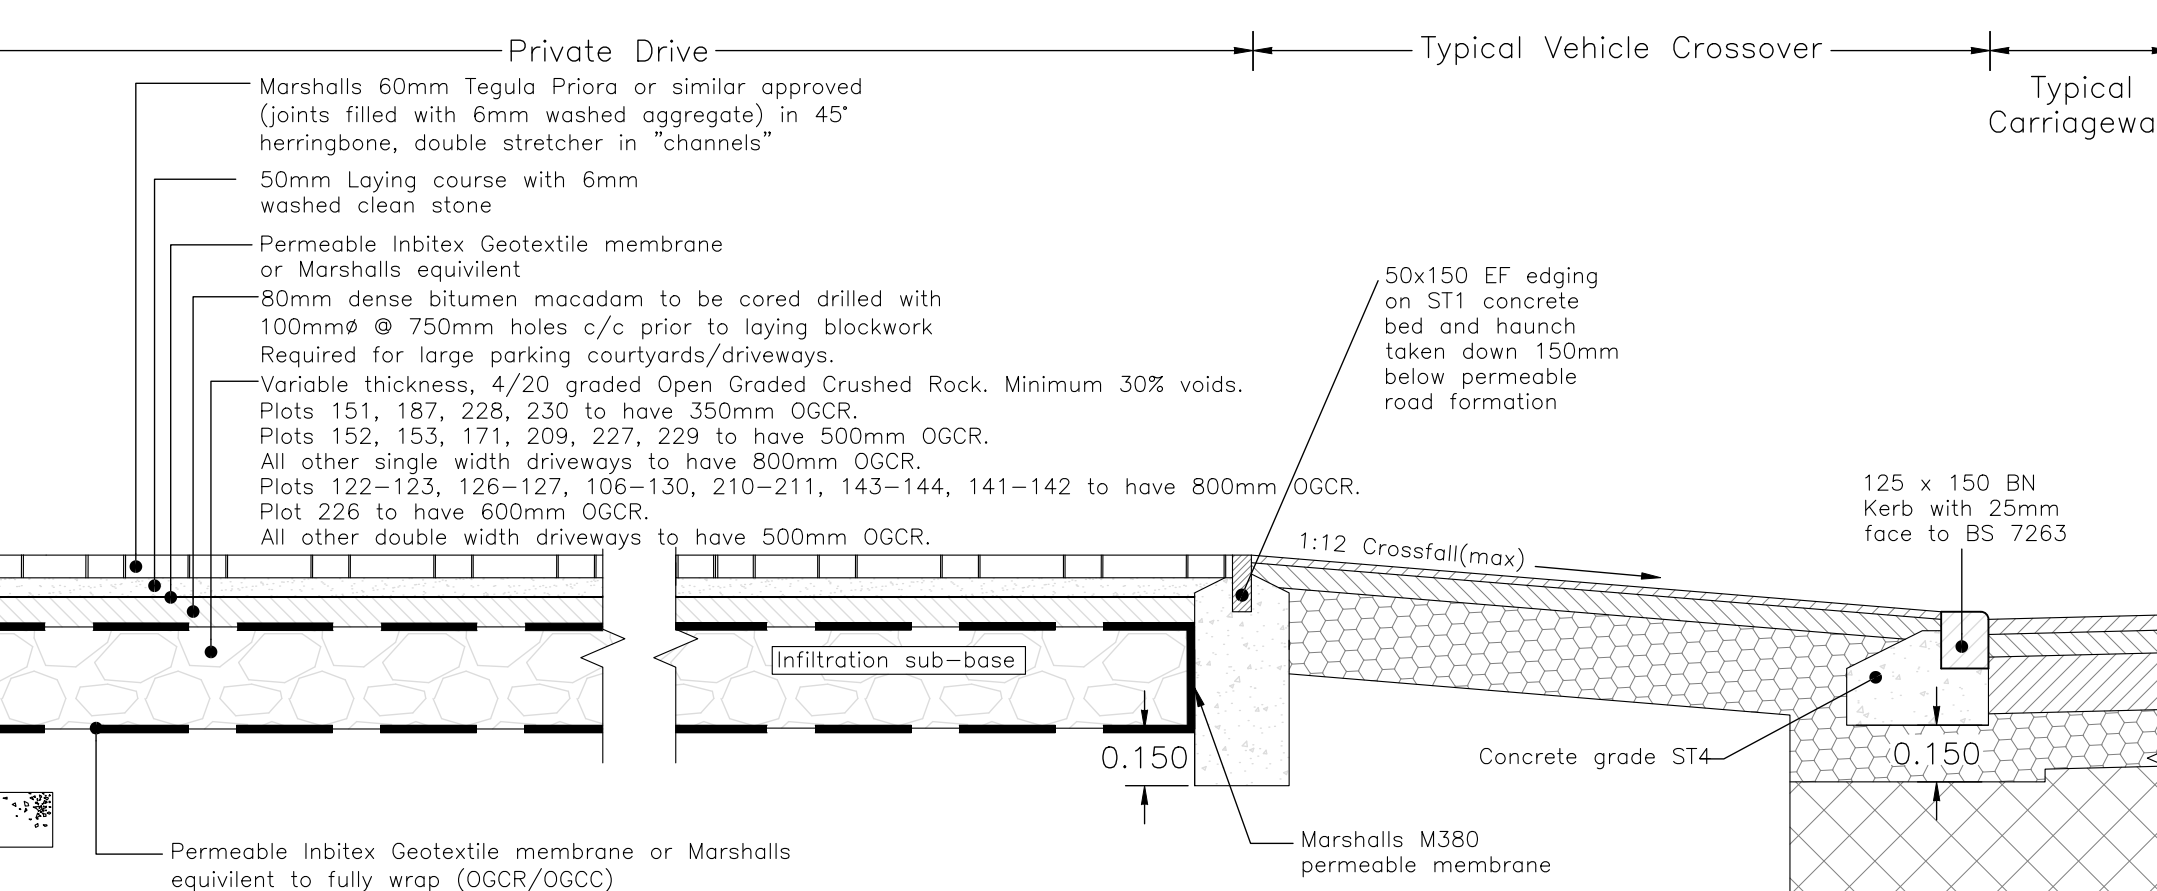


PRIVATE DRIVE - PERMEABLE BLOCK PAVED CONSTRUCTION
Scale 1:20

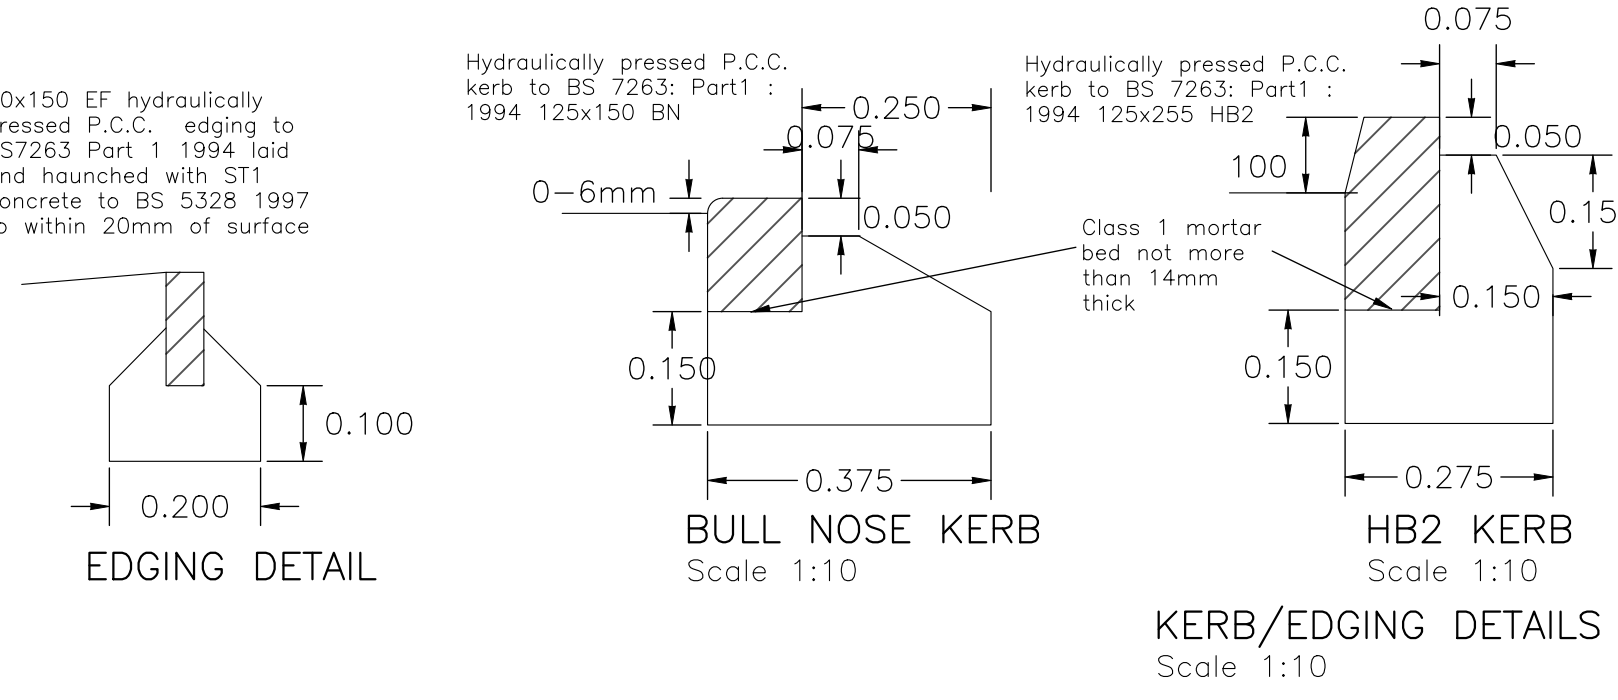

BULL NOSE KERB Scale 1:10
KERB/EDGING DETAILS Scale 1:10

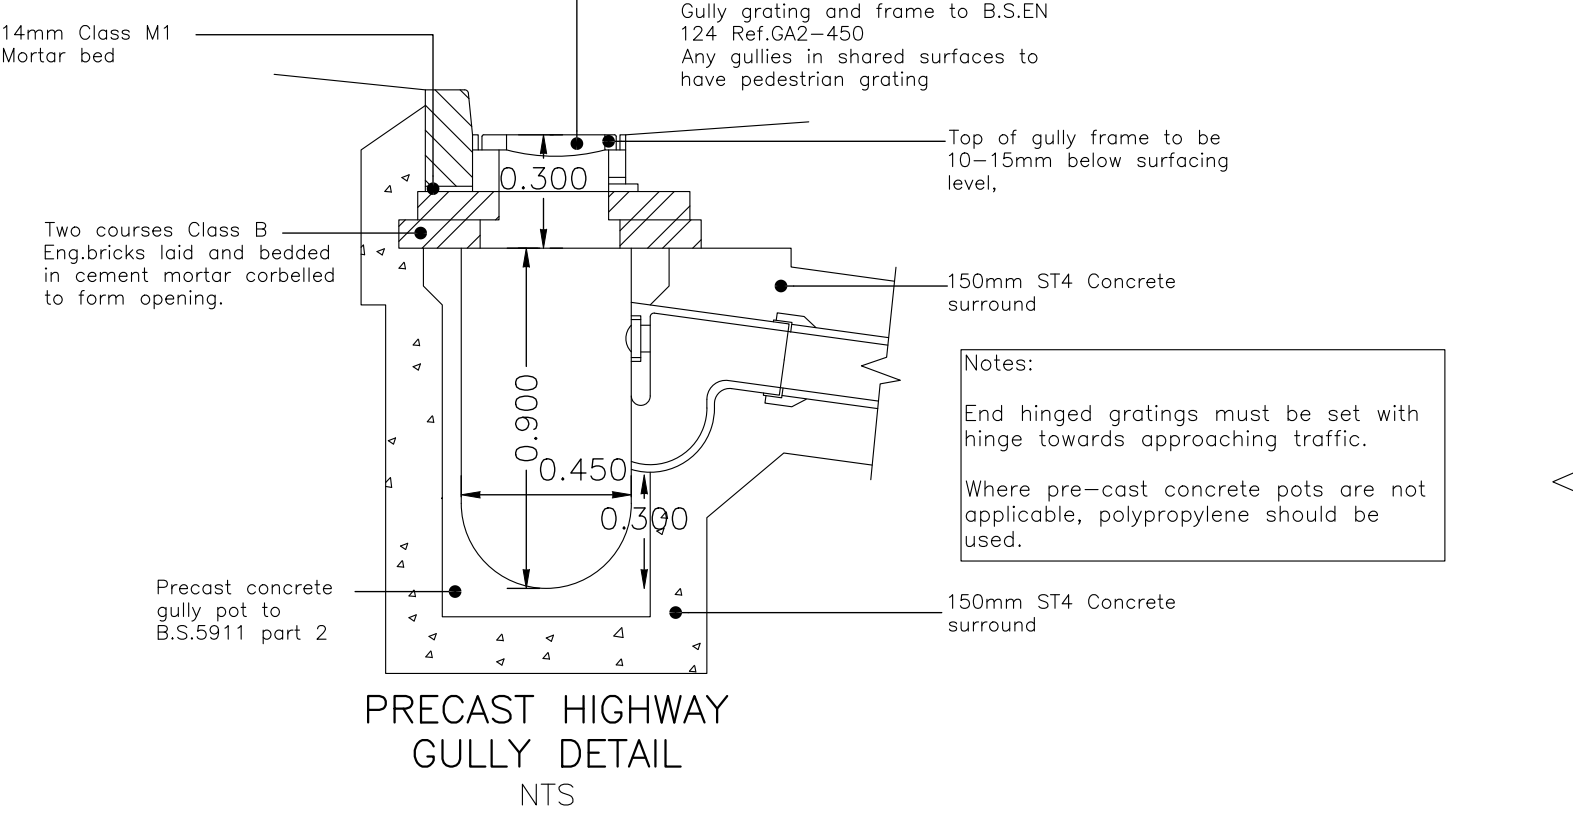

PRECAST HIGHWAY GULLY DETAIL
NTS

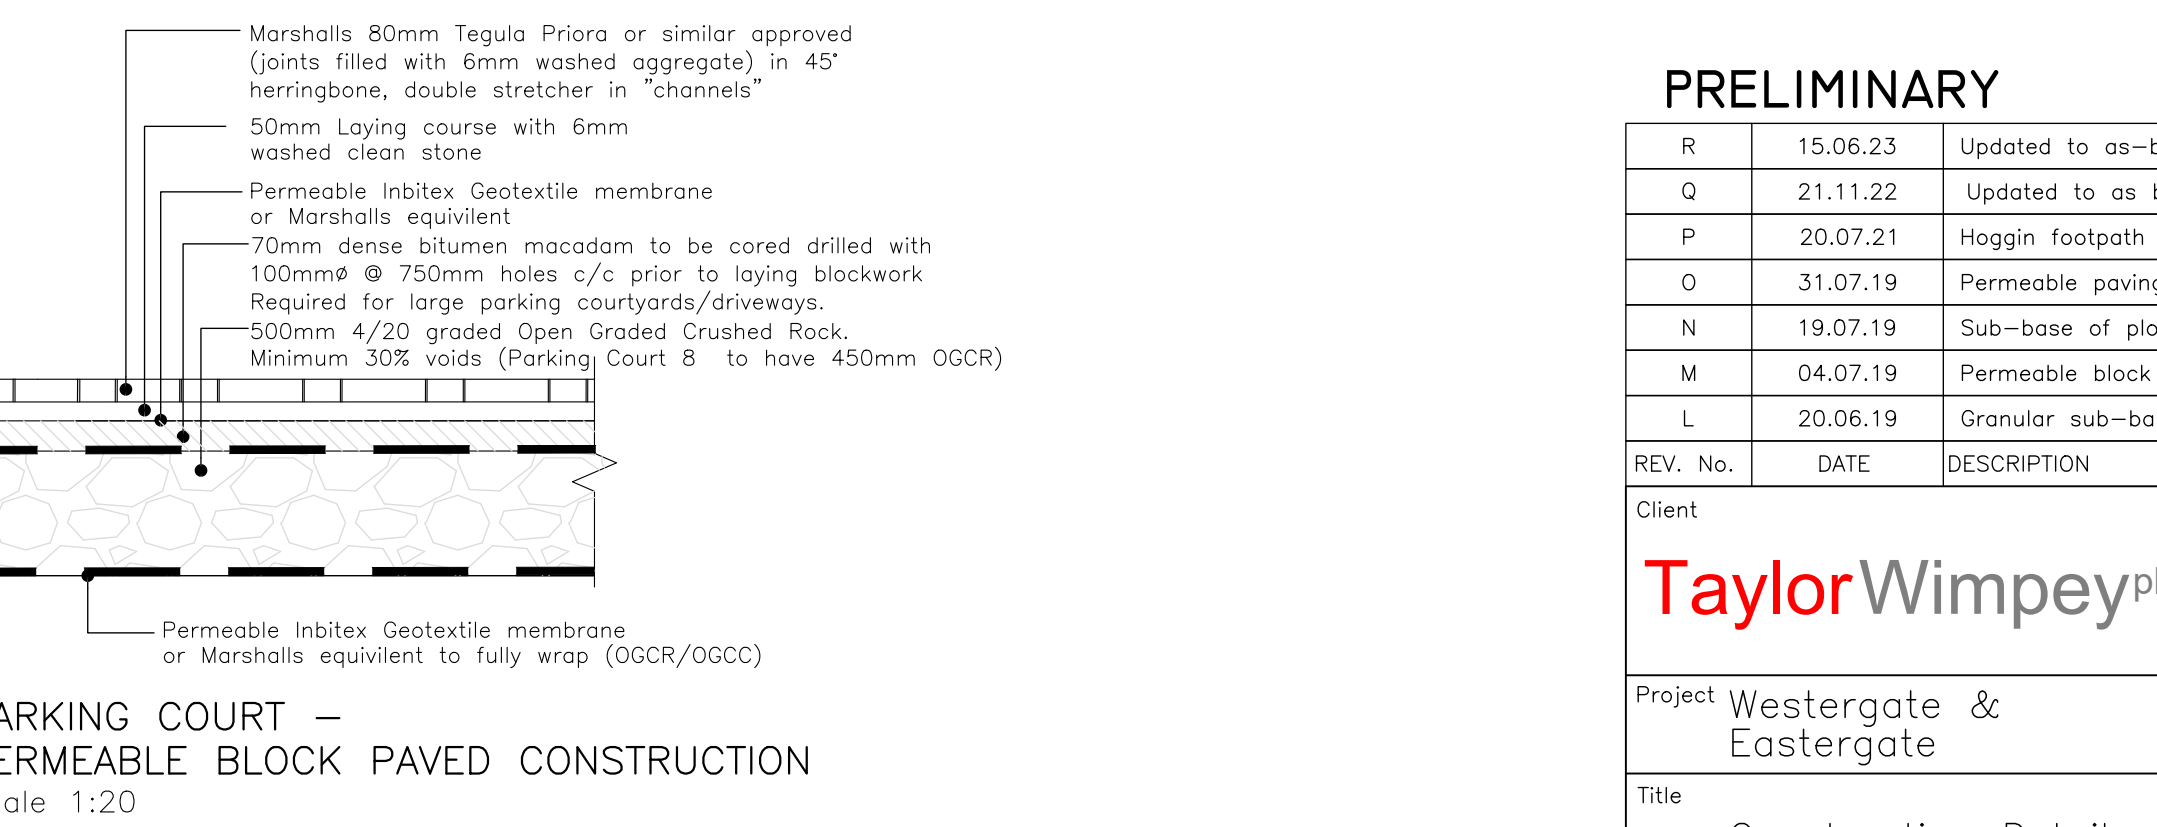

PARKING COURT - PERMEABLE BLOCK PAVED CONSTRUCTION
Scale 1:20

PRELIMINARY			
R	15.06.23	Updated to as-built 15.06.23	SS
Q	21.11.22	Updated to as built status	SS
P	20.07.21	Hoggin fastpath detail added.	TC
O	31.07.19	Permeable paving details updated.	SS
N	19.07.19	Sub-base of plot 226 updated.	SS
M	04.07.19	Permeable block paved road block type amended.	JW
L	20.06.19	Granular sub-base depths updated.	SS
REV. No.	DATE	DESCRIPTION	INITIALS
Client			
Project Westergate & Eastergate			
Title Construction Details			
Scale As Shown @ A0			
Date Sep '17			
Drawing No. 5655:20			
Rev R			