

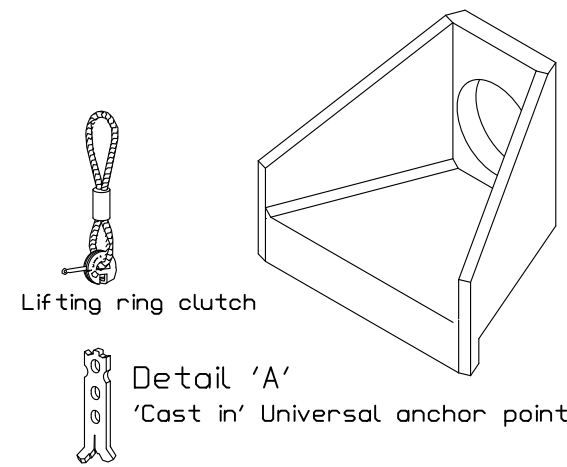
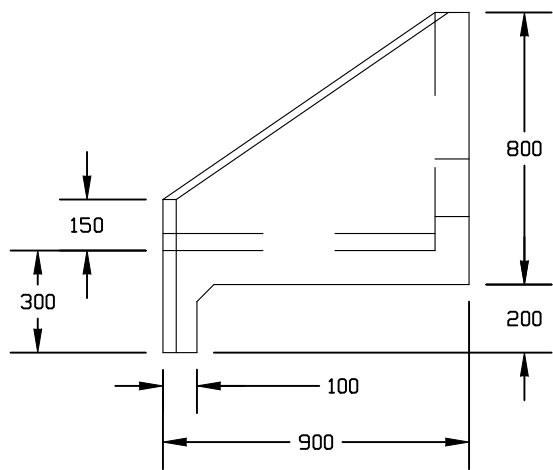
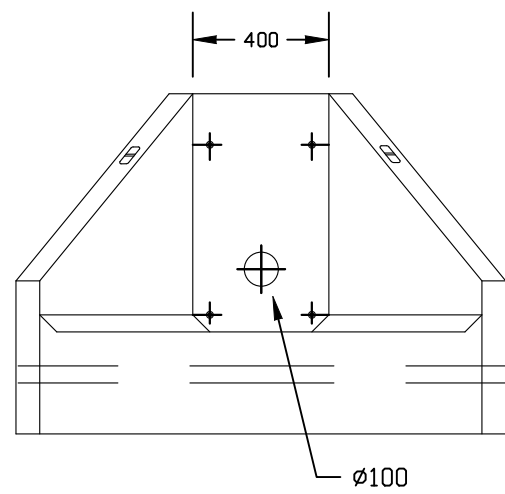


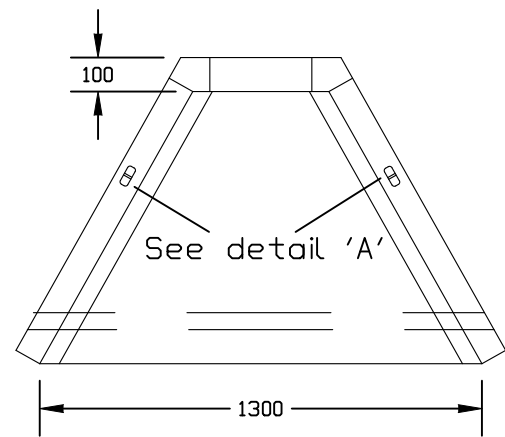


Installation
Units should be bedded on minimum 100mm of semi-dry concrete. Sit the headwall level or with a slight fall 1:50 from pipe to spill mouth.
For full detailed installation instructions contact J.K.H. Drainage Units Ltd. on Tel: 01638 713795


Material: Reinforced concrete
Weight approximately 540kg
All dimensions in mm

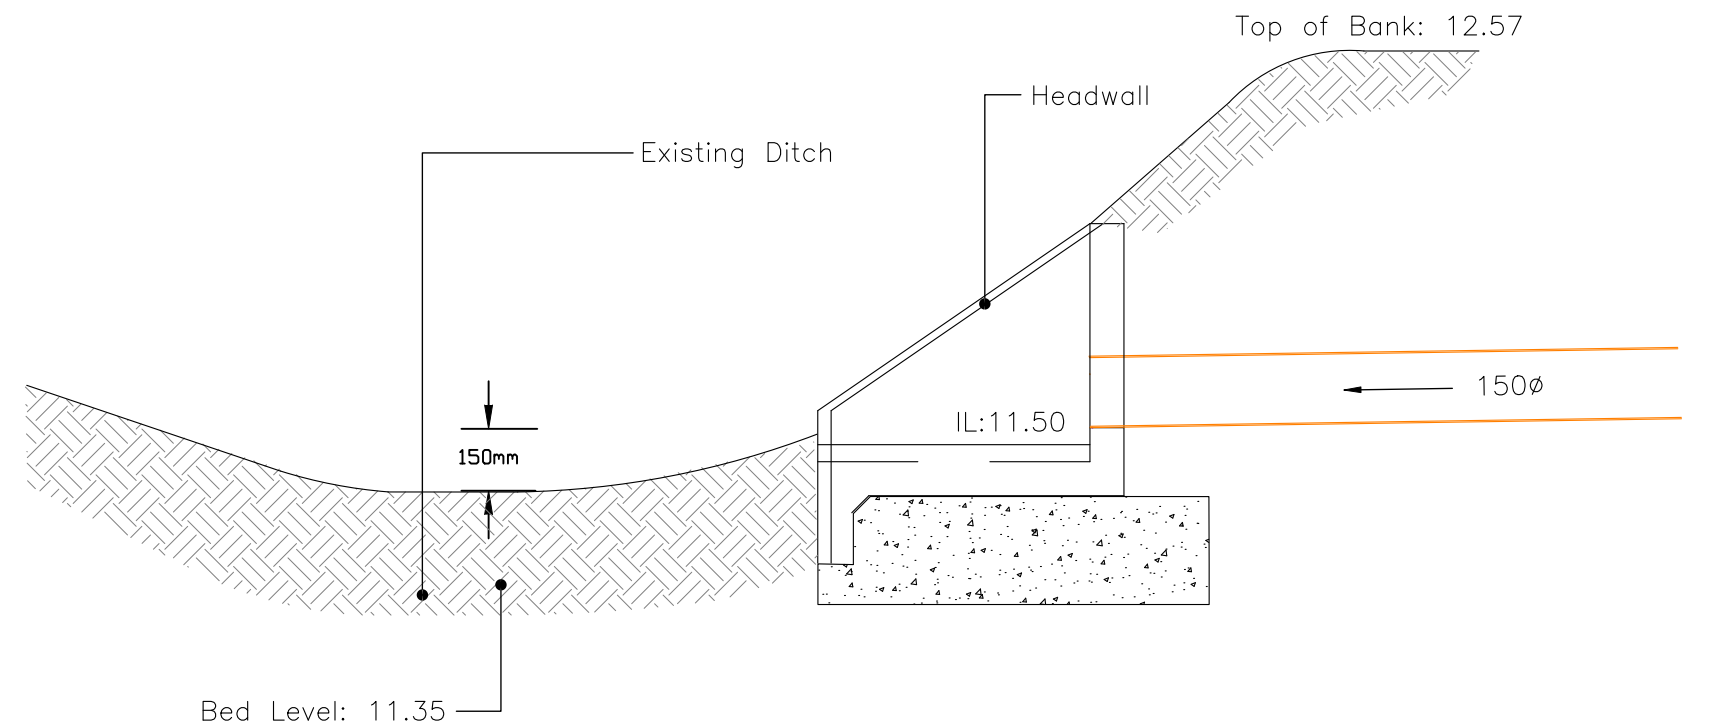

HEADWALL CONSTRUCTION DETAIL
CROSS SECTION
HEADWALL SERVING PARKING COURT 8
Scale NTS

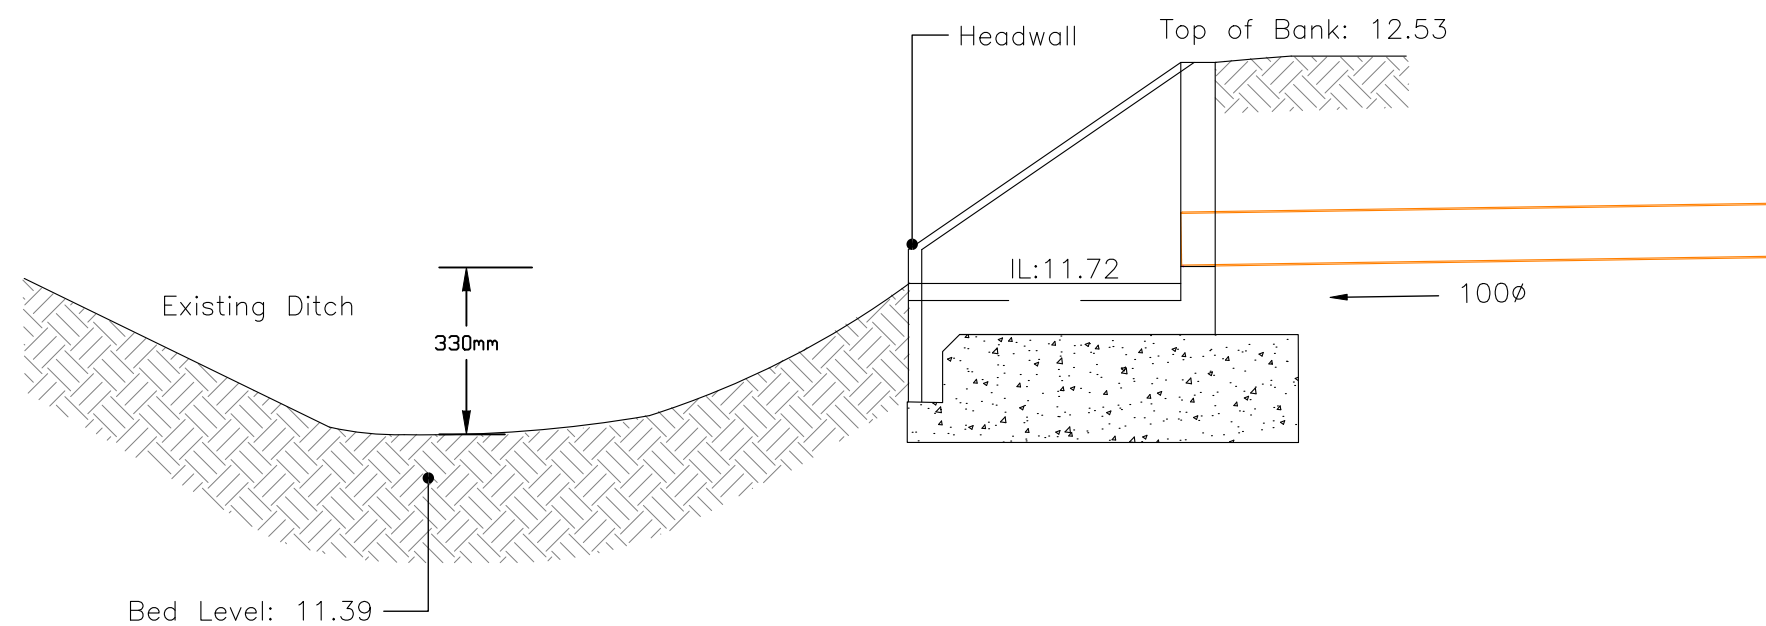

HEADWALL CONSTRUCTION DETAIL
CROSS SECTION
NORTHERN HEADWALL
Scale NTS

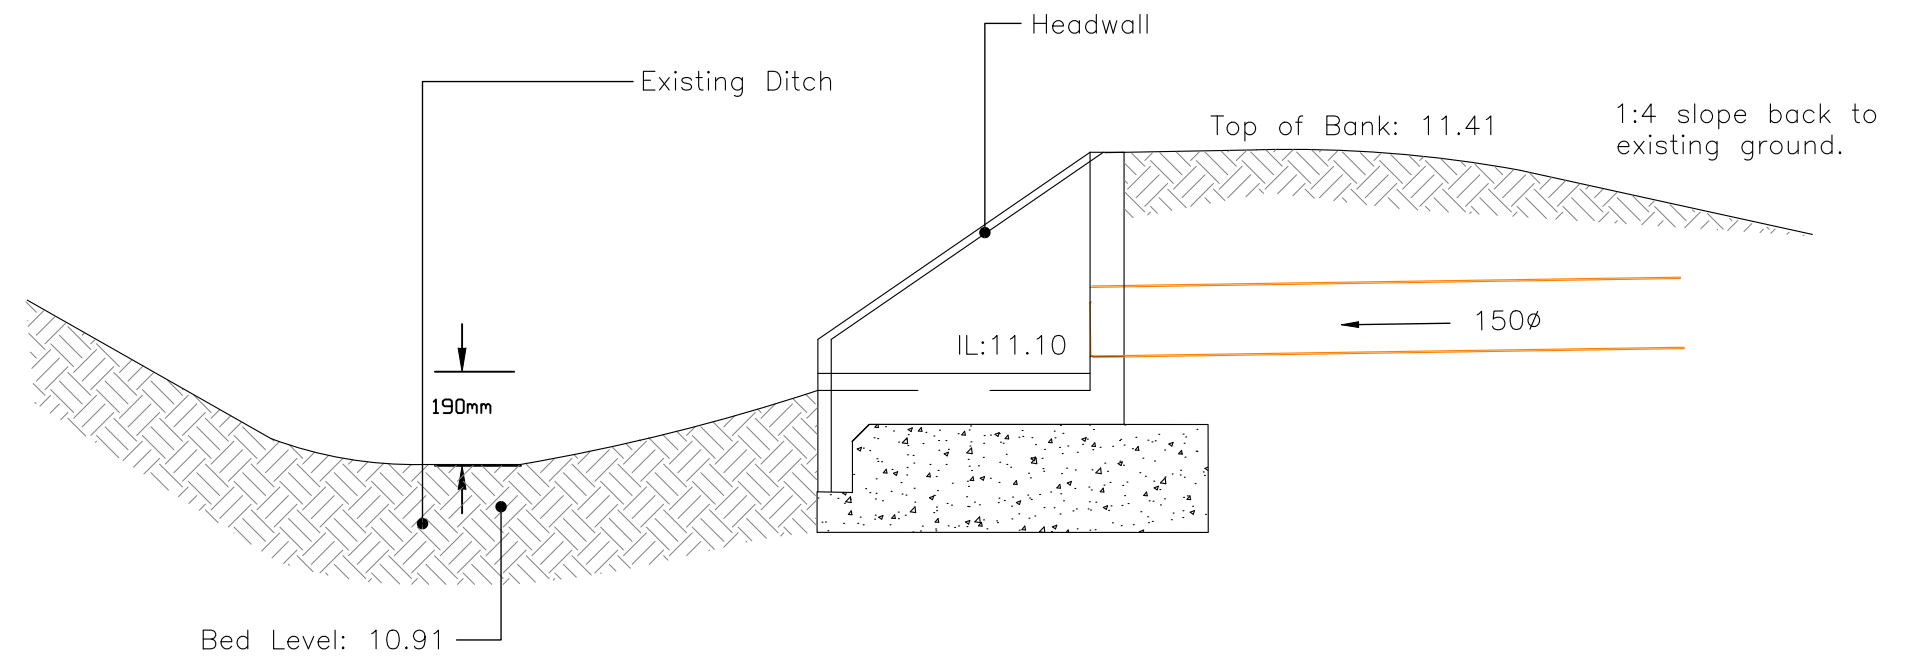

HEADWALL CONSTRUCTION DETAIL
CROSS SECTION
HEADWALL SERVING PARKING COURT 9
Scale NTS

E	15.06.23	Updated to as-built 15.06.23	SS
D	30.05.22	Updated northern headwall to achieve more freeboard.	SS
C	10.05.22	Updated to ditch regrading.	SS
B	07.03.22	Updated to councils comments.	SS
A	20.04.2018	Updated to councils comments.	SS
REV. No.	DATE	DESCRIPTION	INITIALS
Client		MJA CONSULTING	
Taylor Wimpey plc		CIVIL AND STRUCTURAL ENGINEERS	
Project Westergate & Eastergate		Monarch House, Barton Lane, Abingdon, Oxon, OX14 3NB	
Title		Scale AsShown@A2	
Headwall Details		Date Apr' 18	
Checked CP		Drawing No. 5655:23	
		Rev E	