



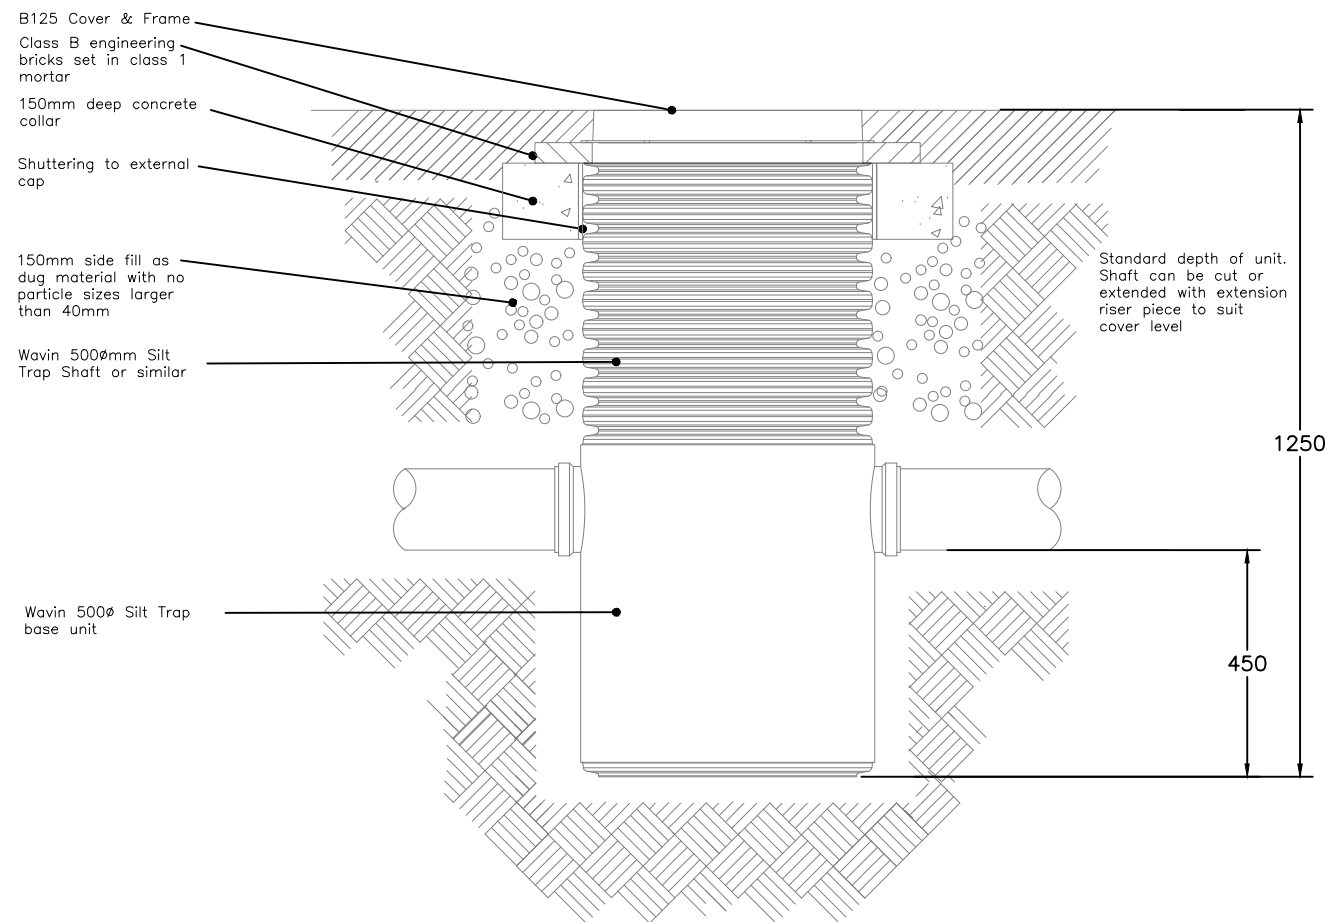

Typical Catchpit Chamber
for Driveways

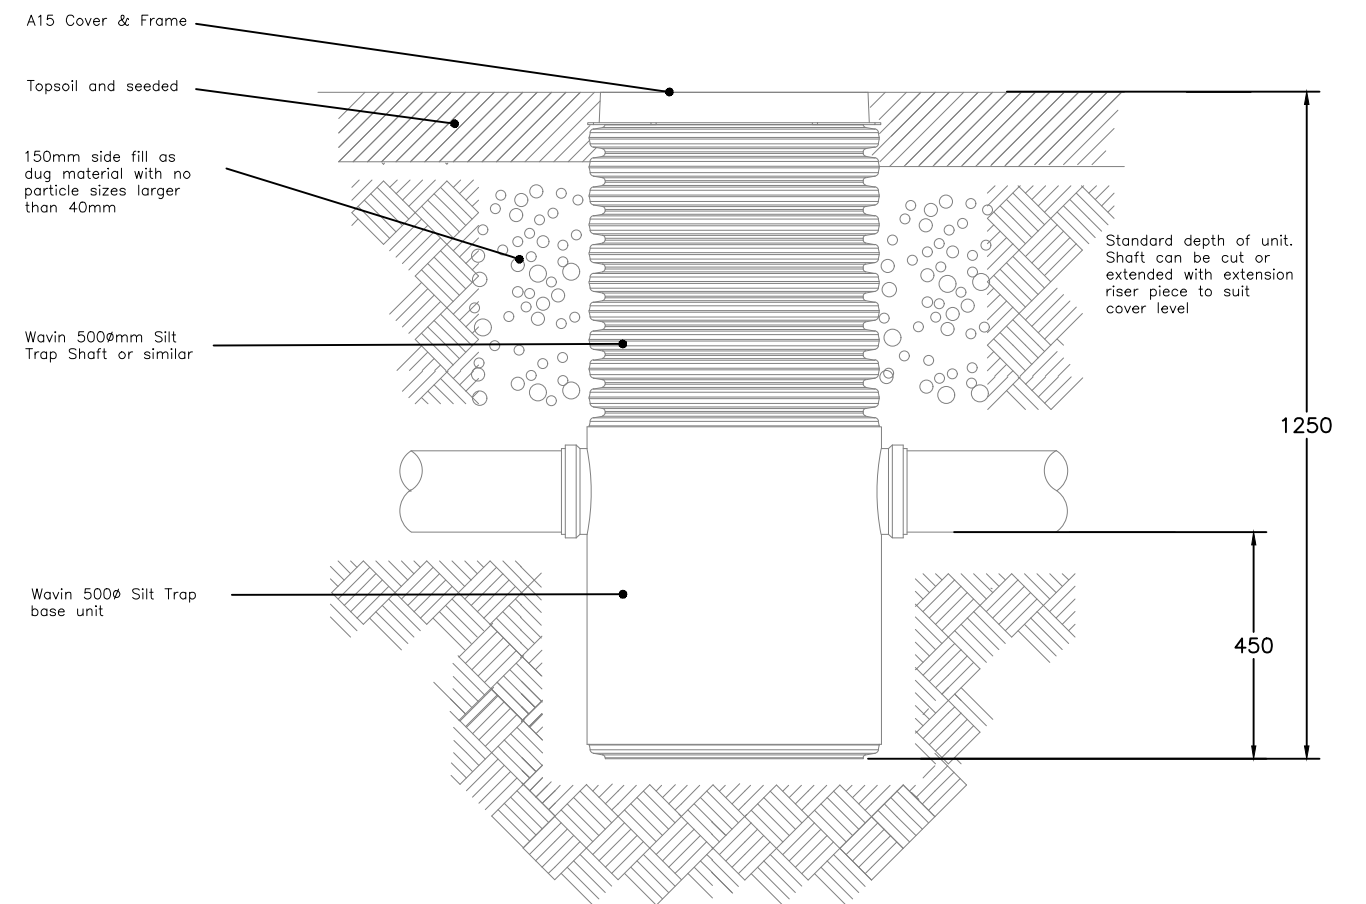

Typical Catchpit Chamber
for non-trafficked areas

REV. No.	DATE	DESCRIPTION	INITIALS			
Client			MJA CONSULTING CIVIL AND STRUCTURAL ENGINEERS Monarch House, Barton Lane, Abingdon, Oxon, OX14 3NB Tel: 01235 555173 Fax: 01235 523226 			
Project Westergate & Eastergate						
Title			Scale	Date	Drawing No.	Rev
Silt Trap Details			1:10@A2	Apr'18	5655:24	—
			Checked CP	Drawn CP		