



from
**Southern
Water**

Planning and Development Services
Arun District Council
Arun Civic Centre
Malltravers Road
Littlehampton
West Sussex
BN17 5LF

Your ref
AL/77/19/HH

Our ref
PLAN-030018

Date
14/10/2019



Dear Sirs,

Proposal: Enlarged replacement single storey extension with bathroom and dressing room in roof space.

Site: AL/77/19/HH: - 2 Tudor Cottage, Tudor Drive, Westergate, Aldingbourne, PO20 3YT.

Thank you for your letter dated 07/10/2019.

Please find attached a plan of the sewer records showing the approximate position of a public foul sewer crossing the site. The exact position of the public foul sewers must be determined on site by the applicant.

Please note:

- The 150mm diameter gravity foul sewers requires a clearance of 3 metres on either side of the gravity sewers to protect it from construction works and to allow for future access for maintenance.
- No development or tree planting should be carried out within 3 metres of the external edge of the public gravity sewer without consent from Southern Water.
- No soakaways, swales, ponds, watercourses or any other surface water retaining or conveying features should be located within 5 metres of a public sewers.
- All existing infrastructure should be protected during the course of construction works.

Furthermore, it is possible that a sewer now deemed to be public could be crossing the development site. Therefore, should any sewer be found during construction works, an investigation of the sewer will be required to ascertain its ownership before any further works commence on site.

Southern Water Developer Services, Sparrowgrove House, Sparrowgrove, Otterbourne, Winchester, Hampshire, SO21 2SW
southernwater.co.uk

Southern Water Services Ltd, Registered Office: Southern House, Yeoman Road, Worthing BN13 3NX Registered in England No. 2386670

Southern Water requires a formal application for any new connection to the foul sewer to be made by the applicant or developer. We request that should this application receive planning approval, the following informative is attached to the consent:

A formal application for connection to the public sewerage system is required in order to service this development. Please read our New Connections Services Charging Arrangements documents which has now been published and is available to read on our website via the following link <https://beta.southernwater.co.uk/infrastructure-charges>

The disposal of surface water from this development should be in compliance with the following hierarchy of Part H3 of Building Regulations:

- a) An adequate soakaway or some other adequate infiltration system.
- b) A water course.
- c) Where neither of the above is practicable: a sewer.

Due to surface water inundation issues in the Lidsey Catchment the applicant is advised to adopt, where appropriate, the measures in the table "Practical measures to reduce the potential impacts of development". Developer should look to protect the public sewerage system from inundation and infiltration, which contribute to flooding in unfavourable conditions.

For further advice, please contact Southern Water, Sparrowgrove House, Sparrowgrove, Otterbourne, Hampshire SO21 2SW ([REDACTED]


Yours sincerely,

[REDACTED]
Tim Peacock-Bjurström
Technical Delivery Lead
Business Channels

Practical measures to reduce the potential adverse impacts of development

Reasons	Practical measures
Adequate and sustainable surface water drainage.	No surface water connections to the wastewater system. (See part H of the Building Regulations)
Guard against further groundwater infiltration into the foul drains or sewers serving the development.	The use of fusion jointed MDPE pipes can prevent groundwater infiltration and require a minimum of maintenance. The use of mass concrete surrounds to inspection chambers and manholes can prevent infiltration and require a minimum of maintenance
Guard against surface floodwaters entering the foul system serving the development.	Overland surface water flow routes should be provided for flows greater than those for which pipelines and culverts have been designed. Wherever possible, foul sewer routes, manhole covers, sink waste gullies, etc. should avoid overland surface water flow routes and any areas where surface water ponding may occur. Failing that they should be sealed against potential surface water inflows. Any sink waste gullies in areas of potential surface water inundation should be sealed or defended by raised brickwork or similar Bolt down sealed inspection chamber and manholes covers should be used in areas of potential surface water inundation. Raising the level of the development above the highways which serve it can protect buildings and their drainage systems from potential surface water inundation. However, care should be taken at local low spots in the highway where overland surface water flows may gather and overflow onto properties.
Protect the properties from foul flooding or unusable sanitation should the public sewerage system surcharge.	Part H of the Building Regulations contains suitable practical measures. However, the provision of an external gully is inappropriate where there is a risk of surface water flooding. In these circumstances, non-return valves are more appropriate. Dirigo or similar non-return air valves are now commonly fitted to soil vent pipes thereby allowing them to allow them to vent within the building. This practice can lead to problems with bubbling WCs, the blow out of U bend traps and odour within buildings when the sewerage system surcharges. The use of traditional external vent pipes without air valves can prevent this.

SOUTHERN WATER

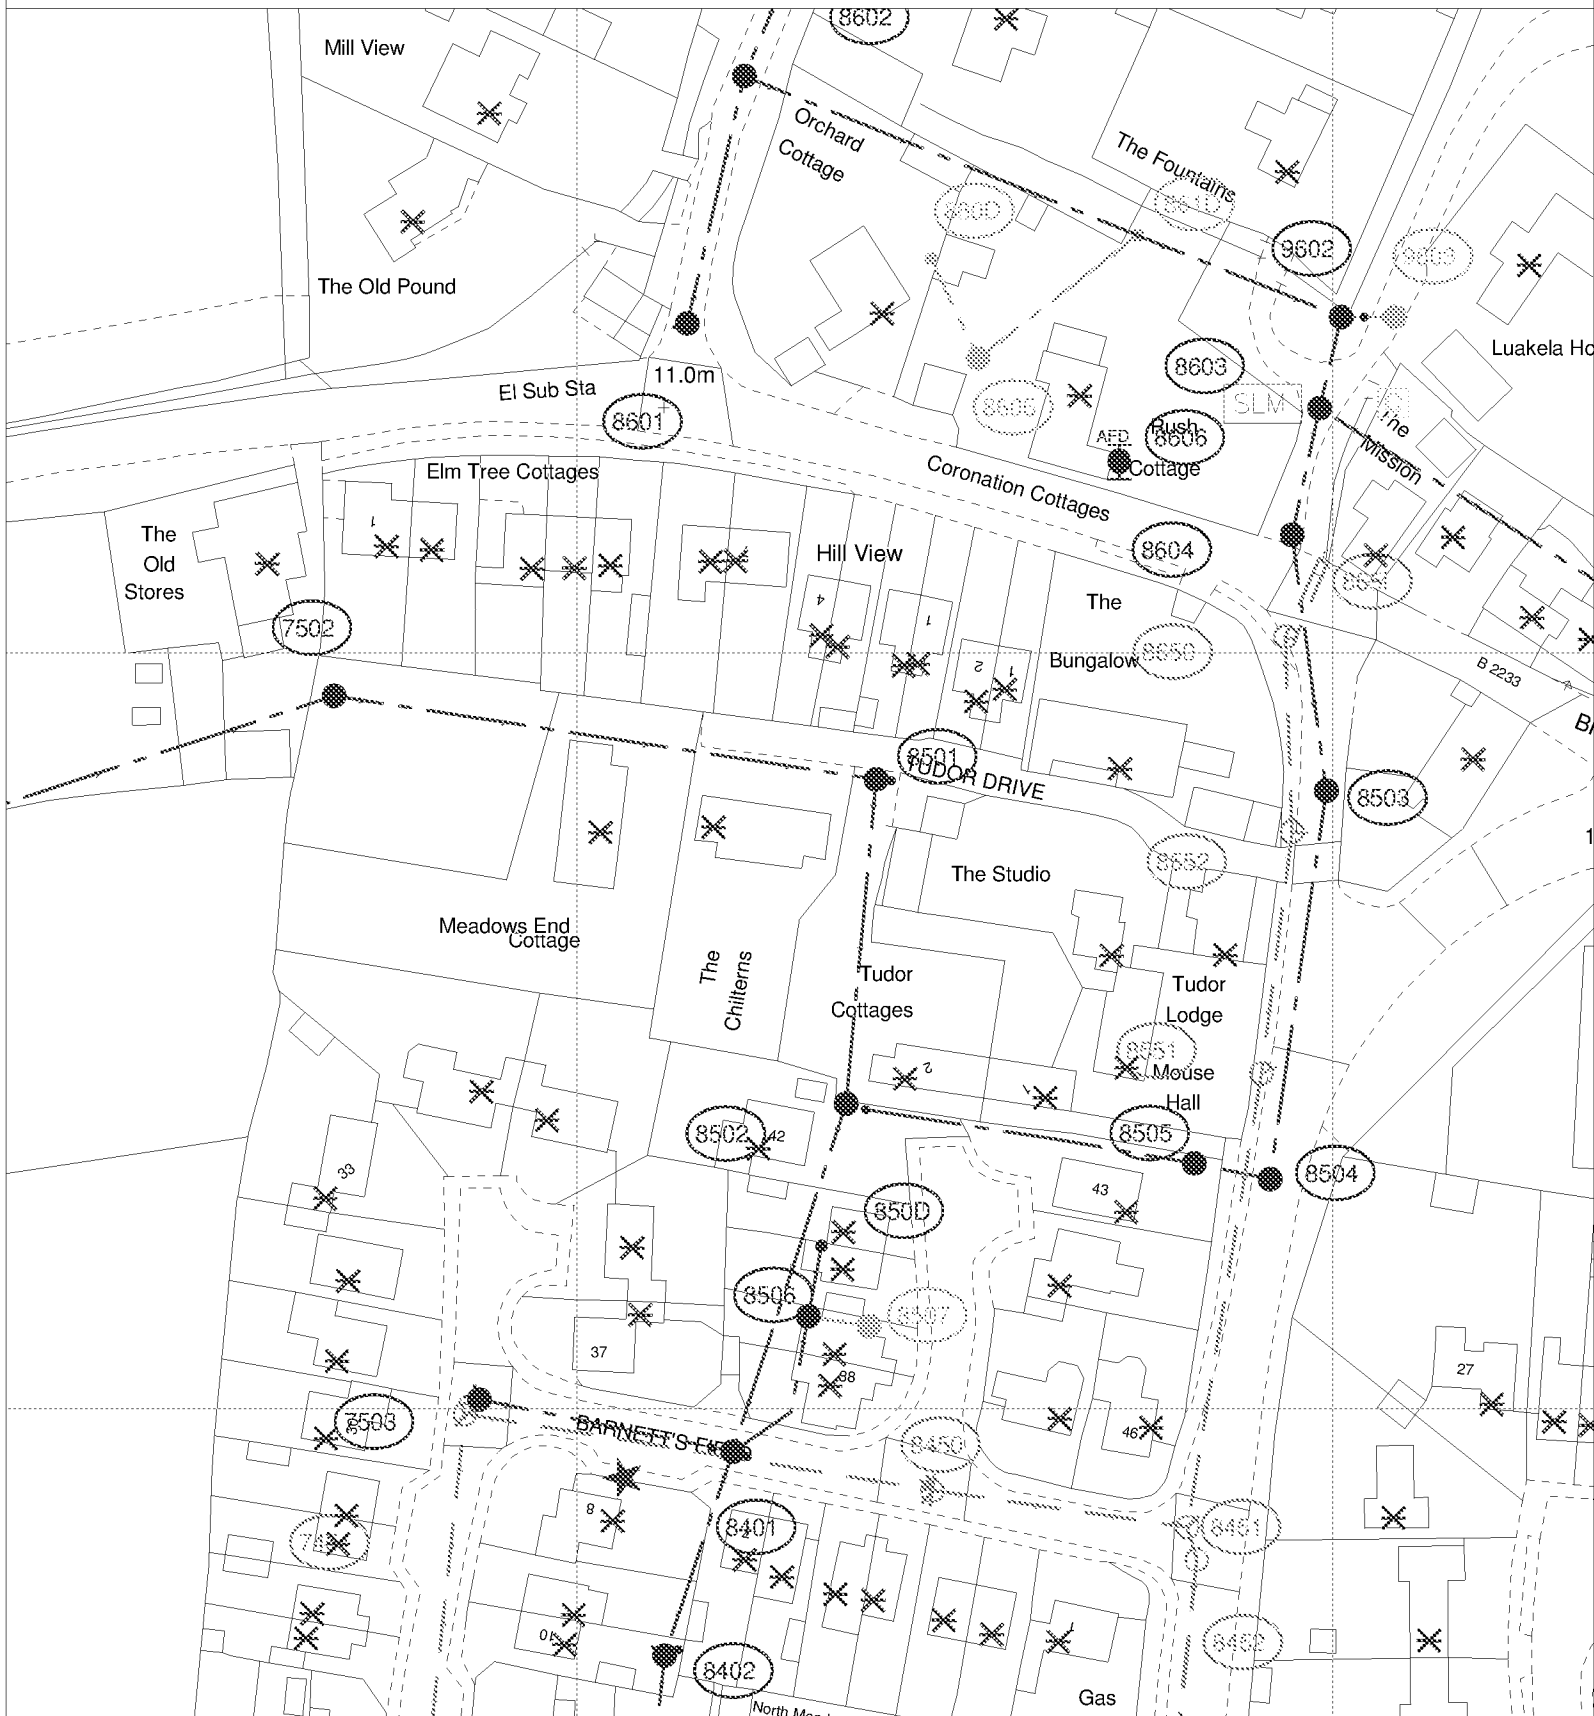

The positions of pipes shown on this plan are believed to be correct, but Southern Water Services Ltd accept no responsibility in the event of inaccuracy. The actual positions should be determined on site.

Based upon Ordnance Survey Digital Data with the permission of the controller of H.M.S.O. Crown Copyright Reserved Licence No. WU 298530

O.S. REF: SU9305NE

Scale: 1:1000

Screen Print

ARUN DISTRICT COUNCIL AD7/19/HH

WARNING: BAC pipes are constructed of Banded Asbestos Cement

WARNING: Unknow (HUK) materials may include Banded Asbestos Cement



Printed By: chandne

Date: 11-10-2019

Southern Water MapGuide Browser

Requested By: