



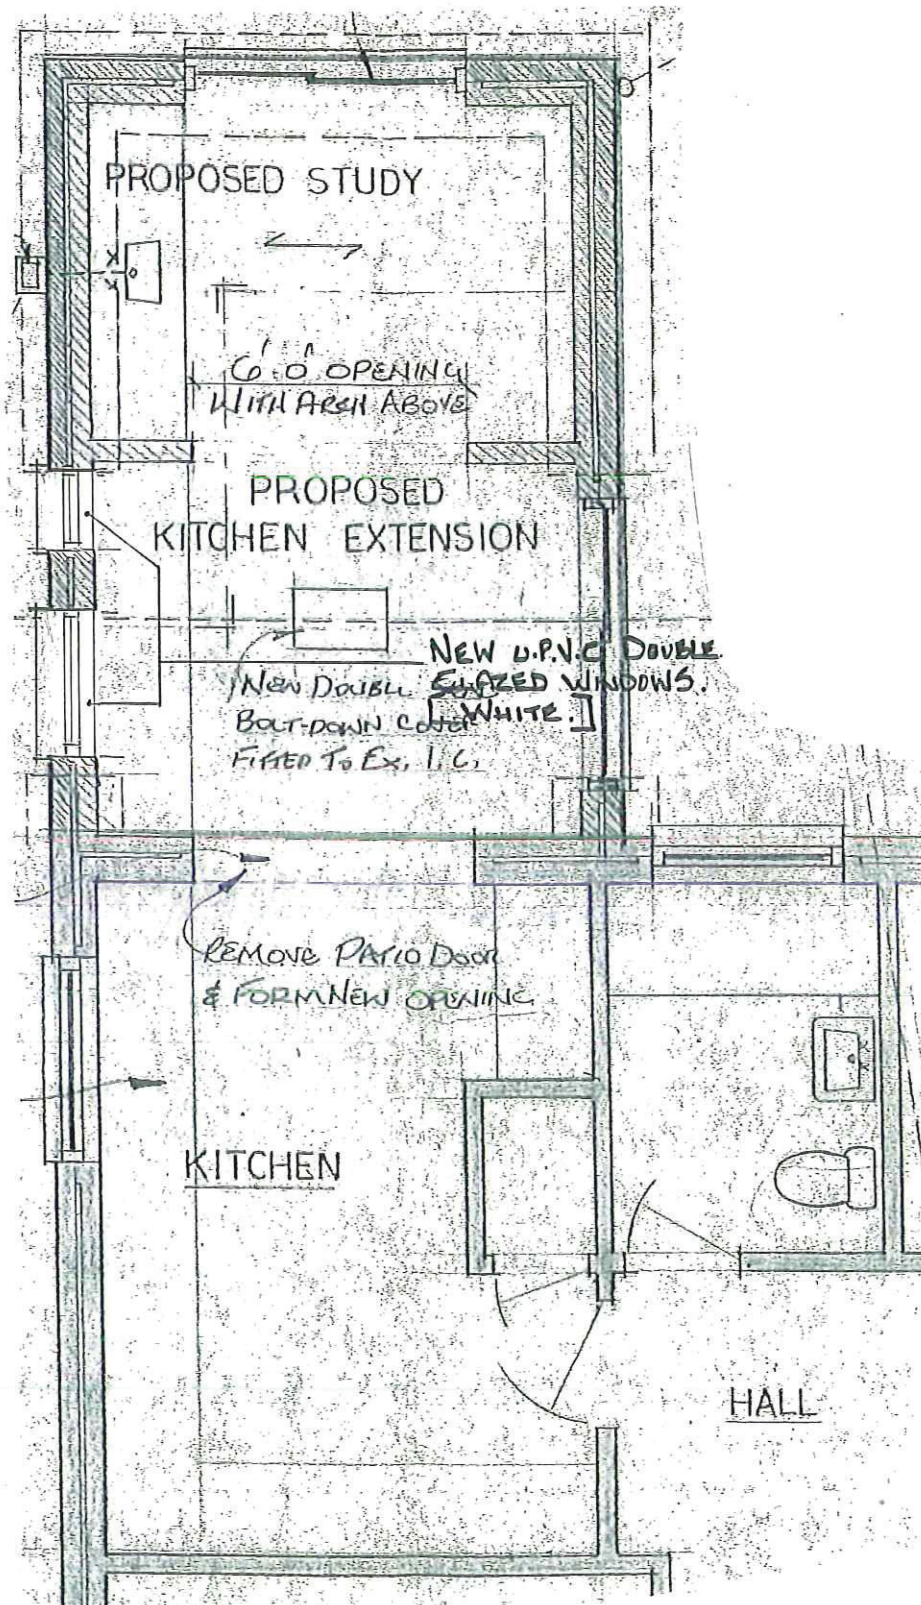

PART GROUND FLOOR. SHOWING
NEW WINDOWS.
[1:50]

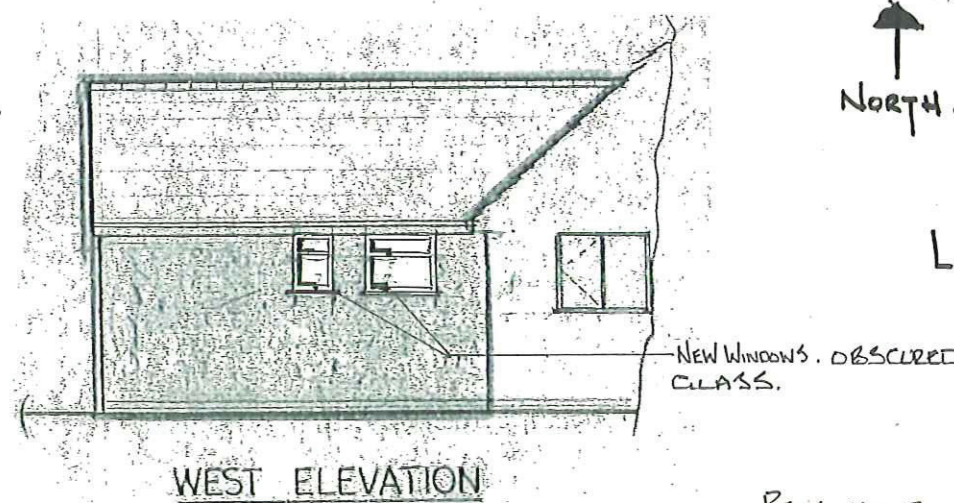


[1:100.]



LOCATION PLAN. [1:1250]

- NOTES:
1. Do not scale this drawing. Use figured dimensions only, except for Planning purposes.
 2. All dimensions must be checked on site by the contractor prior to commencement of work.
 3. All construction details are indicative and are to be checked and confirmed on site and any divergence's are to be agreed with the Contract Administrator.

THIS DRAWING TO BE READ IN-CONJUNCTION WITH THE BUILDING CONTROL AND CONSTRUCTION NOTES

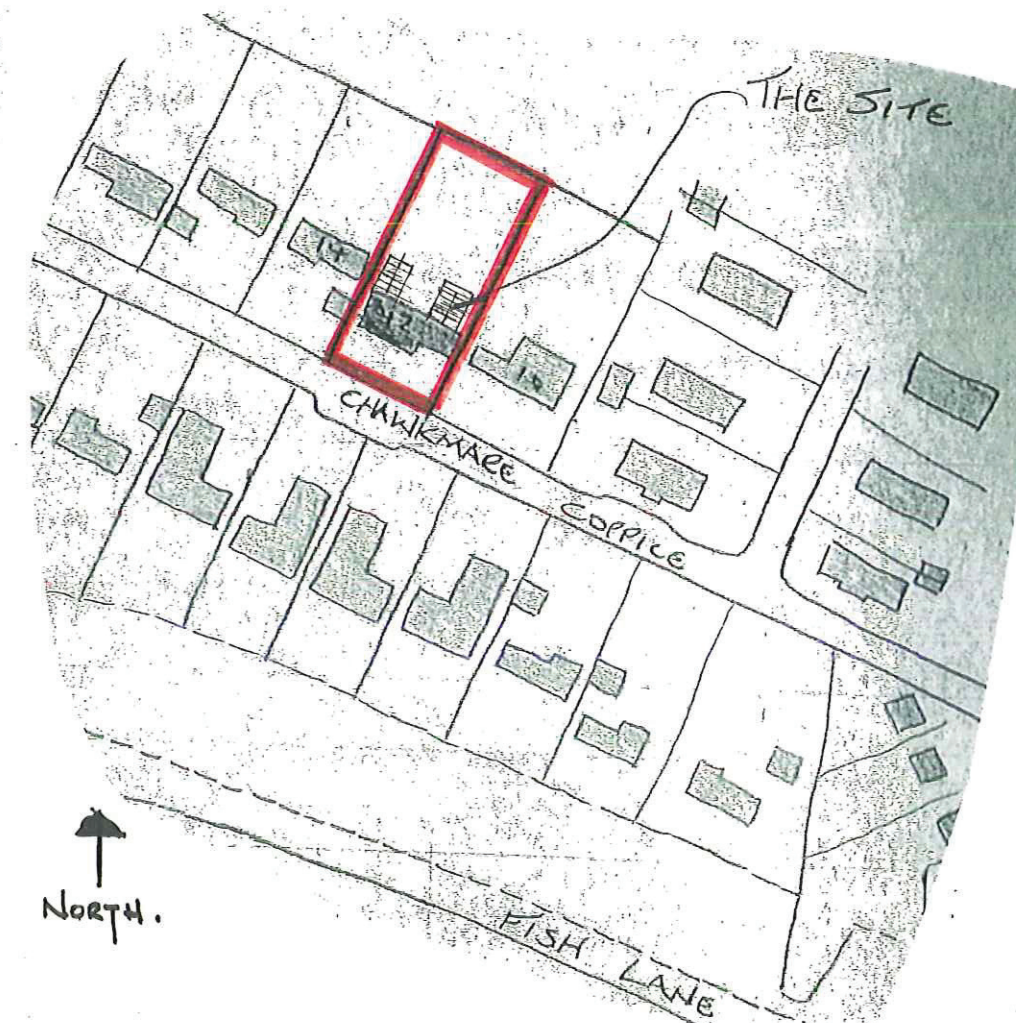

THIS IS AN EXTRACT FROM DWG N° E647
PREVIOUSLY APPROVED UNDER REF N° BR/230/83
ON 14/3/83.
NEW REF N° ENF/201/12.

REV. A. MAY. 12. LOCATION PLAN
AMENDED.
REV. B. JUNE 12. SCALE
AMENDED & NORTH ARROW
ADDED.

K.E. HILTON AND ASSOCIATES
Chartered Structural Engineers
2 ALBERT CHAMBERS
SUDLEY ROAD
BOGNOR REGIS
WEST SUSSEX
PO21 1EQ
Tel: 01243 865500
Fax: 01243 860489
Mobile: 07968 333140
E-Mail: k_e_hilton@yahoo.co.uk

PLANS & ELEVATION. [AS REDLINED.]			
Scale	AS NOTED. @ A3	Drawn By	
Date	MAY. 12.	Checked	
Drawing Number	4682/1 x B.		

NEW WINDOWS TO WEST ELEVATION - 12 CHALKMAZE COPPICE, ALDWICK. PO21 3SA.