






Front Elevation Proposed (West)
Remains as existing
Scale 1:100

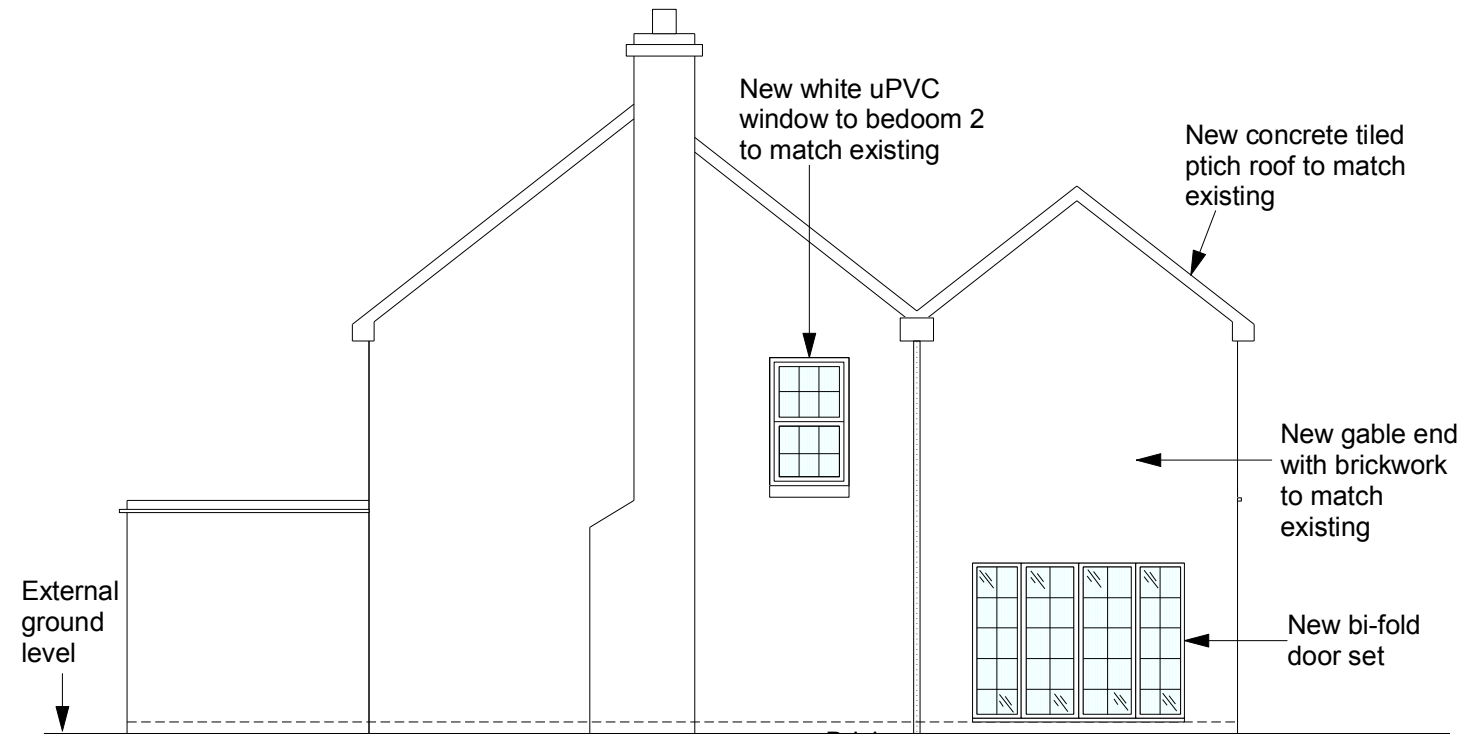

Side Elevation Proposed (South)
Scale 1:100

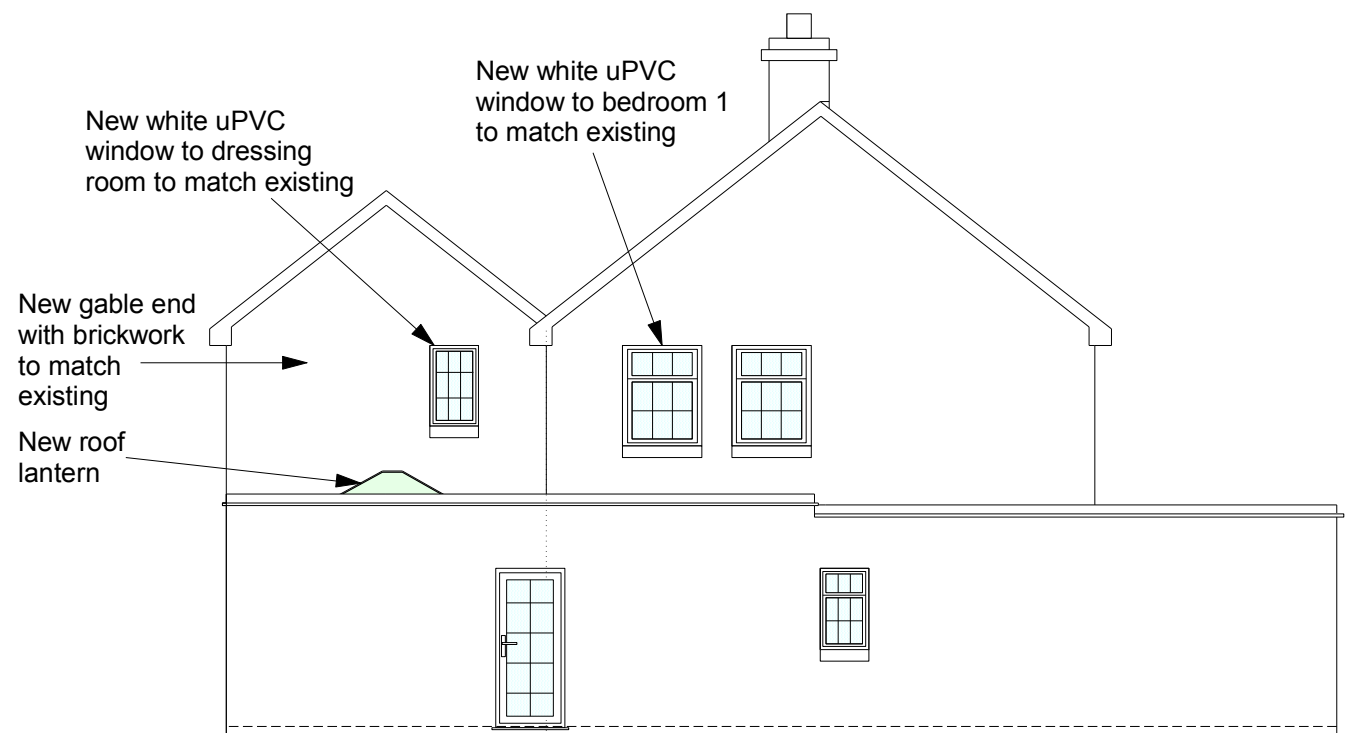

Side Elevation Proposed (North)
Scale 1:100

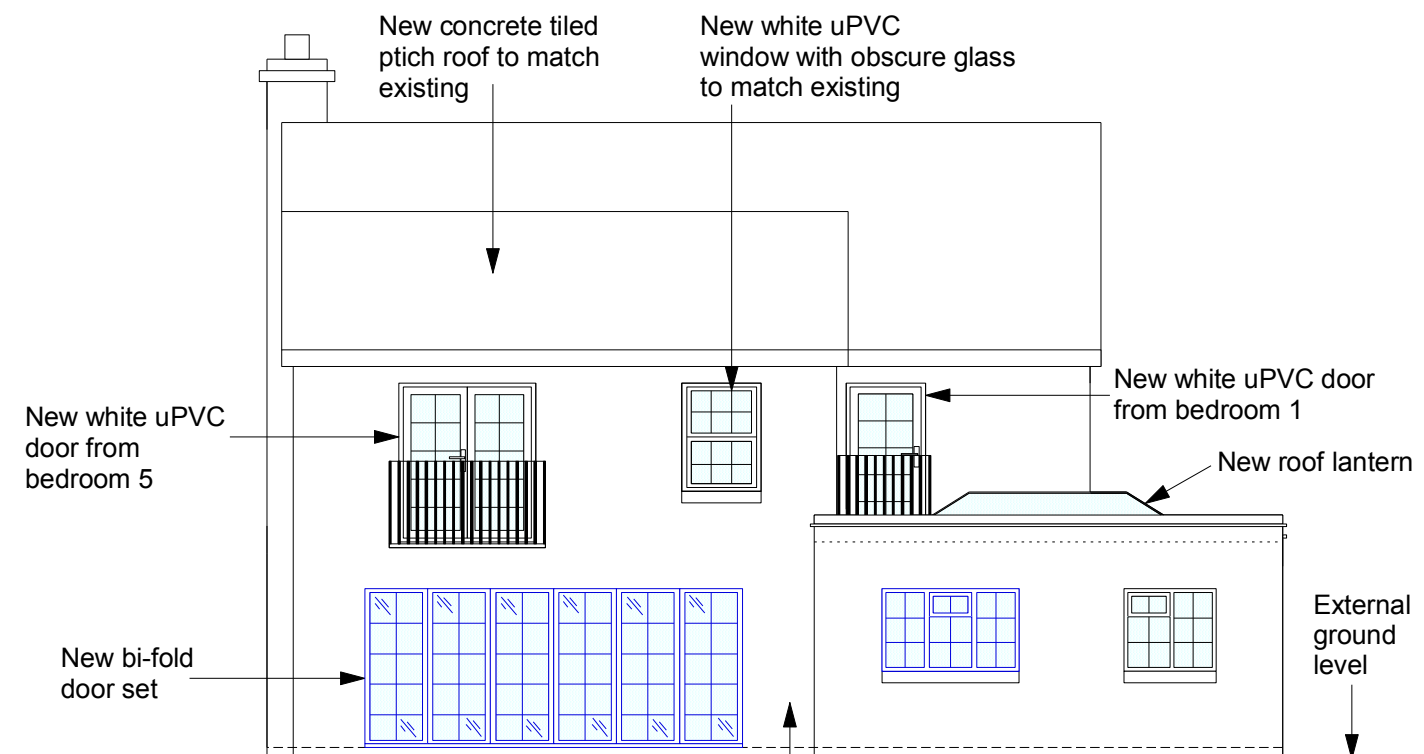

Rear Elevation Proposed (East)
Scale 1:100

Non Material Amendment application notes:

1. Removal of french doors to retain exsiting window on rear elevation proposed (shown in blue line for clarity)
2. New bi-fold door arrangment enlarge on rear elevation proposed (shown in blue line for clarity)

Non Material Application - AW/223/17/HH

All dims and details to be checked on site prior to any commencement of work. This plan is not a full specification or schedule of work and has been produced solely for the purpose of obtaining the necessary local authority consents/approvals For Party Wall etc. Act 1996 see Government booklet or website.	Status:			Client: Mr A Betes 5 Larchfield Close Aldwick Bognor Regis West Sussex PO21 4RB	Revision: C	Project: Extension
	Preliminary	☐	Tender	☐	Scale: 1:100@A3	Content: Proposed elevations
	Planning	☒	Construction	☐	Date: April 18	
	Building Regulations	☐	As Built	☐	Dwg No: AB003	