




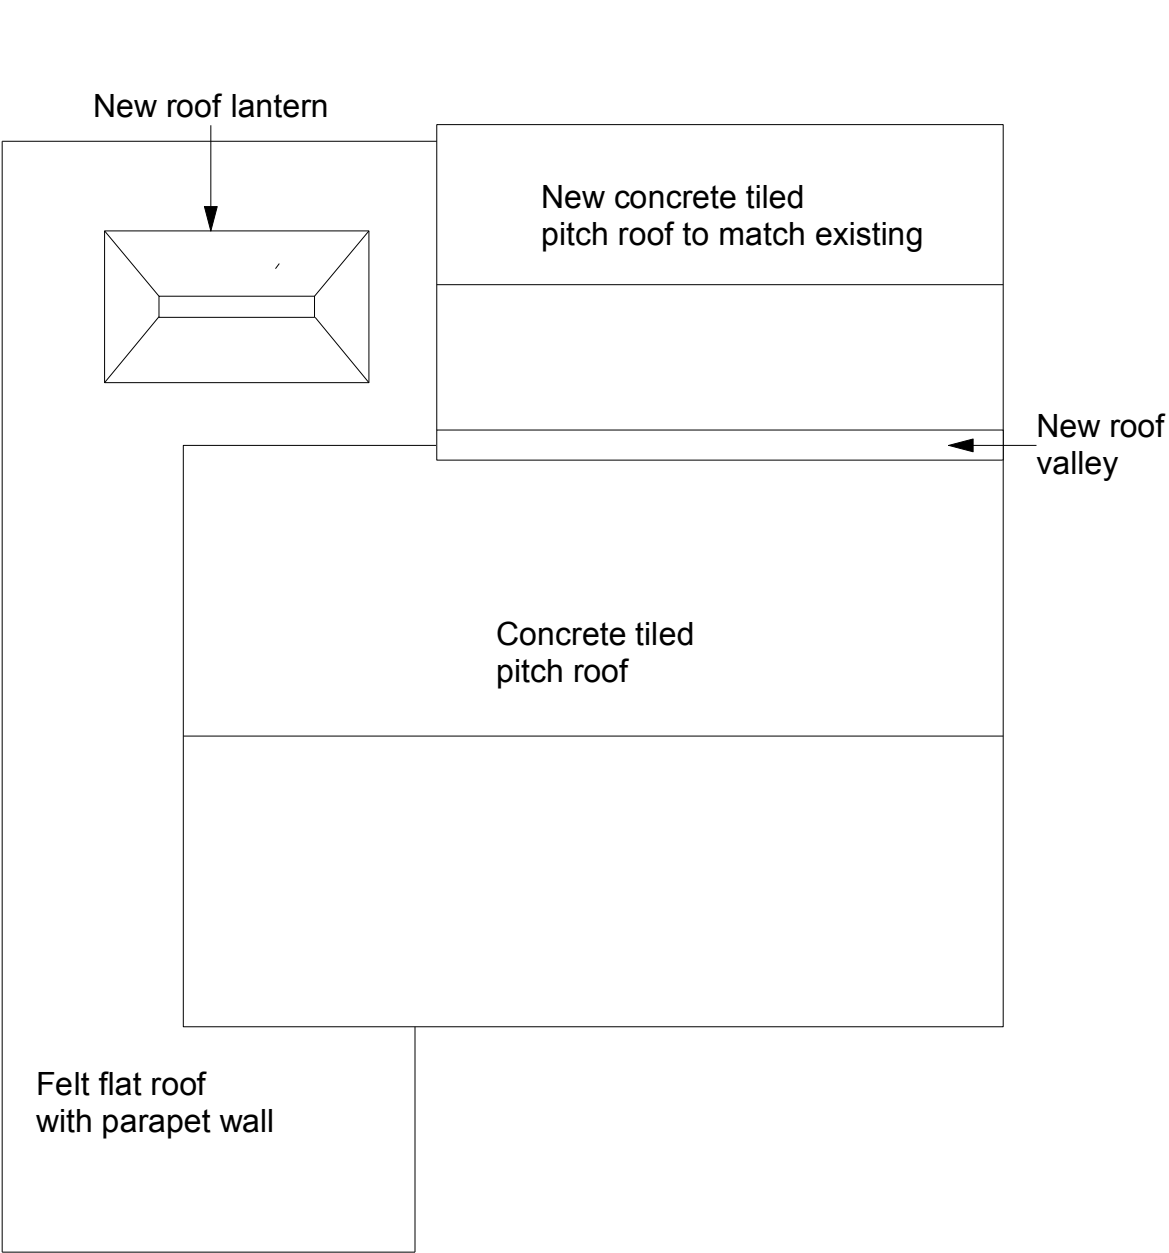

Roof Plan Proposed
(Chimney not shown)
Scale 1:100

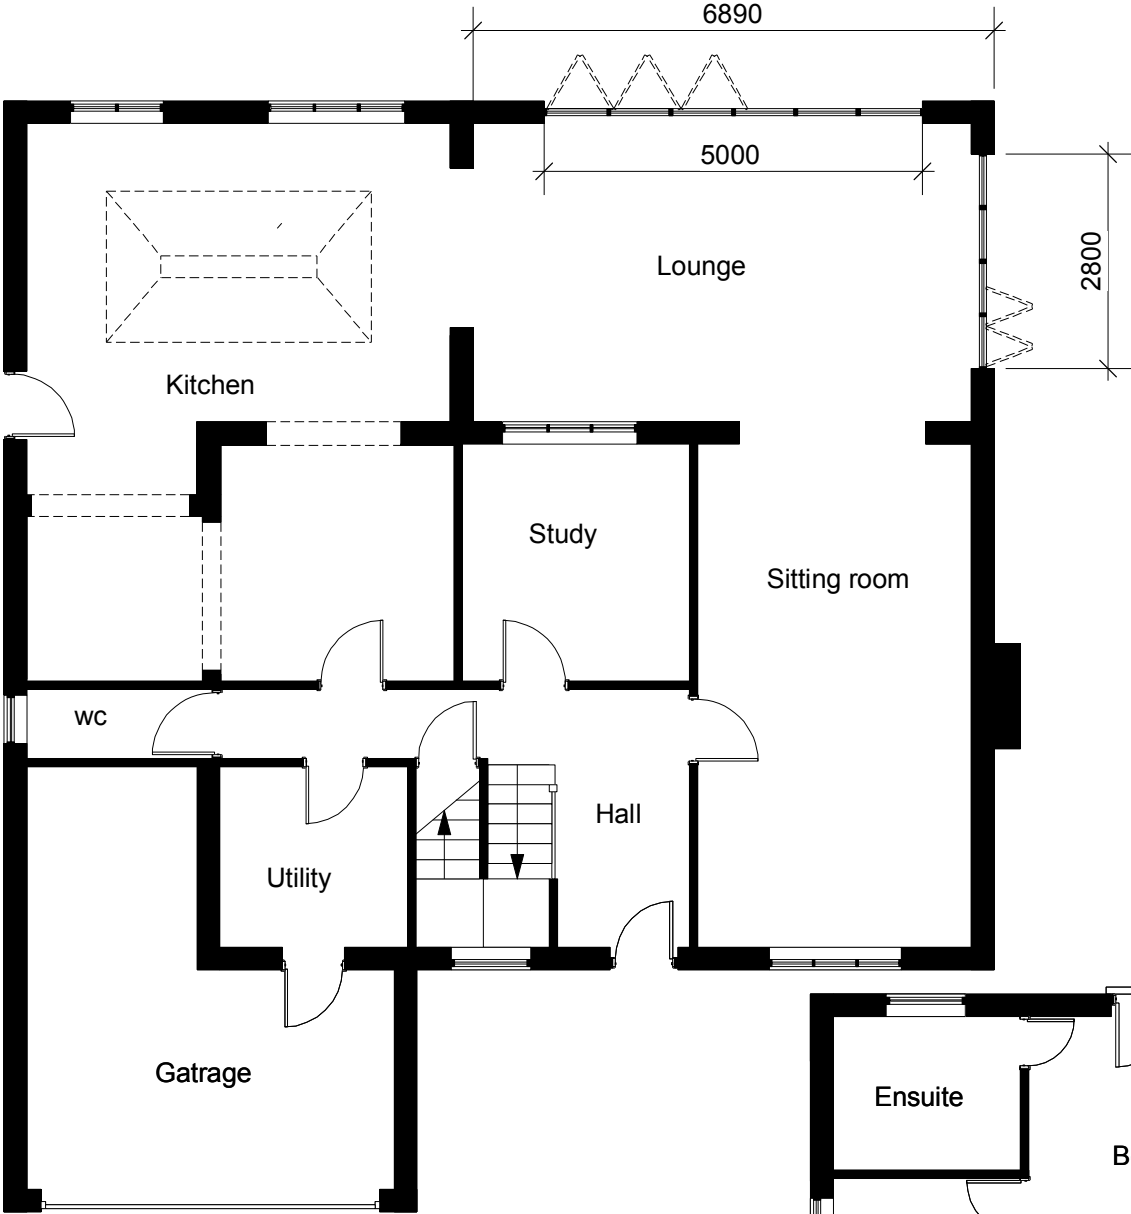

Ground Floor Plan Proposed
Scale 1:100

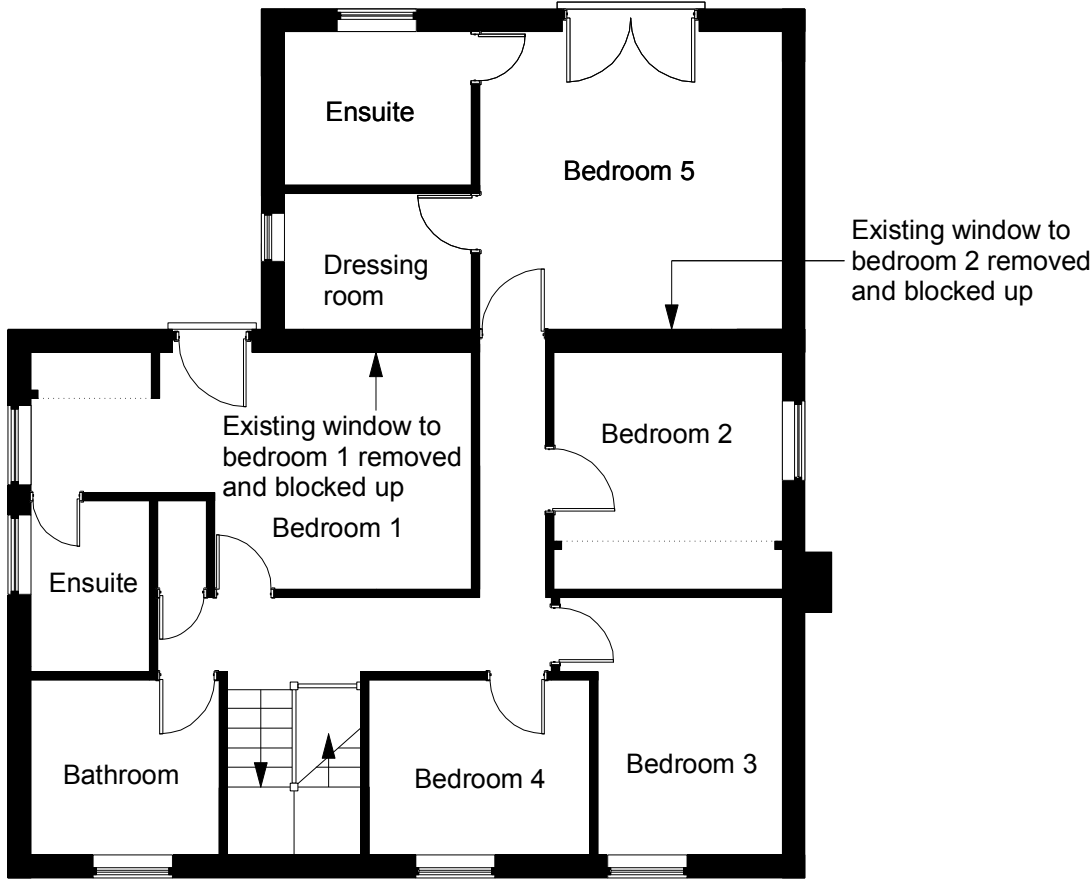

First Floor Plan Proposed
Scale 1:100

Non Material Amendment application notes:
1. Removal of french doors to retain exsiting window on rear elevation proposed
2. New bi-fold door arrangment enlarge on rear elevation proposed

Non Material Application - AW/223/17/HH

All dims and details to be checked on site prior to any commencement of work. This plan is not a full specification or schedule of work and has been produced soley for the purpose of obtaining the necessary local authority consents/approvals For Party Wall etc. Act 1996 see Government booklet or website.	Status:		Client: Mr A Betes 5 Larchfield Close Aldwick Bognor Regis West Sussex PO21 4RB	Revision: C	Project: Extension
	Preliminary	☐ Tender ☐		Scale: 1:100@A3	Content: Proposed floor and roof plans
	Planning	☒ Construction ☐		Date: April 18	
	Building Regulations	☐ As Built ☐		Dwg No: AB004	