


This drawing is the copyright of the Architect and must not be reproduced or used without the Architect's permission. Figured dimensions are to take precedence over scaled dimensions. The Contractor is responsible for checking all figured dimensions on drawings against actual site dimensions. Scaled dimensions are not to be used for construction and setting out purposes. Any discrepancies are to be reported to the Architect. This drawing should be read in conjunction with schedules, specifications and engineers drawings and details where applicable.

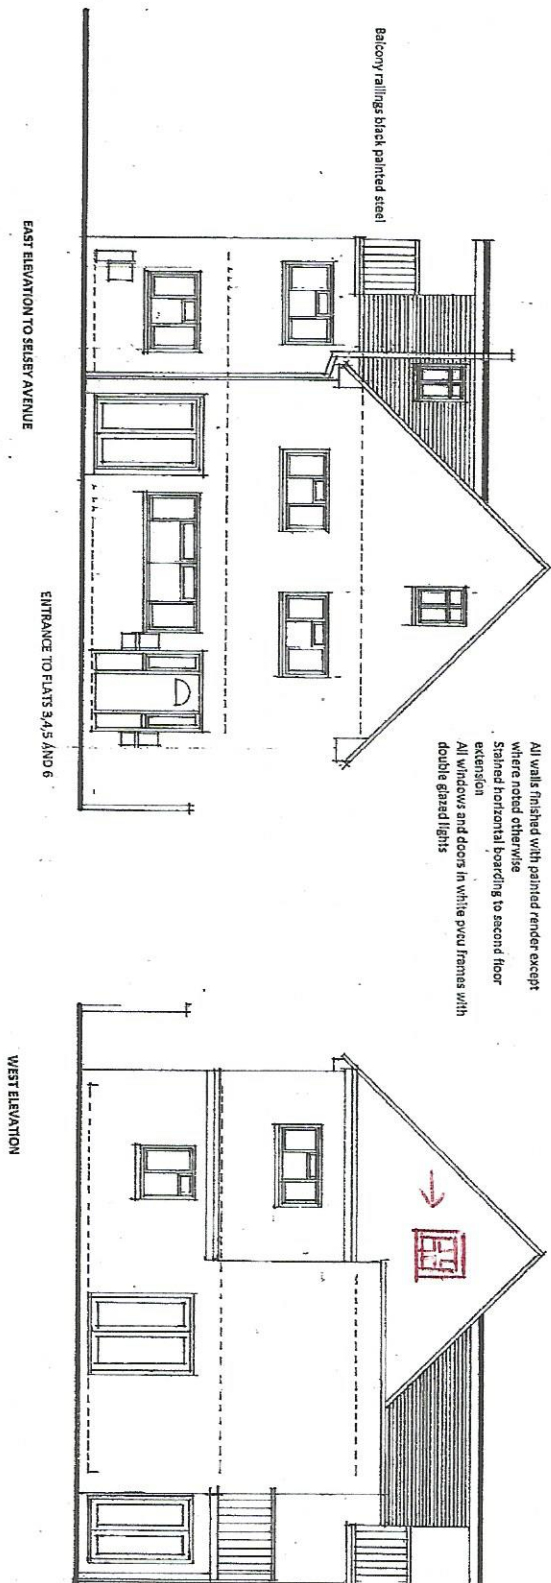

DAVID BENNETT ARCHITECTS

THE OLD COTTAGE

10 WICKARAGE LANE, FELPHAM

WEST SUSSEX PO22 7EA

01243 842619 and 07932 757144

Email: david@kenneth7@gmail.com

CLIENT

CS PROPERTY AND CONSULTANCY LTD

PROJECT

THE PEARL, 3 SELSEY AVENUE

BOGNOR REGIS PO21 2BZ

DRAWING TITLE

AS BUILT DRAWINGS

EAST AND WEST ELEVATIONS

SCALE

1/100 at A3

REFERENCE

11338.05