


Existing roof retiled in red interlocking tile to match original

All walls finished in painted render except where noted otherwise

Stained horizontal boarding to second floor extension

All windows and doors in white pvcu frames with double glazed lights

Balcony railings black painted steel

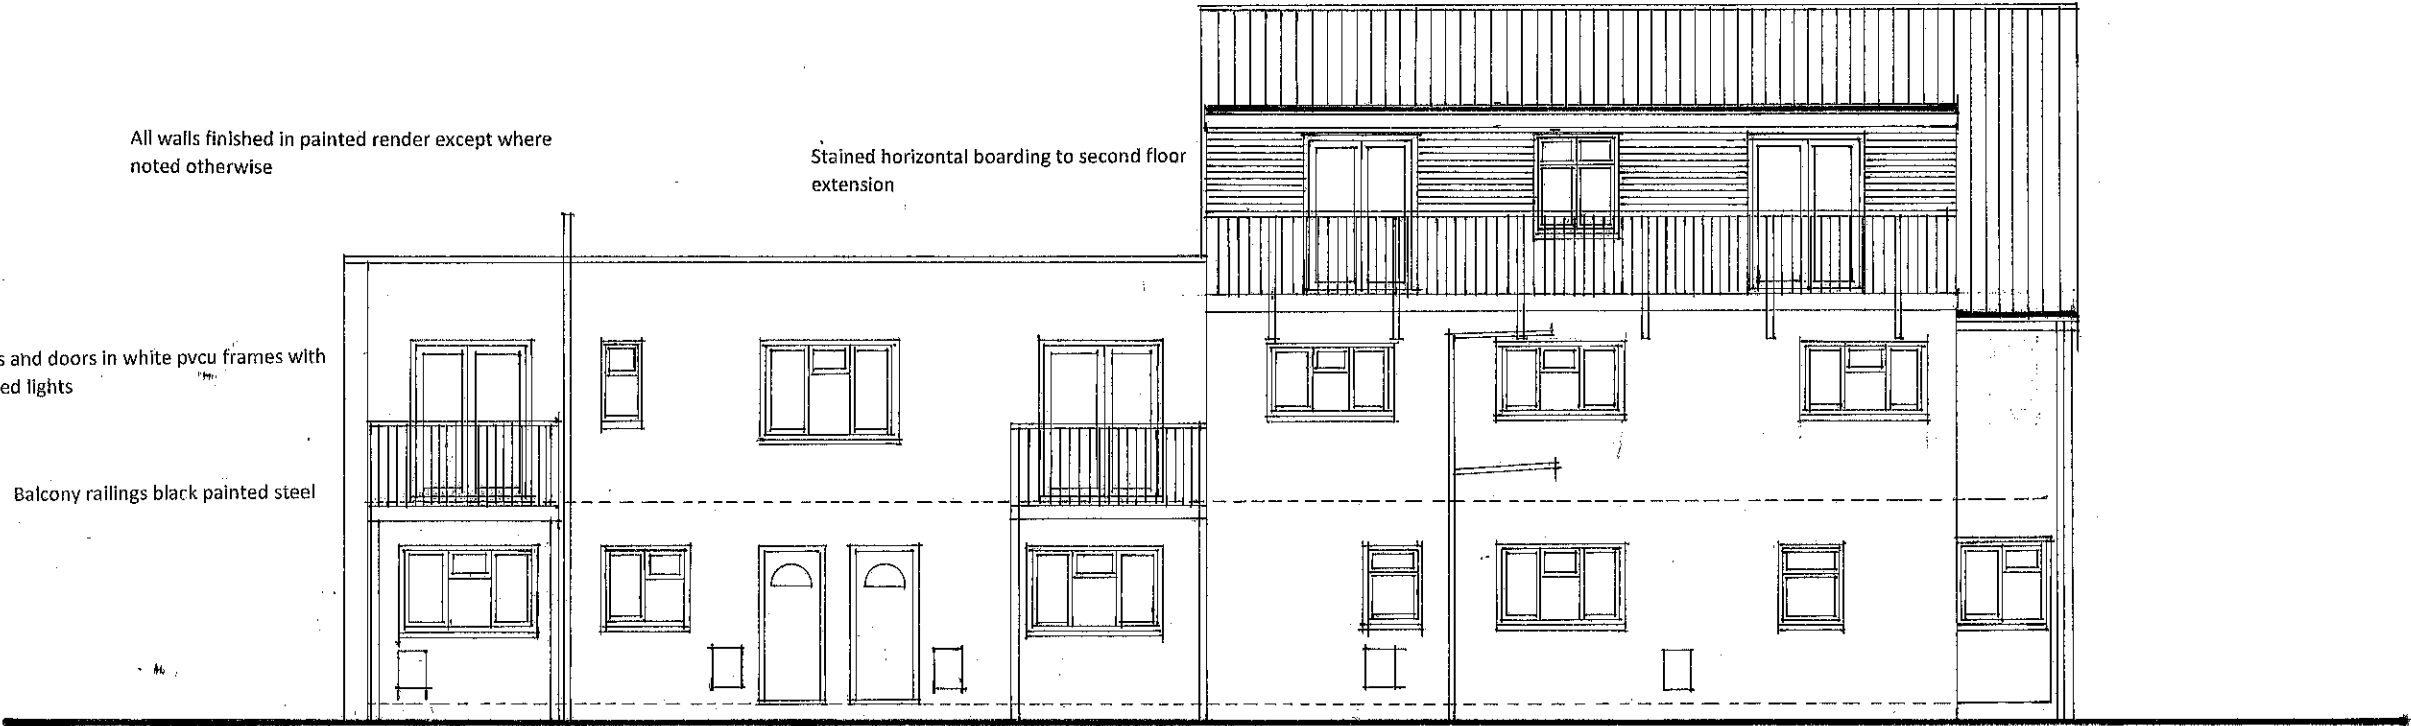

FLAT 1 FLAT 2

This drawing is the copyright of the Architect and must not be reproduced or used without the Architect's permission. Figured dimensions are to take precedence over scaled dimensions. The Contractor is responsible for checking all figured dimensions on drawings against actual site dimensions. Scaled dimensions are not to be used for construction and setting out purposes. Any discrepancies are to be reported to the Architect. This drawing should be read in conjunction with schedules, specifications and engineers drawings and details where applicable.

DAVID BENNETT ARCHITECTS

THE OLD COTTAGE
10 VICARAGE LANE, FELPHAM
WEST SUSSEX PO22 7EA
01243 842619 and 07932 757144
Email:davidkbennett47@gmail.com

CLIENT

CS PROPERTY AND CONSULTANCY LTD

PROJECT

**THE PEARL, 3 SELSEY AVENUE
BOGNOR REGIS PO21 2QZ**

DRAWING TITLE

**AS BUILT DRAWINGS
SOUTH ELEVATION**

SCALE

1/100 at A3

REFERENCE

11338.04