





Front Elevation Proposed (East)
Scale 1:100

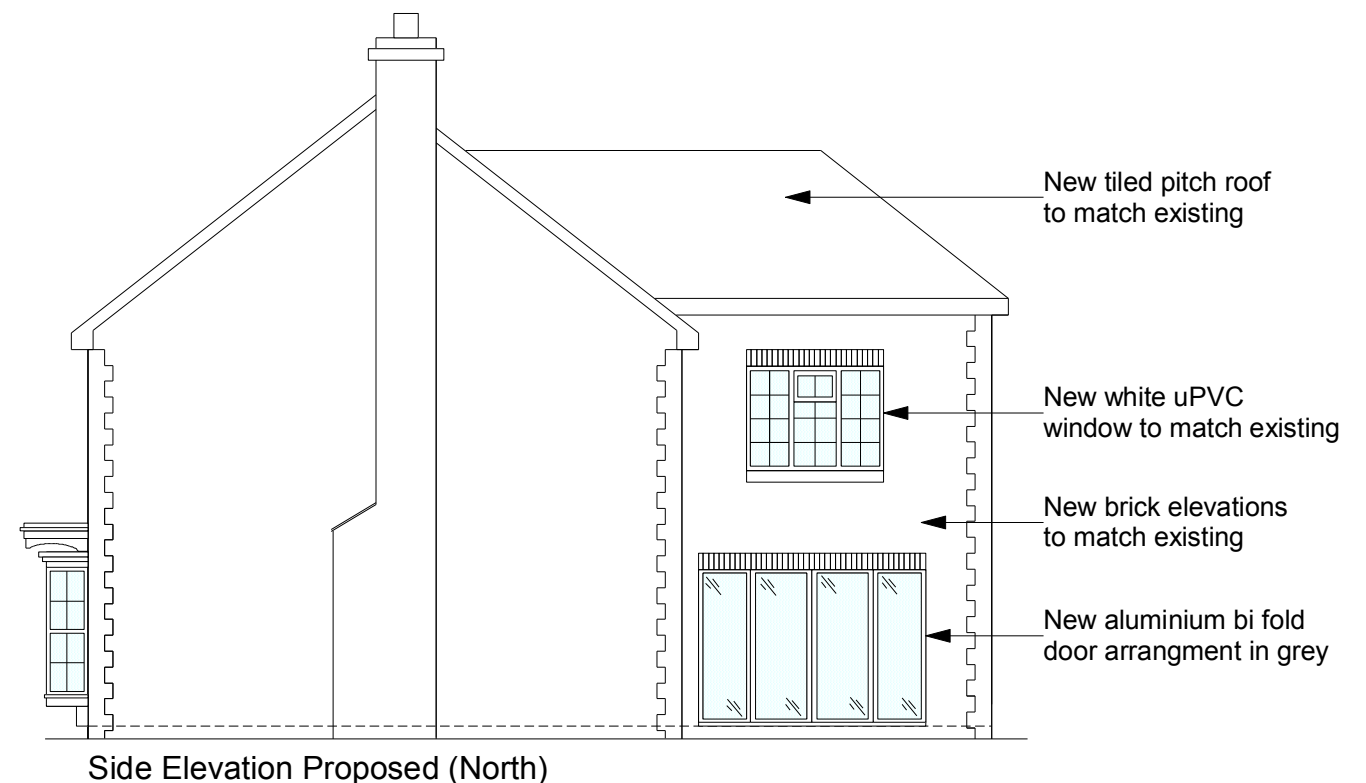

Side Elevation Proposed (North)
Scale 1:100



Rear Elevation Proposed (West)
Scale 1:100

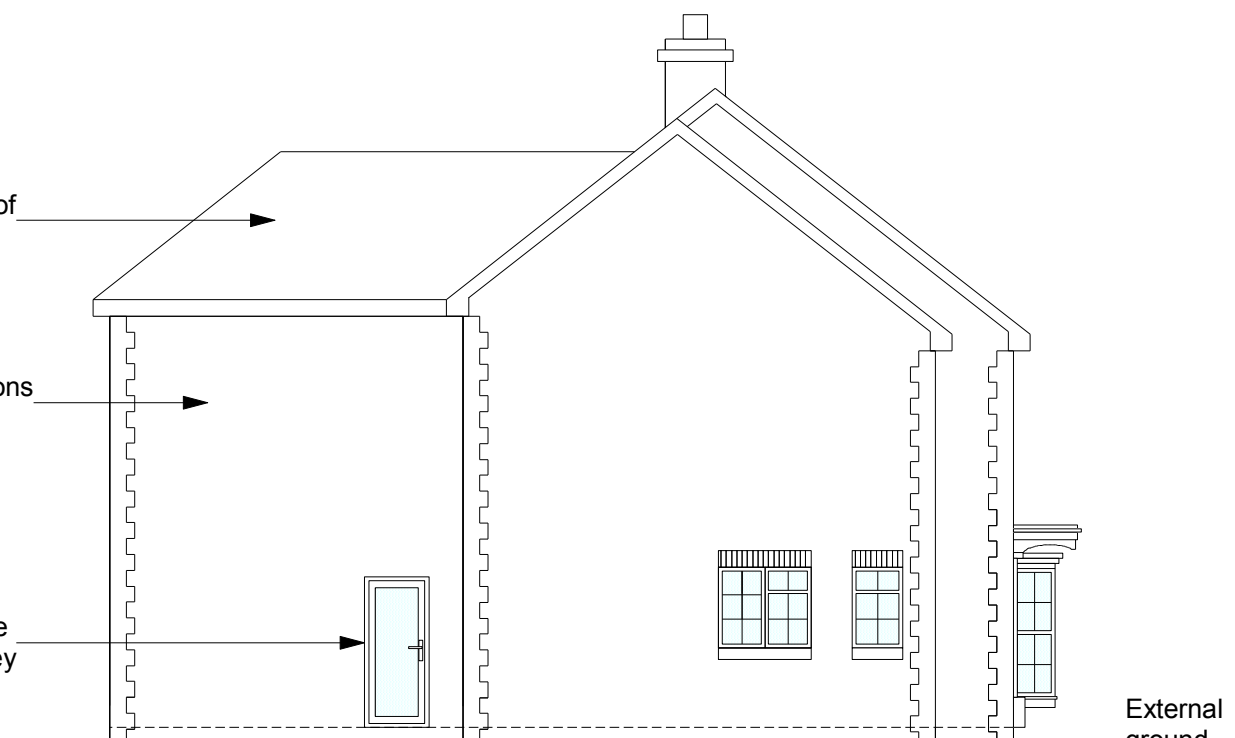

Side Elevation Proposed (South)
Scale 1:100

Non Material Application - AW/303/19/HH

Non Material Amendment application notes:
1. Change of window arrangements on rear elevation
proposed (shown in blue line for clarity)

All dims and details to be checked on site prior to any commencement of work. This plan is not a full specification or schedule of work and has been produced solely for the purpose of obtaining the necessary local authority consents/approvals For Party Wall etc. Act 1996 see Government booklet or website.	Status:		Client: Mr & Mrs Chapman 2 Larchfield Close Aldwick Bognor Regis West Sussex PO21 4RB	Revision: C	Project: Extension
	Preliminary	☐ Tender		Scale: 1:100@A3	Content: Proposed elevations
	Planning	☒ Construction		Date: Jan 20	
	Building Regulations	☐ As Built		Dwg No: CC003	