



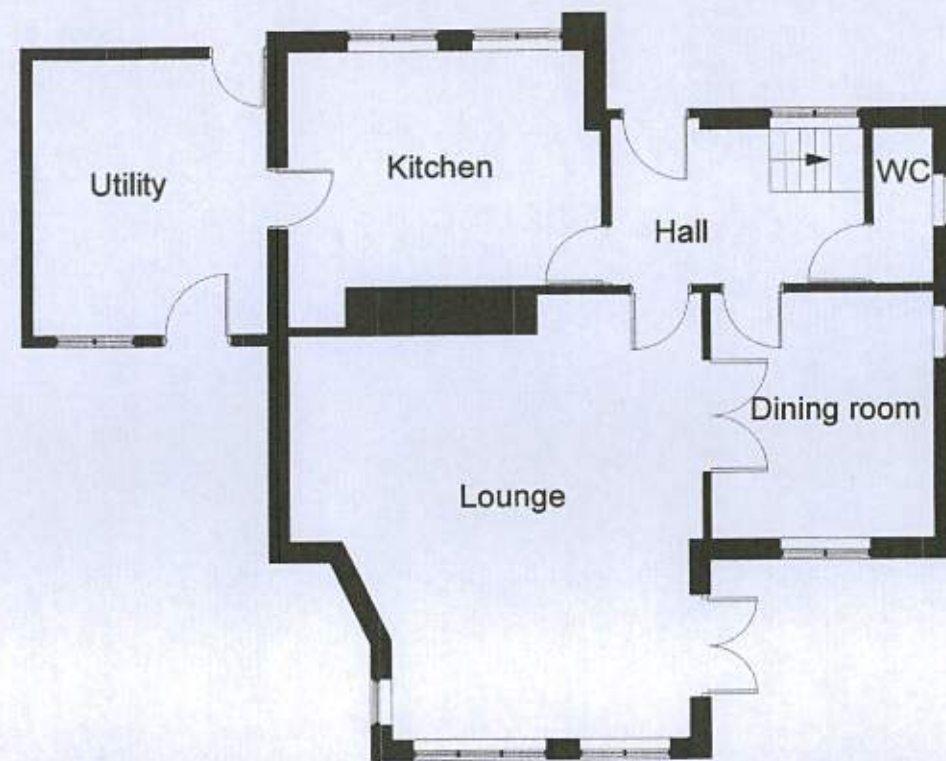

Ground Floor Layout Existing
Scale 1:100
First Floor not shown and is not
affected by the proposed extension

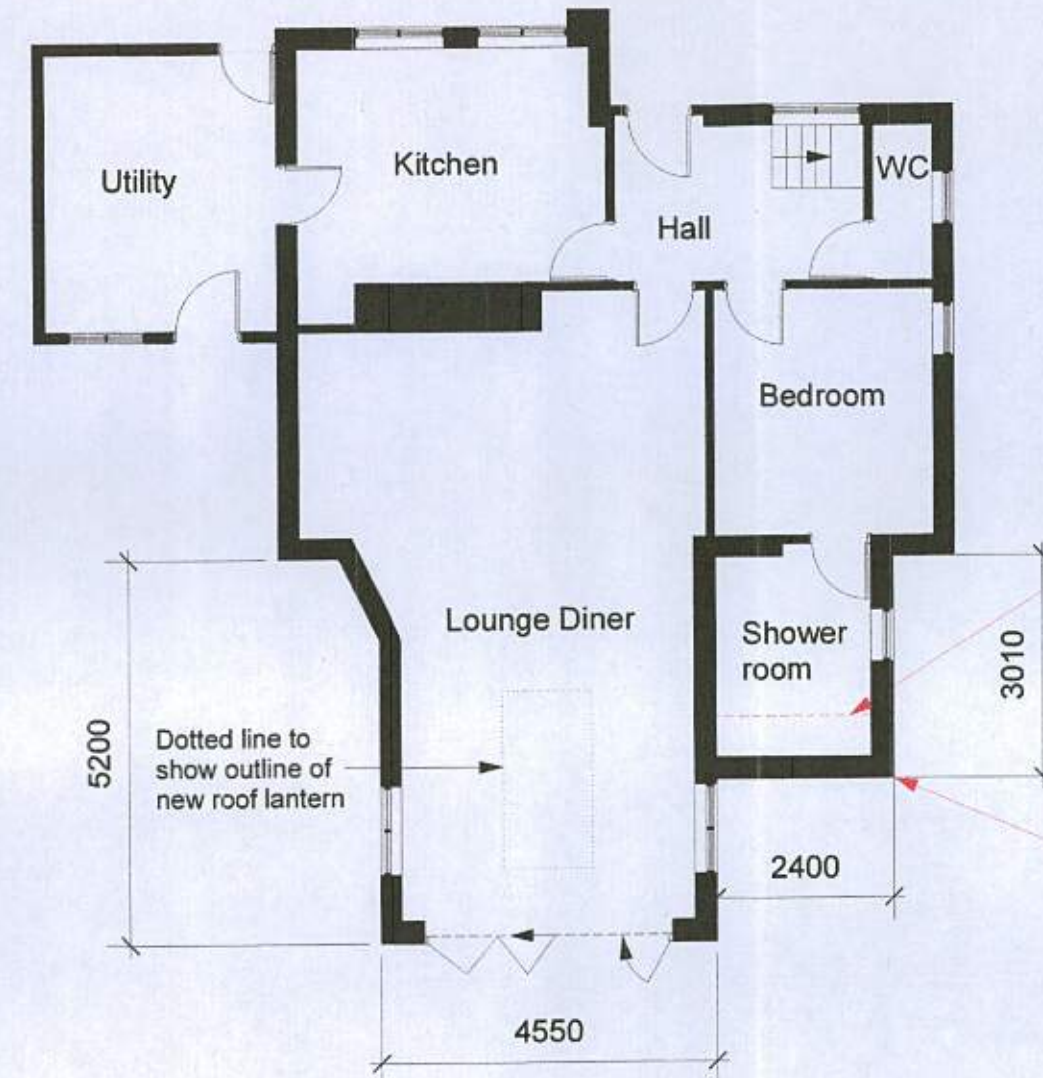

Ground Floor Layout Proposed
Scale 1:100
First Floor Remains Unchanged

Dotted line to show
original extent of shower
room approved in
application AW/79/17/HH.

Shower room extended
by 850mm from 2160mm
to 3010mm.

**For NON MATERIAL AMENDMENT APPLICATION
relating to original application AW/79/17/HH**

All dims and details to be checked on site prior to any commencement of work. This plan is not a full specification or schedule of work and has been produced solely for the purpose of obtaining the necessary local authority consents/approvals For Party Wall etc. Act 1996 see Government booklet or website.	Status:		Client: Mr S Dell 175 Nyetimber Lane Bognor Regis West Sussex PO213HT	Revision: B	Project: Rear extension.
	Preliminary	☐ Tender		Scale: 1:50 & 100 @A3	Content: Existing and proposed floor plans
	Planning	☒ Construction		Date: July 17	
	Building Regulations	☐ As Built		Dwg No: SD002	