
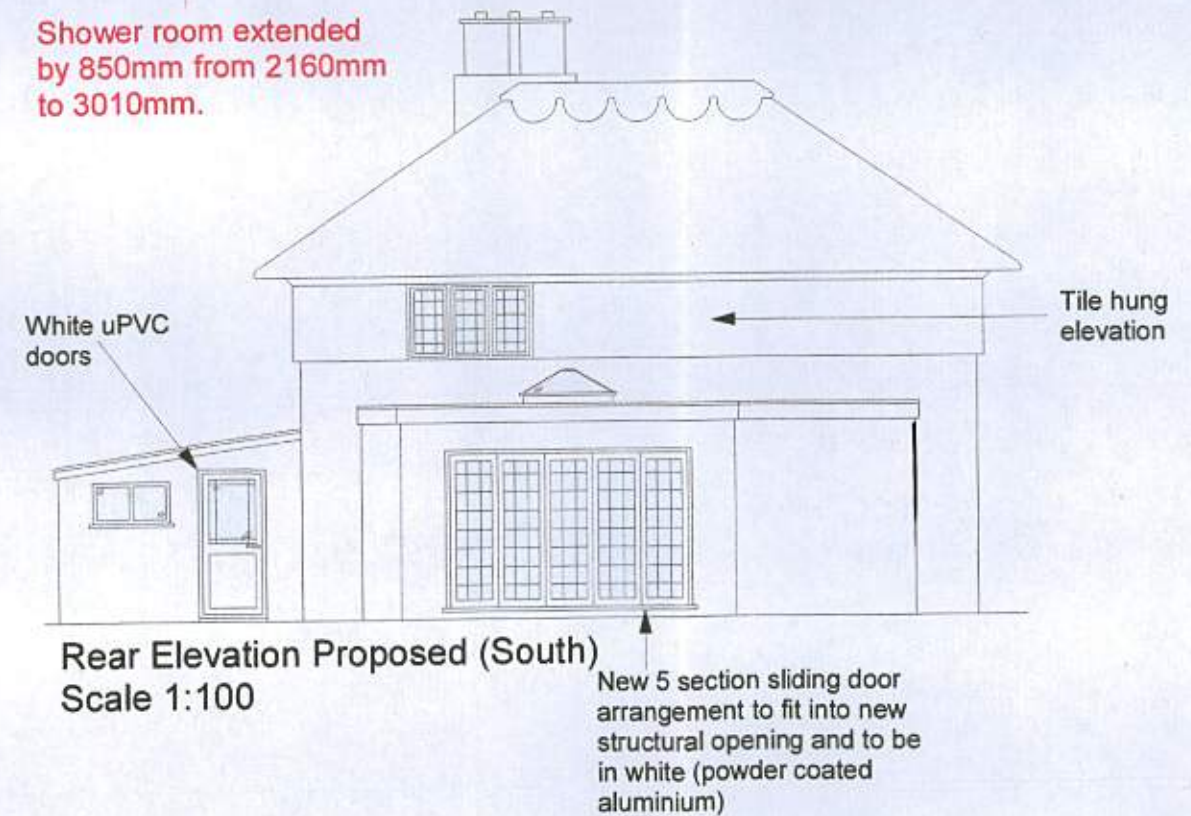
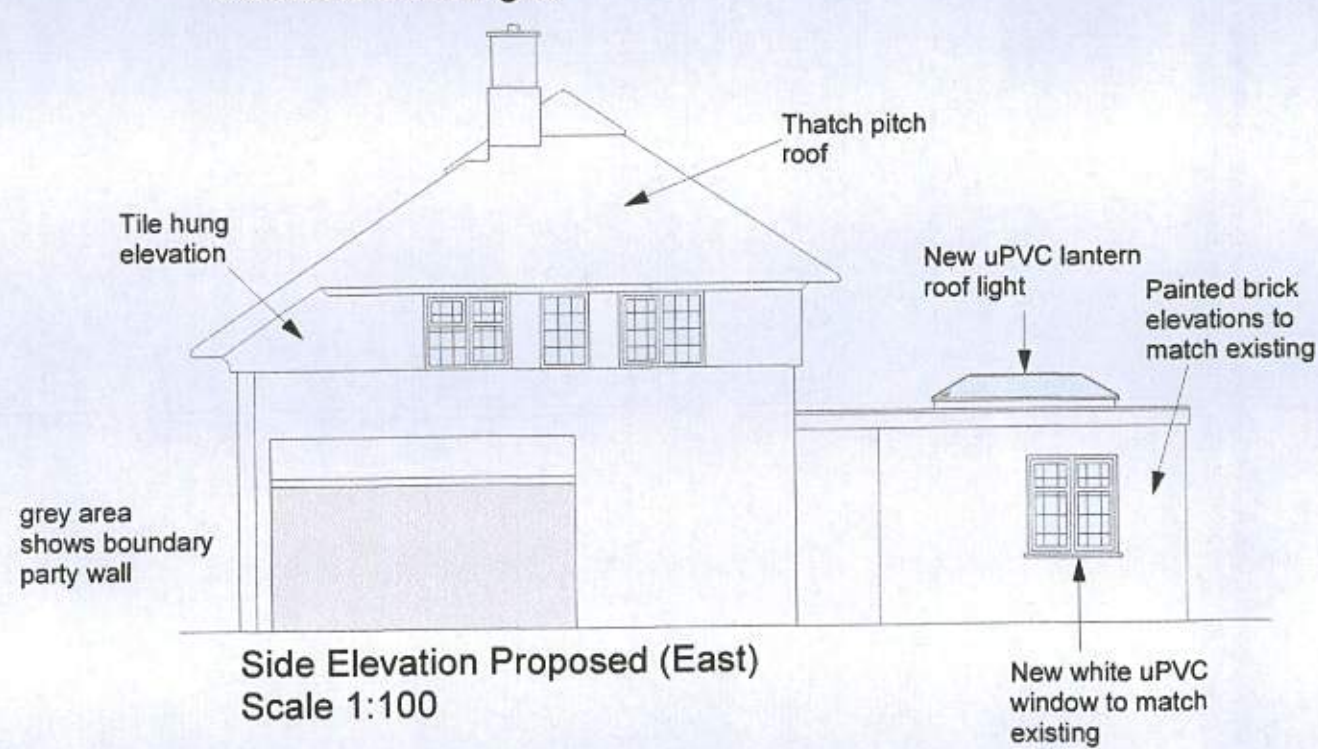


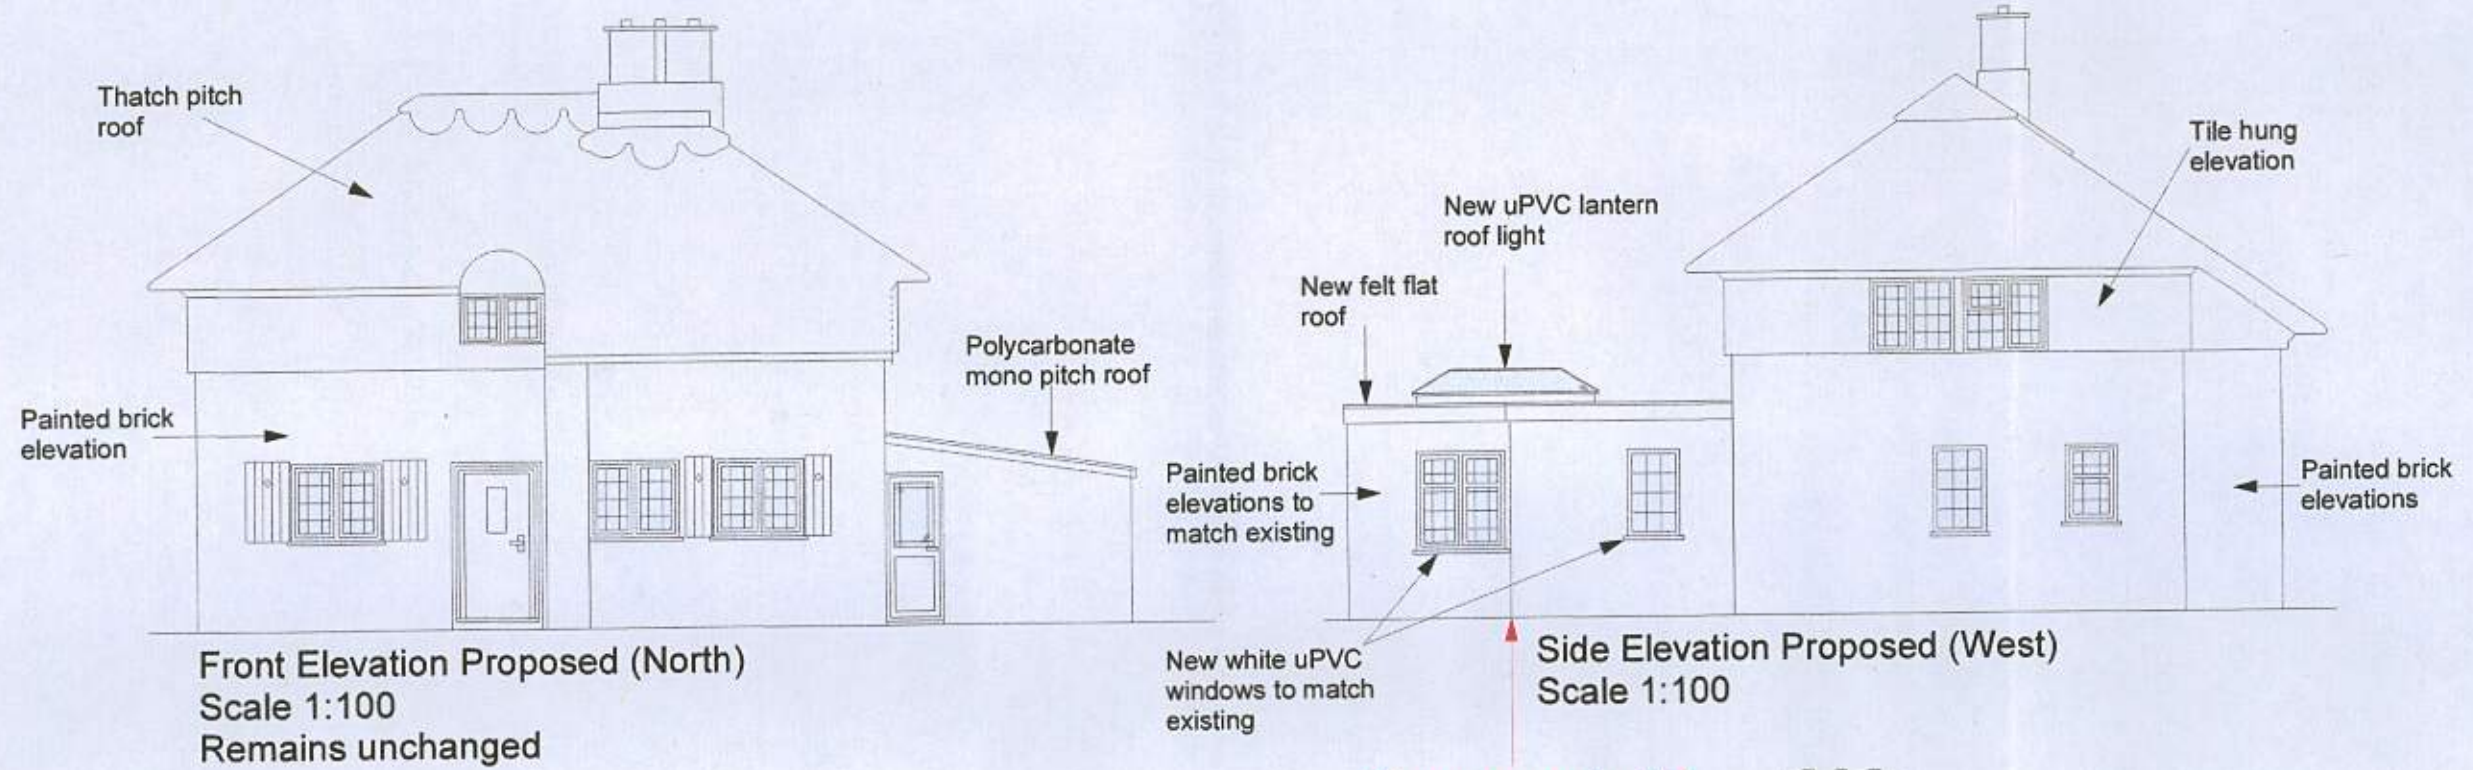

For NON MATERIAL AMENDMENT APPLICATION
relating to original application AW/79/17/HH

All dims and details to be checked on site prior to any commencement of work. This plan is not a full specification or schedule of work and has been produced solely for the purpose of obtaining the necessary local authority consents/approvals. For Party Wall etc. Act 1996 see Government booklet or website.	Status:		Client: Mr S Dell 175 Nyetimber Lane Bognor Regis West Sussex PO213HT	Revision: B	Project: Rear extension
	Preliminary	☐ Tender		Scale: 1:50 & 100 @ A3	Content: Proposed elevations
	Planning	☒ Construction		Date: July 17	
	Building Regulations	☐ As Built		Dwg No: S0003	