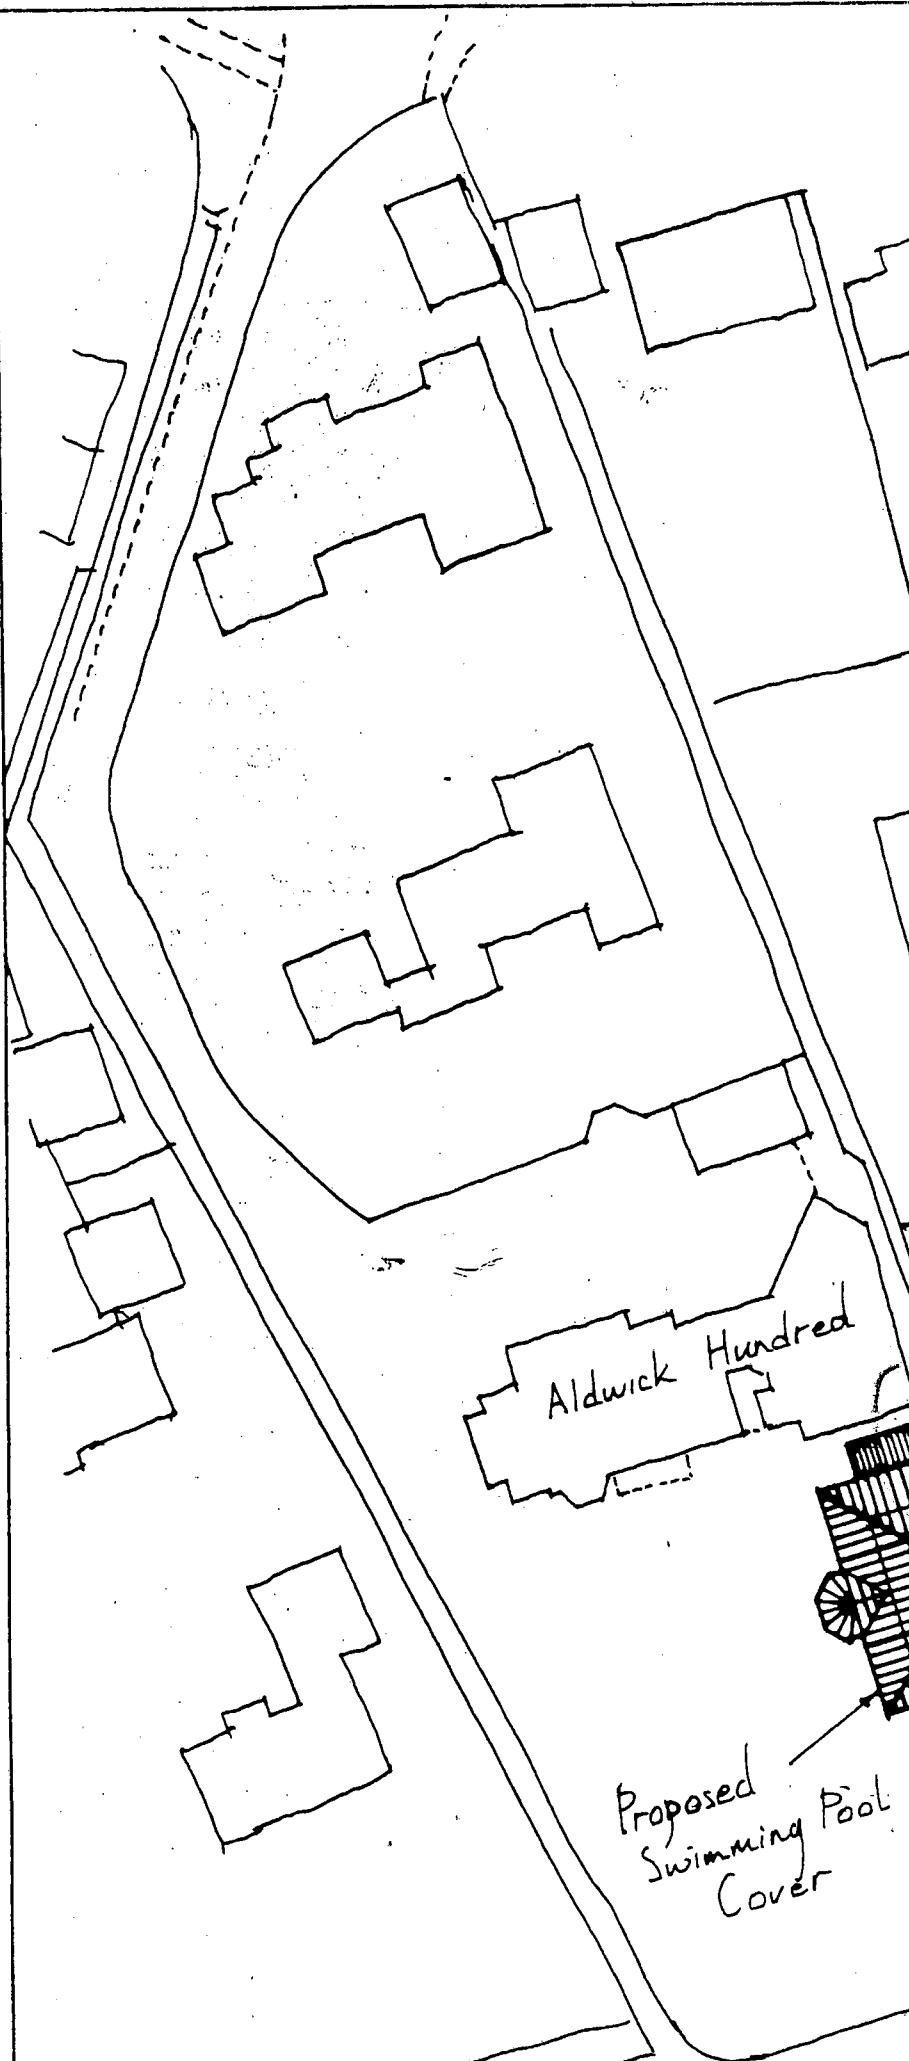


	Client: Mr and Mrs Simpson	
	Project: Aldwick Hundred, Craigwell Lane, Aldwick	
	Title: Block Plan	
	Drawing no: 3731/02	Scale: 1:500
	Revision: ~~A~~	Date: ~~25/2/08~~
	Notes: B JAN 2007 EXTEND PLANT ROOM	
	ARUN DISTRICT COUNCIL	
	No. AW/306/06	
RECEIVED 12/1/07		

Aldwick Hundred

Proposed Swimming Pool Cover

N