
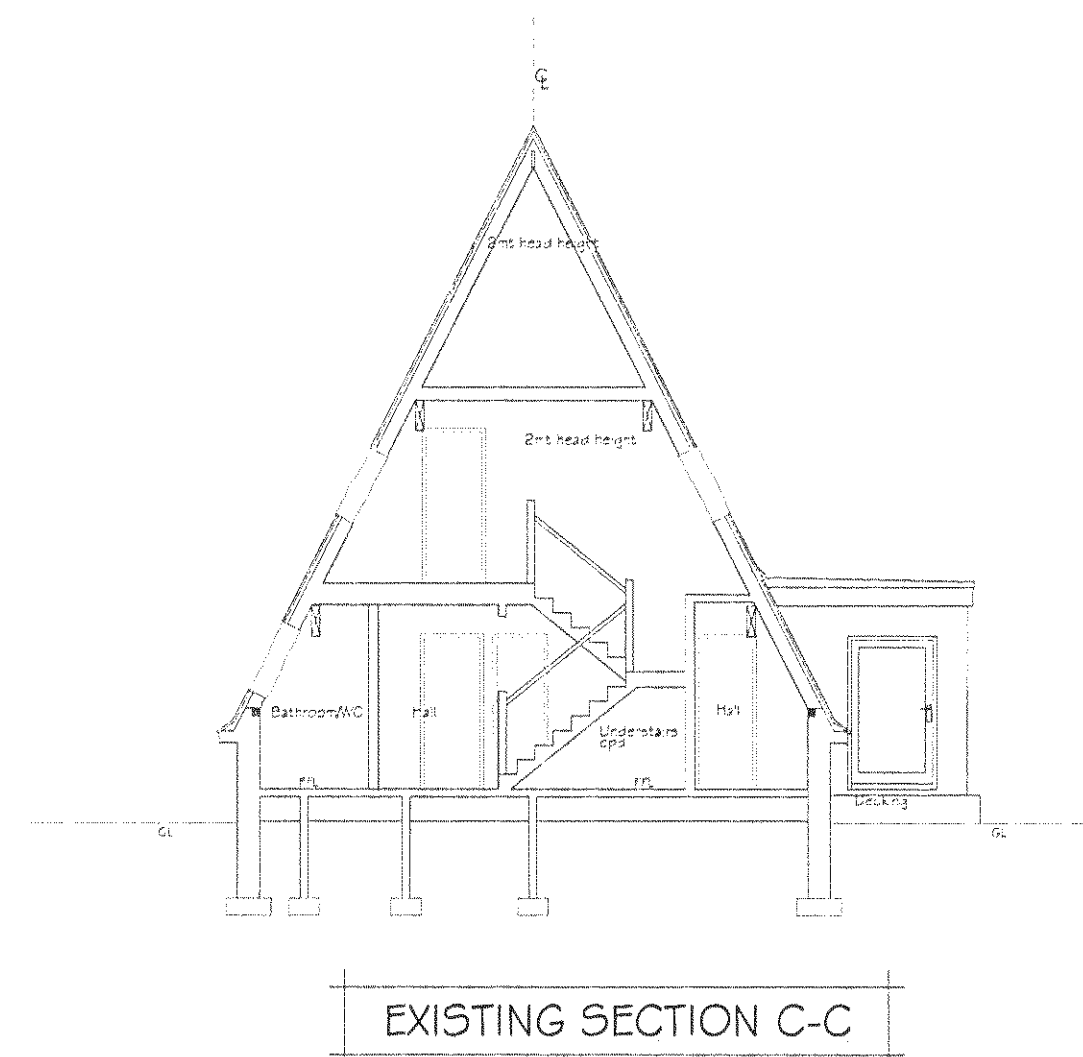
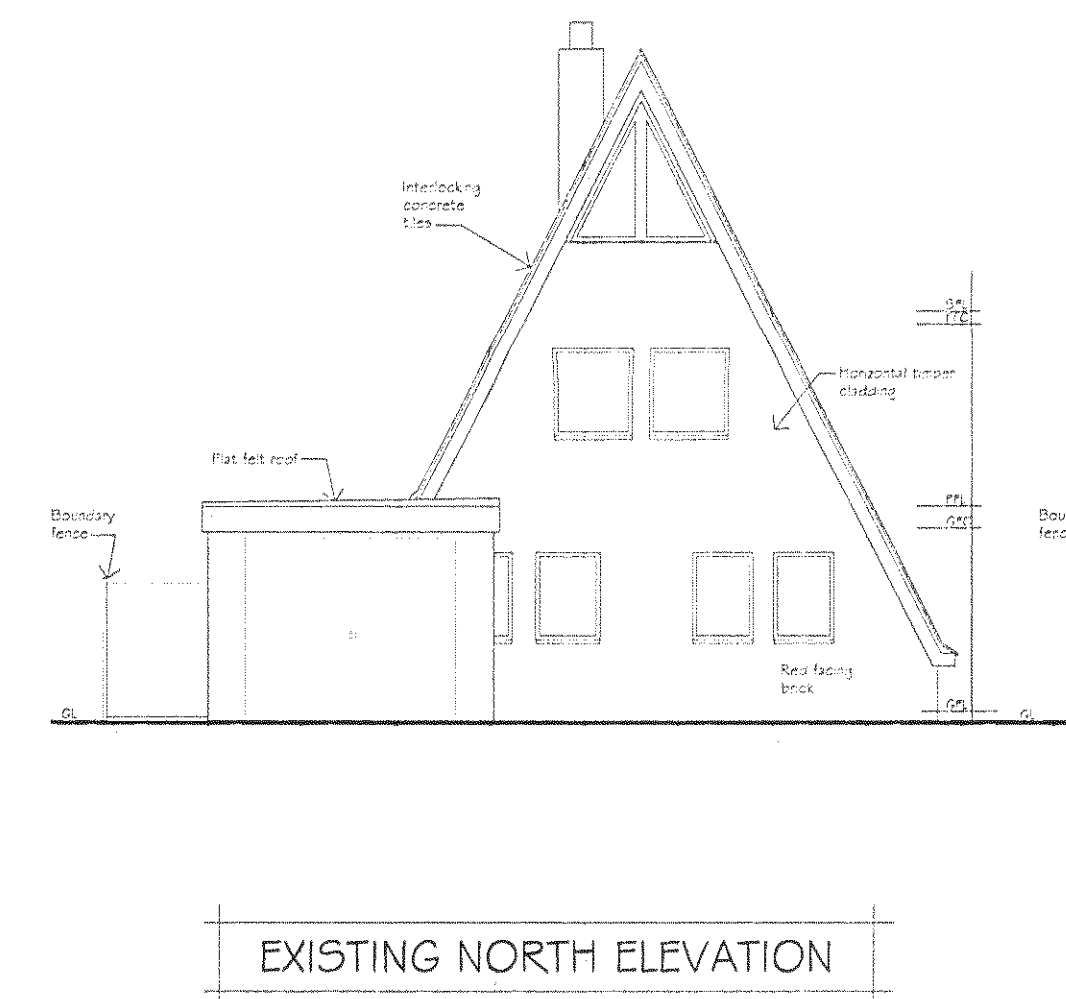
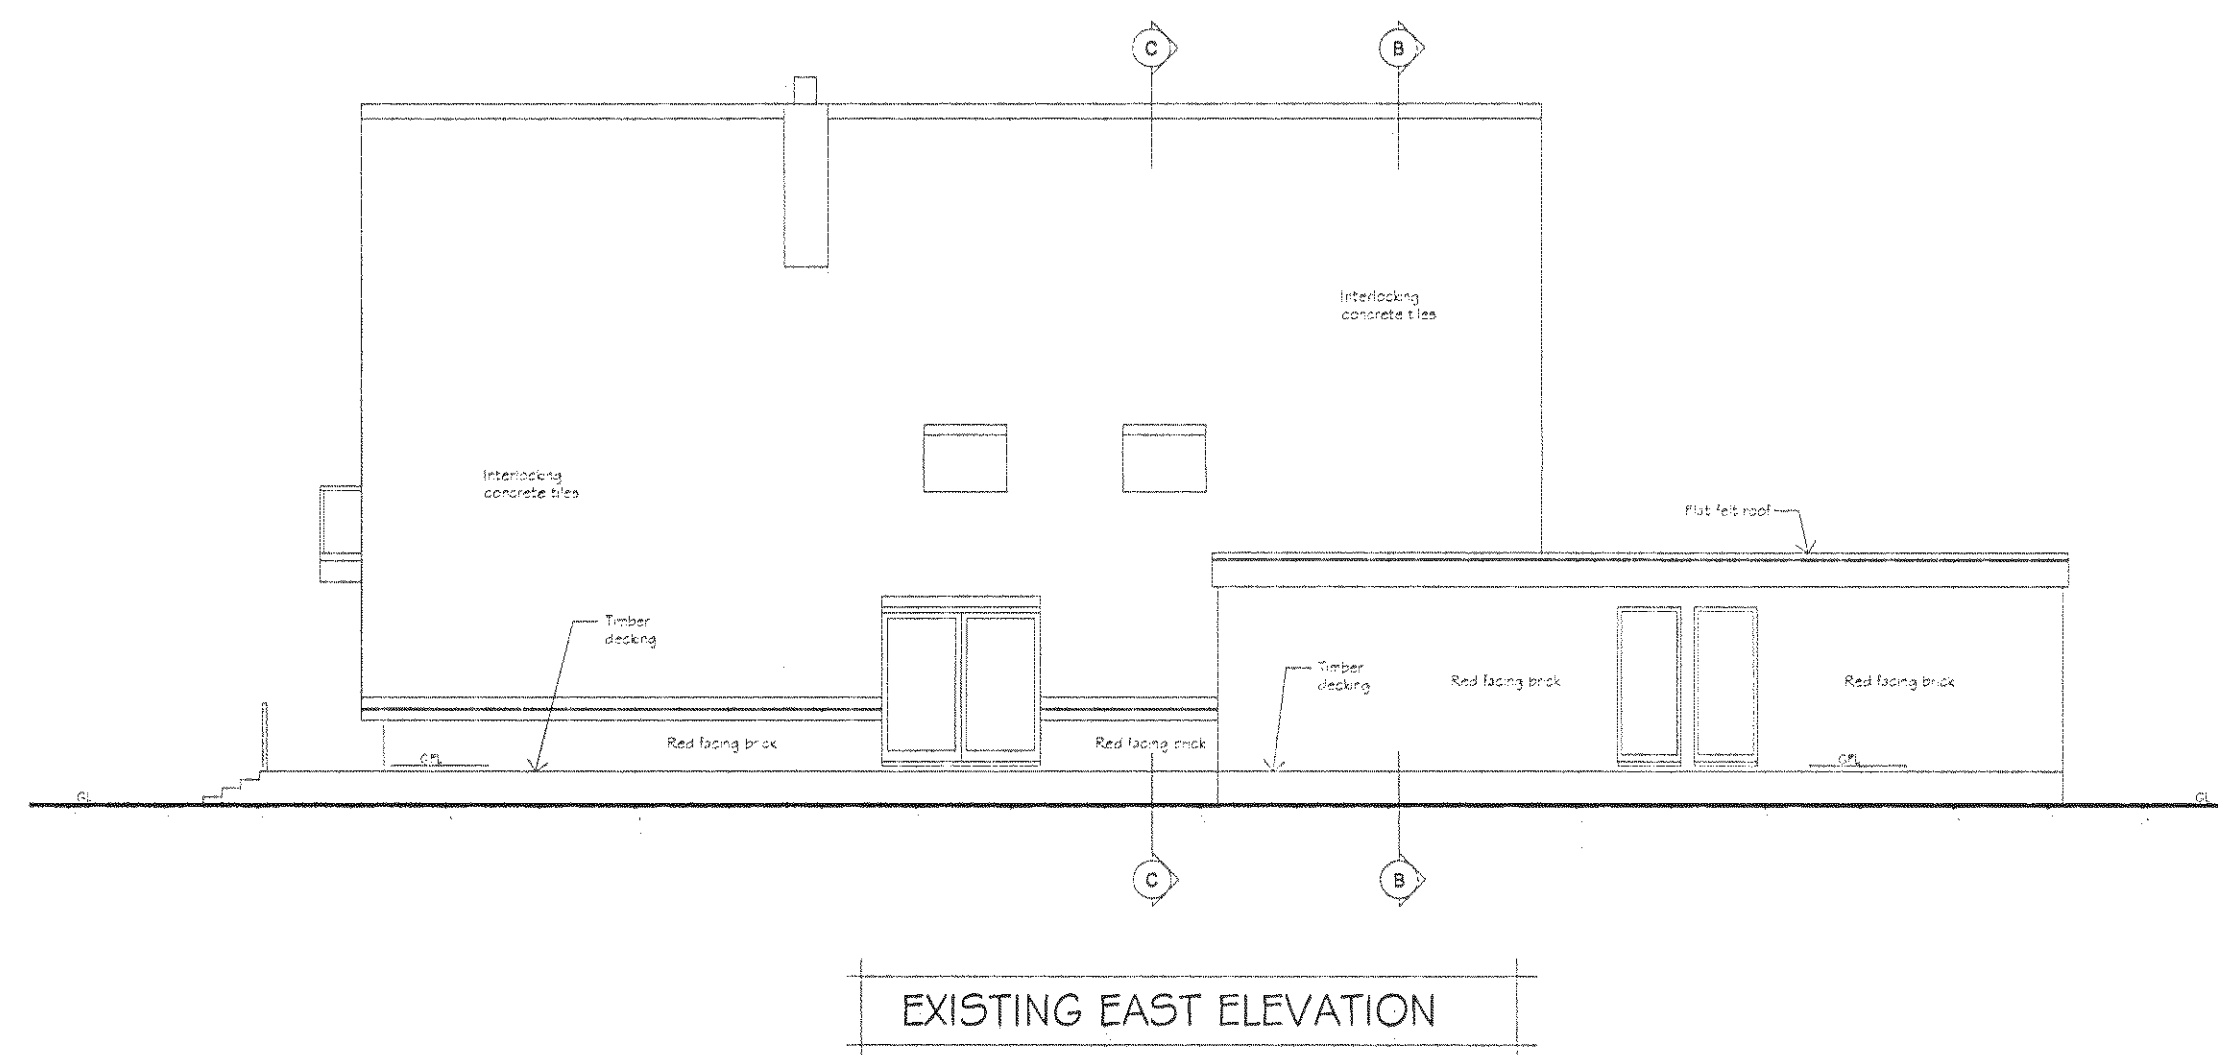
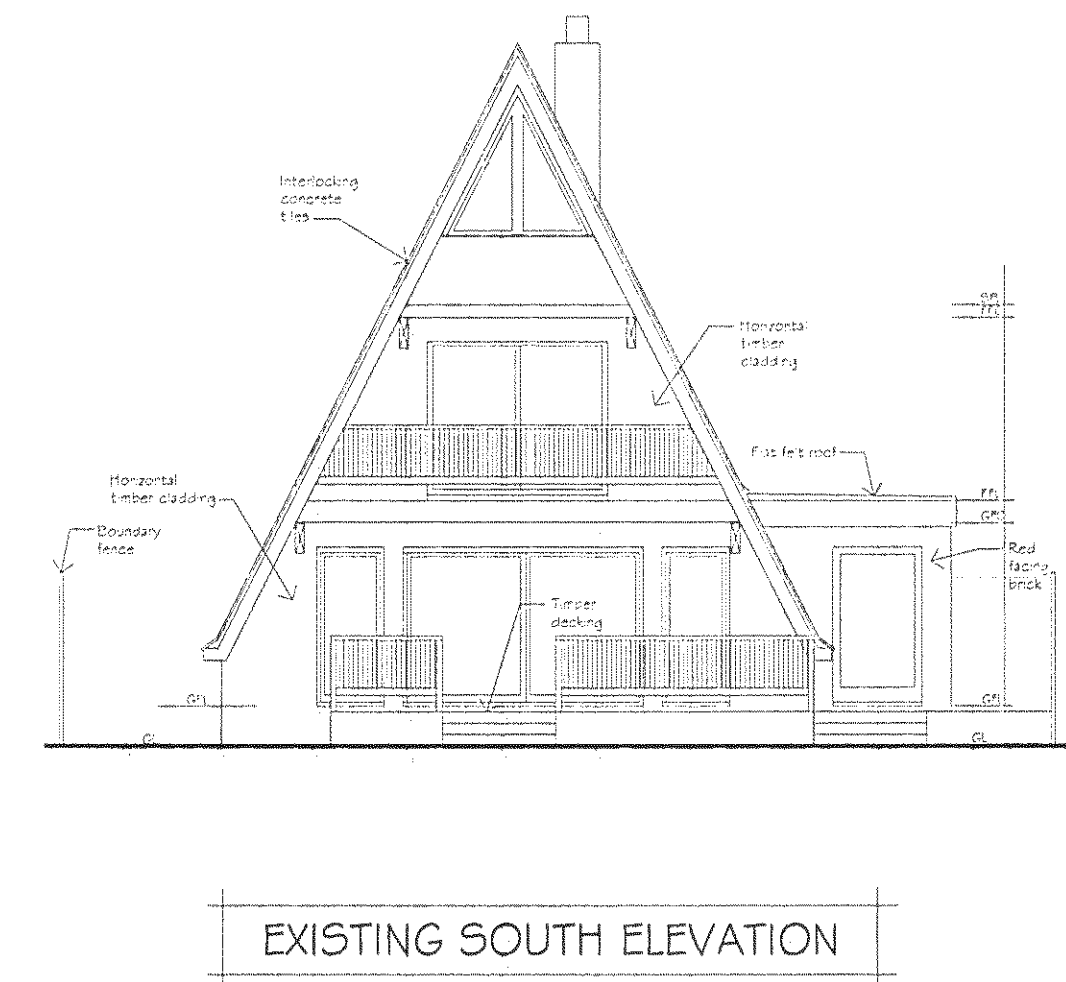


NOTES

1. Do not scale from this drawing except for planning purposes. Use figured dimensions only.
2. All dimensions must be checked on site prior to commencement of work.
3. Where applicable this drawing is to be read in conjunction with other consultants drawings.
4. This drawing is the copyright of MS Associates Ltd.

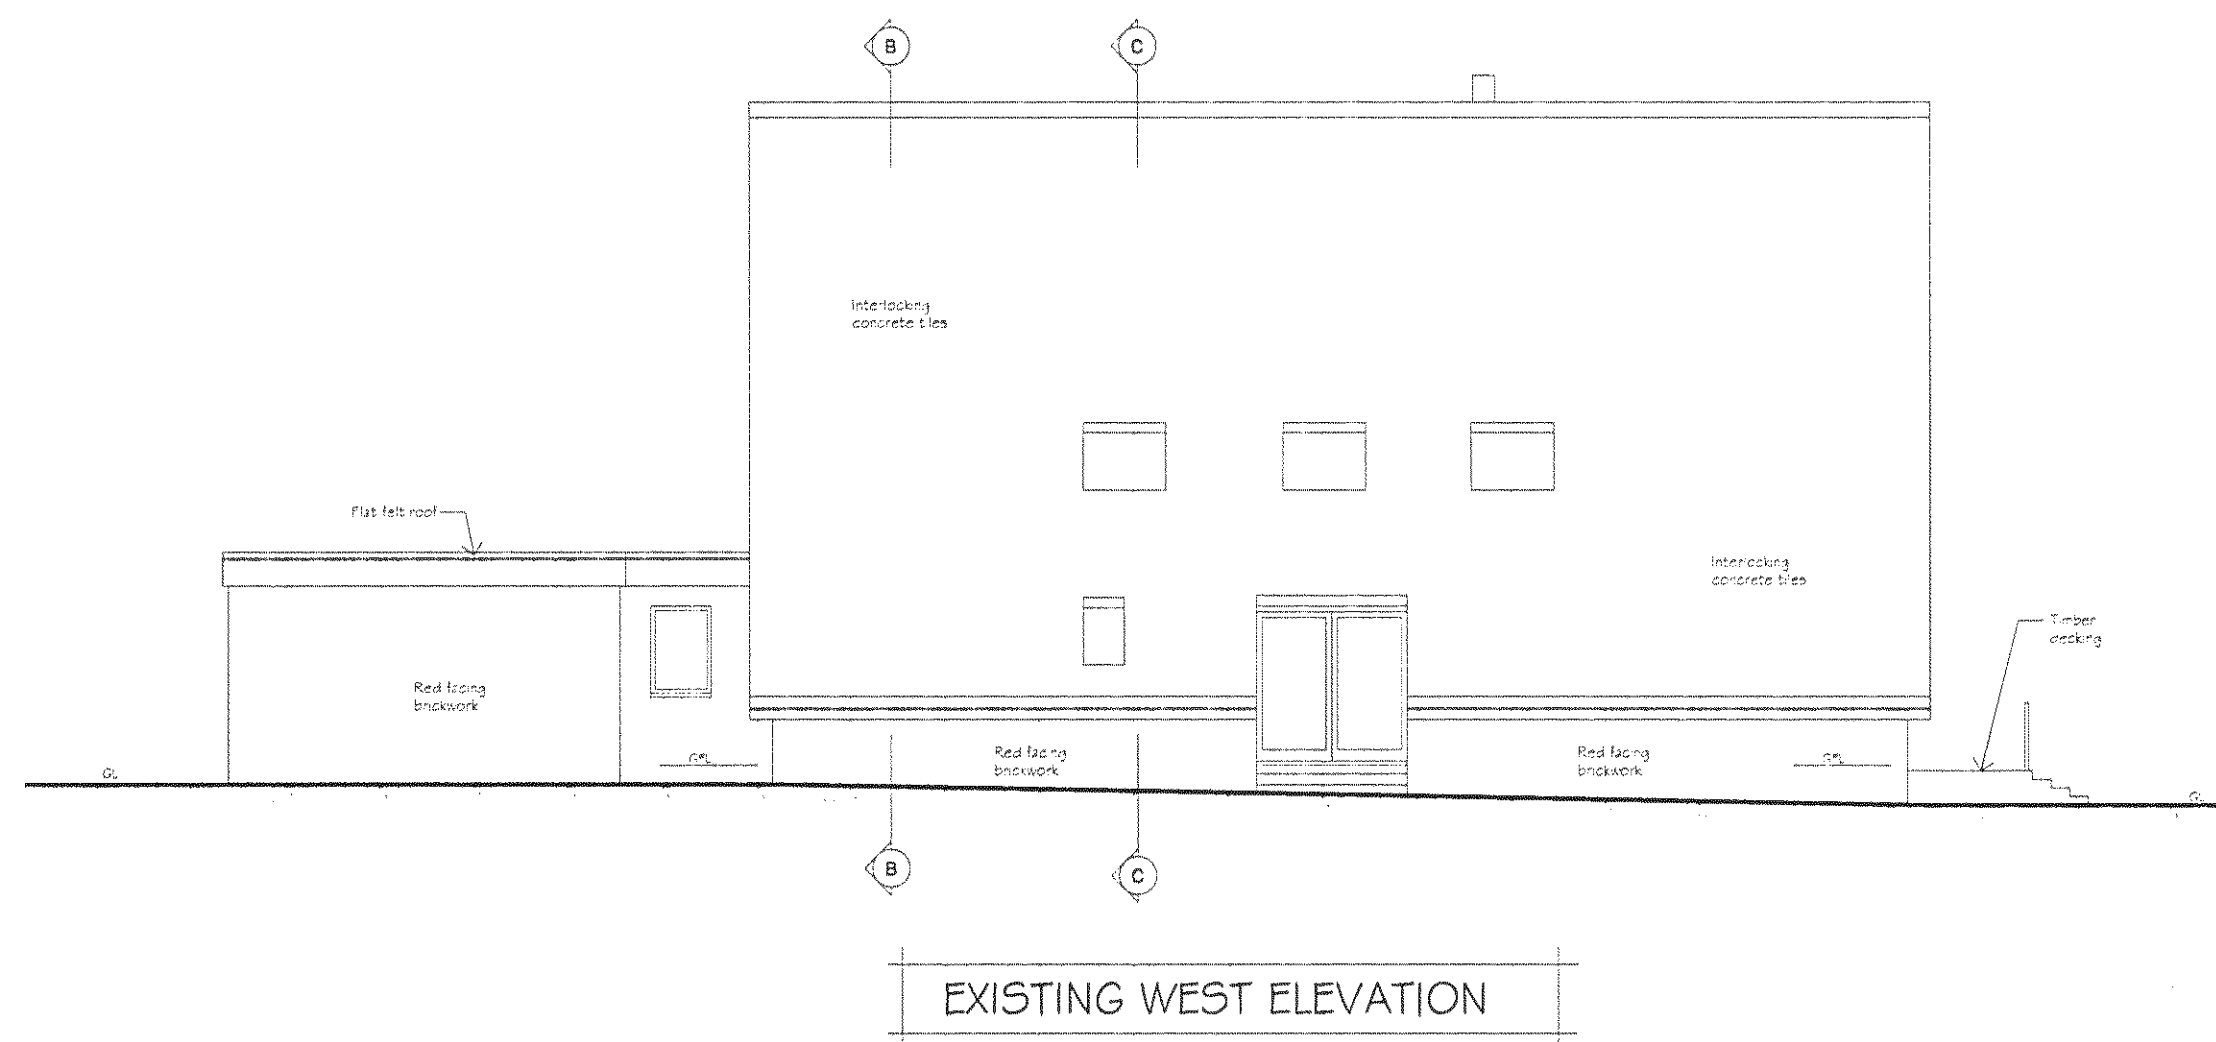

REV	DATE	AMENDMENT	CHECK

MSA ASSOCIATES
RICS SURVEYORS AND BUILDING CONSULTANTS

TEL-01 243-539378 FAX-01 243-531070
email-info@theconstructivegroup.com

CLIENT
Mr & Mrs Simon Jardine

PROJECT
33 Aldwick Avenue,
Aldwick,
Bognor Regis,
West Sussex PO21 3AQ

DRAWING TITLE
Existing Elevations & Sections

SCALE
1:100 @ A1

STATUS AS BUILT

DATE Aug 12	DRAWN AS	CHECKED -
JOB NUMBER 3106	DRAWING NUMBER EX03	REVISION