
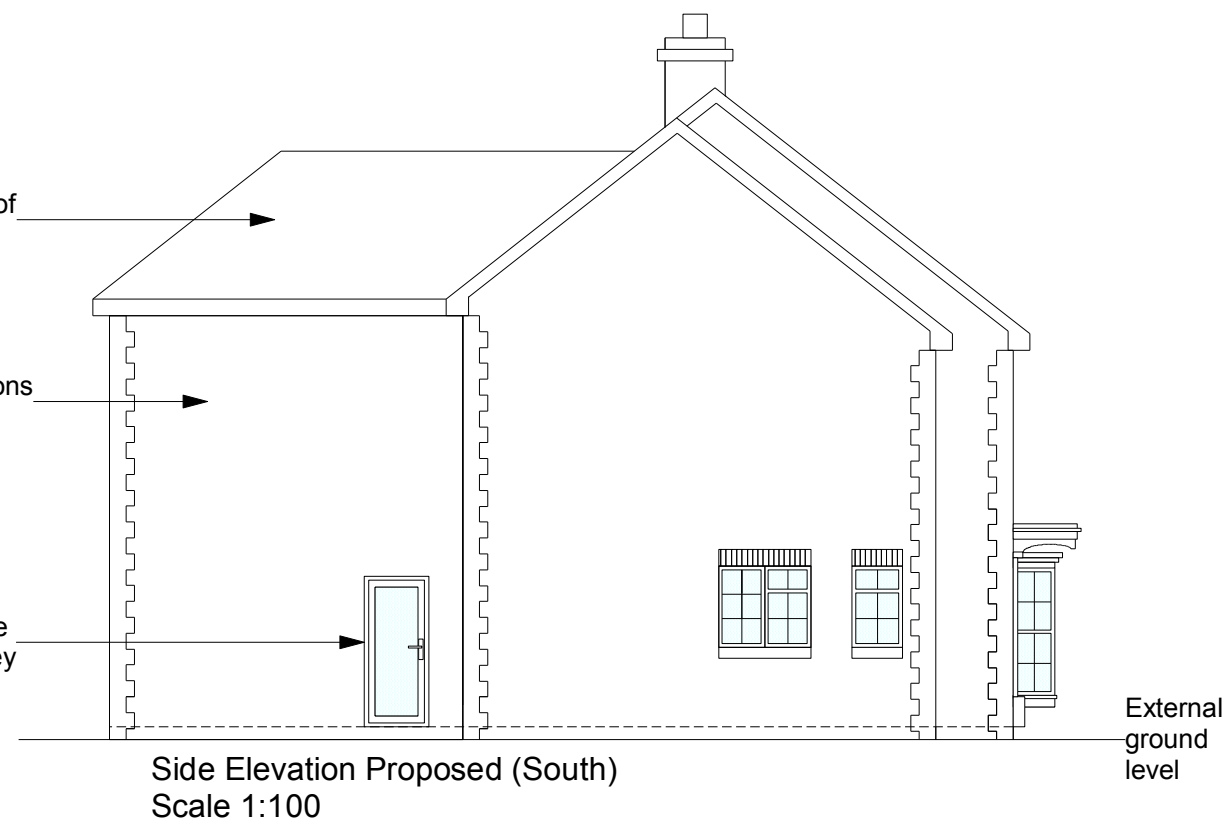


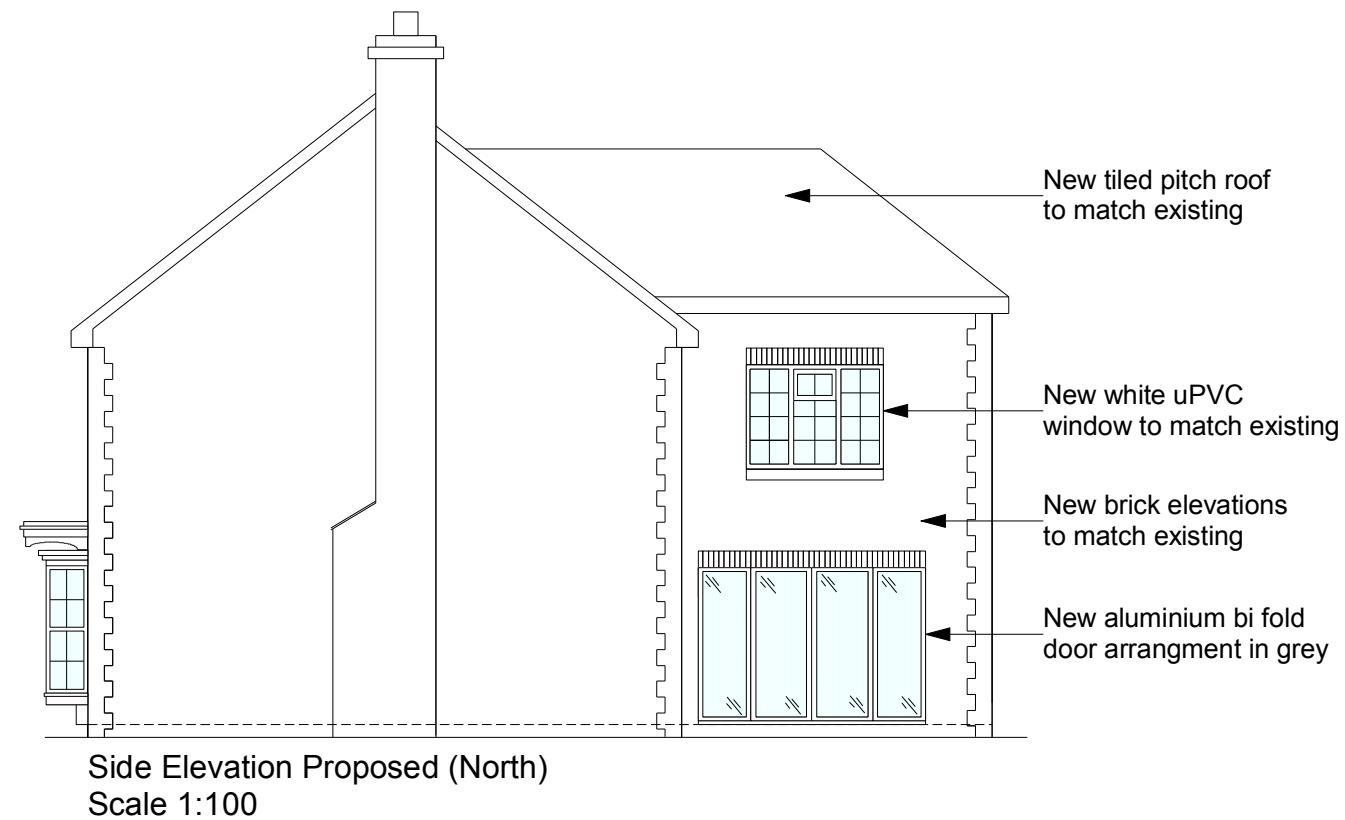

Non Material Amendment application notes:
1. Change of window arrangements on rear elevation proposed (shown in blue line for clarity)

Non Material Application - AW/303/19/HH

All dims and details to be checked on site prior to any commencement of work. This plan is not a full specification or schedule of work and has been produced solely for the purpose of obtaining the necessary local authority consents/approvals For Party Wall etc. Act 1996 see Government booklet or website.	Status:		Client: Mr & Mrs Chapman 2 Larchfield Close Aldwick Bognor Regis West Sussex PO21 4RB	Revision: D	Project: Extension
	Preliminary	☐ Tender ☐		Scale: 1:100@A3	Content: Proposed elevations
	Planning	☒ Construction ☐		Date: Mar 20	
	Building Regulations	☐ As Built ☐		Dwg No: CC003	