
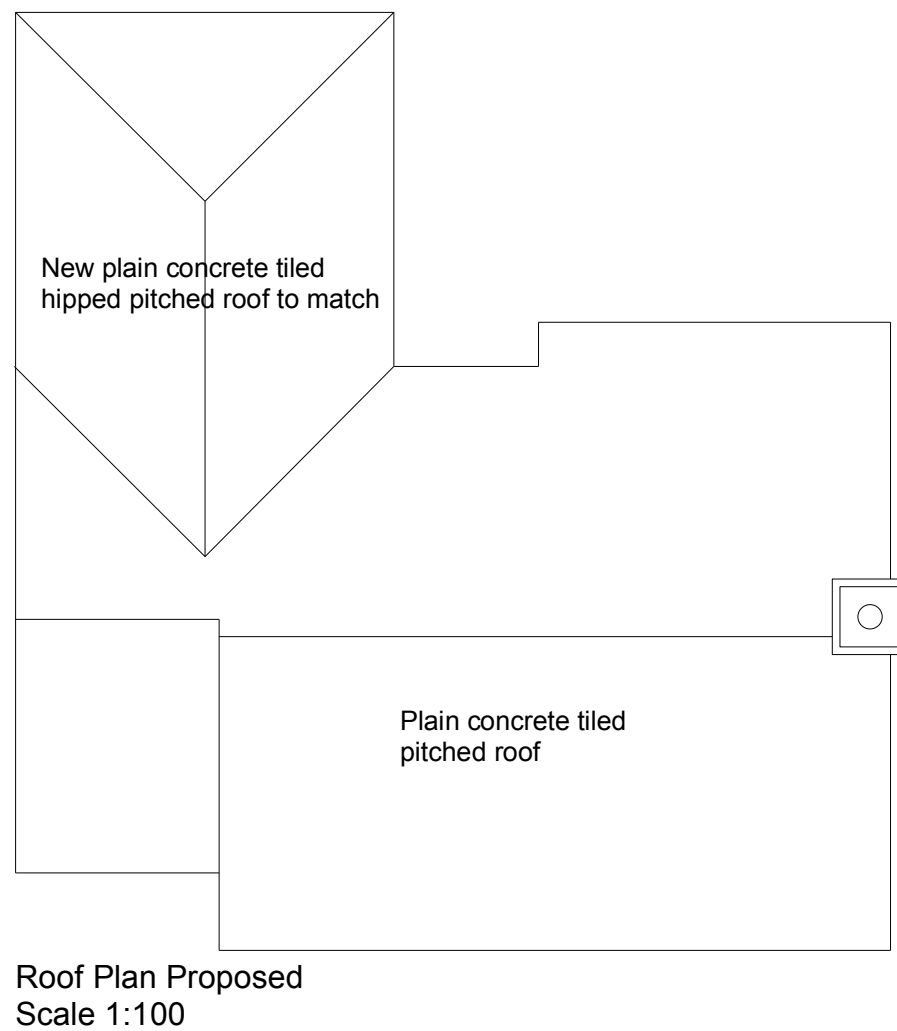
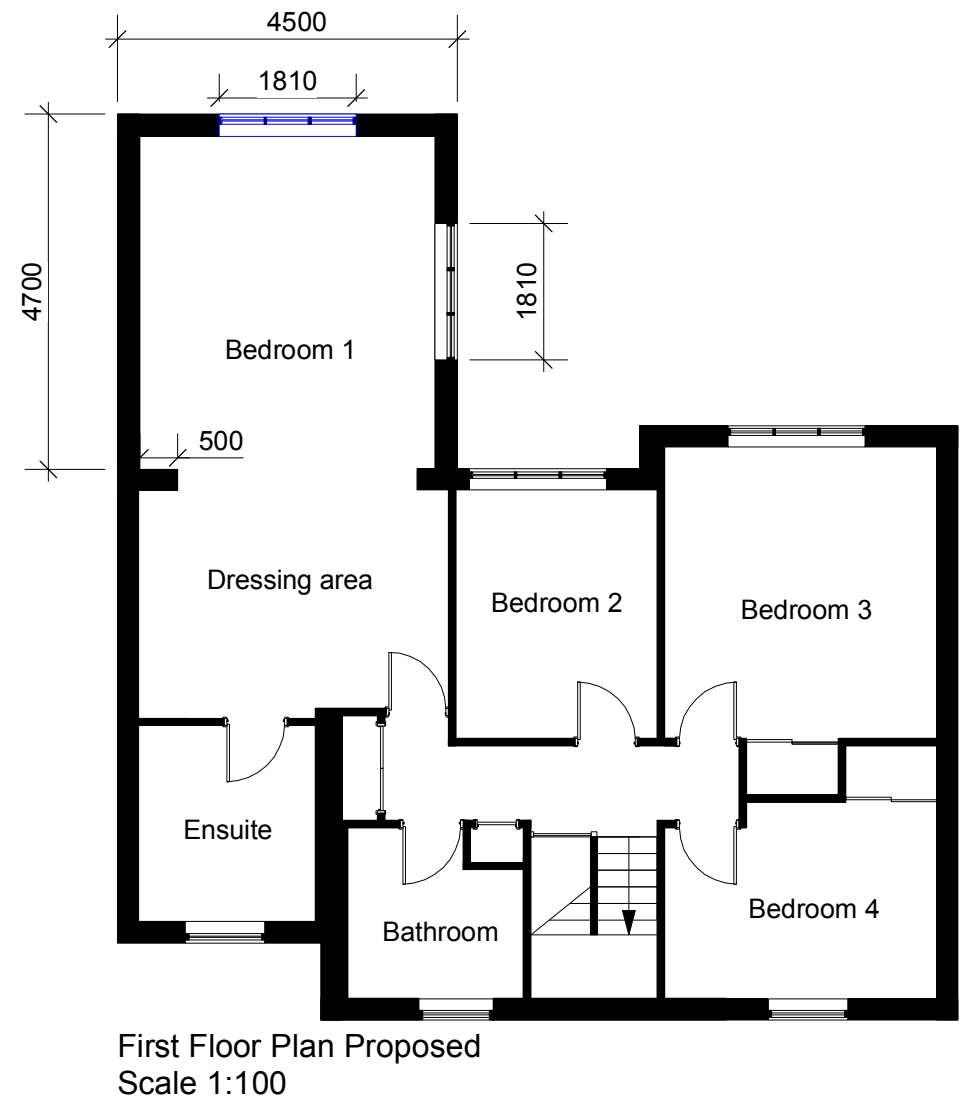


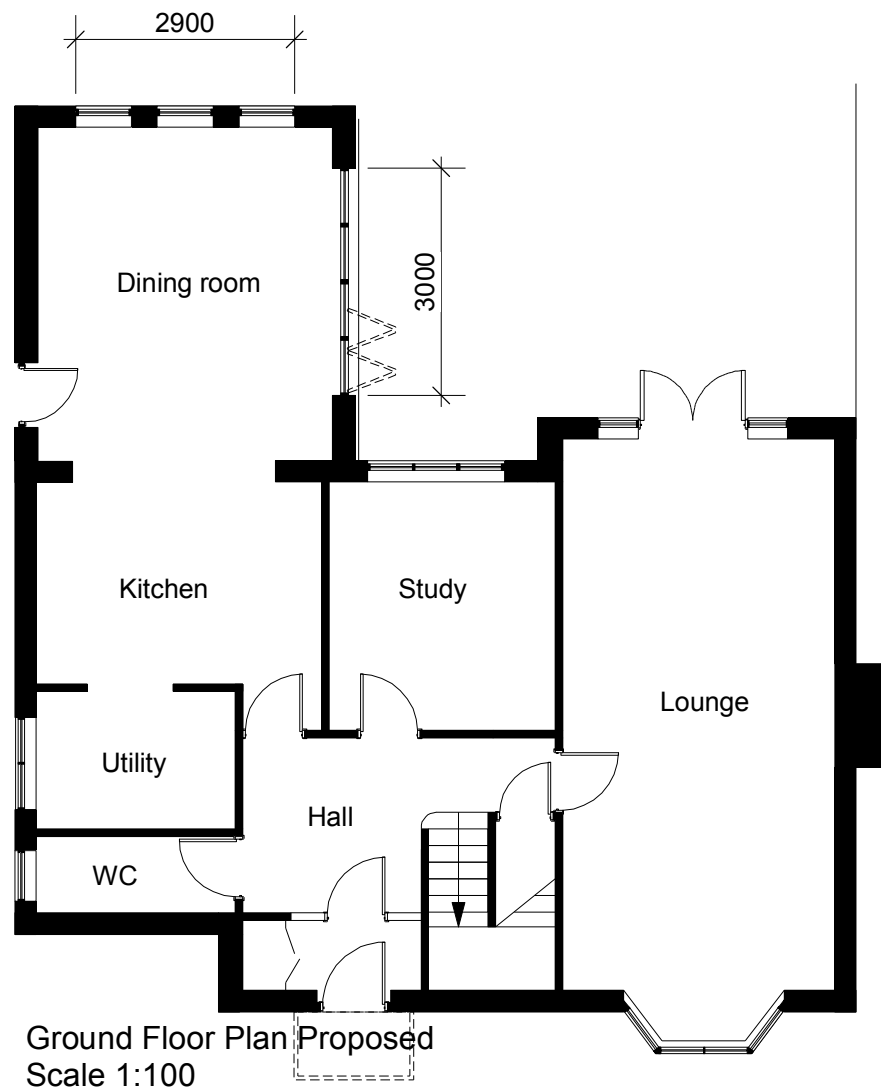

Non Material Amendment application notes:
1. Change of window arrangement on rear elevation proposed (shown in blue line for clarity)

Non Material Application - AW/303/19/HH

All dims and details to be checked on site prior to any commencement of work. This plan is not a full specification or schedule of work and has been produced solely for the purpose of obtaining the necessary local authority consents/approvals For Party Wall etc. Act 1996 see Government booklet or website.	Status:		Client: Mr & Mrs Chapman 2 Larchfield Close Aldwick Bognor Regis West Sussex PO21 4RB	Revision: D	Project: Extension
	Preliminary	☐ Tender		Scale:1:100@A3	Content: Proposed floor and roof plans
	Planning	☒ Construction		Date: Mar 20	
	Building Regulations	☐ As Built		Dwg No: CC004	