


No	A	135	09
Received			

A. APPROX. VERT
 DIMS ADDED
 FOR ROOFS 5.5.99

B. GENERAL
 REVISIONS JAN 2000

C. ORIEL OMITTED FEB 2000

7

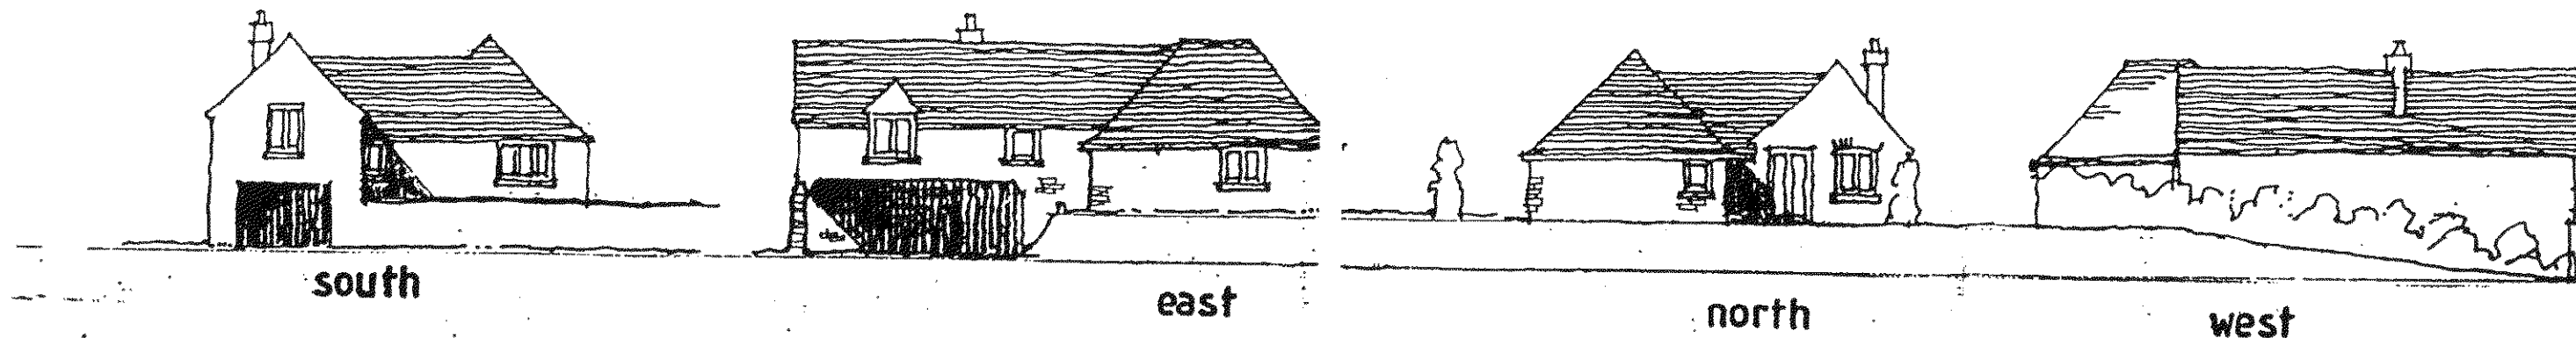

e levations



street scene from ~~neavers~~ ^{neavers} ~~viewing~~ ^{viewing} the High Street.

3. A	114	99
SUBSTITUTION		
RECEIVED	24.2.00.	

bill abem, rba, architect.

DWG TITLE ELEVATIONS + ST
 THE OLD FOURMELER, ALANWAT ROAD, BERRAM, CHESTER, WYLS

STREET SCENE

DATE 09.12
 SCALE 1:200

201 No	DWG No	REVISION
592	04	ABG