



Section Inspection - 20/07/2021 - S18X

Item No. 145	Insp. No. 1	Date 20/07/21	Time 9:02	Client's Job Ref Not Specified	Weather No Rain Or Snow	Pre Cleaned Yes	PLR S18X
Operator Luke		Vehicle Not Specified		Camera Not Specified	Preset Length Not Specified	Legal Status Private Drain	Alternative ID Not Specified

Town or Village:	Angmering	Inspection Direction:	Downstream	Upstream Node:	S18
Road:	Dappers Lane	Inspected Length:	14.00 m	Upstream Pipe Depth:	
Location:	Property or buildings	Total Length:	14.00 m	Downstream Node:	S19
Surface Type:		Joint Length:		Downstream Pipe Depth:	
Use:	Surface water	Pipe Shape:	Circular		
Type of Pipe:	Gravity drain/sewer	Dia/Height:	100 mm		
Flow Control:	No flow control	Material:	Polyvinyl chloride		
Year Constructed:	Not Specified	Lining Type:	No Lining		
Inspection Purpose:	Routine inspection	Lining Material:	No Lining		

Comments:

Recommendations:

Scale: 1:121 Position [m] Code Observation Grade

Depth: m

S18



0.00

MH

Start node, manhole, reference: S18

0.00

WL

Water level, 0% of the vertical dimension

0.10

LL

Line deviates left

1.50

LL

Line deviates left

3.20

JN

Junction at 9 o'clock, 100mm dia

3.60

JN

Junction at 3 o'clock, 100mm dia

9.60

JN

Junction at 11 o'clock, 100mm dia

14.00

MHF

Finish node, manhole, reference: S19

S19

Depth: m

Construction Features

Structural Defects

Miscellaneous Features

Service & Operational Observations

STR No. Def	STR Peak	STR Mean	STR Total	STR Grade	SER No. Def	SER Peak	SER Mean	SER Total	SER Grade
0	0.0	0.0	0.0	1.0	0	0.0	0.0	0.0	1.0

Dappers Lane

313




Section Pictures - 20/07/2021 - S18X


Item No.	Inspection Direction	PLR	Client's Job Ref	Contractor's Job Ref
145	Downstream	S18X		




1, 00:00:03, 0.10 m
Line deviates left

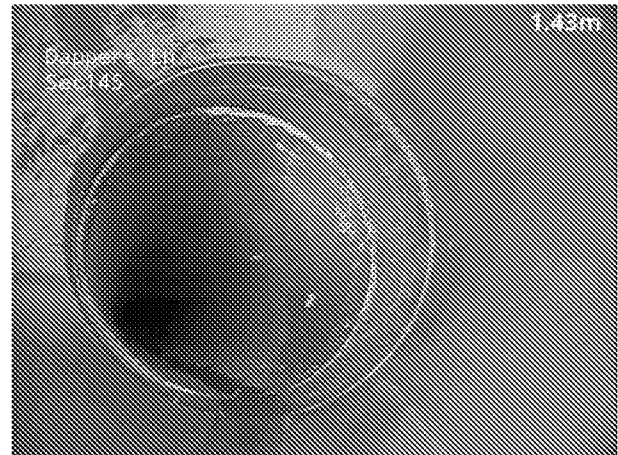

2, 00:00:14, 1.50 m
Line deviates left

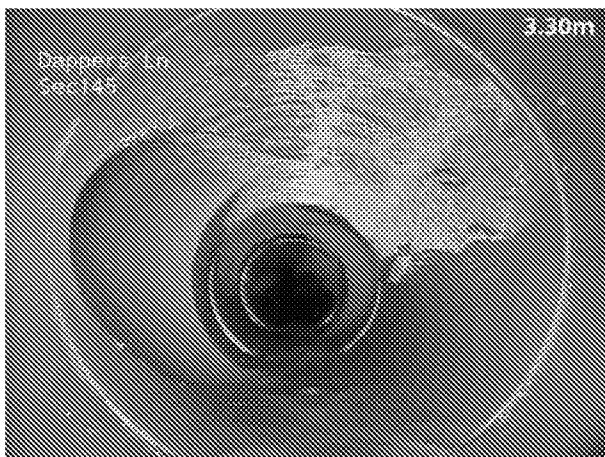


3, 00:00:25, 3.20 m
Junction at 9 o'clock, 100mm dia

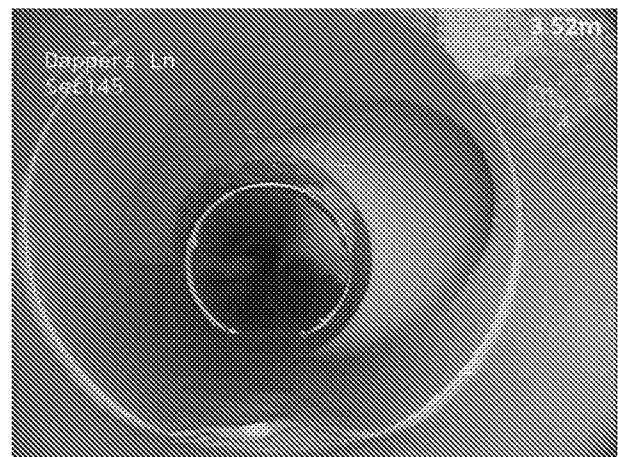

4, 00:00:30, 3.60 m
Junction at 3 o'clock, 100mm dia



5, 00:01:02, 9.60 m
Junction at 11 o'clock, 100mm dia

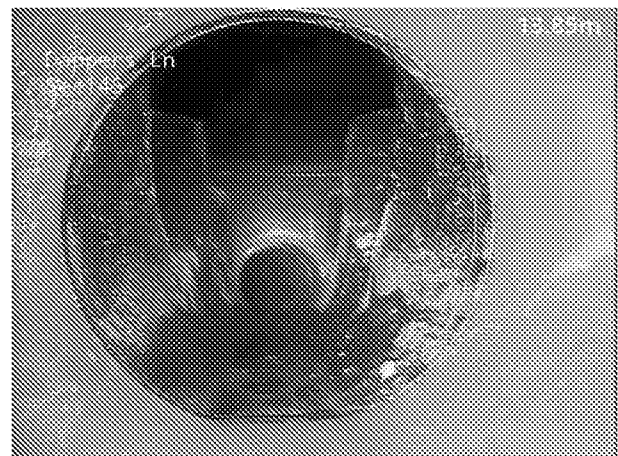

6, 00:01:22, 14.00 m
Finish node, manhole, reference: S19



Section Inspection - 20/07/2021 - RWPX

Item No. 146	Insp. No. 1	Date 20/07/21	Time 9:18	Client's Job Ref Not Specified	Weather No Rain Or Snow	Pre Cleaned Yes	PLR RWPX
Operator Luke		Vehicle Not Specified		Camera Not Specified	Preset Length Not Specified	Legal Status Private Drain	Alternative ID Not Specified

Town or Village:	Angmering	Inspection Direction:	Upstream	Upstream Node:	RWP
Road:	Dappers Lane	Inspected Length:	3.80 m	Upstream Pipe Depth:	
Location:	Property or buildings	Total Length:	3.80 m	Downstream Node:	S19
Surface Type:		Joint Length:		Downstream Pipe Depth:	
Use:	Surface water	Pipe Shape:	Circular		
Type of Pipe:	Gravity drain/sewer	Dia/Height:	100 mm		
Flow Control:	No flow control	Material:	Polyvinyl chloride		
Year Constructed:	Not Specified	Lining Type:	No Lining		
Inspection Purpose:	Routine inspection	Lining Material:	No Lining		

Comments:

Recommendations:

Scale: 1:50 Position [m] Code Observation Grade

Depth: m

S19



0.00

MH

Start node, manhole, reference: S19

0.00

WL

Water level, 0% of the vertical dimension

3.80

LU

Line deviates up

3.80

GYF

Finish node, gully, reference: ACO

RWP

Depth: m

Construction Features

Structural Defects

Miscellaneous Features

Service & Operational Observations


STR No. Def	STR Peak	STR Mean	STR Total	STR Grade	SER No. Def	SER Peak	SER Mean	SER Total	SER Grade
0	0.0	0.0	0.0	1.0	0	0.0	0.0	0.0	1.0

Dappers Lane

315

Section Pictures - 20/07/2021 - RWPX

Item No.	Inspection Direction	PLR	Client's Job Ref	Contractor's Job Ref
146	Upstream	RWPX		

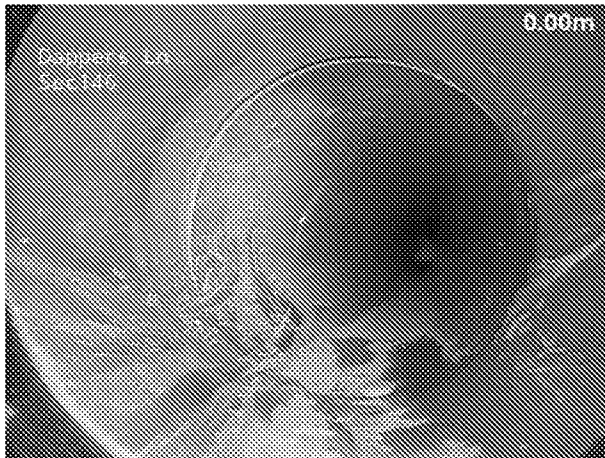

1, 00:00:06, 0.00 m
Water level, 0% of the vertical dimension



2, 00:00:22, 3.60 m
Line deviates up



3, 00:00:26, 3.80 m
Finish node, gully, reference: ACO



Section Inspection - 20/07/2021 - REX

Item No. 147	Insp. No. 1	Date 20/07/21	Time 10:19	Client's Job Ref Not Specified	Weather No Rain Or Snow	Pre Cleaned Yes	PLR REX
Operator Luke		Vehicle Not Specified		Camera Not Specified	Preset Length Not Specified	Legal Status Private Drain	Alternative ID Not Specified

Town or Village:	Angmering	Inspection Direction:	Upstream	Upstream Node:	RE
Road:	Dappers Lane	Inspected Length:	13.50 m	Upstream Pipe Depth:	
Location:	Property or buildings	Total Length:	13.50 m	Downstream Node:	S20
Surface Type:		Joint Length:		Downstream Pipe Depth:	
Use:	Surface water	Pipe Shape:	Circular		
Type of Pipe:	Gravity drain/sewer	Dia/Height:	100 mm		
Flow Control:	No flow control	Material:	Polyvinyl chloride		
Year Constructed:	Not Specified	Lining Type:	No Lining		
Inspection Purpose:	Routine inspection	Lining Material:	No Lining		

Comments:

Recommendations:

Scale: 1:117	Position [m]	Code	Observation	Grade
Depth: m				
S20				
0.00	MH	Start node, manhole, reference: S20		
0.00	WL	Water level, 0% of the vertical dimension		
0.10	LR	Line deviates right		
5.10	JN	Junction at 3 o'clock, 100mm dia		
8.70	JN	Junction at 3 o'clock, 100mm dia		
12.90	JN	Junction at 3 o'clock, 100mm dia		
13.00	LU	Line deviates up		
13.50	REF	Finish node, rodding eye, reference: RE		
RE				
Depth: m				

Construction Features

Structural Defects

Miscellaneous Features

Service & Operational Observations

STR No. Def	STR Peak	STR Mean	STR Total	STR Grade	SER No. Def	SER Peak	SER Mean	SER Total	SER Grade
0	0.0	0.0	0.0	1.0	0	0.0	0.0	0.0	1.0


Dappers Lane

317




Section Pictures - 20/07/2021 - REX

Item No.	Inspection Direction	PLR	Client's Job Ref	Contractor's Job Ref
147	Upstream	REX		

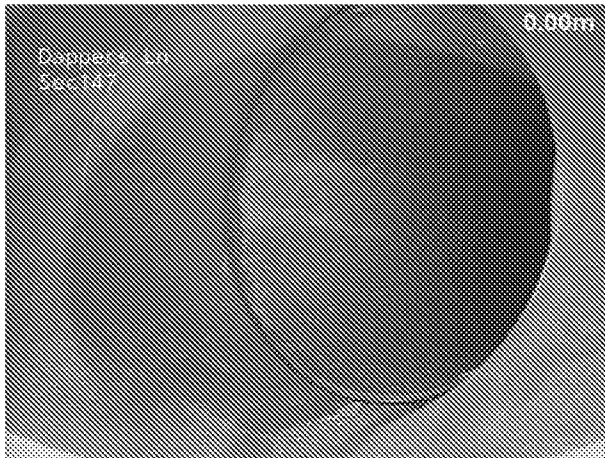

1, 00:00:03, 0.10 m
Line deviates right

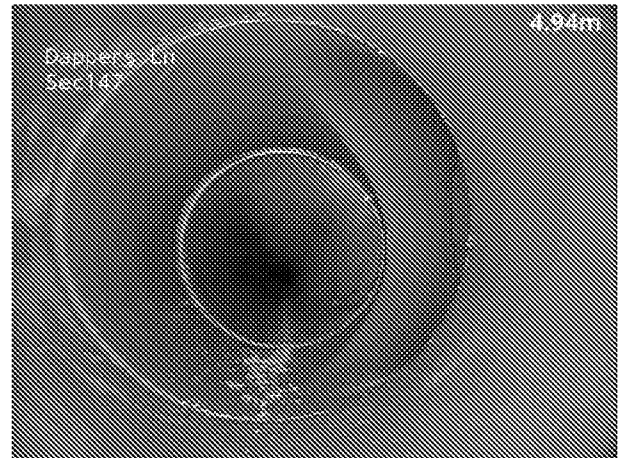


2, 00:00:24, 5.10 m
Junction at 3 o'clock, 100mm dia



3, 00:00:37, 8.70 m
Junction at 3 o'clock, 100mm dia



4, 00:00:49, 12.90 m
Junction at 3 o'clock, 100mm dia

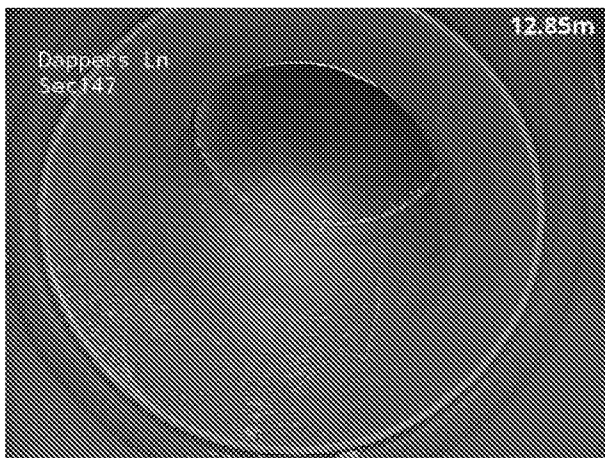

5, 00:00:52, 13.00 m
Line deviates up



6, 00:00:56, 13.50 m
Finish node, rodding eye, reference: RE



Section Inspection - 20/07/2021 - RWPX


Item No. 148	Insp. No. 1	Date 20/07/21	Time 10:21	Client's Job Ref Not Specified	Weather No Rain Or Snow	Pre Cleaned Yes	PLR RWPX
Operator Luke		Vehicle Not Specified		Camera Not Specified	Preset Length Not Specified	Legal Status Private Drain	Alternative ID Not Specified

Town or Village:	Angmering	Inspection Direction:	Upstream	Upstream Node:	RWP
Road:	Dappers Lane	Inspected Length:	1.00 m	Upstream Pipe Depth:	
Location:	Property or buildings	Total Length:	1.00 m	Downstream Node:	S20
Surface Type:		Joint Length:		Downstream Pipe Depth:	
Use:	Surface water	Pipe Shape:	Circular		
Type of Pipe:	Gravity drain/sewer	Dia/Height:	100 mm		
Flow Control:	No flow control	Material:	Polyvinyl chloride		
Year Constructed:	Not Specified	Lining Type:	No Lining		
Inspection Purpose:	Routine inspection	Lining Material:	No Lining		

Comments:

Recommendations:

Scale: 1:50 Position [m] Code Observation Grade

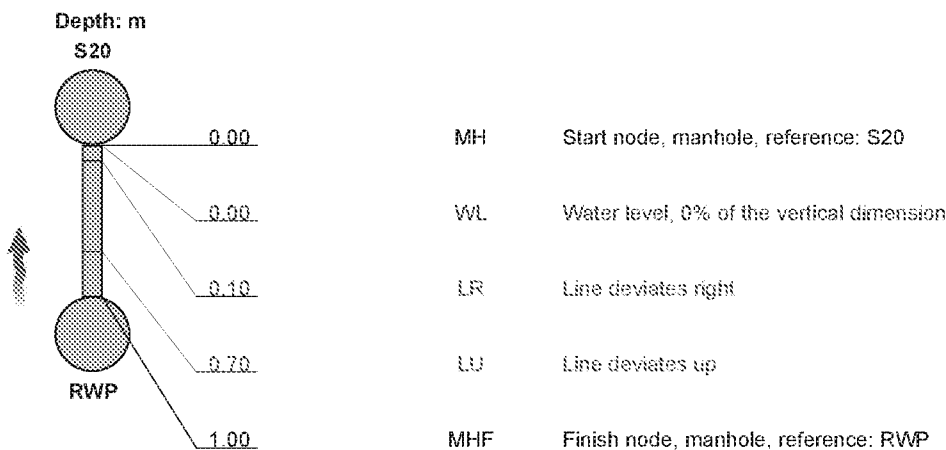

Depth: m

Construction Features					Miscellaneous Features				
Structural Defects					Service & Operational Observations				
STR No. Def	STR Peak	STR Mean	STR Total	STR Grade	SER No. Def	SER Peak	SER Mean	SER Total	SER Grade
0	0.0	0.0	0.0	1.0	0	0.0	0.0	0.0	1.0


Dappers Lane

319



Section Pictures - 20/07/2021 - RWPX

Item No.	Inspection Direction	PLR	Client's Job Ref	Contractor's Job Ref
148	Upstream	RWPX		

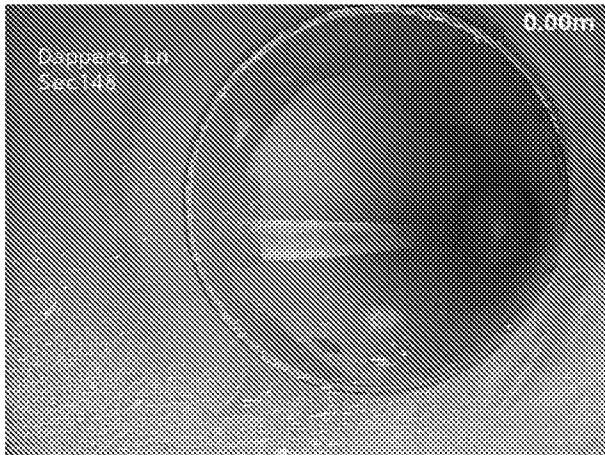

1, 00:00:03, 0.10 m
Line deviates right



2, 00:00:12, 0.70 m
Line deviates up



3, 00:00:16, 1.00 m
Finish node, manhole, reference: RWP



Section Inspection - 20/07/2021 - S20X

Item No. 149	Insp. No. 1	Date 20/07/21	Time 10:26	Client's Job Ref Not Specified	Weather No Rain Or Snow	Pre Cleaned Yes	PLR S20X
Operator Luke		Vehicle Not Specified		Camera Not Specified	Preset Length Not Specified	Legal Status Private Drain	Alternative ID Not Specified

Town or Village:	Angmering	Inspection Direction:	Downstream	Upstream Node:	S20
Road:	Dappers Lane	Inspected Length:	15.70 m	Upstream Pipe Depth:	
Location:	Property or buildings	Total Length:	15.70 m	Downstream Node:	S21
Surface Type:		Joint Length:		Downstream Pipe Depth:	
Use:	Surface water	Pipe Shape:	Circular		
Type of Pipe:	Gravity drain/sewer	Dia/Height:	100 mm		
Flow Control:	No flow control	Material:	Polyvinyl chloride		
Year Constructed:	Not Specified	Lining Type:	No Lining		
Inspection Purpose:	Routine inspection	Lining Material:	No Lining		

Comments:

Recommendations:

Scale: 1:136 Position [m] Code Observation Grade

Depth: m

S20



0.00

MH

Start node, manhole, reference: S20

0.00

WL

Water level, 0% of the vertical dimension

0.10

LL

Line deviates left

1.40

JN

Junction at 9 o'clock, 100mm dia

10.30

LL

Line deviates left

15.70

MHF

Finish node, manhole, reference: S21

S21

Depth: m

Construction Features

Structural Defects

Miscellaneous Features

Service & Operational Observations

STR No. Def	STR Peak	STR Mean	STR Total	STR Grade	SER No. Def	SER Peak	SER Mean	SER Total	SER Grade
0	0.0	0.0	0.0	1.0	0	0.0	0.0	0.0	1.0

Dappers Lane


321

Section Pictures - 20/07/2021 - S20X

Item No.	Inspection Direction	PLR	Client's Job Ref	Contractor's Job Ref
149	Downstream	S20X		



1, 00:00:02, 0.10 m
Line deviates left

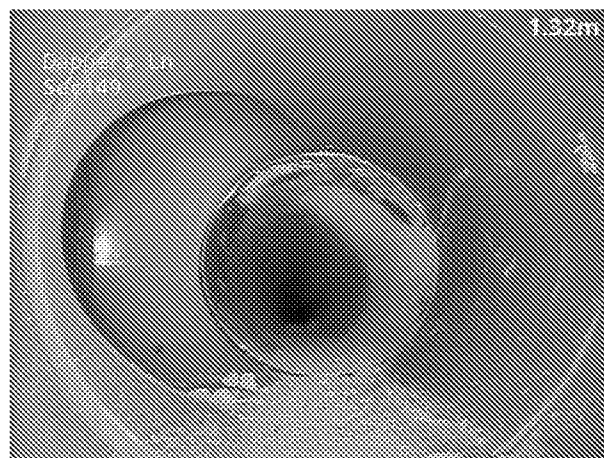

2, 00:00:10, 1.40 m
Junction at 9 o'clock, 100mm dia



3, 00:00:37, 10.30 m
Line deviates left



4, 00:00:58, 15.70 m
Finish node, manhole, reference: S21



Section Inspection - 20/07/2021 - ACOX

Item No. 150	Insp. No. 1	Date 20/07/21	Time 10:34	Client's Job Ref Not Specified	Weather No Rain Or Snow	Pre Cleaned Yes	PLR ACOX
Operator Luke		Vehicle Not Specified		Camera Not Specified	Preset Length Not Specified	Legal Status Private Drain	Alternative ID Not Specified

Town or Village:	Angmering	Inspection Direction:	Upstream	Upstream Node:	ACO
Road:	Dappers Lane	Inspected Length:	4.50 m	Upstream Pipe Depth:	
Location:	Property or buildings	Total Length:	4.50 m	Downstream Node:	S21
Surface Type:		Joint Length:		Downstream Pipe Depth:	
Use:	Surface water	Pipe Shape:	Circular		
Type of Pipe:	Gravity drain/sewer	Dia/Height:	100 mm		
Flow Control:	No flow control	Material:	Polyvinyl chloride		
Year Constructed:	Not Specified	Lining Type:	No Lining		
Inspection Purpose:	Routine inspection	Lining Material:	No Lining		

Comments:

Recommendations:

Scale: 1:50 Position [m] Code Observation Grade

Depth: m

S21



0.00

MH

Start node, manhole, reference: S21

0.00

WL

Water level, 0% of the vertical dimension

3.70

LU

Line deviates up

4.50

GYF

Finish node, gully, reference: ACO

ACO

Depth: m

Construction Features

Structural Defects

Miscellaneous Features

Service & Operational Observations

STR No. Def	STR Peak	STR Mean	STR Total	STR Grade	SER No. Def	SER Peak	SER Mean	SER Total	SER Grade
0	0.0	0.0	0.0	1.0	0	0.0	0.0	0.0	1.0


Dappers Lane

323



Section Pictures - 20/07/2021 - ACOX


Item No.	Inspection Direction	PLR	Client's Job Ref	Contractor's Job Ref
150	Upstream	ACOX		

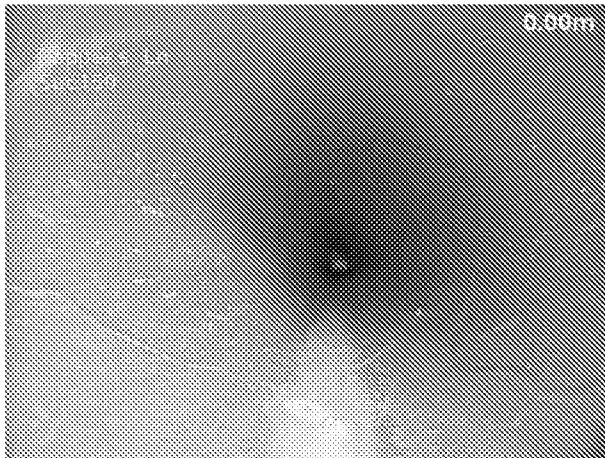

1, 00:00:02, 0.00 m
Water level, 0% of the vertical dimension



2, 00:00:16, 3.70 m
Line deviates up

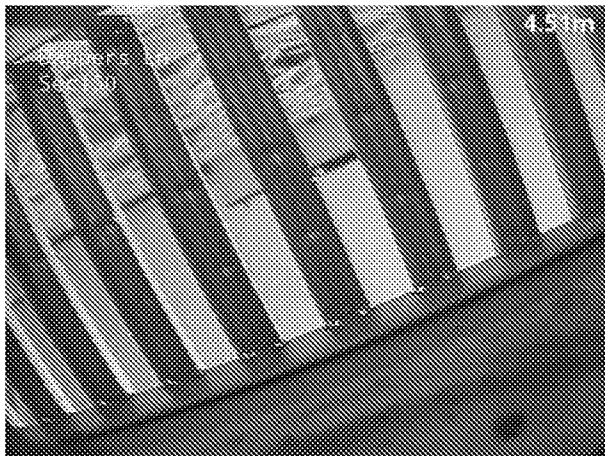

3, 00:00:14, 4.50 m
Finish node, gully, reference: ACO



Section Inspection - 20/07/2021 - AX


Item No. 151	Insp. No. 1	Date 20/07/21	Time 10:35	Client's Job Ref Not Specified	Weather No Rain Or Snow	Pre Cleaned Yes	PLR AX
Operator Luke		Vehicle Not Specified		Camera Not Specified	Preset Length Not Specified	Legal Status Private Drain	Alternative ID Not Specified

Town or Village:	Angmering	Inspection Direction:	Upstream	Upstream Node:	A
Road:	Dappers Lane	Inspected Length:	2.10 m	Upstream Pipe Depth:	
Location:	Property or buildings	Total Length:	2.10 m	Downstream Node:	S21
Surface Type:		Joint Length:		Downstream Pipe Depth:	
Use:	Surface water	Pipe Shape:	Circular		
Type of Pipe:	Gravity drain/sewer	Dia/Height:	100 mm		
Flow Control:	No flow control	Material:	Polyvinyl chloride		
Year Constructed:	Not Specified	Lining Type:	No Lining		
Inspection Purpose:	Routine inspection	Lining Material:	No Lining		

Comments:

Recommendations:

Scale: 1:50 Position [m] Code Observation Grade

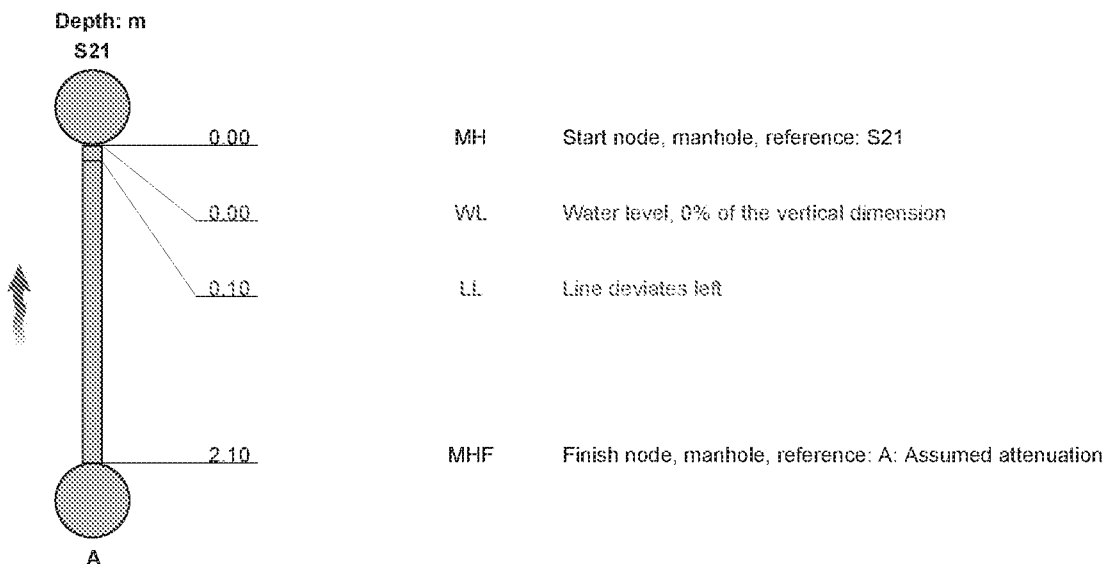

Depth: m

Construction Features					Miscellaneous Features				
Structural Defects					Service & Operational Observations				
STR No. Def	STR Peak	STR Mean	STR Total	STR Grade	SER No. Def	SER Peak	SER Mean	SER Total	SER Grade
0	0.0	0.0	0.0	1.0	0	0.0	0.0	0.0	1.0

Dappers Lane

325




Section Pictures - 20/07/2021 - AX

Item No.	Inspection Direction	PLR	Client's Job Ref	Contractor's Job Ref
151	Upstream	AX		



1, 00:00:02, 0.10 m
Line deviates left

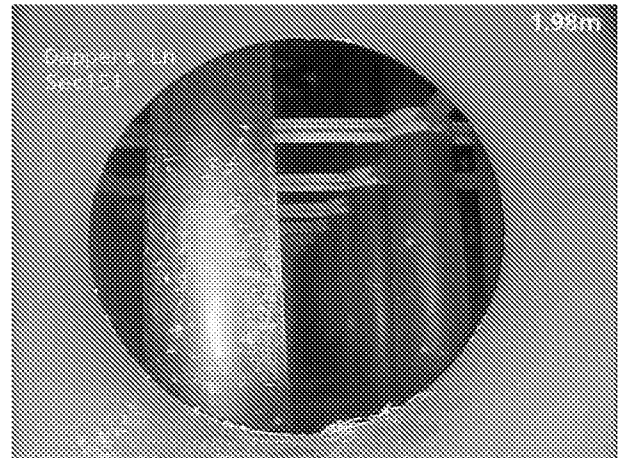

2, 00:00:22, 2.10 m
Finish node, manhole, reference: A, Assumed attenuation



Section Inspection - 20/07/2021 - SP46X

Item No. 152	Insp. No. 1	Date 20/07/21	Time 10:46	Client's Job Ref Not Specified	Weather No Rain Or Snow	Pre Cleaned Yes	PLR SP46X
Operator Luke		Vehicle Not Specified		Camera Not Specified	Preset Length Not Specified	Legal Status Private Drain	Alternative ID Not Specified

Town or Village:	Angmering	Inspection Direction:	Downstream	Upstream Node:	SP46
Road:	Dappers Lane	Inspected Length:	14.40 m	Upstream Pipe Depth:	
Location:	Property or buildings	Total Length:	14.40 m	Downstream Node:	F14
Surface Type:		Joint Length:		Downstream Pipe Depth:	
Use:	Foul	Pipe Shape:	Circular		
Type of Pipe:	Gravity drain/sewer	Dia/Height:	100 mm		
Flow Control:	No flow control	Material:	Polyvinyl chloride		
Year Constructed:	Not Specified	Lining Type:	No Lining		
Inspection Purpose:	Routine inspection	Lining Material:	No Lining		

Comments:

Recommendations:

Scale: 1:125 Position [m] Code Observation Grade

Depth: m

SP46



0.00

MH

Start node, manhole, reference: SP46

0.00

WL

Water level, 0% of the vertical dimension

1.50

REM

General remark: Rest bend

8.70

LL

Line deviates left

14.40

MHF

Finish node, manhole, reference: F14

F14

Depth: m

Construction Features

Structural Defects

Miscellaneous Features

Service & Operational Observations

STR No. Def	STR Peak	STR Mean	STR Total	STR Grade	SER No. Def	SER Peak	SER Mean	SER Total	SER Grade
0	0.0	0.0	0.0	1.0	0	0.0	0.0	0.0	1.0

Dappers Lane

327

Section Pictures - 20/07/2021 - SP46X

Item No.	Inspection Direction	PLR	Client's Job Ref	Contractor's Job Ref
152	Downstream	SP46X		




1, 00:01:34, 0.00 m
Water level, 0% of the vertical dimension



2, 00:01:21, 1.50 m
General remark, Rest bend



3, 00:00:50, 8.70 m
Line deviates left

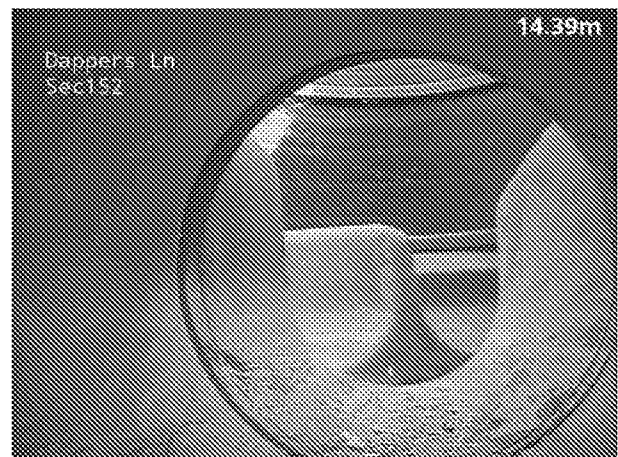

4, 00:00:04, 14.40 m
Finish node, manhole, reference: F14



Section Inspection - 20/07/2021 - SP47X

Item No. 153	Insp. No. 1	Date 20/07/21	Time 10:58	Client's Job Ref Not Specified	Weather No Rain Or Snow	Pre Cleaned Yes	PLR SP47X
Operator Luke		Vehicle Not Specified		Camera Not Specified	Preset Length Not Specified	Legal Status Private Drain	Alternative ID Not Specified

Town or Village:	Angmering	Inspection Direction:	Downstream	Upstream Node:	SP47
Road:	Dappers Lane	Inspected Length:	9.40 m	Upstream Pipe Depth:	
Location:	Property or buildings	Total Length:	9.40 m	Downstream Node:	F20
Surface Type:		Joint Length:		Downstream Pipe Depth:	
Use:	Foul	Pipe Shape:	Circular		
Type of Pipe:	Gravity drain/sewer	Dia/Height:	100 mm		
Flow Control:	No flow control	Material:	Polyvinyl chloride		
Year Constructed:	Not Specified	Lining Type:	No Lining		
Inspection Purpose:	Routine inspection	Lining Material:	No Lining		

Comments:

Recommendations:

Scale: 1:82 Position [m] Code Observation Grade

Depth: m

SP47



0.00

MH

Start node, manhole, reference: SP47

0.00

WL

Water level, 0% of the vertical dimension

0.60

REM

General remark: Rest bend

0.80

WL

Water level, 5% of the vertical dimension

1.10

LL

Line deviates left

5.80

LL

Line deviates left

9.40

MHF

Finish node, manhole, reference: F20



F20

Depth: m

Construction Features

Structural Defects

Miscellaneous Features

Service & Operational Observations

STR No. Def	STR Peak	STR Mean	STR Total	STR Grade	SER No. Def	SER Peak	SER Mean	SER Total	SER Grade
0	0.0	0.0	0.0	1.0	0	0.0	0.0	0.0	1.0




Dappers Lane

329



Section Pictures - 20/07/2021 - SP47X

Item No.	Inspection Direction	PLR	Client's Job Ref	Contractor's Job Ref
153	Downstream	SP47X		

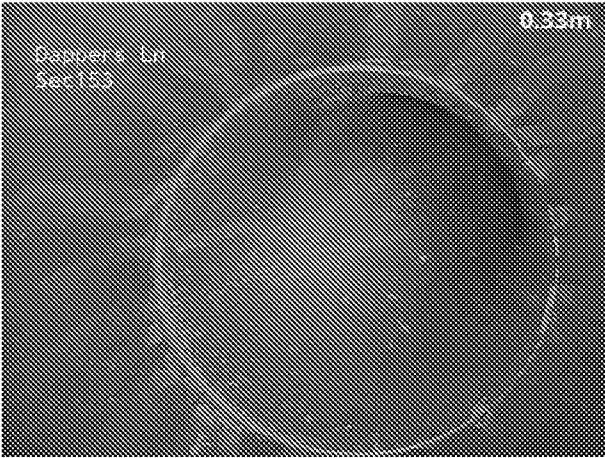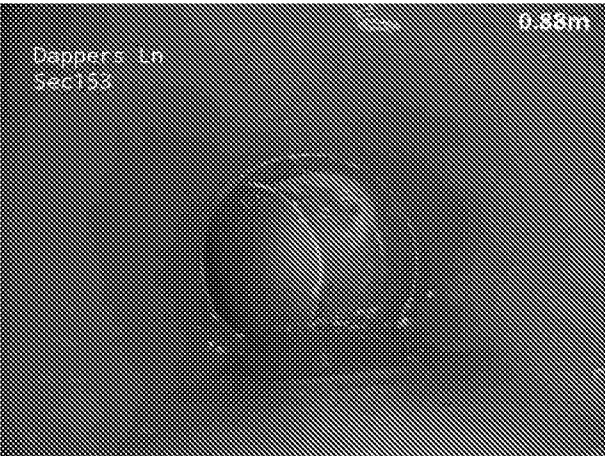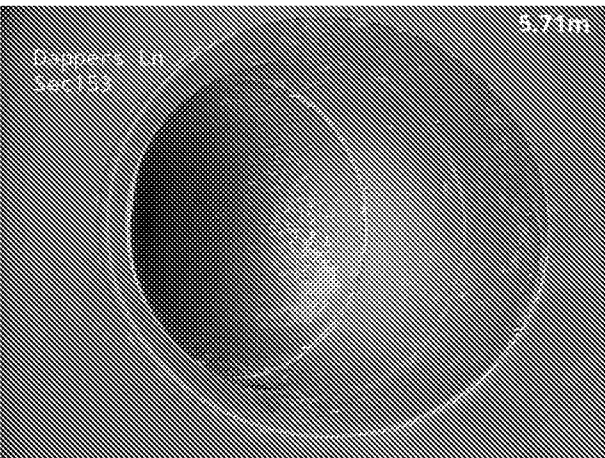 1, 00:00:02, 0.00 m Water level, 0% of the vertical dimension	 2, 00:00:06, 0.60 m General remark, Rest bend
 3, 00:00:13, 0.80 m Water level, 5% of the vertical dimension	 4, 00:00:17, 1.10 m Line deviates left
 5, 00:00:43, 5.80 m Line deviates left	 6, 00:01:07, 9.40 m Finish node, manhole, reference: F20



Section Inspection - 20/07/2021 - SP48X

Item No. 154	Insp. No. 1	Date 20/07/21	Time 11:03	Client's Job Ref Not Specified	Weather No Rain Or Snow	Pre Cleaned Yes	PLR SP48X
Operator Luke		Vehicle Not Specified		Camera Not Specified	Preset Length Not Specified	Legal Status Private Drain	Alternative ID Not Specified

Town or Village:	Angmering	Inspection Direction:	Downstream	Upstream Node:	SP48
Road:	Dappers Lane	Inspected Length:	12.00 m	Upstream Pipe Depth:	
Location:	Property or buildings	Total Length:	12.00 m	Downstream Node:	F20
Surface Type:		Joint Length:		Downstream Pipe Depth:	
Use:	Foul	Pipe Shape:	Circular		
Type of Pipe:	Gravity drain/sewer	Dia/Height:	100 mm		
Flow Control:	No flow control	Material:	Polyvinyl chloride		
Year Constructed:	Not Specified	Lining Type:	No Lining		
Inspection Purpose:	Routine inspection	Lining Material:	No Lining		

Comments:

Recommendations:

Scale: 1:104 Position [m] Code Observation Grade

Depth: m

SP48



0.00

MH

Start node, manhole, reference: SP48

0.00

WL

Water level, 0% of the vertical dimension

1.30

REM

General remark: Rest bend

12.00

MHF

Finish node, manhole, reference: F20



F20

Depth: m

Construction Features

Structural Defects

Miscellaneous Features

Service & Operational Observations

STR No. Def	STR Peak	STR Mean	STR Total	STR Grade	SER No. Def	SER Peak	SER Mean	SER Total	SER Grade
0	0.0	0.0	0.0	1.0	0	0.0	0.0	0.0	1.0

Dappers Lane

331



Section Pictures - 20/07/2021 - SP48X

Item No.
154

Inspection Direction
Downstream


PLR
SP48X

Client's Job Ref


Contractor's Job Ref



1, 00:00:03, 0.00 m
Water level, 0% of the vertical dimension

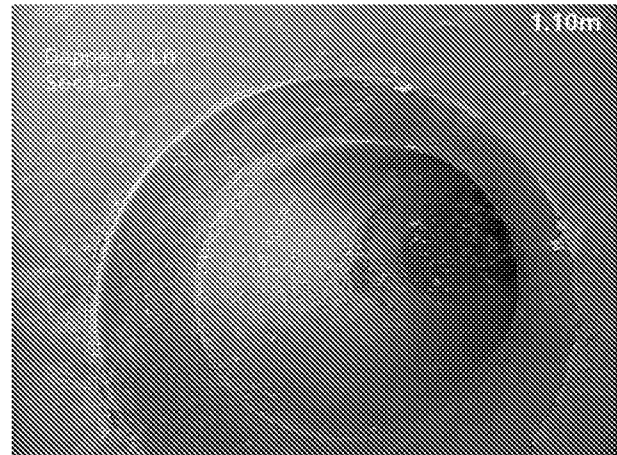

2, 00:00:13, 1.30 m
General remark, Rest bend

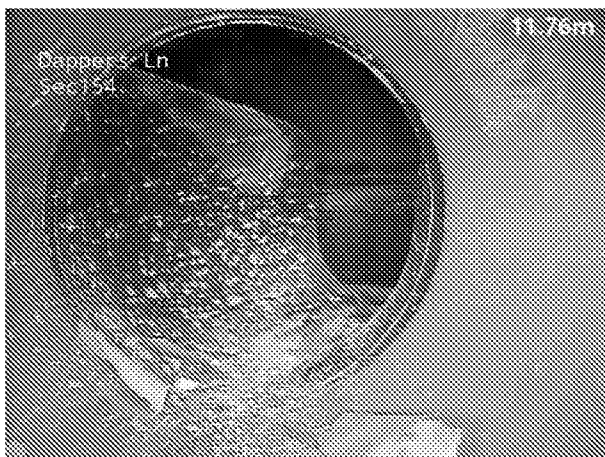

3, 00:01:03, 12.00 m
Finish node, manhole, reference: F20



Section Inspection - 20/07/2021 - REX

Item No. 155	Insp. No. 1	Date 20/07/21	Time 11:13	Client's Job Ref Not Specified	Weather No Rain Or Snow	Pre Cleaned Yes	PLR REX
Operator Luke		Vehicle Not Specified		Camera Not Specified	Preset Length Not Specified	Legal Status Private Drain	Alternative ID Not Specified

Town or Village:	Angmering	Inspection Direction:	Upstream	Upstream Node:	RE
Road:	Dappers Lane	Inspected Length:	13.00 m	Upstream Pipe Depth:	
Location:	Property or buildings	Total Length:	13.00 m	Downstream Node:	S23
Surface Type:		Joint Length:		Downstream Pipe Depth:	
Use:	Surface water	Pipe Shape:	Circular		
Type of Pipe:	Gravity drain/sewer	Dia/Height:	100 mm		
Flow Control:	No flow control	Material:	Polyvinyl chloride		
Year Constructed:	Not Specified	Lining Type:	No Lining		
Inspection Purpose:	Routine inspection	Lining Material:	No Lining		

Comments:

Recommendations:

Scale: 1:113 Position [m] Code Observation Grade

Depth: m

S23



0.00

MH

Start node, manhole, reference: S23

0.00

WL

Water level, 0% of the vertical dimension

0.10

LR

Line deviates right

3.50

JN

Junction at 2 o'clock, 100mm dia

7.80

JN

Junction at 3 o'clock, 100mm dia

12.00

JN

Junction at 3 o'clock, 100mm dia

12.20

LU

Line deviates up

13.00

REF

Finish node, rodding eye, reference: RE

RE

Depth: m

Construction Features

Structural Defects

Miscellaneous Features

Service & Operational Observations

STR No. Def	STR Peak	STR Mean	STR Total	STR Grade	SER No. Def	SER Peak	SER Mean	SER Total	SER Grade
0	0.0	0.0	0.0	1.0	0	0.0	0.0	0.0	1.0


Dappers Lane

333



Section Pictures - 20/07/2021 - REX

Item No.	Inspection Direction	PLR	Client's Job Ref	Contractor's Job Ref
155	Upstream	REX		

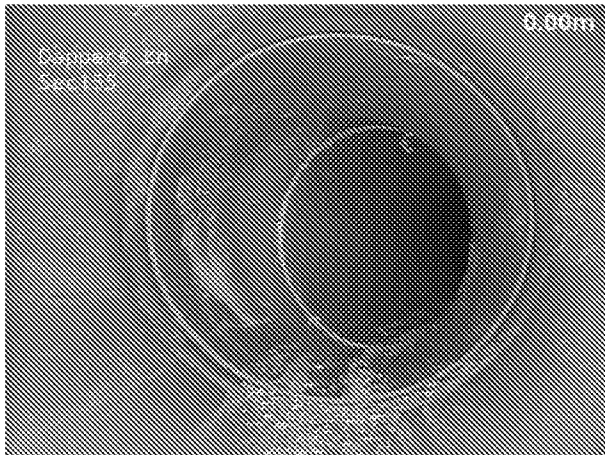

1, 00:00:50, 0.10 m
Line deviates right




2, 00:00:46, 3.50 m
Junction at 2 o'clock, 100mm dia



3, 00:00:29, 7.80 m
Junction at 3 o'clock, 100mm dia



4, 00:00:11, 12.00 m
Junction at 3 o'clock, 100mm dia

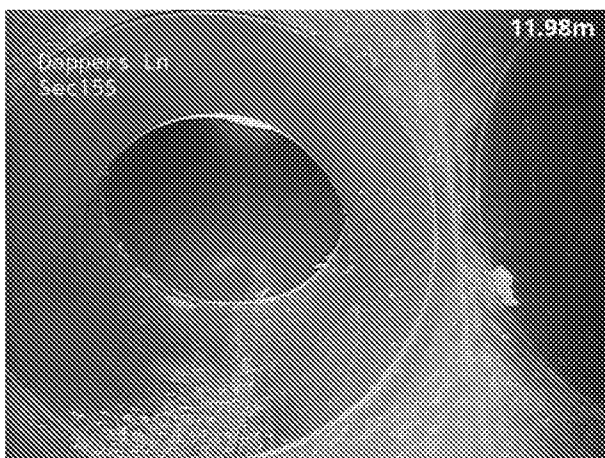

5, 00:00:06, 12.20 m
Line deviates up



6, 00:00:01, 13.00 m
Finish node, rodding eye, reference: RE



Section Inspection - 20/07/2021 - RWPX


Item No. 156	Insp. No. 1	Date 20/07/21	Time 11:14	Client's Job Ref Not Specified	Weather No Rain Or Snow	Pre Cleaned Yes	PLR RWPX
Operator Luke		Vehicle Not Specified		Camera Not Specified	Preset Length Not Specified	Legal Status Private Drain	Alternative ID Not Specified

Town or Village:	Angmering	Inspection Direction:	Upstream	Upstream Node:	RWP
Road:	Dappers Lane	Inspected Length:	1.00 m	Upstream Pipe Depth:	
Location:	Property or buildings	Total Length:	1.00 m	Downstream Node:	S23
Surface Type:		Joint Length:		Downstream Pipe Depth:	
Use:	Surface water	Pipe Shape:	Circular		
Type of Pipe:	Gravity drain/sewer	Dia/Height:	100 mm		
Flow Control:	No flow control	Material:	Polyvinyl chloride		
Year Constructed:	Not Specified	Lining Type:	No Lining		
Inspection Purpose:	Routine inspection	Lining Material:	No Lining		

Comments:

Recommendations:

Scale: 1:50 Position [m] Code Observation Grade

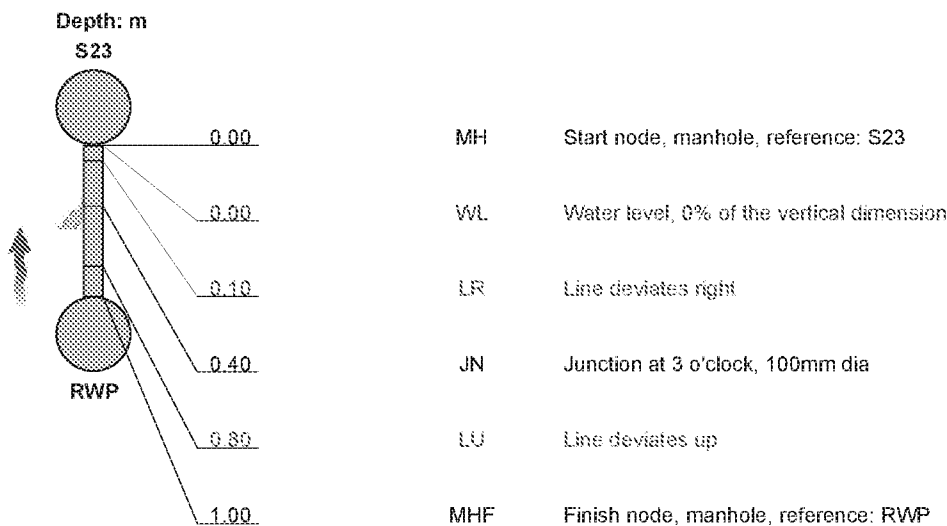

Depth: m

Construction Features					Miscellaneous Features				
Structural Defects					Service & Operational Observations				
STR No. Def	STR Peak	STR Mean	STR Total	STR Grade	SER No. Def	SER Peak	SER Mean	SER Total	SER Grade
0	0.0	0.0	0.0	1.0	0	0.0	0.0	0.0	1.0

Dappers Lane

335




Section Pictures - 20/07/2021 - RWPX

Item No.	Inspection Direction	PLR	Client's Job Ref	Contractor's Job Ref
156	Upstream	RWPX		




1, 00:00:06, 0.10 m
Line deviates right

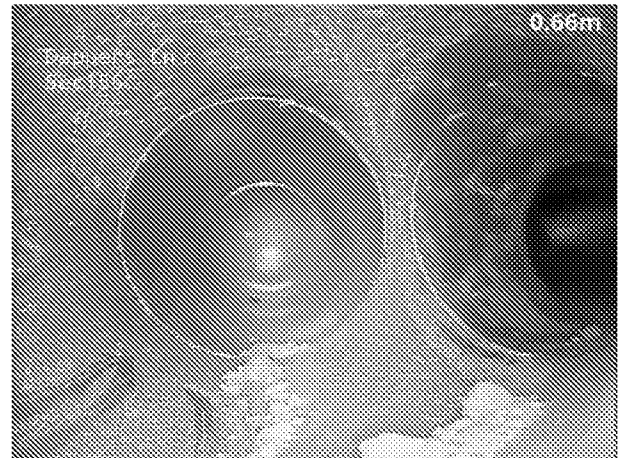

2, 00:00:18, 0.40 m
Junction at 3 o'clock, 100mm dia



3, 00:00:29, 0.80 m
Line deviates up

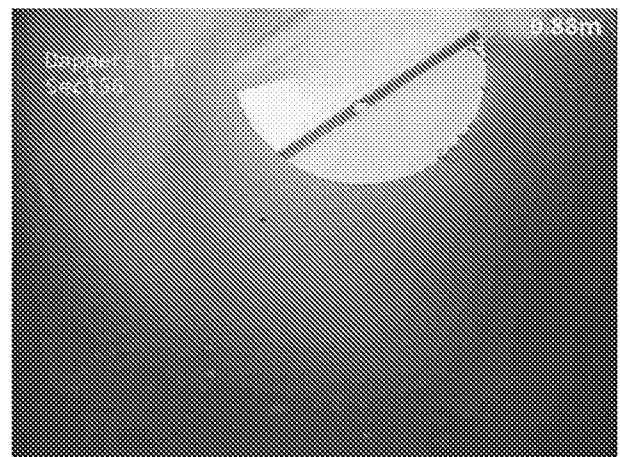

4, 00:00:35, 1.00 m
Finish node, manhole, reference: RWP



Section Inspection - 20/07/2021 - S23X

Item No. 157	Insp. No. 1	Date 20/07/21	Time 11:17	Client's Job Ref Not Specified	Weather No Rain Or Snow	Pre Cleaned Yes	PLR S23X
Operator Luke		Vehicle Not Specified		Camera Not Specified	Preset Length Not Specified	Legal Status Private Drain	Alternative ID Not Specified

Town or Village:	Angmering	Inspection Direction:	Downstream	Upstream Node:	S23
Road:	Dappers Lane	Inspected Length:	13.20 m	Upstream Pipe Depth:	
Location:	Property or buildings	Total Length:	13.20 m	Downstream Node:	S36
Surface Type:		Joint Length:		Downstream Pipe Depth:	
Use:	Surface water	Pipe Shape:	Circular		
Type of Pipe:	Gravity drain/sewer	Dia/Height:	100 mm		
Flow Control:	No flow control	Material:	Polyvinyl chloride		
Year Constructed:	Not Specified	Lining Type:	No Lining		
Inspection Purpose:	Routine inspection	Lining Material:	No Lining		

Comments:

Recommendations:

Scale: 1:114 Position [m] Code Observation Grade

Depth: m

S23



0.00

MH

Start node, manhole, reference: S23

0.00

WL

Water level, 0% of the vertical dimension

0.10

LL

Line deviates left

13.00

LR

Line deviates right

13.20

MHF

Finish node, manhole, reference: S36

S36

Depth: m

Construction Features

Structural Defects

Miscellaneous Features

Service & Operational Observations


STR No. Def	STR Peak	STR Mean	STR Total	STR Grade	SER No. Def	SER Peak	SER Mean	SER Total	SER Grade
0	0.0	0.0	0.0	1.0	0	0.0	0.0	0.0	1.0

Dappers Lane

337

Section Pictures - 20/07/2021 - S23X


Item No.	Inspection Direction	PLR	Client's Job Ref	Contractor's Job Ref
157	Downstream	S23X		

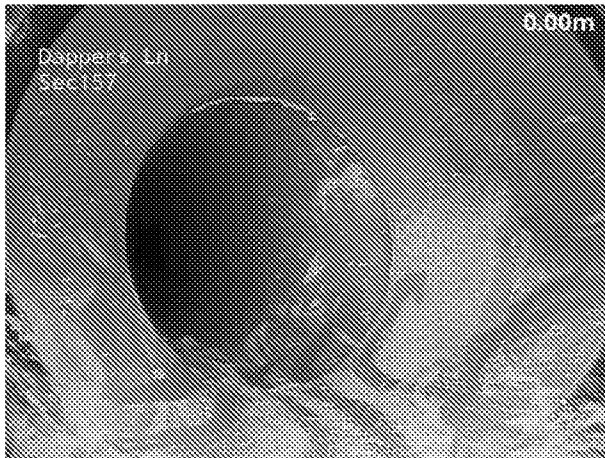

1, 00:00:02, 0.10 m
Line deviates left



2, 00:00:35, 13.00 m
Line deviates right

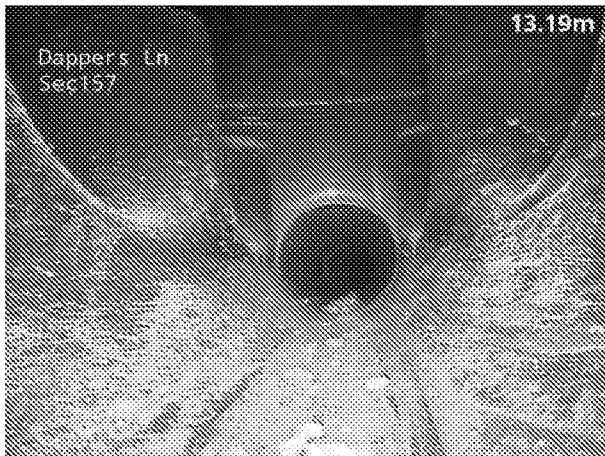

3, 00:00:40, 13.20 m
Finish node, manhole, reference: S36



Section Inspection - 20/07/2021 - ACOX

Item No. 158	Insp. No. 1	Date 20/07/21	Time 11:25	Client's Job Ref Not Specified	Weather No Rain Or Snow	Pre Cleaned Yes	PLR ACOX
Operator Luke		Vehicle Not Specified		Camera Not Specified	Preset Length Not Specified	Legal Status Private Drain	Alternative ID Not Specified

Town or Village:	Angmering	Inspection Direction:	Upstream	Upstream Node:	ACO
Road:	Dappers Lane	Inspected Length:	12.00 m	Upstream Pipe Depth:	
Location:	Property or buildings	Total Length:	12.00 m	Downstream Node:	S36
Surface Type:		Joint Length:		Downstream Pipe Depth:	
Use:	Surface water	Pipe Shape:	Circular		
Type of Pipe:	Gravity drain/sewer	Dia/Height:	100 mm		
Flow Control:	No flow control	Material:	Polyvinyl chloride		
Year Constructed:	Not Specified	Lining Type:	No Lining		
Inspection Purpose:	Routine inspection	Lining Material:	No Lining		

Comments:

Recommendations:

Scale: 1:104 Position [m] Code Observation Grade

Depth: m

S36



0.00

MH

Start node, manhole, reference: S36

0.00

WL

Water level, 0% of the vertical dimension

0.10

LL

Line deviates left

7.80

JN

Junction at 9 o'clock, 100mm dia

9.50

JN

Junction at 3 o'clock, 100mm dia

11.80

LU

Line deviates up

12.00

GYF

Finish node, gully, reference: ACO

ACO

Depth: m

Construction Features

Structural Defects

Miscellaneous Features

Service & Operational Observations

STR No. Def	STR Peak	STR Mean	STR Total	STR Grade	SER No. Def	SER Peak	SER Mean	SER Total	SER Grade
0	0.0	0.0	0.0	1.0	0	0.0	0.0	0.0	1.0


Dappers Lane

339



Section Pictures - 20/07/2021 - ACOX

Item No.	Inspection Direction	PLR	Client's Job Ref	Contractor's Job Ref
158	Upstream	ACOX		

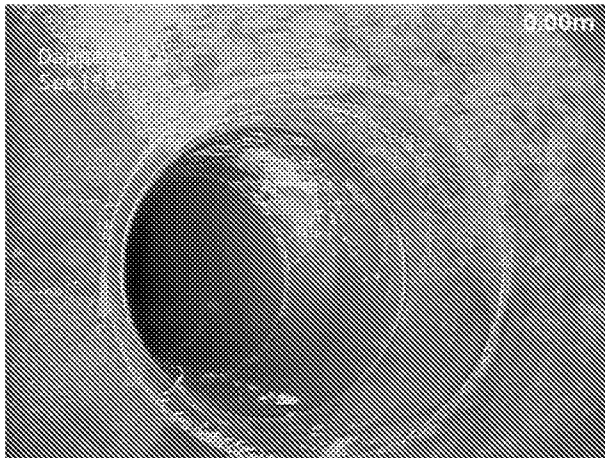

1, 00:00:04, 0.10 m
Line deviates left



2, 00:00:23, 7.80 m
Junction at 9 o'clock, 100mm dia



3, 00:00:25, 9.50 m
Junction at 3 o'clock, 100mm dia



4, 00:00:33, 11.80 m
Line deviates up



5, 00:00:38, 12.00 m
Finish node, gully, reference: ACO



Section Inspection - 20/07/2021 - RWPX

Item No. 159	Insp. No. 1	Date 20/07/21	Time 11:32	Client's Job Ref Not Specified	Weather No Rain Or Snow	Pre Cleaned Yes	PLR RWPX
Operator Luke		Vehicle Not Specified		Camera Not Specified	Preset Length Not Specified	Legal Status Private Drain	Alternative ID Not Specified

Town or Village:	Angmering	Inspection Direction:	Upstream	Upstream Node:	RWP
Road:	Dappers Lane	Inspected Length:	18.10 m	Upstream Pipe Depth:	
Location:	Property or buildings	Total Length:	18.10 m	Downstream Node:	S36
Surface Type:		Joint Length:		Downstream Pipe Depth:	
Use:	Surface water	Pipe Shape:	Circular		
Type of Pipe:	Gravity drain/sewer	Dia/Height:	100 mm		
Flow Control:	No flow control	Material:	Polyvinyl chloride		
Year Constructed:	Not Specified	Lining Type:	No Lining		
Inspection Purpose:	Routine inspection	Lining Material:	No Lining		

Comments:

Recommendations:

Scale: 1:157 Position [m] Code Observation Grade

Depth: m

S36



0.00

MH

Start node, manhole, reference: S36

0.00

WL

Water level, 0% of the vertical dimension

3.40

JN

Junction at 3 o'clock, 100mm dia

15.80

LR

Line deviates right

17.60

LU

Line deviates up

18.10

MHF

Finish node, manhole, reference: RWP

RWP

Depth: m

Construction Features

Structural Defects

Miscellaneous Features

Service & Operational Observations

STR No. Def	STR Peak	STR Mean	STR Total	STR Grade	SER No. Def	SER Peak	SER Mean	SER Total	SER Grade
0	0.0	0.0	0.0	1.0	0	0.0	0.0	0.0	1.0

Dappers Lane

341




Section Pictures - 20/07/2021 - RWPX


Item No.	Inspection Direction	PLR	Client's Job Ref	Contractor's Job Ref
159	Upstream	RWPX		



1, 00:00:00, 0.00 m
Water level, 0% of the vertical dimension

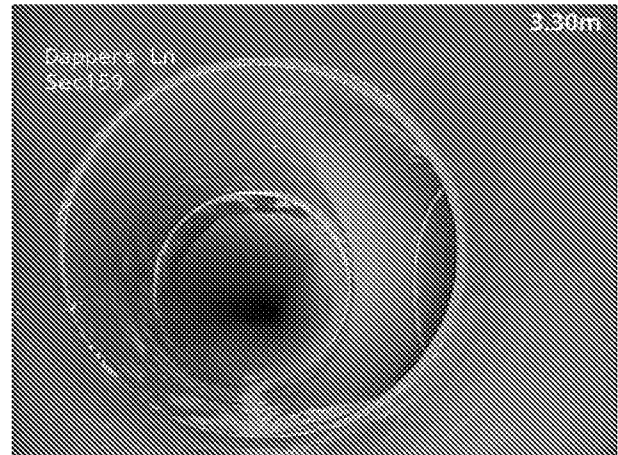

2, 00:00:13, 3.40 m
Junction at 3 o'clock, 100mm dia

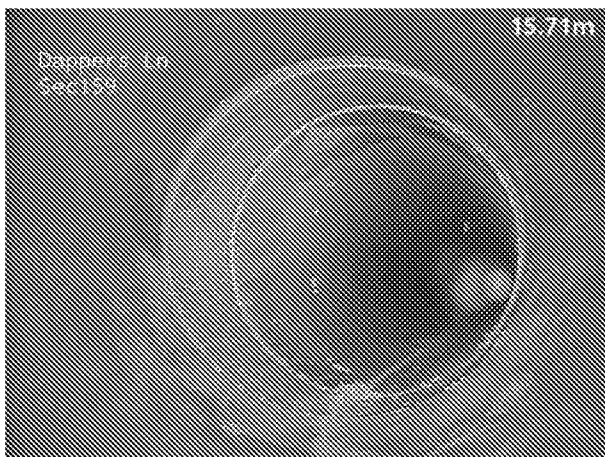

3, 00:00:37, 15.80 m
Line deviates right



4, 00:00:44, 17.60 m
Line deviates up



5, 00:00:50, 18.10 m
Finish node, manhole, reference: RWP



Section Inspection - 20/07/2021 - RE24X

Item No. 160	Insp. No. 1	Date 20/07/21	Time 12:50	Client's Job Ref Not Specified	Weather No Rain Or Snow	Pre Cleaned Yes	PLR RE24X
Operator Luke		Vehicle Not Specified		Camera Not Specified	Preset Length Not Specified	Legal Status Private Drain	Alternative ID Not Specified

Town or Village:	Angmering	Inspection Direction:	Downstream	Upstream Node:	RE24
Road:	Dappers Lane	Inspected Length:	25.20 m	Upstream Pipe Depth:	
Location:	Property or buildings	Total Length:	25.20 m	Downstream Node:	JN
Surface Type:		Joint Length:		Downstream Pipe Depth:	
Use:	Surface water	Pipe Shape:	Circular		
Type of Pipe:	Gravity drain/sewer	Dia/Height:	100 mm		
Flow Control:	No flow control	Material:	Polyvinyl chloride		
Year Constructed:	Not Specified	Lining Type:	No Lining		
Inspection Purpose:	Routine inspection	Lining Material:	No Lining		

Comments:

Recommendations:

Scale: 1:216	Position [m]	Code	Observation	Grade
Depth: m				
RE24	0.00	MH	Start node, manhole, reference: RE24	
	0.00	WL	Water level, 0% of the vertical dimension	
	0.50	REM	General remark: Line reverts horizontal	
	3.00	JN	Junction at 9 o'clock, 100mm dia	
	4.00	JN	Junction at 9 o'clock, 100mm dia	
	4.00	LL	Line deviates left	
	7.00	JN	Junction at 3 o'clock, 100mm dia	
	7.60	JN	Junction at 3 o'clock, 100mm dia	
	10.90	LR	Line deviates right	
	10.90	SC	Pipe size changes, new size(s), 150mm high	
	11.00	JN	Junction at 10 o'clock, 100mm dia	
	14.20	JN	Junction at 3 o'clock, 100mm dia	
	18.40	LR	Line deviates right	
	25.00	LD	Line deviates down	
JN	25.20	BRF	Finish node, major connection without manhole, reference: JN	
Depth: m				

Construction Features

Structural Defects

Miscellaneous Features

Service & Operational Observations

STR No. Def	STR Peak	STR Mean	STR Total	STR Grade	SER No. Def	SER Peak	SER Mean	SER Total	SER Grade
0	0.0	0.0	0.0	1.0	0	0.0	0.0	0.0	1.0

Dappers Lane

343




Section Pictures - 20/07/2021 - RE24X


Item No.	Inspection Direction	PLR	Client's Job Ref	Contractor's Job Ref
160	Downstream	RE24X		




1, 00:00:00, 0.00 m
Water level, 0% of the vertical dimension

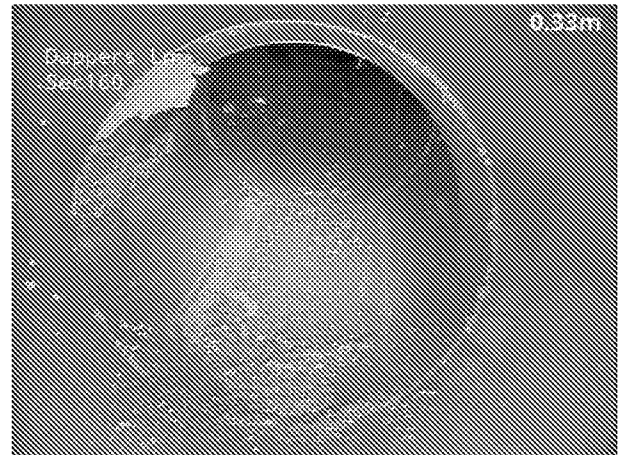


2, 00:00:05, 0.50 m
General remark, Line reverts horizontal

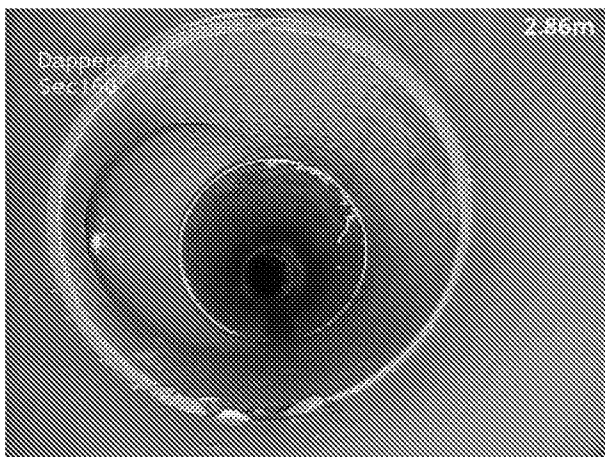


3, 00:00:14, 3.00 m
Junction at 9 o'clock, 100mm dia

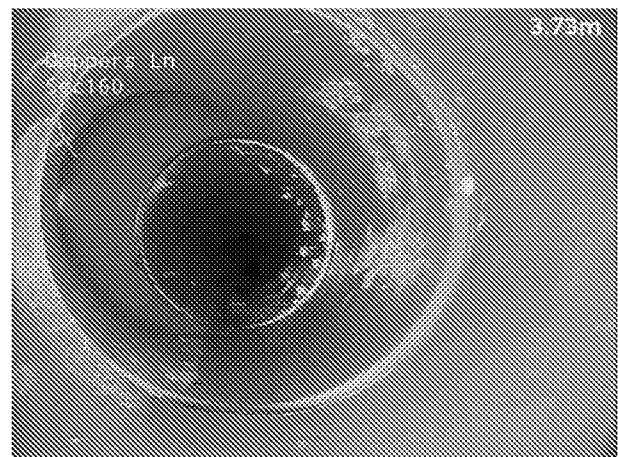

4, 00:00:18, 4.00 m
Line deviates left

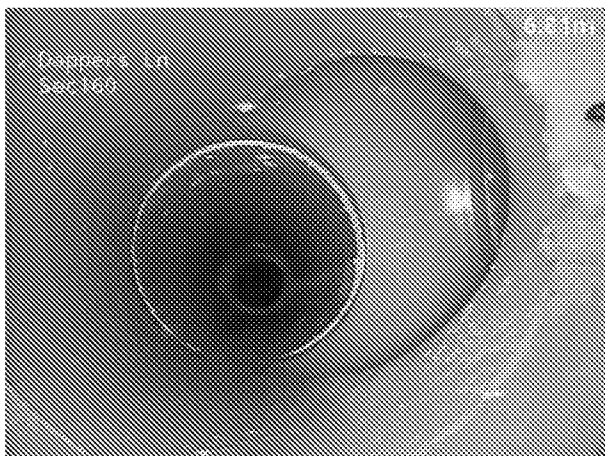

5, 00:00:27, 7.00 m
Junction at 3 o'clock, 100mm dia

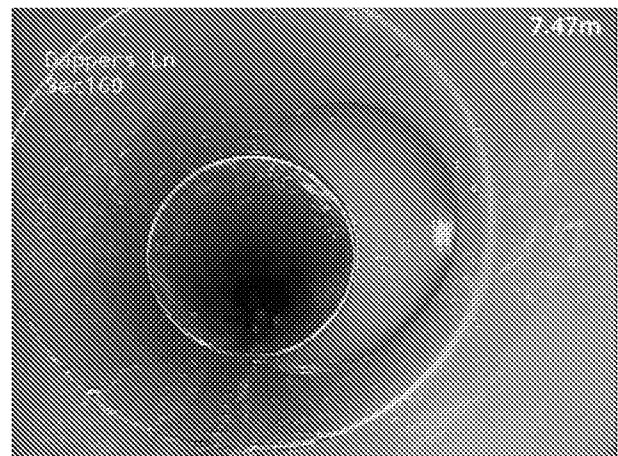


6, 00:00:35, 7.60 m
Junction at 3 o'clock, 100mm dia



Section Pictures - 20/07/2021 - RE24X

Item No.	Inspection Direction	PLR	Client's Job Ref	Contractor's Job Ref
160	Downstream	RE24X		

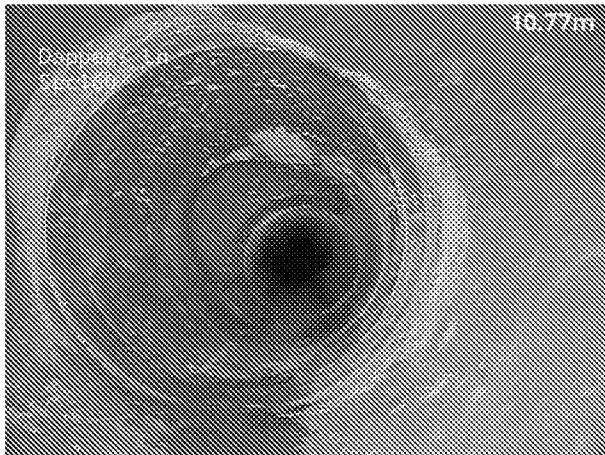

7, 00:00:49, 10.90 m
Line deviates right




8, 00:00:53, 11.00 m
Junction at 10 o'clock, 100mm dia



9, 00:01:47, 14.20 m
Junction at 3 o'clock, 100mm dia



10, 00:01:16, 18.40 m
Line deviates right

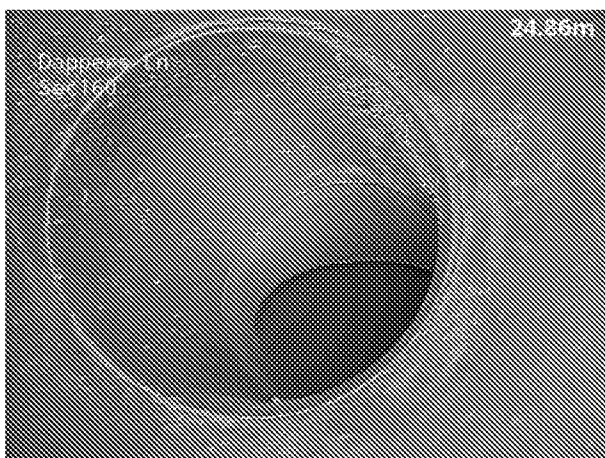

11, 00:01:39, 25.00 m
Line deviates down



12, 00:01:42, 25.20 m
Finish node, major connection without manhole, reference: JN



Section Inspection - 20/07/2021 - S41X


Item No. 161	Insp. No. 1	Date 20/07/21	Time 13:35	Client's Job Ref Not Specified	Weather No Rain Or Snow	Pre Cleaned Yes	PLR S41X
Operator Luke		Vehicle Not Specified		Camera Not Specified	Preset Length Not Specified	Legal Status Private Drain	Alternative ID Not Specified

Town or Village:	Angmering	Inspection Direction:	Upstream	Upstream Node:	S41
Road:	Dappers Lane	Inspected Length:	2.50 m	Upstream Pipe Depth:	
Location:	Property or buildings	Total Length:	2.50 m	Downstream Node:	S12
Surface Type:		Joint Length:		Downstream Pipe Depth:	
Use:	Surface water	Pipe Shape:	Circular		
Type of Pipe:	Gravity drain/sewer	Dia/Height:	100 mm		
Flow Control:	No flow control	Material:	Polyvinyl chloride		
Year Constructed:	Not Specified	Lining Type:	No Lining		
Inspection Purpose:	Routine inspection	Lining Material:	No Lining		

Comments:

Recommendations:

Scale: 1:50 Position [m] Code Observation Grade

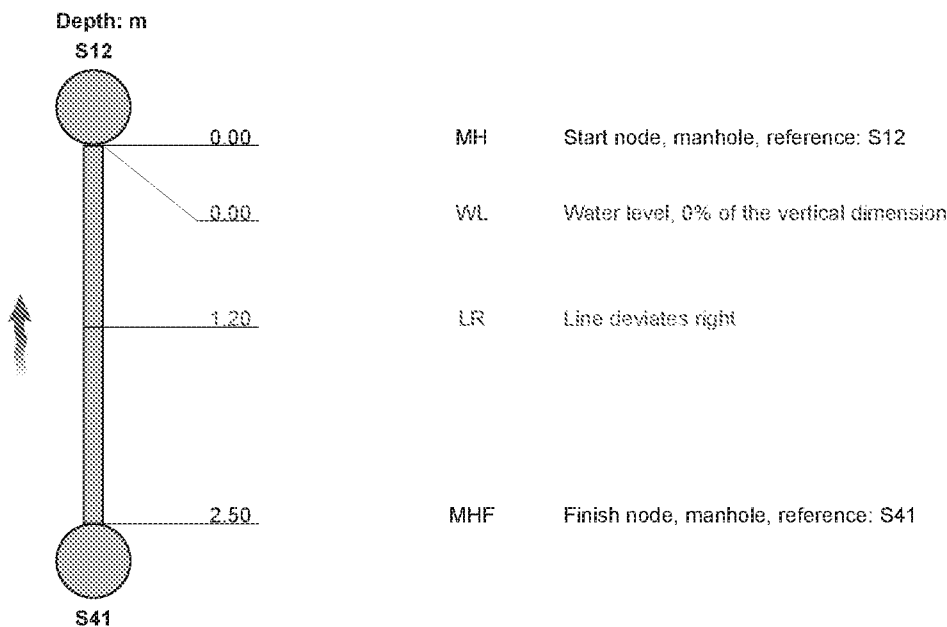

Depth: m

Construction Features					Miscellaneous Features				
Structural Defects					Service & Operational Observations				
STR No. Def	STR Peak	STR Mean	STR Total	STR Grade	SER No. Def	SER Peak	SER Mean	SER Total	SER Grade
0	0.0	0.0	0.0	1.0	0	0.0	0.0	0.0	1.0

Dappers Lane

346




Section Pictures - 20/07/2021 - S41X


Item No.	Inspection Direction	PLR	Client's Job Ref	Contractor's Job Ref
161	Upstream	S41X		



1, 00:00:00, 0.00 m
Water level, 0% of the vertical dimension

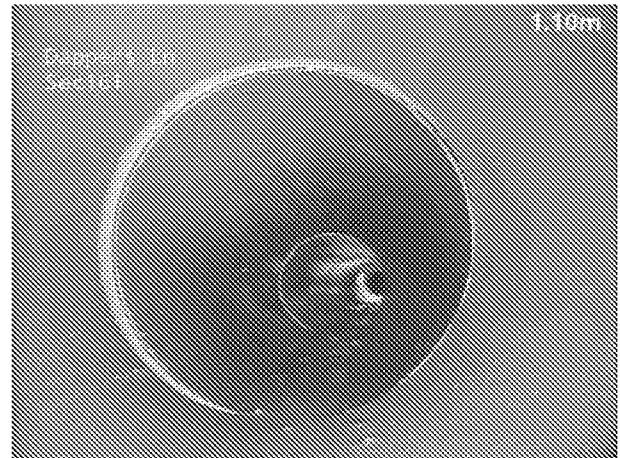

2, 00:00:08, 1.20 m
Line deviates right

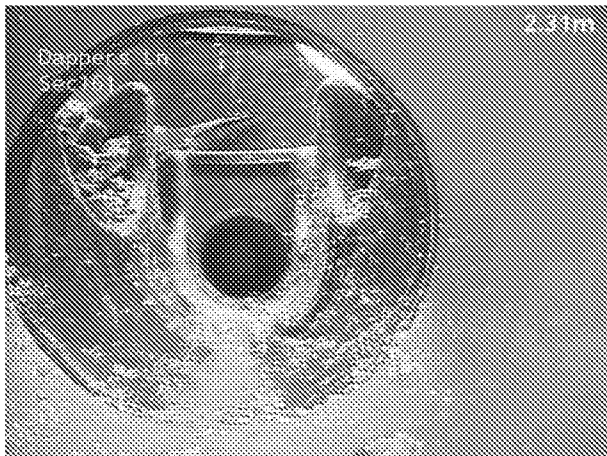

3, 00:00:15, 2.50 m
Finish node, manhole, reference: S41



Section Inspection - 20/07/2021 - RE10X

Item No. 162	Insp. No. 1	Date 20/07/21	Time 13:39	Client's Job Ref Not Specified	Weather No Rain Or Snow	Pre Cleaned Yes	PLR RE10X
Operator Luke		Vehicle Not Specified		Camera Not Specified	Preset Length Not Specified	Legal Status Private Drain	Alternative ID Not Specified

Town or Village:	Angmering	Inspection Direction:	Upstream	Upstream Node:	RE10
Road:	Dappers Lane	Inspected Length:	17.90 m	Upstream Pipe Depth:	
Location:	Property or buildings	Total Length:	17.90 m	Downstream Node:	S12
Surface Type:		Joint Length:		Downstream Pipe Depth:	
Use:	Surface water	Pipe Shape:	Circular		
Type of Pipe:	Gravity drain/sewer	Dia/Height:	100 mm		
Flow Control:	No flow control	Material:	Polyvinyl chloride		
Year Constructed:	Not Specified	Lining Type:	No Lining		
Inspection Purpose:	Routine inspection	Lining Material:	No Lining		

Comments:

Recommendations:

Scale: 1:155 Position [m] Code Observation Grade

Depth: m

S12



0.00

MH

Start node, manhole, reference: S12

0.00

WL

Water level, 0% of the vertical dimension

1.60

WL

Water level, 10% of the vertical dimension

1.90

JN

Junction at 1 o'clock, 100mm dia

6.80

JN

Junction at 3 o'clock, 100mm dia

12.60

JN

Junction at 3 o'clock, 100mm dia

17.00

JN

Junction at 3 o'clock, 10mm dia

17.20

LU

Line deviates up

17.90

RE10

REF

Finish node, rodding eye, reference: RE10

Depth: m

Construction Features

Structural Defects

Miscellaneous Features

Service & Operational Observations

STR No. Def	STR Peak	STR Mean	STR Total	STR Grade	SER No. Def	SER Peak	SER Mean	SER Total	SER Grade
0	0.0	0.0	0.0	1.0	0	0.0	0.0	0.0	1.0

Dappers Lane

348



Section Pictures - 20/07/2021 - RE10X

Item No.	Inspection Direction	PLR	Client's Job Ref	Contractor's Job Ref
162	Upstream	RE10X		



1, 00:00:01, 0.00 m
Water level, 0% of the vertical dimension




2, 00:00:19, 1.60 m
Water level, 10% of the vertical dimension



3, 00:00:24, 1.90 m
Junction at 1 o'clock, 100mm dia



4, 00:00:38, 6.80 m
Junction at 3 o'clock, 100mm dia

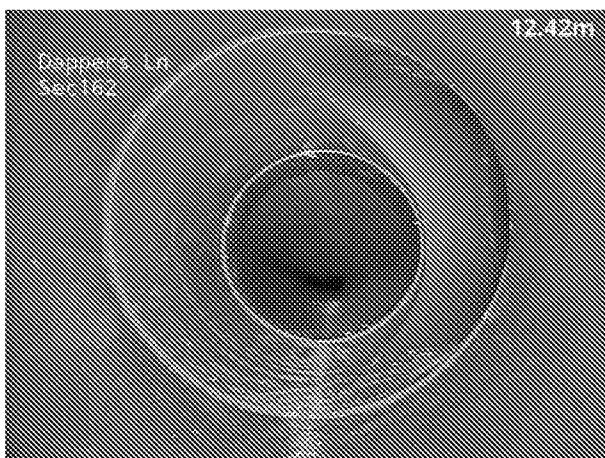

5, 00:00:51, 12.60 m
Junction at 3 o'clock, 100mm dia



6, 00:01:01, 17.00 m
Junction at 3 o'clock, 10mm dia



Section Pictures - 20/07/2021 - RE10X

Item No.	Inspection Direction	PLR	Client's Job Ref	Contractor's Job Ref
162	Upstream	RE10X		



7, 00:01:08, 17.20 m
Line deviates up



8, 00:01:12, 17.90 m
Finish node, rodding eye, reference: RE10

Disclaimer

Although every effort has been made to produce a thorough and precise report, Eyes On Drainage Services Ltd cannot be held liable for any discrepancies or omissions. Furthermore Eyes On Drainage Services Ltd cannot be held responsible for any actions taken based on the information supplied within this report.

Appendix C

As Built Drainage Design Drawings



1	2	3	100
REF ID: A12345 DATE: 10/26/2019 TIME: 10:00 USER: JDOE IP: 192.168.1.1 STATUS: SUCCESS GD GROUP CITYZEN MERRY LING AMGNERING DRAINAGE LAYOUT CS CS CS CS CS																																																																																																			