


ALL DIMENSIONS TO BE CONFIRMED ONSITE!!! IF IN DOUBT ASK!!!

Accommodation Schedule

Mix	Aparts.	Houses
1 bed	2	
2 bed	6	
2 bed		
3 bed		14
4 bed		8
	8	22

NB: 54no. parking spaces

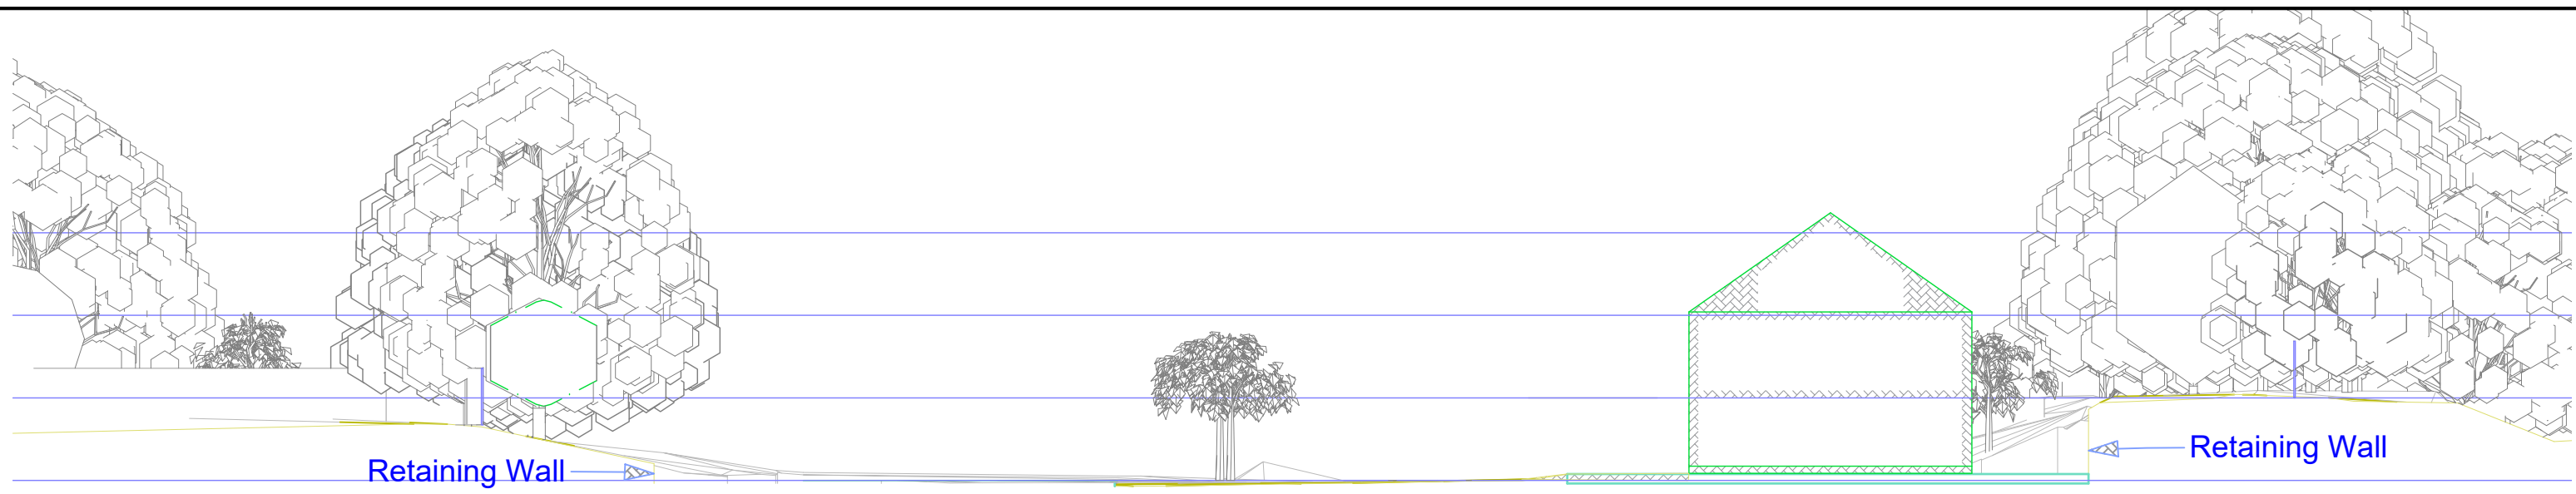

Cross Section S-01

NOTES

This drawing and all the information shown is the property of Southmill and shall not be copied whole, or in part, or used for any other purpose without written permission of the Company.

ALL SUBJECT TO STRUCTURAL ENGINEERS CHECKS AND CALCULATIONS.

ALL DIMENSIONS TO BE CHECKED ON SITE


IF ANY VARIATIONS ARE MADE TO SPECIFICATION/DRAWINGS WITHOUT SOUTHMILL KNOWLEDGE, SOUTHMILL WILL NOT BE HELD ACCOUNTABLE FOR NON COMPLIANCE OF PLANNING AND BUILDING REGULATIONS

Schedule Of Accommodation

	X 2No
TYPE A 1019 sq ft - 3 Bedroom Terrace	
	X 8No
TYPE B 1462 sq ft - 4 Bedroom Detached House	
	12No X (2No Affordable)
TYPE C 1252 sq ft - 3 Bedroom Semi Detached House/Terrace	
	X 6No 2 Bed 2No 1 bed
APARTMENTS Plot 23 645 sq ft - 1 bed apartment Plot 24 660 sq ft - 1 bed apartment Plot 25 665 sq ft - 2 bed apartment Plot 26 656 sq ft - 2 bed apartment Plot 27 666 sq ft - 2 bed apartment Plot 28 656 sq ft - 2 bed apartment Plot 29 666 sq ft - 2 bed apartment Plot 30 850 sq ft - 2 bed apartment	

Z	04.02.21	As Built issue
Y	17.12.20	Added note advising trees to be removed
X	09.03.20	2no. Bins added to apartments
W	02.03.20	General amendments made
V	20.02.20	Plots 7 garden extended
U	14.02.20	Plots 1, 6, 8, 19 & 22 planting changed to bark
T	12.02.20	Landscape amended to match updated landscape layout
S	16.04.19	Added path to site front to meet part M
R	07.02.19	Updated external floor finishes
Q	07.11.18	Updated plan to new layout
P	17.10.18	Added path to front plots to comply with 278 works
O	25.09.18	Planning Issue
N	06.09.18	Plan amended after planning mtg
M	29.08.18	Plan amended planners comments
L	10-08.18	Floor areas updated
K	26.07.18	Boundary updated
J	06.07.18	Plot 5 updated
H	22.05.18	Rear paths added to plots 2 & 3

Rev.	Date.	Remarks						
 Southmill Ltd Northern Office Ground Floor, Building 3, Olympic Park, Warrington, WA2 0YL T - 01925 851604  Project. Angmering Title. Proposed site Layout As Built <table><tr><td>Scales. 1:200@A1</td><td>Date. May 2018</td></tr><tr><td>Drawing Number. 1006-Ang101</td><td>Revision. Z</td><td>Drawn by. PM</td><td>Checked by. DC</td></tr></table>			Scales. 1:200@A1	Date. May 2018	Drawing Number. 1006-Ang101	Revision. Z	Drawn by. PM	Checked by. DC
Scales. 1:200@A1	Date. May 2018							
Drawing Number. 1006-Ang101	Revision. Z	Drawn by. PM	Checked by. DC					

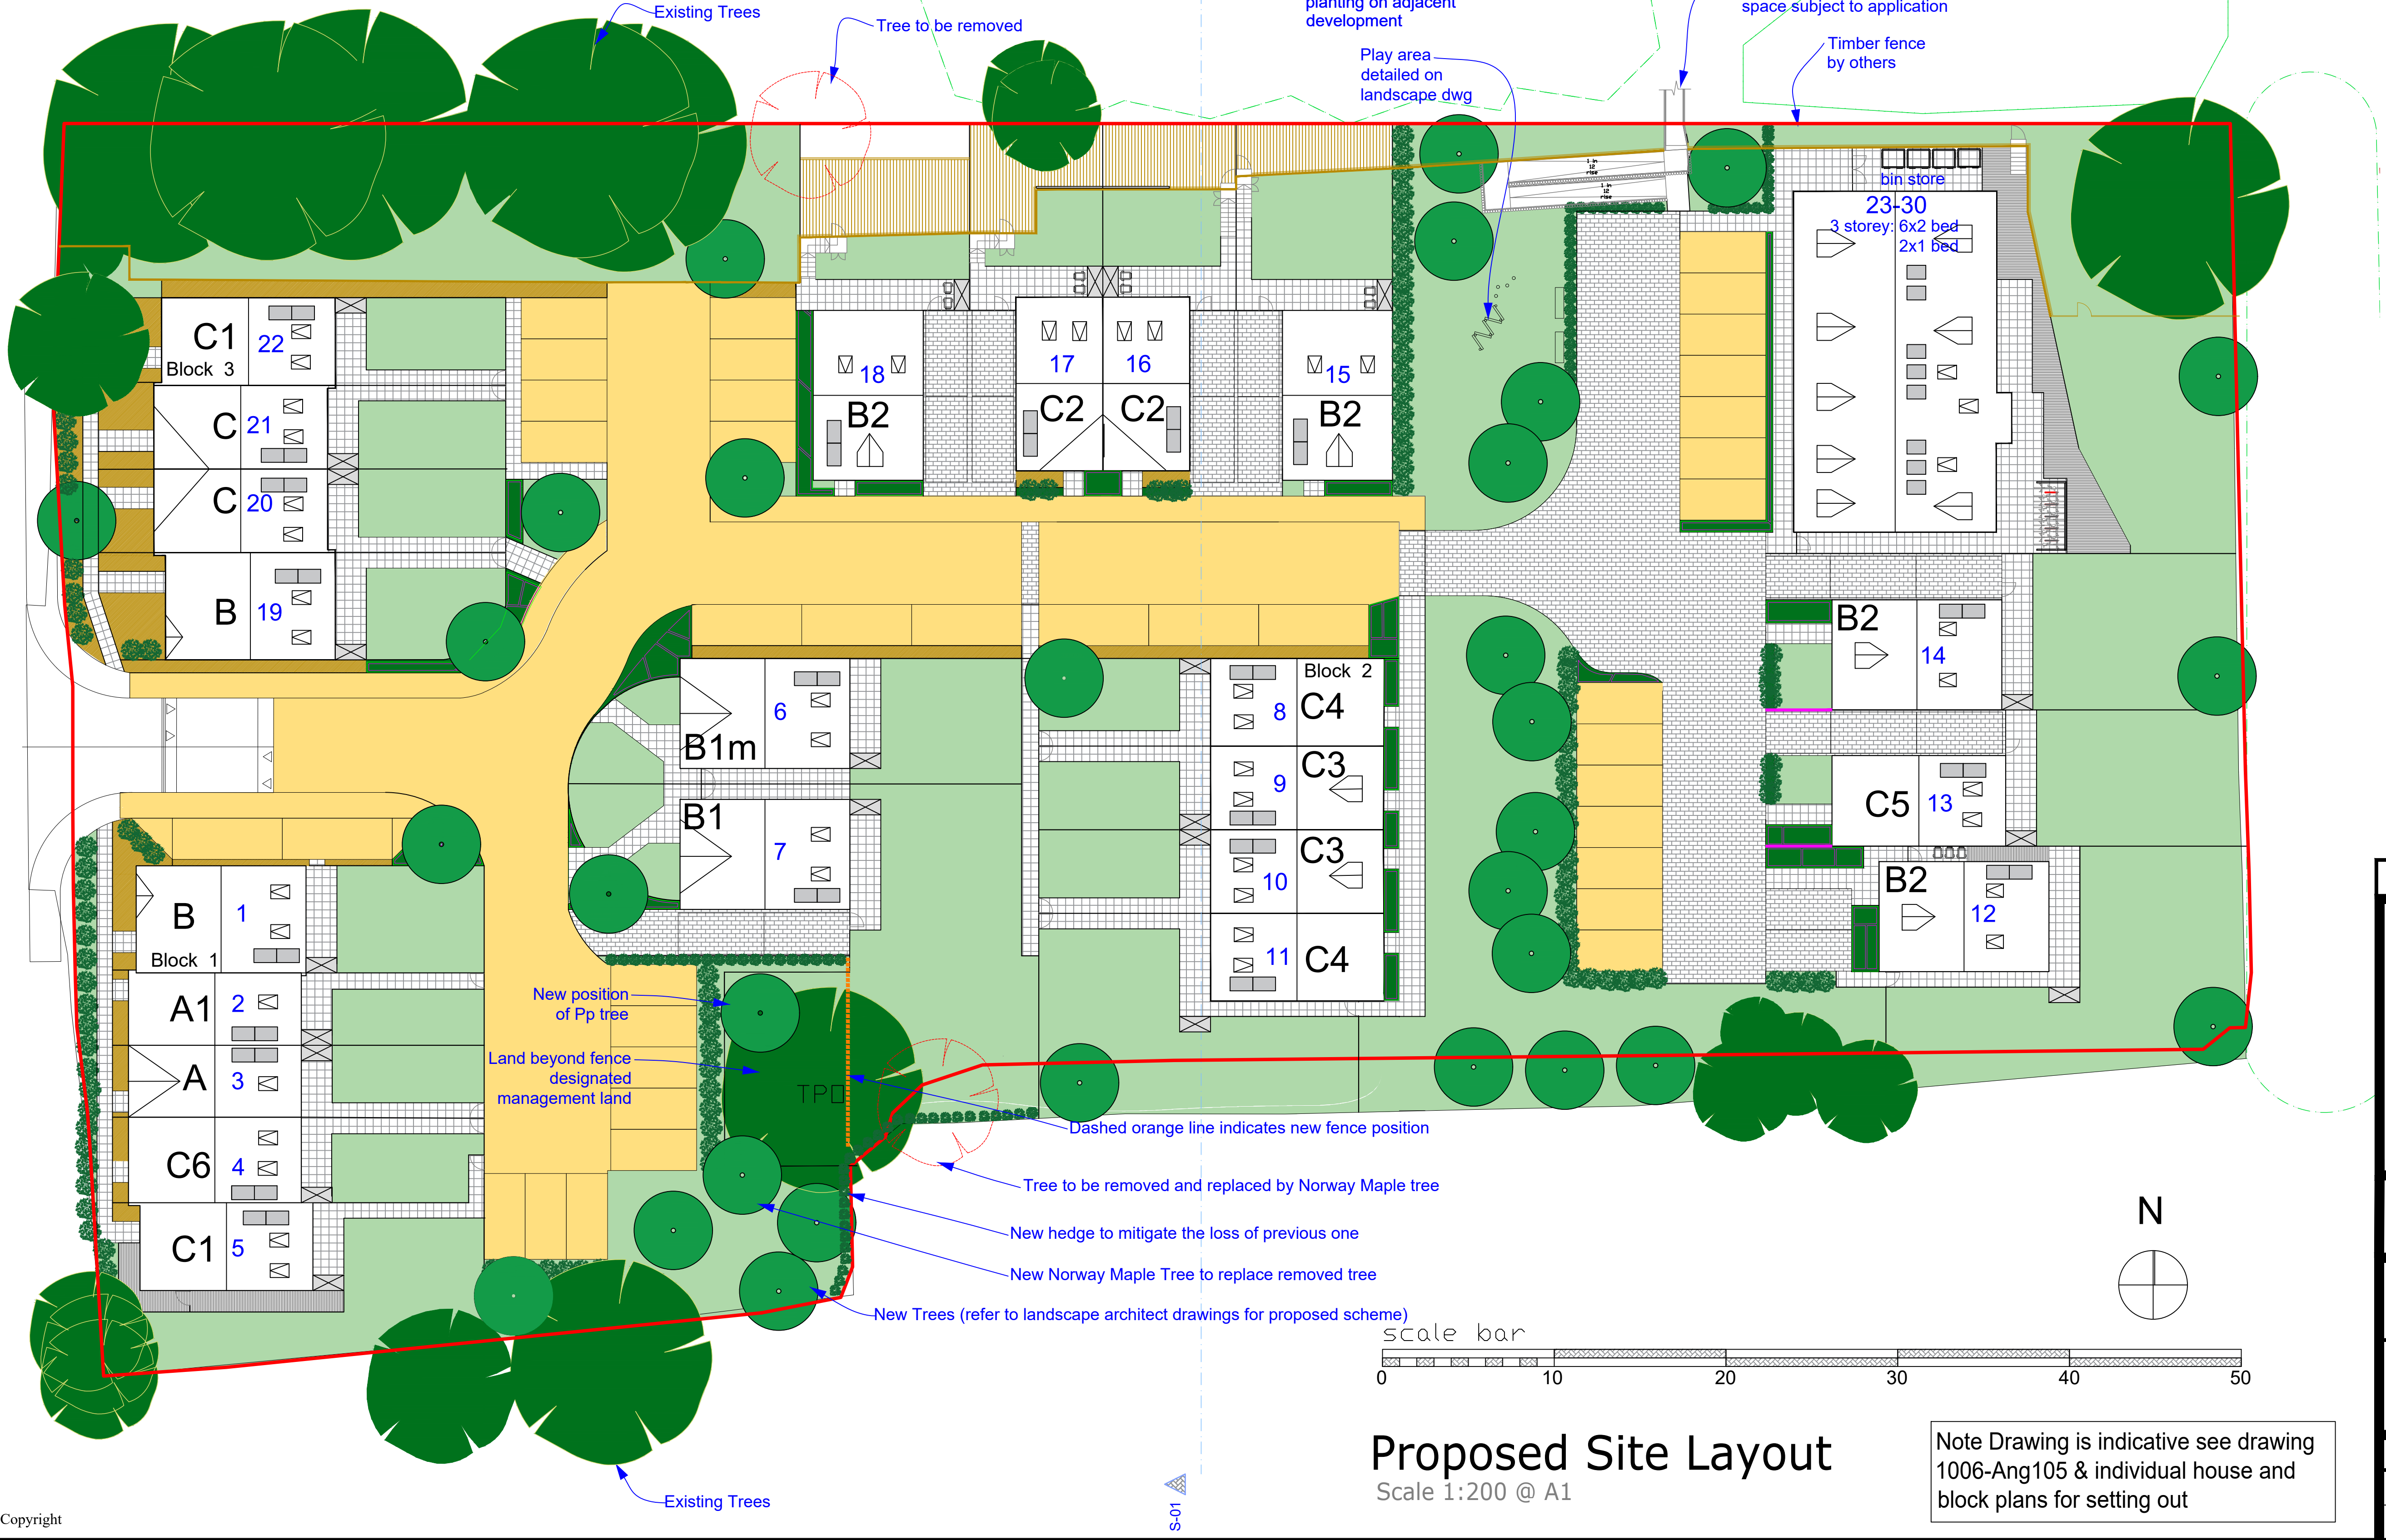

Proposed Site Layout
Scale 1:200 @ A1

Note Drawing is indicative see drawing 1006-Ang105 & individual house and block plans for setting out