




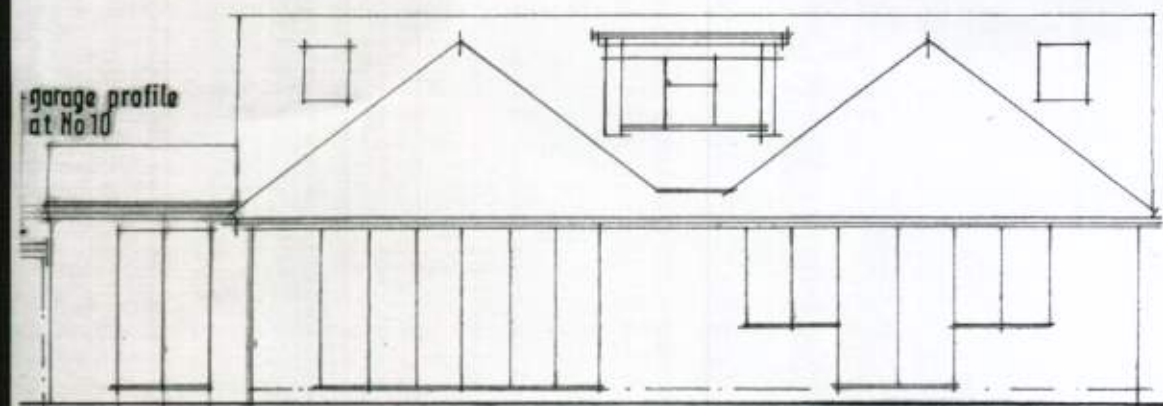


SOUTH [rear] 1/100

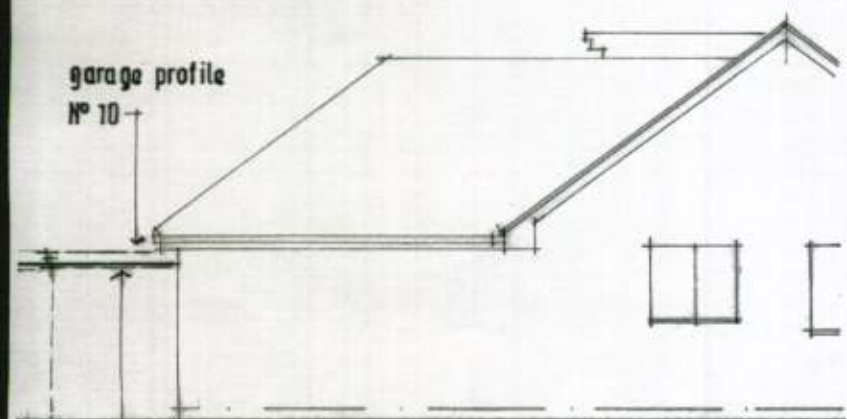


EAST 1/100

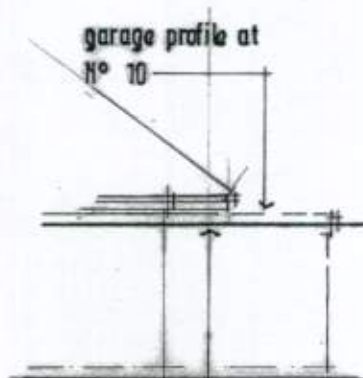


WEST 1/100

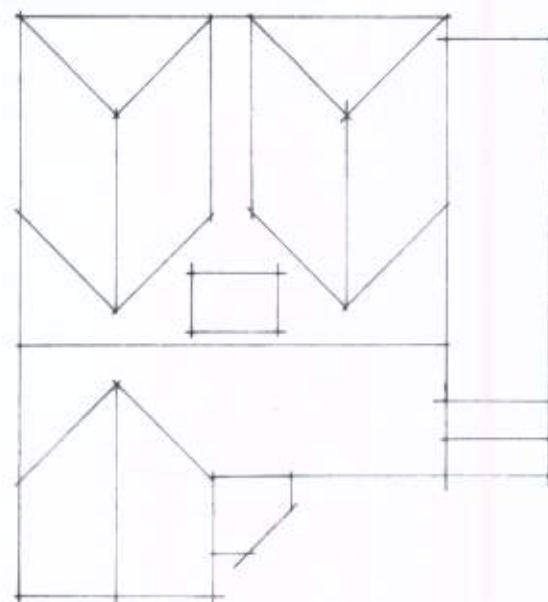

ROOF PLAN 1/200

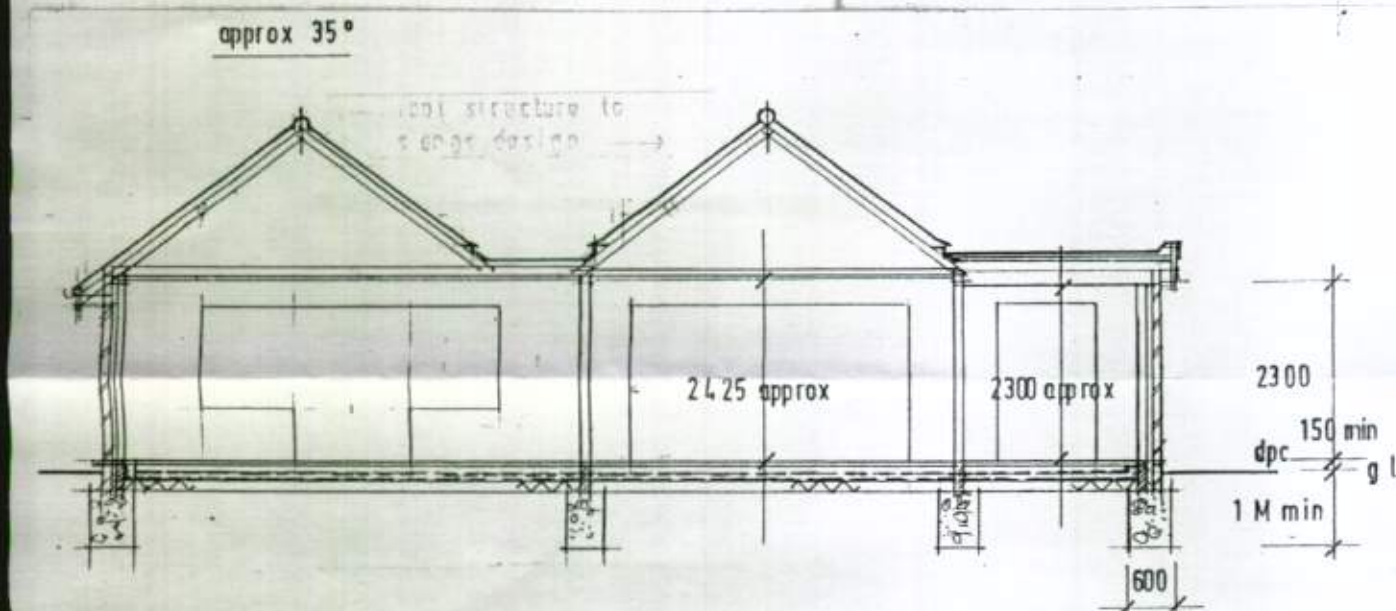

SECTION A: A

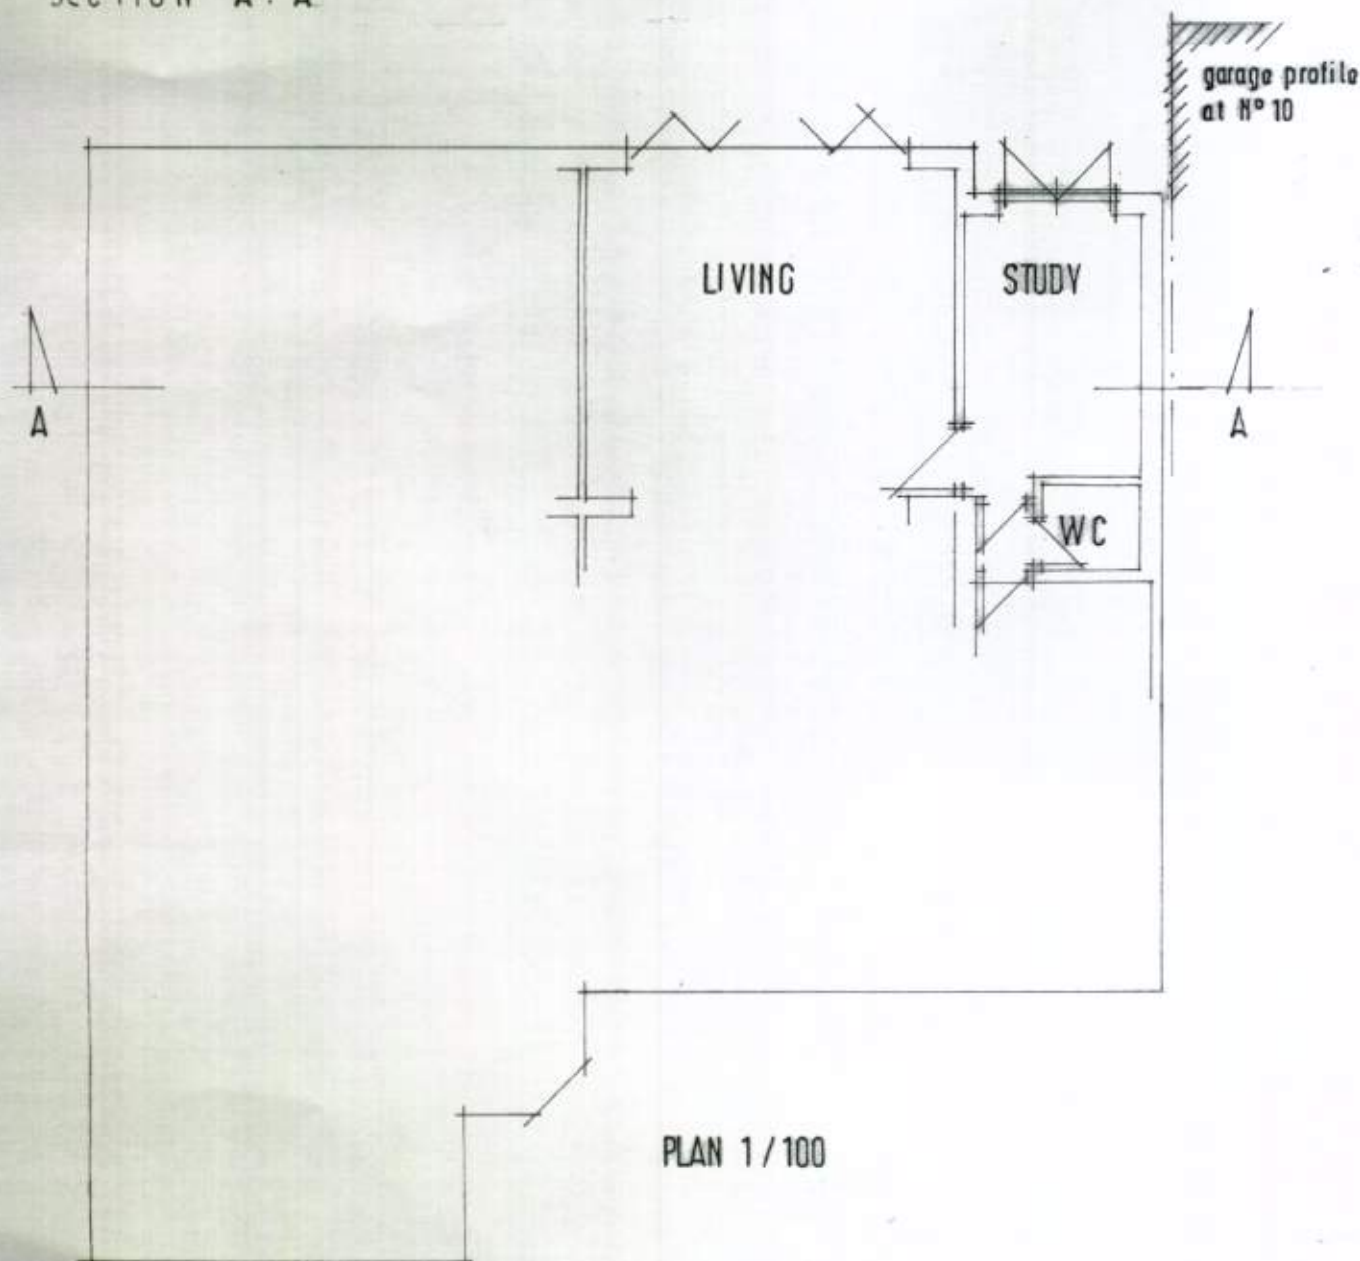

PLAN 1/100

TREVOR E. UNSTED LTD

R.B.S. HOUSE • 61 SEA LANE • RUSTINGTON • WEST SUSSEX • BN16 2RQ

Tel: 01903 859090

Client: MR & MRS D GRIFFITHS

Project: PORCH. EXTENSION 12 MILL ROAD
ANGMERING
W/SUSSEX BN16 4HT

Drawing: **EXISTING** (RETROSPECTIVE)

Scale: 1:100

Drawing No:

Date: MARCH 2011

11/3823/2

Drawn: TU

Revisions:

Copyright

The contractor must check all dimensions and levels on site ~~and use~~
~~dimensions are to be scaled from drawings~~

It is the contractor's responsibility to ensure compliance with all statutory authority requirements, carry out works with total regard to existing and retained structure. Works and materials to latest CP/BS.

Drawing to be read in strict accordance with engineer's information where applicable.

All structural timber C16 unless otherwise noted. All structural and external timber pressure impregnated with preservative, cut ends site swabbed with Cuprinol or similar treatment.

Local authority to witness satisfactory test on all new and affected foul/storm drainage.

4/6/11