


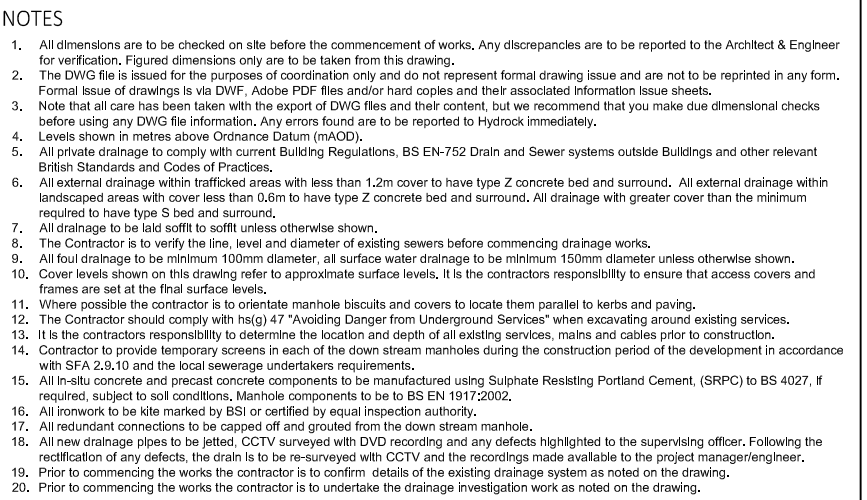

C05	AS BUILT ISSUE					
	J. SHIMMIN	27.07.21	D. GALLIMORE	27.07.21	J. MAGEE	27.07.21
C04	ISSUED FOR CONSTRUCTION					
	J. SHIMMIN	28.06.21	D. GALLIMORE	28.06.21	M. GRIFFIN	28.06.21
C03	ISSUED FOR CONSTRUCTION					
	D. GALLIMORE	29/03/21	D. GALLIMORE	29/03/21	M. GRIFFIN	29/03/21
C02	ISSUED FOR CONSTRUCTION					
	D. GALLIMORE	03/02/21	D. GALLIMORE	24/07/20	M. GRIFFIN	24/07/20
C01	ISSUED FOR CONSTRUCTION					
	D. GALLIMORE	24/07/20	D. GALLIMORE	24/07/20	M. GRIFFIN	24/07/20
P02	ISSUED FOR CONTRACT					
	R. HUNT	13/03/20	D. GALLIMORE	13/03/20	M. GRIFFIN	13/03/20
P01	TENDER ISSUE					
	D. GALLIMORE	13/12/19	D. GALLIMORE	13/12/19	M. GRIFFIN	13/12/19

Hydrock

 Merchants' House North
Wapping Road
Bristol
BS1 4RW
t: +44 (0)117 945 9225
e: bristolcentral@hydrock.com

CLIENT _____

LANDLINK ESTATES

PROJECT

SALTBOX

BOGNOR REGIS

TITLE
UNIT 2 DRAINAGE LAYOUT SHEET 2

HYDROCK PROJECT NO. C-13319-C	SCALE @ A1 1:250
----------------------------------	---------------------

STATUS DESCRIPTION	STATUS
AS BUILT ISSUE	A

DRAWING NO. (PROJECT CODE-ORIGINATOR-ZONE-LEVEL-TYPE-ROLE-NUMBER)	REVISION
SAL-HYD-PH1-ZZ-DR-C-7011	C05