






Proposed Front Elevation at 1:100 scale
NORTH WEST

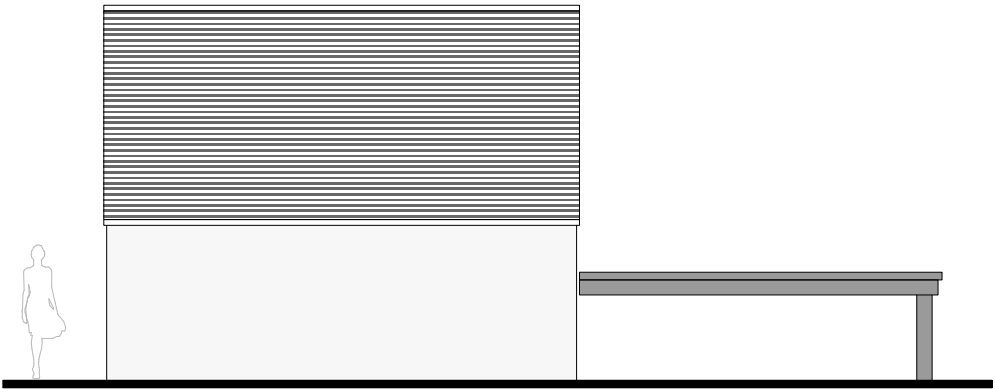


Proposed Rear Elevation at 1:100 scale
SOUTH EAST

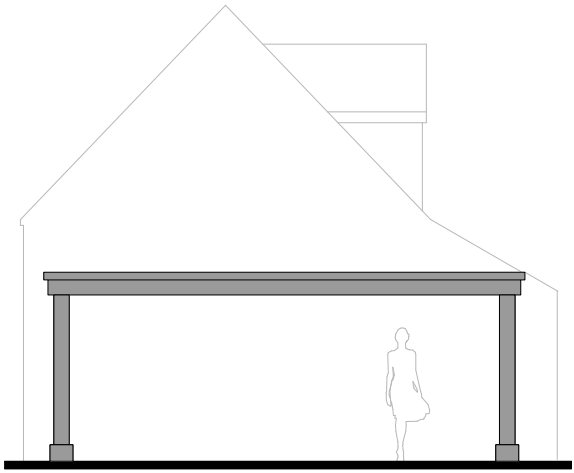


Proposed Side Elevation at 1:100 scale
NORTH EAST

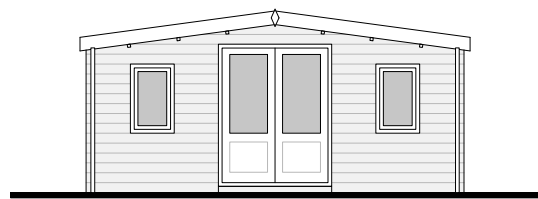


Proposed Front Elevation at 1:100 scale
SOUTH WEST

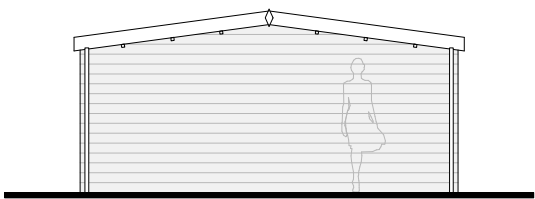


Proposed Rear Elevation at 1:100 scale
NORTH EAST

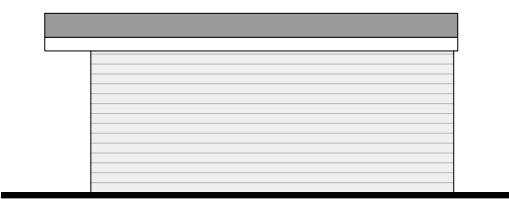

Proposed Side Elevation at 1:100 scale
SOUTH EAST

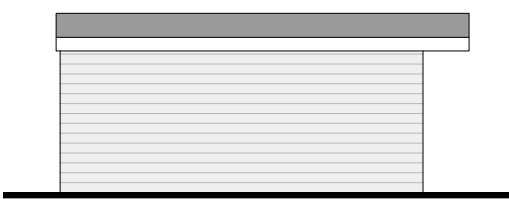


Proposed Side Elevation at 1:100 scale
NORTH WEST

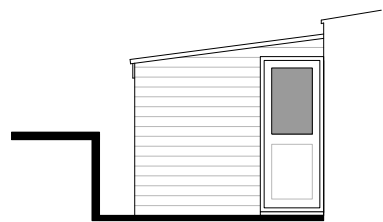


Proposed Front Elevation at 1:100 scale
SOUTH WEST



Proposed Rear Elevation at 1:100 scale
NORTH EAST

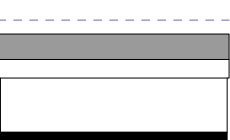

Proposed Side Elevation at 1:100 scale
SOUTH EAST

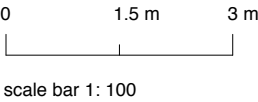

Drawings & Scale Bar are for
Planning Purposes Only.
These are not Survey Drawings

0. DRAWINGS ARE INDICATIVE AND STRICTLY FOR PLANNING PURPOSES ONLY.
1. DRAWINGS ARE NOT TO BE SCALED EXCEPT FOR PLANNING PURPOSES.
2. ROOM DIMENSIONS WHERE SHOWN ARE APPROXIMATE.
3. ALL DIMENSIONS TO BE CONTRACTOR-CHECKED ON SITE BEFORE USE.
4. PROPOSED DRAWINGS ARE SUBJECT TO LOCAL AUTHORITY PLANNING / LBC & BUILDING REGULATIONS APPROVAL.
5. ALL DIMENSIONS MUST BE CHECKED AND CONFIRMED BY CONTRACTOR PRIOR TO ANY CONSTRUCTION WORKS TAKING PLACE.
6. THESE ARE NOT SURVEY DRAWINGS. SCALE BAR FOR PLANING PURPOSES ONLY.
7. DRAWINGS REMAIN COPYRIGHT OF CORINTHIAN ARCHITECTURAL DESIGN AND CANNOT BE REPRODUCED OR USED IN ANY MANNER WITHOUT PRIOR WRITTEN CONSENT.

CLIENT	Mrs L Parker	DRAWING	002 As-Built Elevations		
SITE	84 North Bersted Street, Bognor Regis	DATE	04 12 18	AUTHOR	AH
PROJECT	Extensions & Alterations	SCALE	1: 100 @ A3	STATUS	PL

CORINTHIAN ARCHITECTURAL DESIGN

Main Road, Fishbourne, West Sussex. PO18 8BD
01243 576 078 > contact@corinthianad.co.uk > www.corinthianad.co.uk