

PROJECT

Temporary Logistics
Building - Technology
and Logistics Centre

CLIENT

Rolls Royce Motor
Cars Limited

CONSULTANT

AECOM
Colmore Building
Colmore Circus Queensway
Birmingham
B4 6AT
www.aecom.com

NOTES

- THIS DRAWING IS NOT TO BE SCALED
- TOPOGRAPHICAL SURVEY FROM GREENHATCH REF 28170A_T DATED 22.05.2019

KEY

- FOUL WATER DRAINAGE PIPE
- SURFACE WATER DRAINAGE PIPE
- ATTENUATION TANK LOCATION FROM AS BUILT INFORMATION
- PROPOSED TEMPORARY BUILDING OPTIONS

ISSUE/REVISION

Z1	06/06/2019	FIRST ISSUE
I/R	DATE	DESCRIPTION

PROJECT NUMBER


60579154

SHEET TITLE

AS-BUILT DRAINAGE

SHEET NUMBER

60579154-SHT-00-0000-C-0003

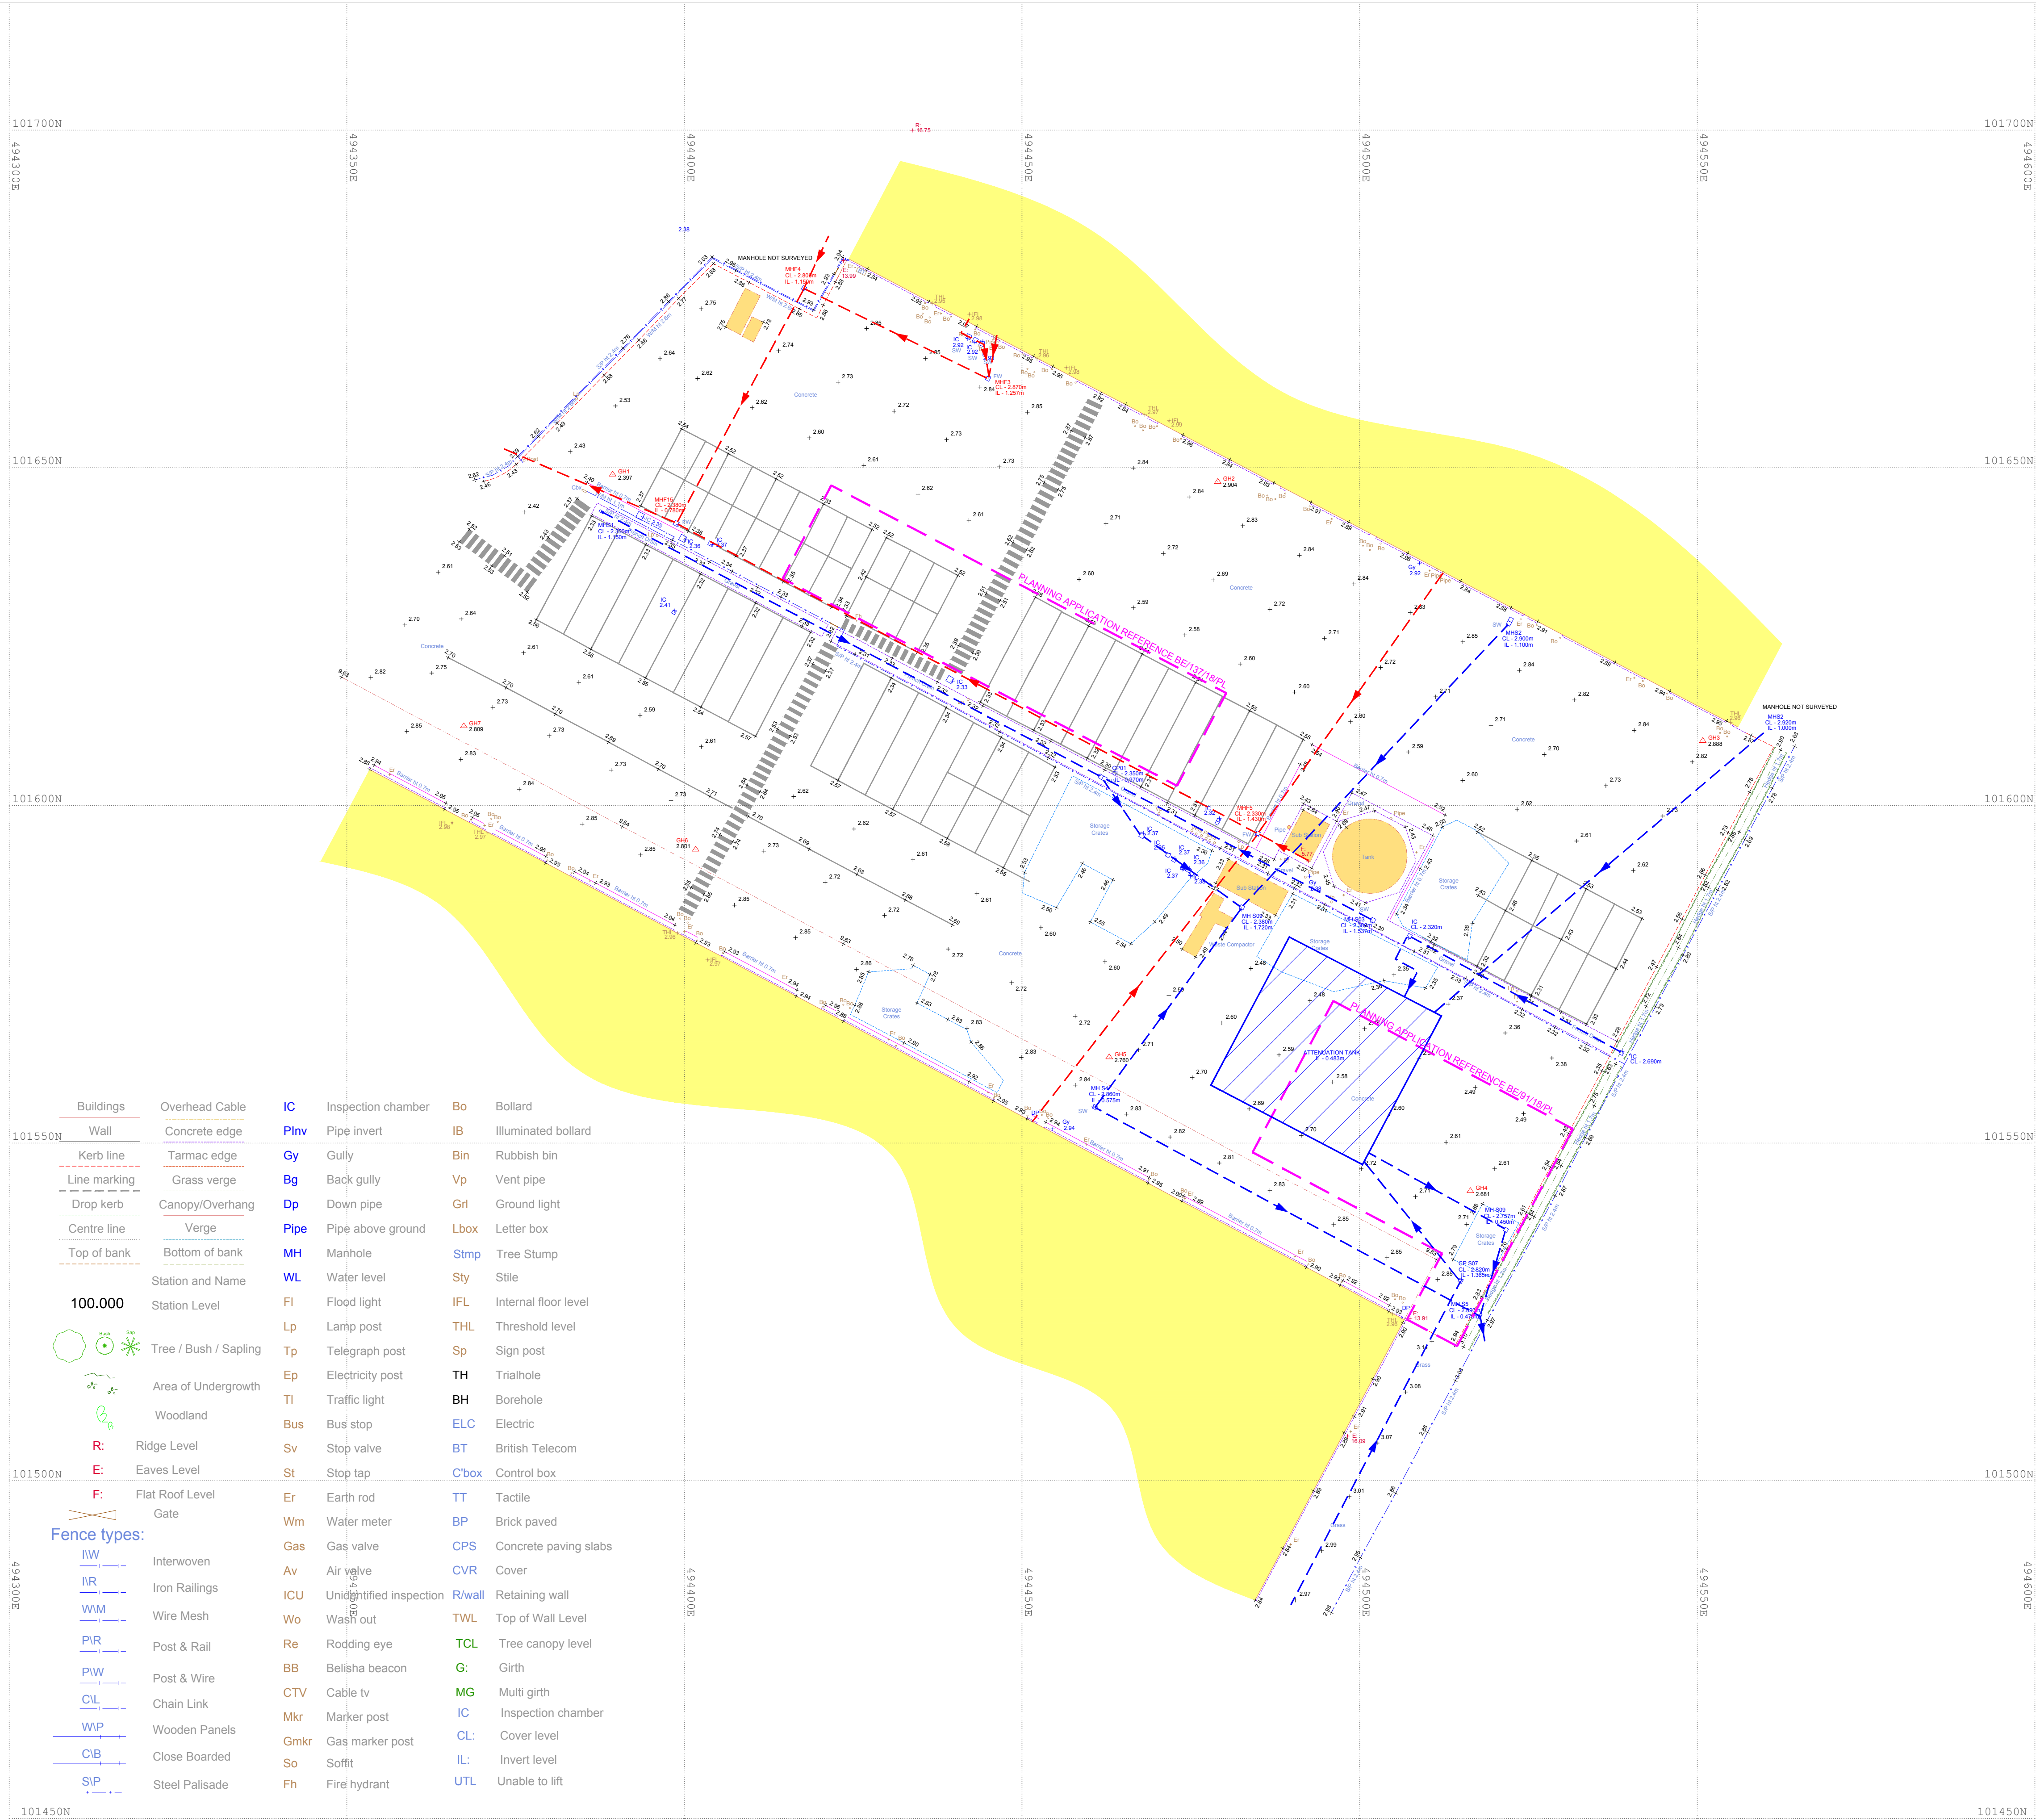

Buildings	Overhead Cable	IC	Inspection chamber	Bo	Bollard
Wall	Concrete edge	Plnv	Pipe invert	IB	Illuminated bollard
Kerb line	Tarmac edge	Gy	Gully	Bin	Rubbish bin
Line marking	Grass verge	Bg	Back gully	Vp	Vent pipe
Drop kerb	Canopy/Overhang	Dp	Down pipe	Grl	Ground light
Centre line	Verge	Pipe	Pipe above ground	Lbox	Letter box
Top of bank	Bottom of bank	MH	Manhole	Stmp	Tree Stump
	Station and Name	WL	Water level	Sty	Stile
100.000	Station Level	FI	Flood light	IFL	Internal floor level
		Lp	Lamp post	THL	Threshold level
	Tree / Bush / Sapling	Tp	Telegraph post	Sp	Sign post
	Area of Undergrowth	Ep	Electricity post	TH	Trialhole
	Woodland	TI	Traffic light	BH	Borehole
		Bus	Bus stop	ELC	Electric
R:	Ridge Level	Sv	Stop valve	BT	British Telecom
E:	Eaves Level	St	Stop tap	C'box	Control box
F:	Flat Roof Level	Er	Earth rod	TT	Tactile
	Gate	Wm	Water meter	BP	Brick paved
		Gas	Gas valve	CPS	Concrete paving slabs
		Av	Air valve	CVR	Cover
		ICU	Unidentified inspection	R'wall	Retaining wall
		Wo	Wash out	TWL	Top of Wall Level
		Re	Rodding eye	TCL	Tree canopy level
		BB	Belisha beacon	G:	Girth
		CTV	Cable tv	MG	Multi girth
		Mkr	Marker post	IC	Inspection chamber
		Gmkr	Gas marker post	CL:	Cover level
		So	Soffit	IL:	Invert level
		Fh	Fire hydrant	UTL	Unable to lift

Fence types:	
IW	Interwoven
IR	Iron Railings
WM	Wire Mesh
PR	Post & Rail
PW	Post & Wire
CL	Chain Link
WP	Wooden Panels
CB	Close Boarded
SP	Steel Palisade

PLAN

1:500