


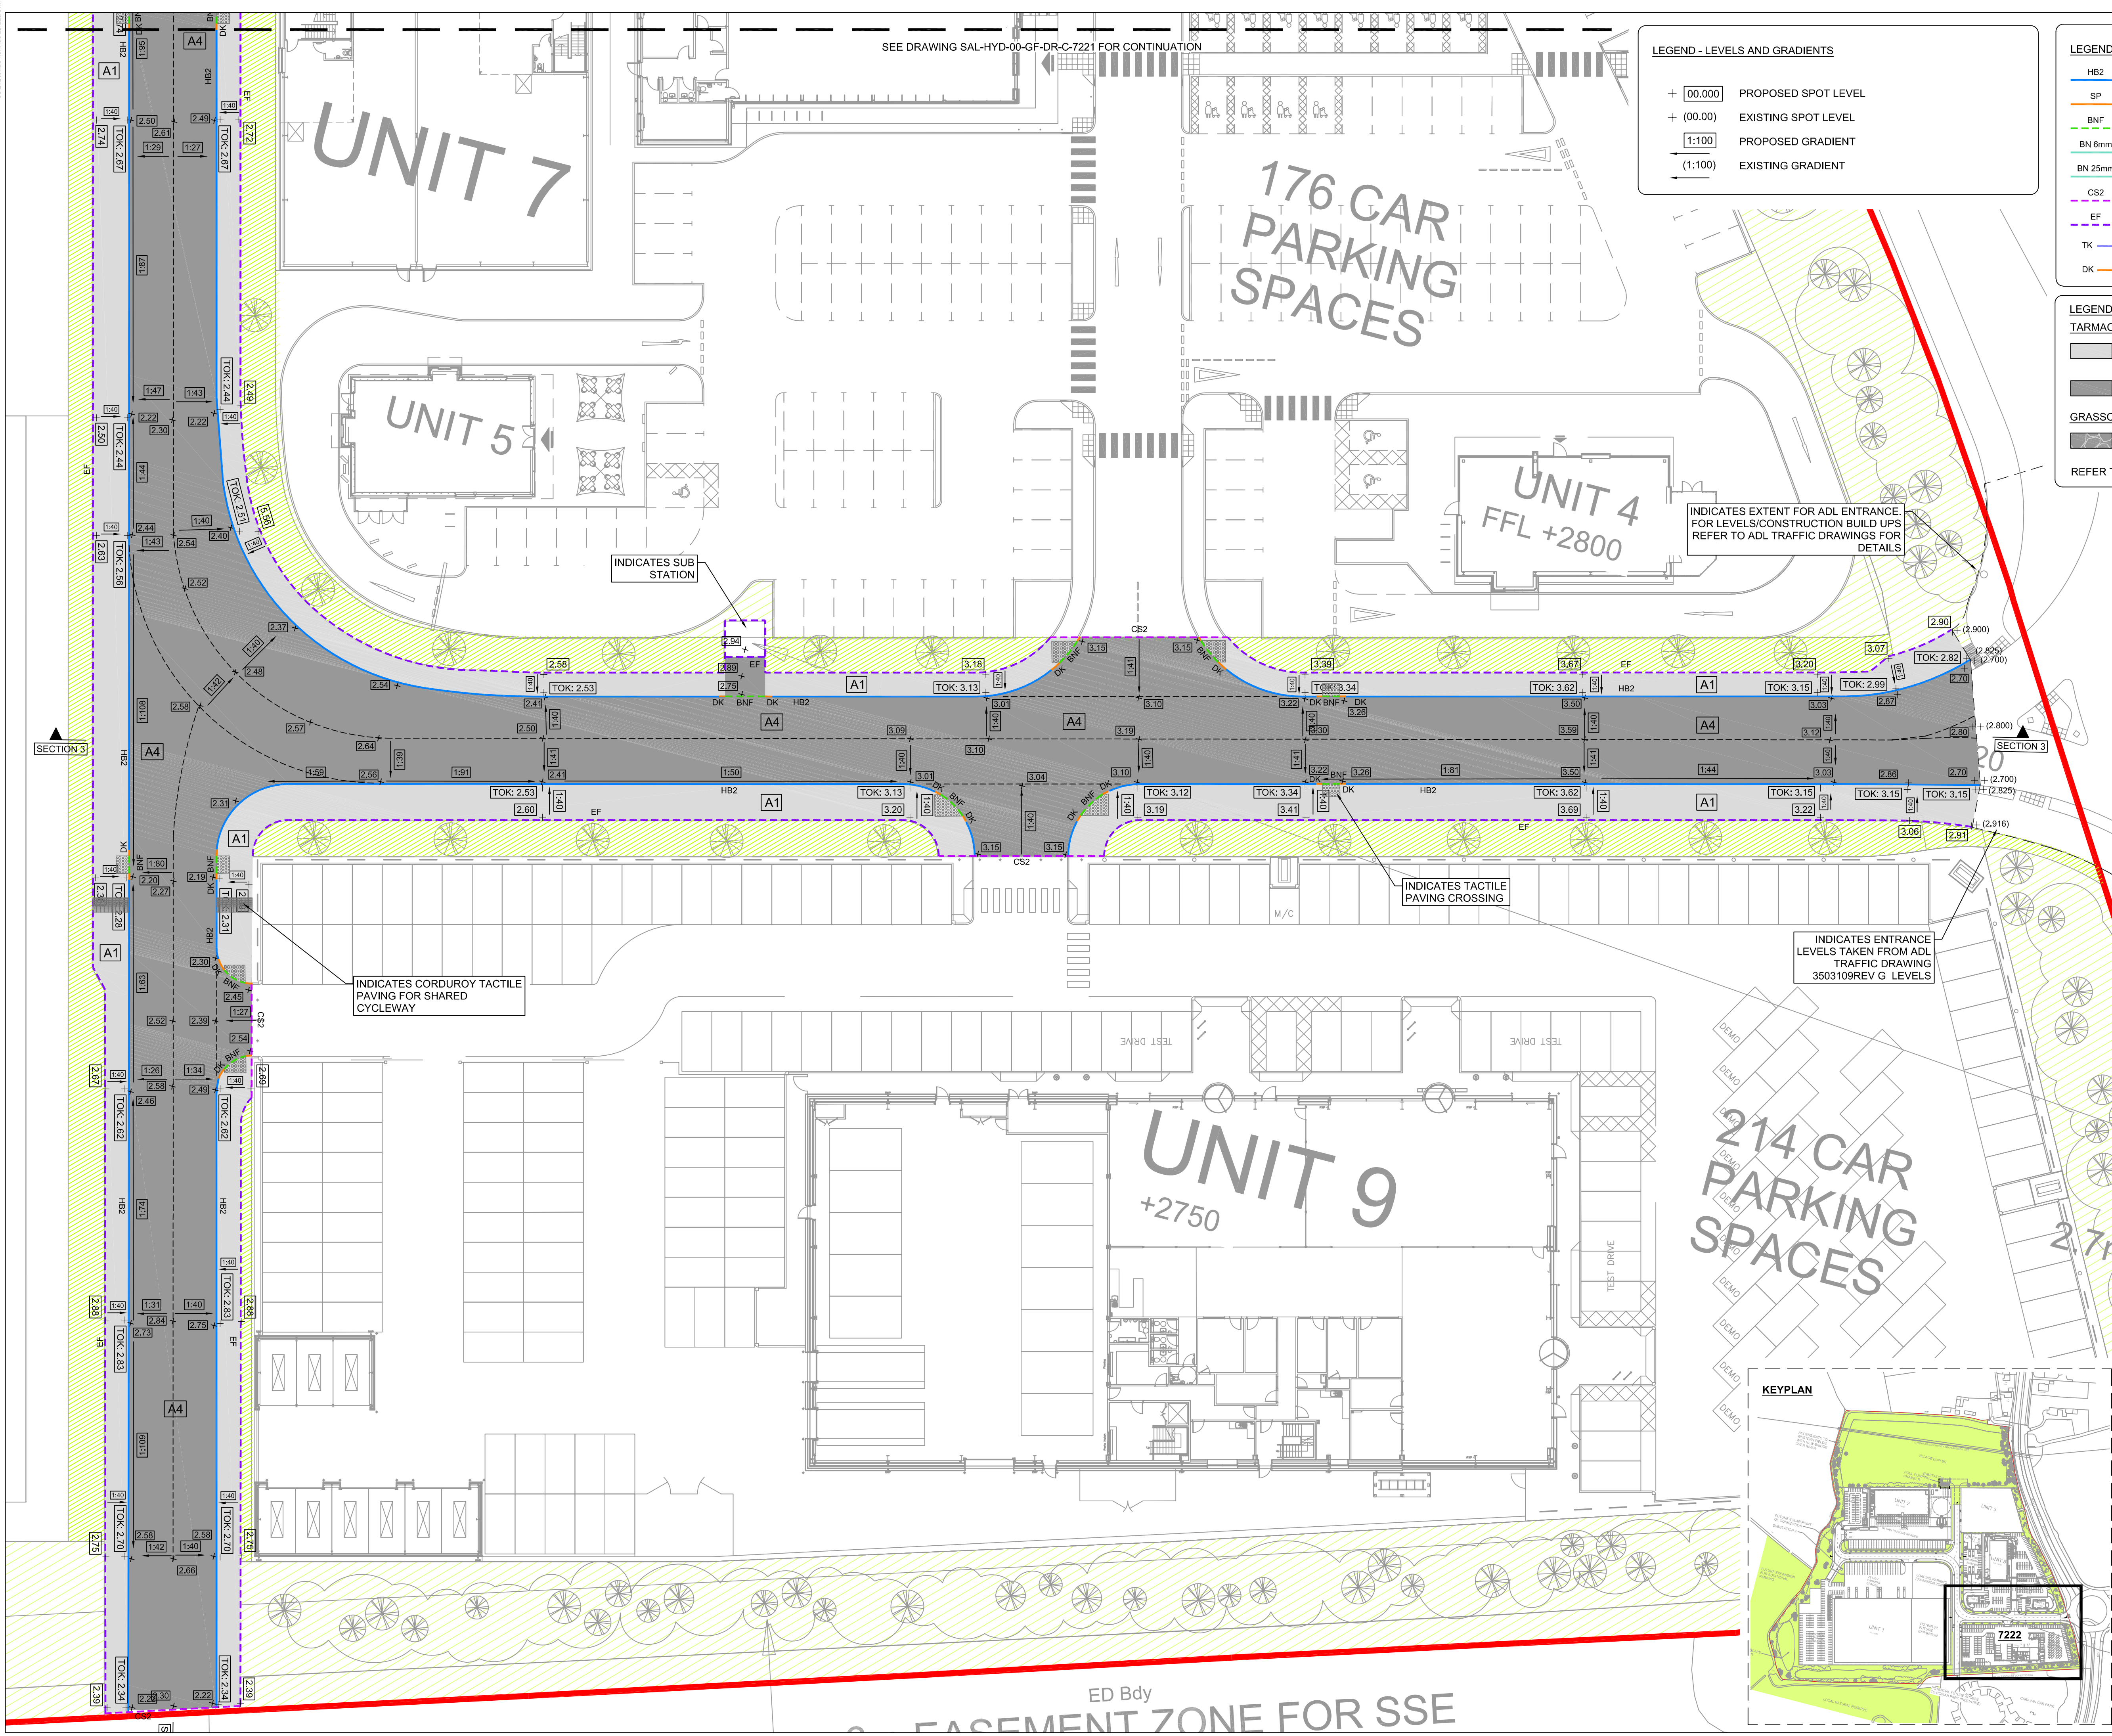

LEGEND - LEVELS AND GRADIENTS

- + [00.000] PROPOSED SPOT LEVEL
- + (00.00) EXISTING SPOT LEVEL
- [1:100] PROPOSED GRADIENT
- (1:100) EXISTING GRADIENT

LEGEND - KERB TYPES

- HB2 HALF BATTERED KERB (TYPE HB2: 125mm UPSTAND)
- SP SPLAY KERB (TYPE SP: 125mm UPSTAND)
- BNF BULLNOSED KERB (TYPE BN: LAID FLUSH)
- BN 6mm BULLNOSED KERB (TYPE BN: 6mm UPSTAND)
- BN 25mm BULLNOSED KERB (TYPE BN: 25mm UPSTAND)
- CS2 CHANNEL SQUARE KERB (TYPE CS2: LAID FLUSH)
- EF FLAT TOP EDGING KERB (TYPE EF: LAID FLUSH)
- TK TRANSITION KERB (TYPE TK: UPSTAND KERB TO DROPPED KERB)
- DK DROPPER KERB (TYPE DK: UPSTAND KERB TO DROPPED KERB)

LEGEND - SURFACE TYPES

TARMAAC:

- TYPE A1:** ASPHALT PAVING CONSTRUCTION - PEDESTRIAN LOADING ONLY
- TYPE A4:** ASPHALT PAVING CONSTRUCTION - FREQUENT HGV AND COMMERCIAL VEHICLES

GRASSCRETE:

- TYPE G1:** GRASSCRETE CONSTRUCTION - CARS, LIGHT VEHICLES AND OCCASIONAL HGV'S

REFER TO DRAWING SAL-HYD-PH1-ZZ-C-DR-7300 FOR DETAILS

- NOTES**
- All dimensions are to be checked on site before the commencement of works. Any discrepancies are to be reported to the Architect & Engineer for verification. Figured dimensions only are to be taken from this drawing.
 - The DWG file is issued for the purposes of coordination only and does not represent formal drawing issue and are not to be reprinted in any form. Formal issue of drawings is via DWG, Adobe PDF files and/or hard copies and their associated information issue sheets.
 - Note that all care has been taken with the export of DWG files and their content, but we recommend that you make due dimensional checks before using any DWG file information. Any errors found are to be reported to Hydrock immediately.
 - All levels are shown in metres above Ordnance Datum (m AOD).
 - In the event of any contradiction between this drawing and the specification, then the contractor shall seek clarification from the engineer before proceeding.
 - Refer to landscape architects drawings for extent of external surfaces and kinking.
 - The works on site affect statutory undertakers apparatus, where the contractor is required to verify the location and depth of all such apparatus prior to commencement of work and to take any precautions necessary when working in the vicinity of apparatus.

C08	AS BUILT ISSUE				
	D.DAVIS	22.07.21	D.GALLIMORE	22.07.21	D.GALLIMORE
C07	CONSTRUCTION ISSUE				
	J.SHIMMIN	28/06/21	D.GALLIMORE	28/06/21	M. GRIFFIN
C06	HEALTH AND SAFETY FILE ISSUE				
	J.SHIMMIN	11/06/21	D.GALLIMORE	11/06/21	M. GRIFFIN
C05	LEVELS AMENDED - PEDESTRIAN TACTILE PAVING POINTS ADDED (AS CLOUDED)				
	D. GALLIMORE	16/12/20	D.GALLIMORE	16/12/20	M. GRIFFIN
C04	DROP KERB CROSSINGS AND TACTILE PAVING ADDED				
	D. GALLIMORE	13/10/20	D.GALLIMORE	13/10/20	M. GRIFFIN
C03	REVISED TO SUIT ADL ENTRANCE LEVELS/LAYOUT				
	D. GALLIMORE	20/08/20	D.GALLIMORE	20/08/20	M. GRIFFIN
C02	LEVELS AMENDED AND CAMBER LEVELS ADDED				
	D. GALLIMORE	10/08/20	D.GALLIMORE	10/08/20	M. GRIFFIN
C01	ISSUED FOR CONSTRUCTION				
	D. GALLIMORE	24/07/20	D.GALLIMORE	24/07/20	M. GRIFFIN
P03	ISSUED FOR CONTRACT				
	R.HUNT	13/03/20	D.GALLIMORE	13/03/20	M. GRIFFIN
P02	REVISED AS CLOUDED				
	D. GALLIMORE	13/12/19	J. MAGEE	13/12/19	M. GRIFFIN
REV	REVISION NOTES/COMMENTS				
	DRAWN BY	DATE	CHECKED BY	DATE	APPROVED BY

Hydrock

Merchants' House North
Wapping Road
Bristol
BS1 4RW
t: +44 (0)117 945 9225
e: bristolcentral@hydrock.com

CLIENT		LANDLINK ESTATES	
PROJECT			
SALTBOX BOGNOR REGIS			
TITLE			
ACCESS ROAD EXTERNAL WORKS SHEET 3			
HYDROCK PROJECT NO. C-13319-C		SCALE @ A1 1:250	
STATUS DESCRIPTION AS BUILT ISSUE		STATUS A1	
DRAWING NO. (PROJECT CODE-ORIGINATOR-ZONE-LEVEL-TYPE-ROLE-NUMBER) SAL-HYD-PH1-ZZ-DR-C-7222		REVISION C08	

