

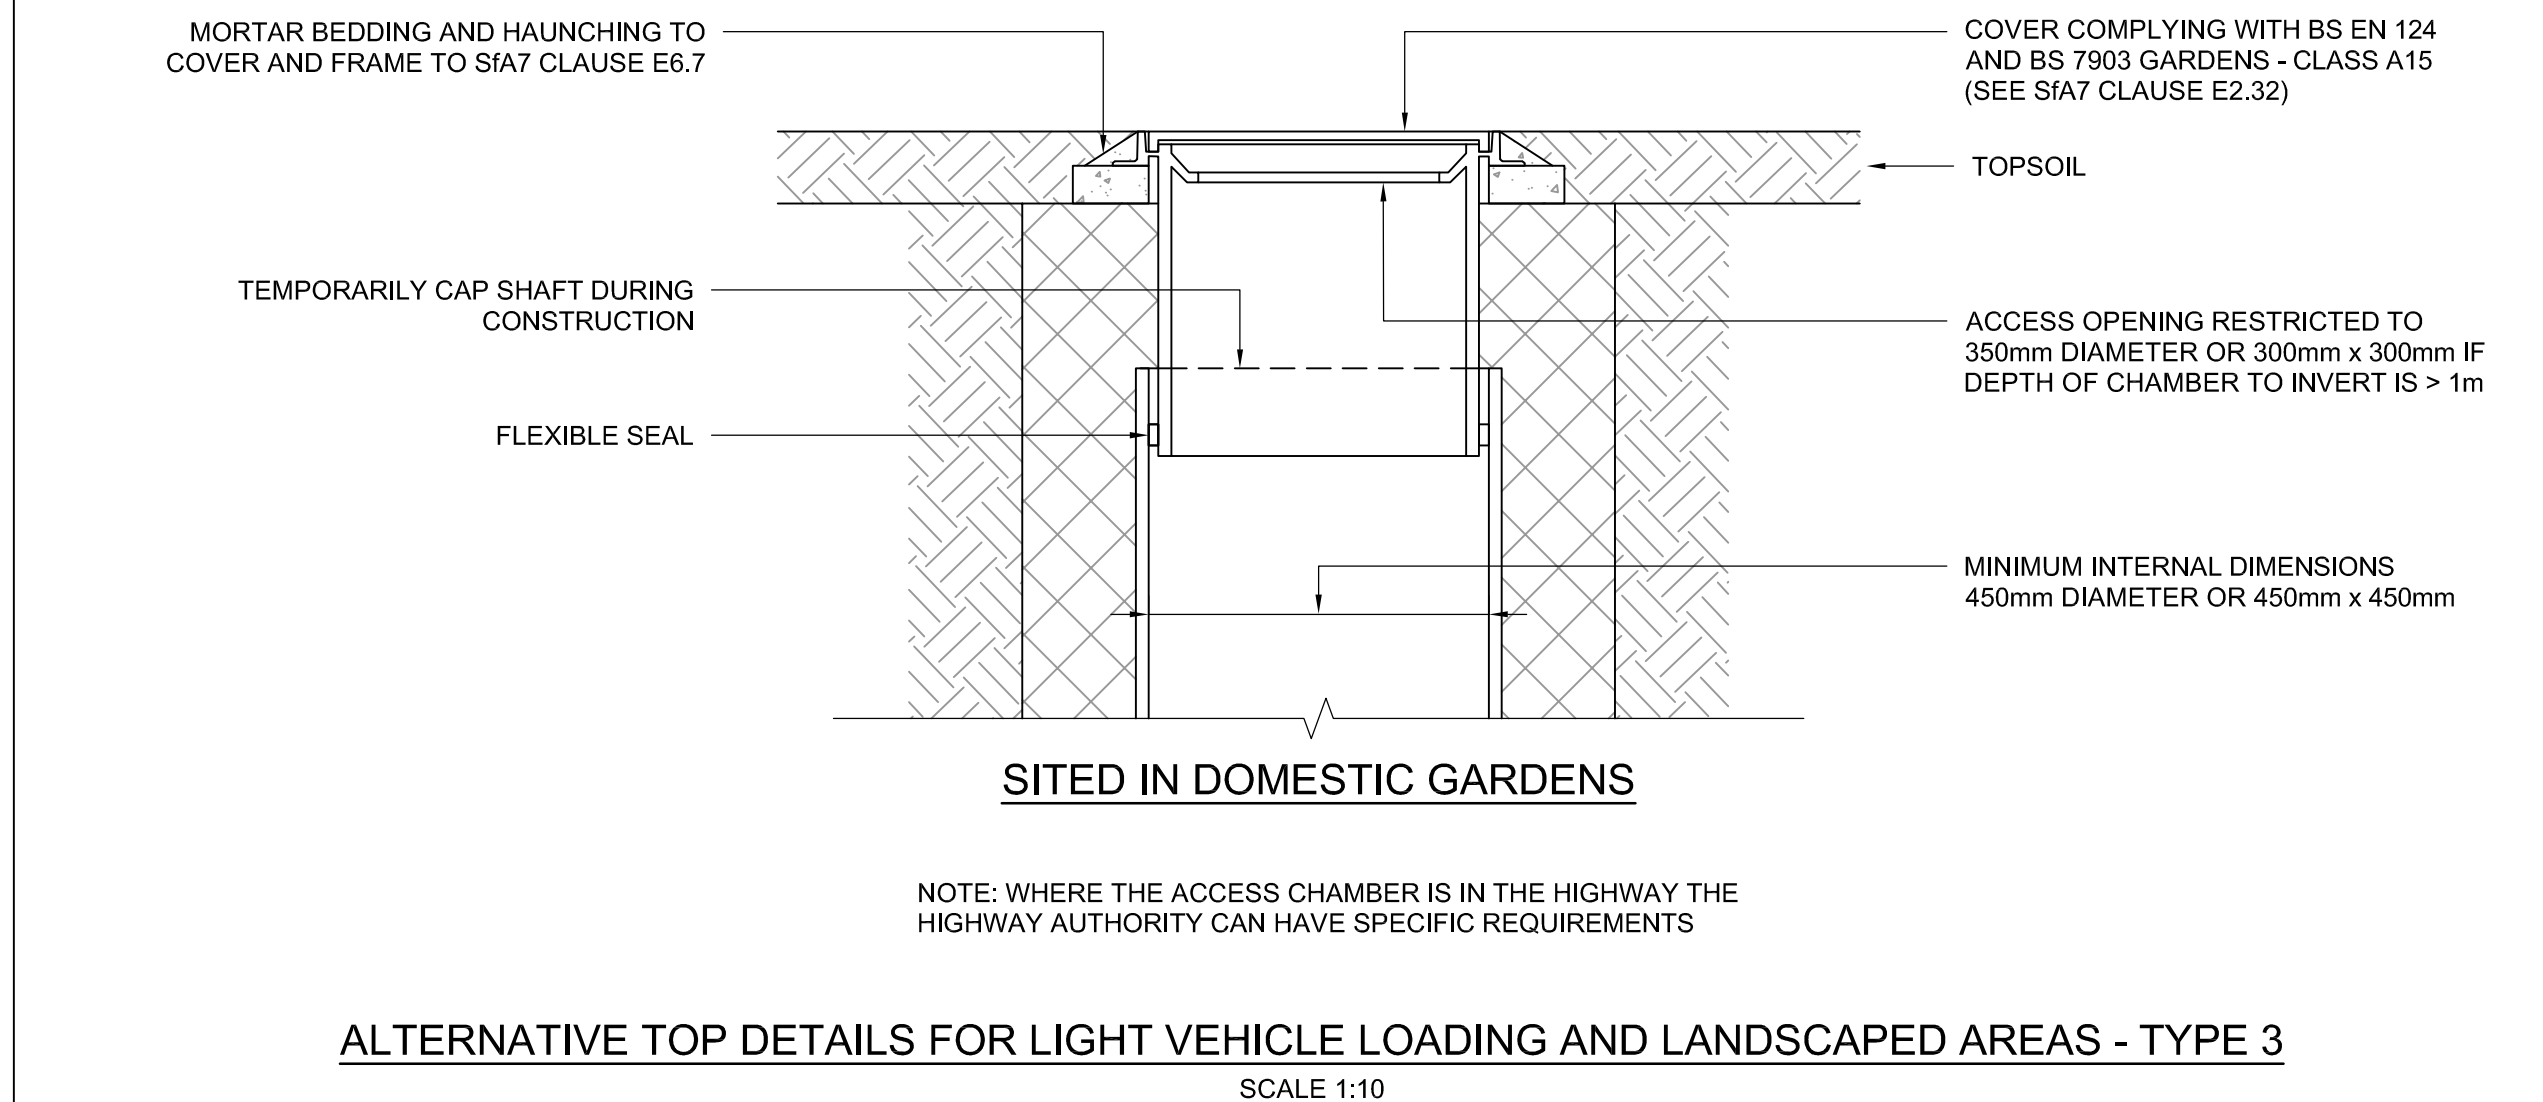
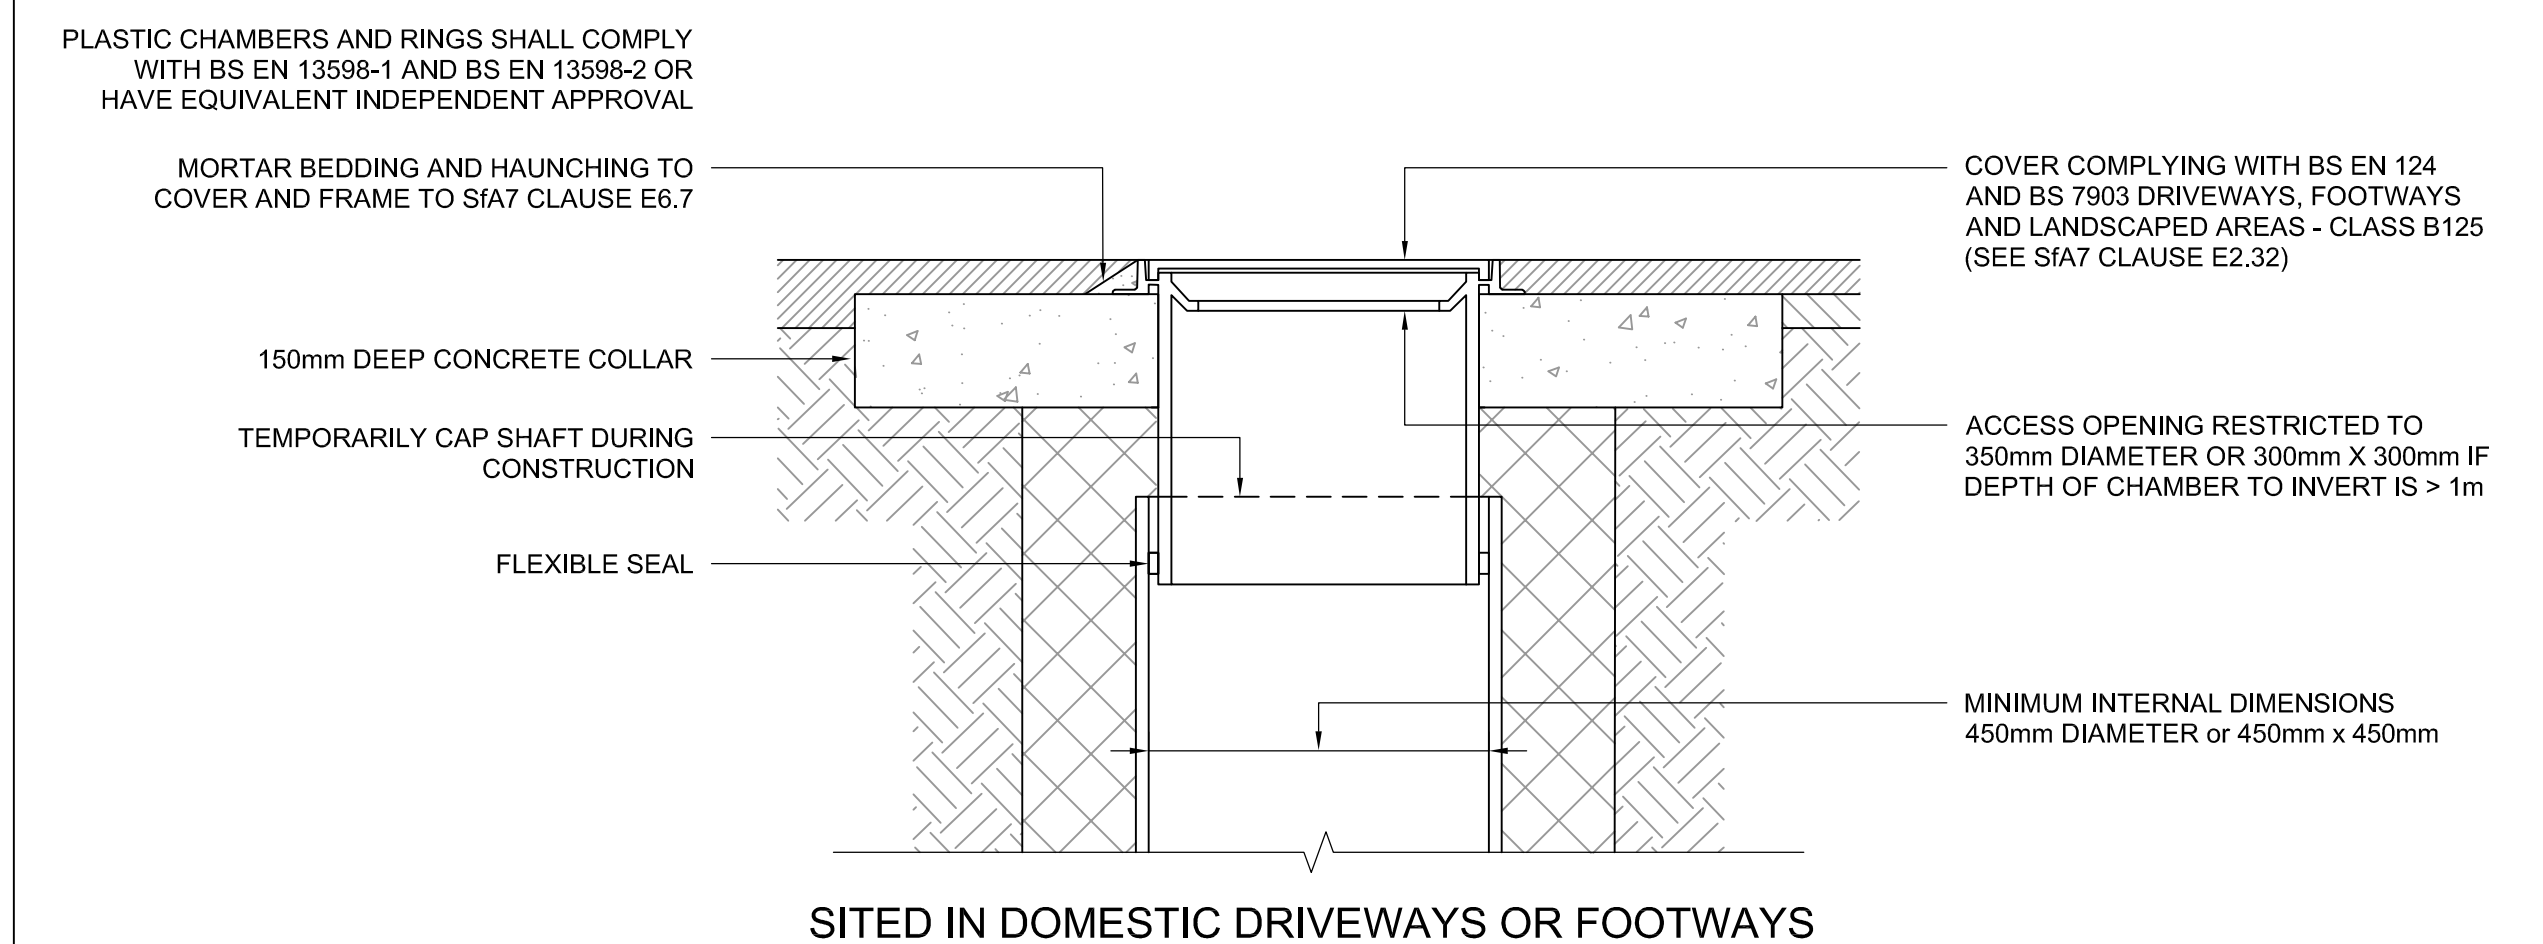


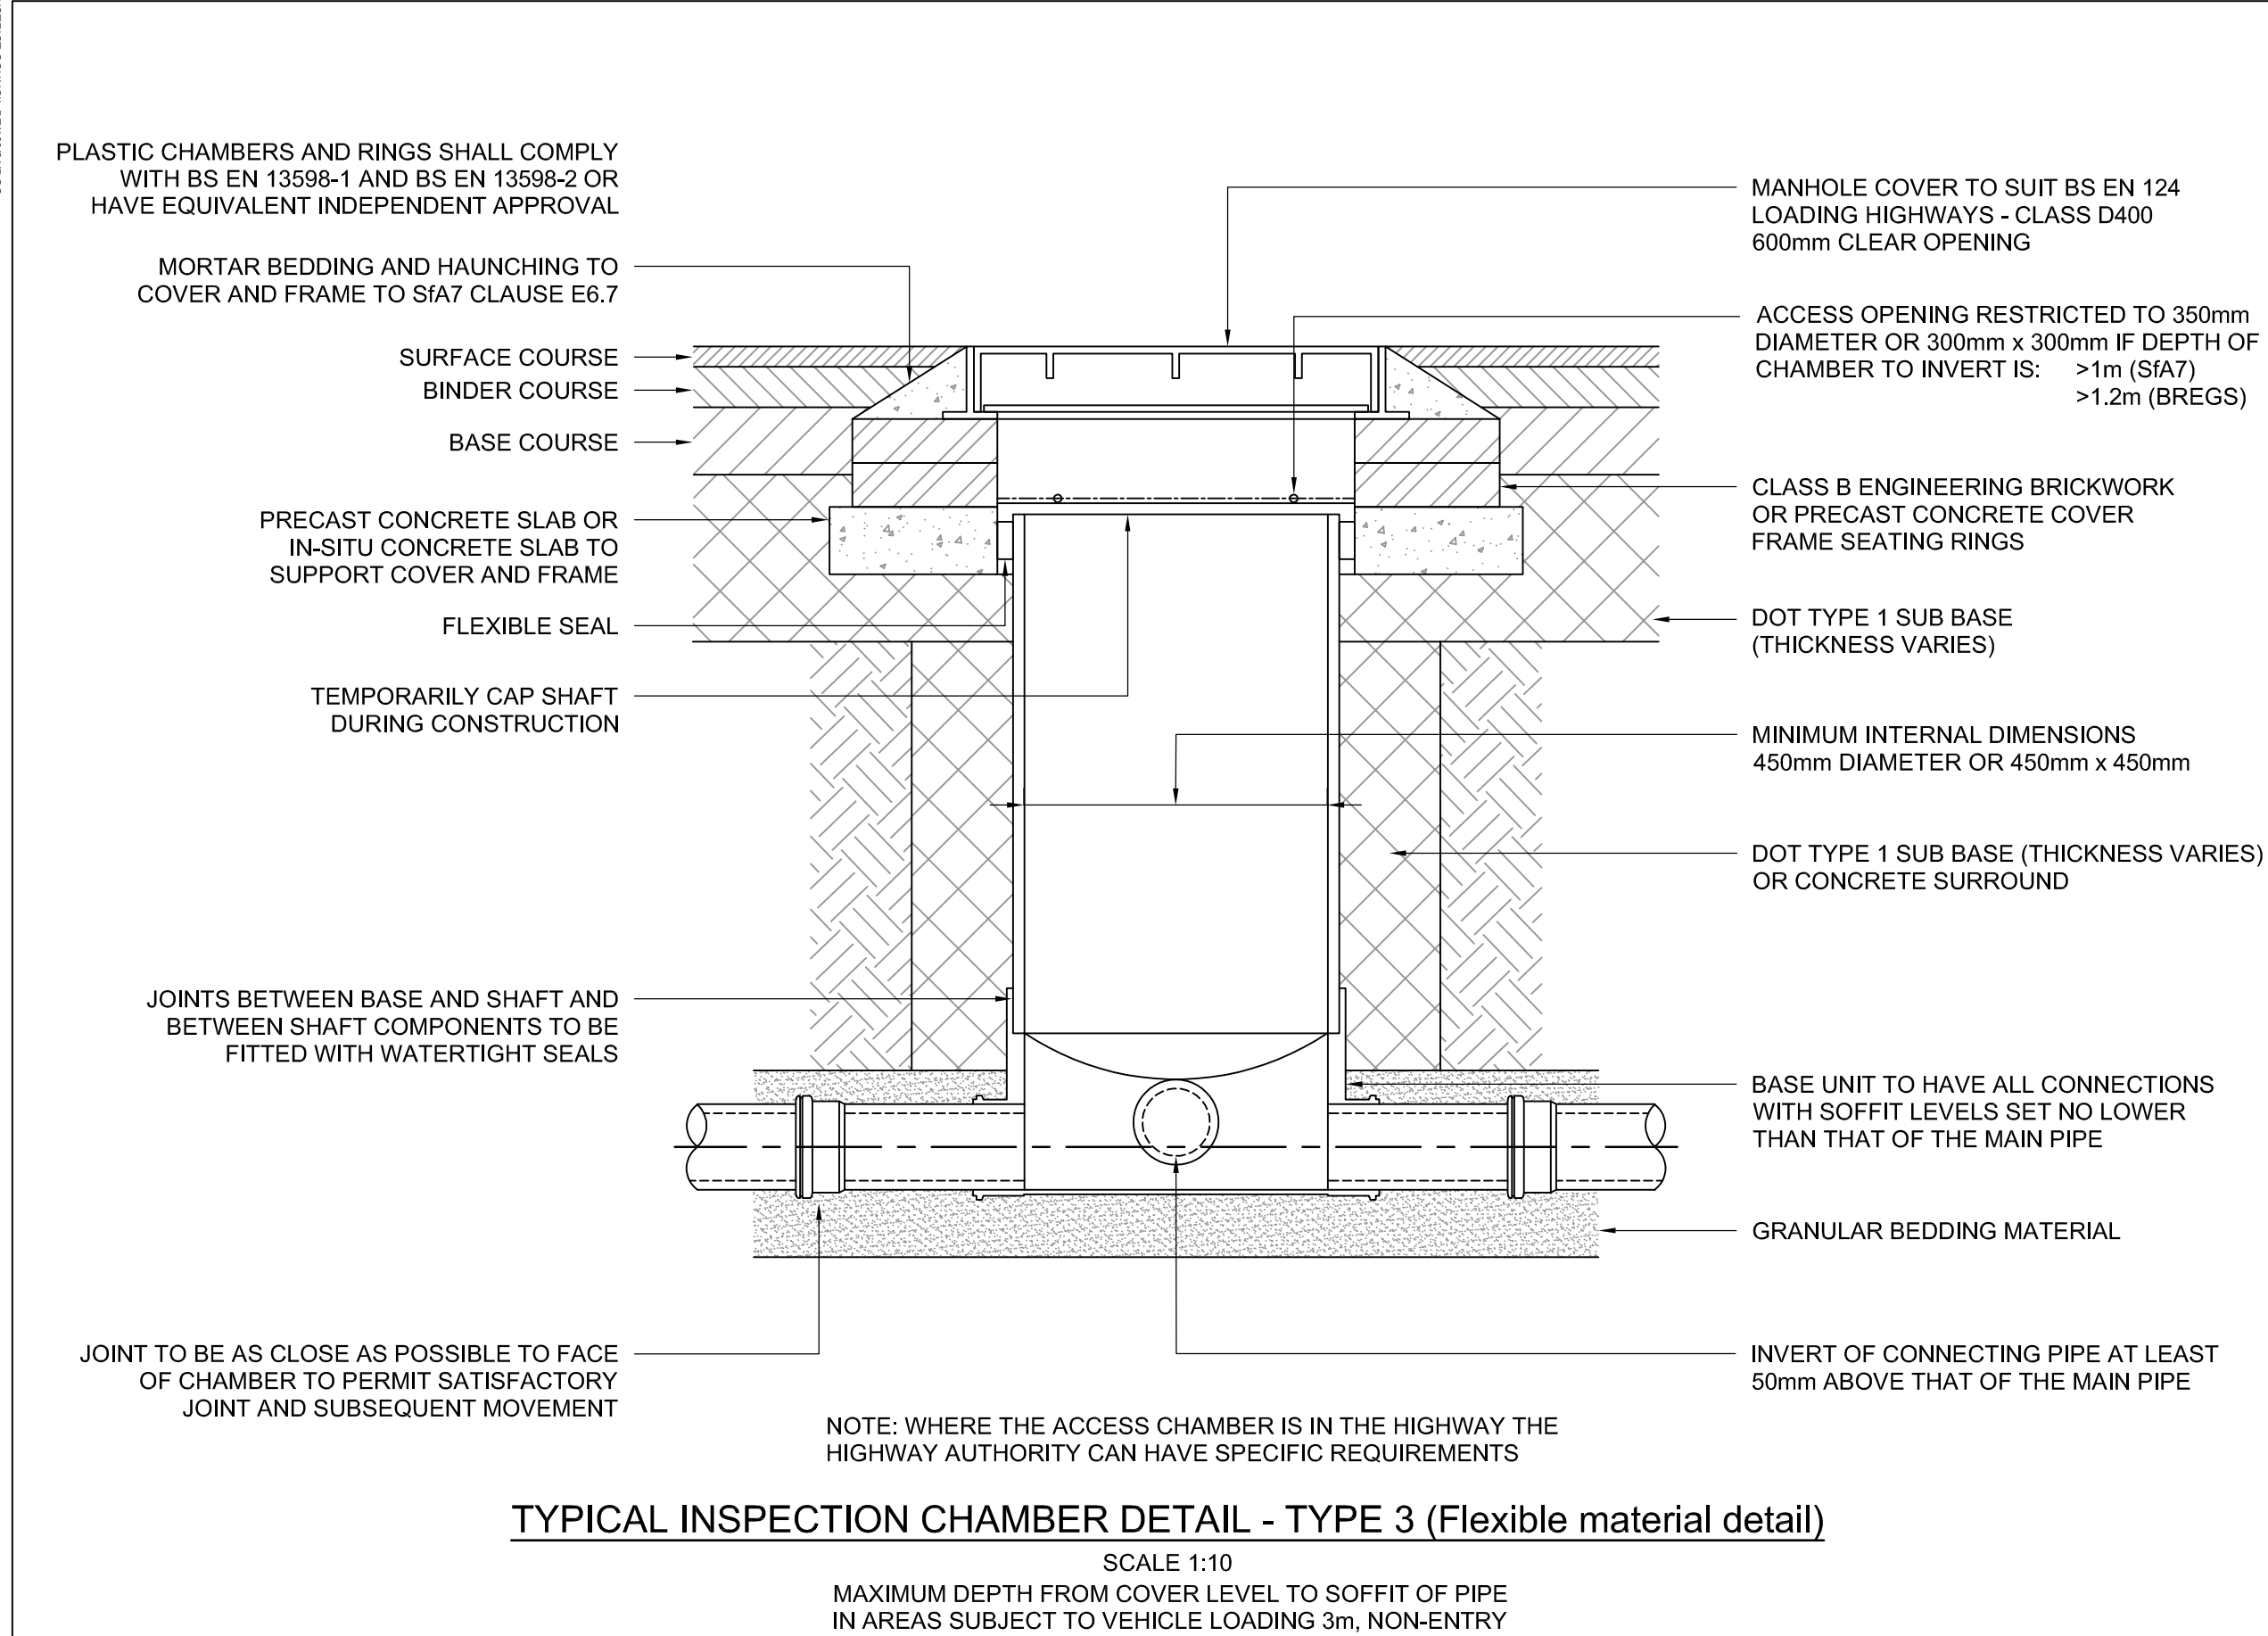

SIZING OF GRANULAR BEDDING MATERIAL:		
NOMINAL BORE OF PIPE (MIN)	AGGREGATE SIZE (MM)	
	SINGLE SIZED	GRADED
100	10	10
150 - 200	10 or 14	14 to 5
225 - 300	10, 14 or 20	14 to 5 or 20 to 5
375 - 500	14 or 20	14 to 5 or 20 to 5
EXCEEDING 500	14, 20 or 40	14 to 5, 20 to 5 or 40 to 5

ALL GRAULAR MATERIAL TO BE SINGLE SIZED OR GRADED IN ACCORDANCE WITH BS 882:1992, SINTERED PULVERISED-FUEL ASH TO BS 3797:1990 AND AIR-COOLED BLAST FURNACE SLAGS TO BS 1047:1983 ARE SUITABLE.

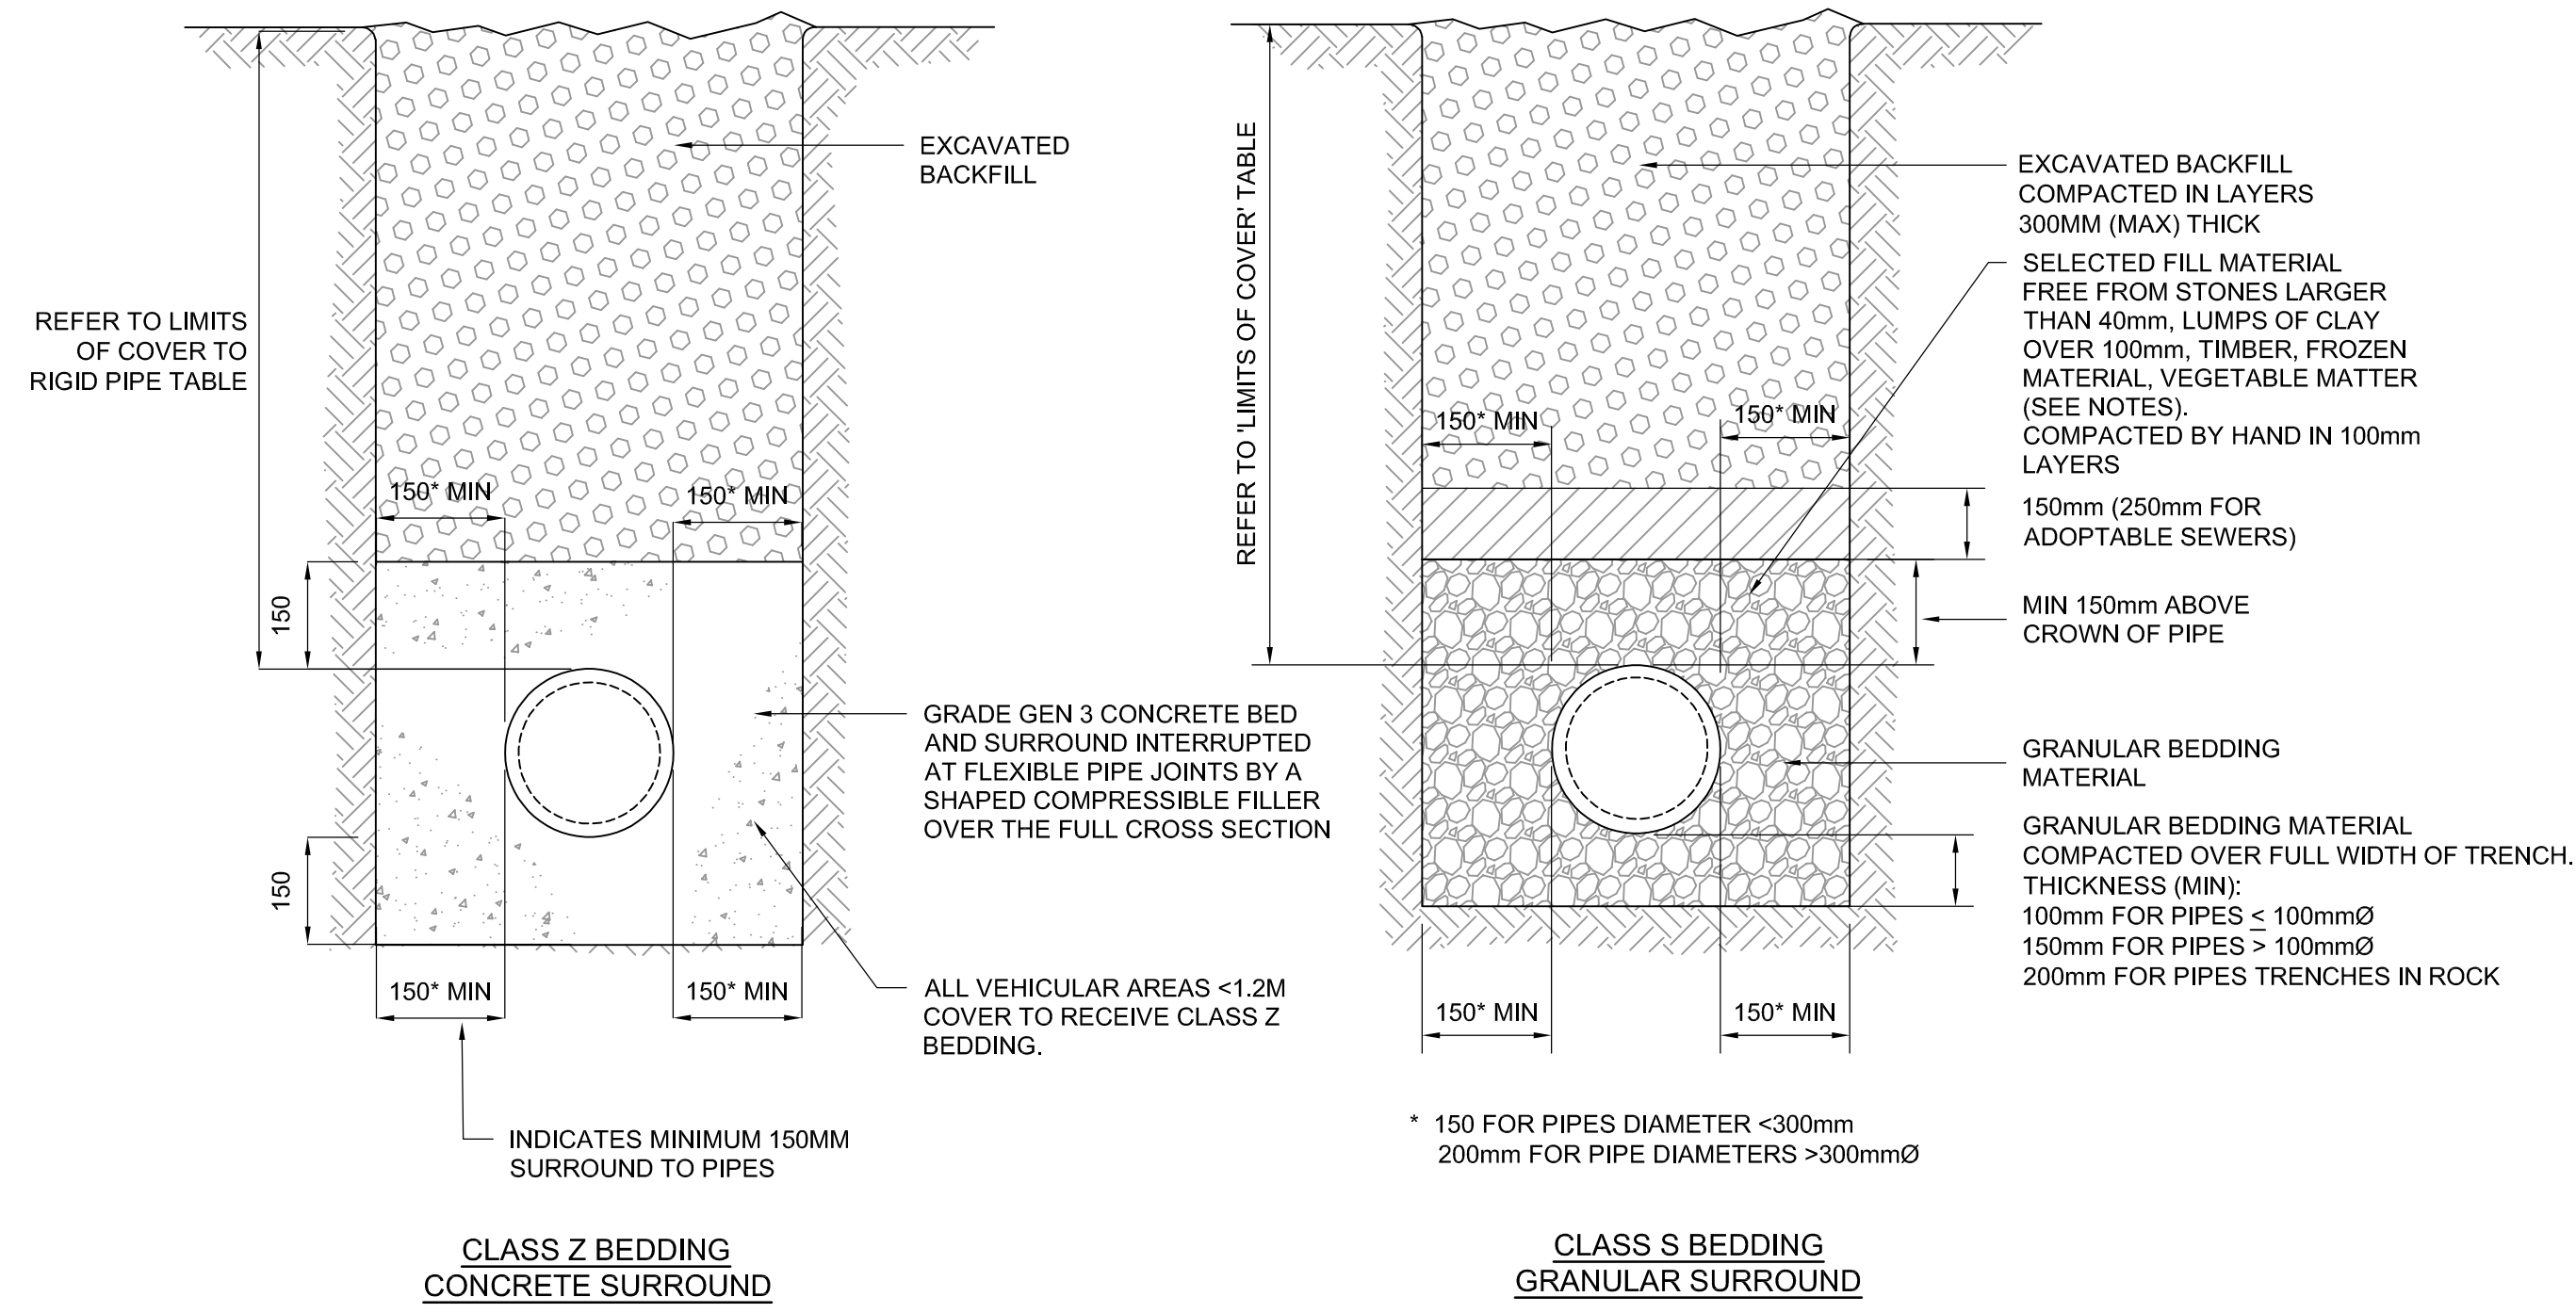

NOTES:

1. BACKFILL MATERIAL TO BE SELECTED EXCAVATED MATERIAL WHERE THIS MATERIAL COMPLIES WITH CESWI. ADDITIONAL MATERIAL TO MAKE UP ANY DEFICIENCY TO BE GRANULAR SUB-BASE TYPE 1 UNLESS STATED OTHERWISE.
2. IN WET, SOFT, OR SILTY SOILS, WHERE LATERAL SUPPORT IS NOT OBTAINED OR WHERE FINES MAY MIGRATE, THE GRANULAR BEDDING MATERIAL SHALL BE SURROUNDED BY GEOTEXTILE FABRIC WITH MIN 200 OVERLAP.
3. TRENCH BACKFILL TO MEET HIGHWAY SPECIFICATION WHEN LAID IN ROAD OR FOOTPATH.

KEY PLAN

- ## NOTES
1. All dimensions are to be checked on site before the commencement of works. Any discrepancies are to be reported to the Architect & Engineer for verification. Figured dimensions only are to be taken from this drawing.
 2. The DWG file is issued for the purposes of coordination only and do not represent formal drawing issue and are not to be reprinted in any form. Formal issue of drawings is via DWF, Adobe PDF files and/or hard copies and their associated information issue sheets.
 3. Note that all care has been taken with the export of DWG files and their content, but we recommend that you make due dimensional checks before using any DWG file information. Any errors found are to be reported to Hydrock immediately.

C04	AS BUILT ISSUE					
	D.DAVIS	22/07/21	D.GALLIMORE	22/07/21	D.GALLIMORE	22/07/21
C03	HEALTH AND SAFETY FILE ISSUE					
	J.SHIMMIN	11/06/21	D.GALLIMORE	11/06/21	M. GRIFFIN	11/06/21
C02	AS BUILT ISSUE					
	J.SHIMMIN	NYI	D.GALLIMORE	NYI	M. GRIFFIN	NYI
C01	ISSUED FOR CONSTRUCTION					
	D. GALLIMORE	24/07/20	D.GALLIMORE	24/07/20	M. GRIFFIN	24/07/20
P06	ISSUED FOR CONTRACT					
	R.HUNT	13/03/20	D.GALLIMORE	13/03/20	M. GRIFFIN	13/03/20
P05	REVISED FOLLOWING DOC COMMENTS (CLOUDED)					
	R.HUNT	22/11/19	D.GALLIMORE	22/11/19	M.GRIFFIN	22/11/19
P04	REVISED FOLLOWING DOC COMMENTS (CLOUDED)					
	R.HUNT	22/11/19	D.GALLIMORE	22/11/19	M.GRIFFIN	22/11/19
P03	REVISED FOLLOWING DOC COMMENTS (CLOUDED)					
	R.HUNT	22/11/19	D.GALLIMORE	22/11/19	M.GRIFFIN	22/11/19
P02	REVISED FOLLOWING DOC COMMENTS (CLOUDED)					
	R.HUNT	20/11/19	D.GALLIMORE	20/11/19	M.GRIFFIN	20/11/19
P01	TENDER ISSUE					
	R.HUNT	11/10/19	D.GALLIMORE	11/10/19	M.GRIFFIN	11/10/19
REV	REVISION NOTES/COMMENTS					
	DRAWN BY	DATE	CHECKED BY	DATE	APPROVED BY	DATE

Hydrock

 Merchants' House North
Wapping Road
Bristol
BS1 4RW
t: +44 (0)117 945 9225
e: bristolcentral@hydrock.com

CLIENT

LANDLINK ESTATES

PROJECT

SALTBOX
BOGNOR REGIS

TITLE
DRAINAGE DETAILS SHEET 2

HYDROCK PROJECT NO. C-13319-C	SCALE @ A1 AS SHOWN
STATUS DESCRIPTION AS BUILT ISSUE	STATUS A
DRAWING NO. (PROJECT CODE-ORIGINATOR-ZONE-LEVEL-TYPE-ROLE-NUMBER) SAL-HYD-00-ZZ-DR-C-7101	REVISION C04