

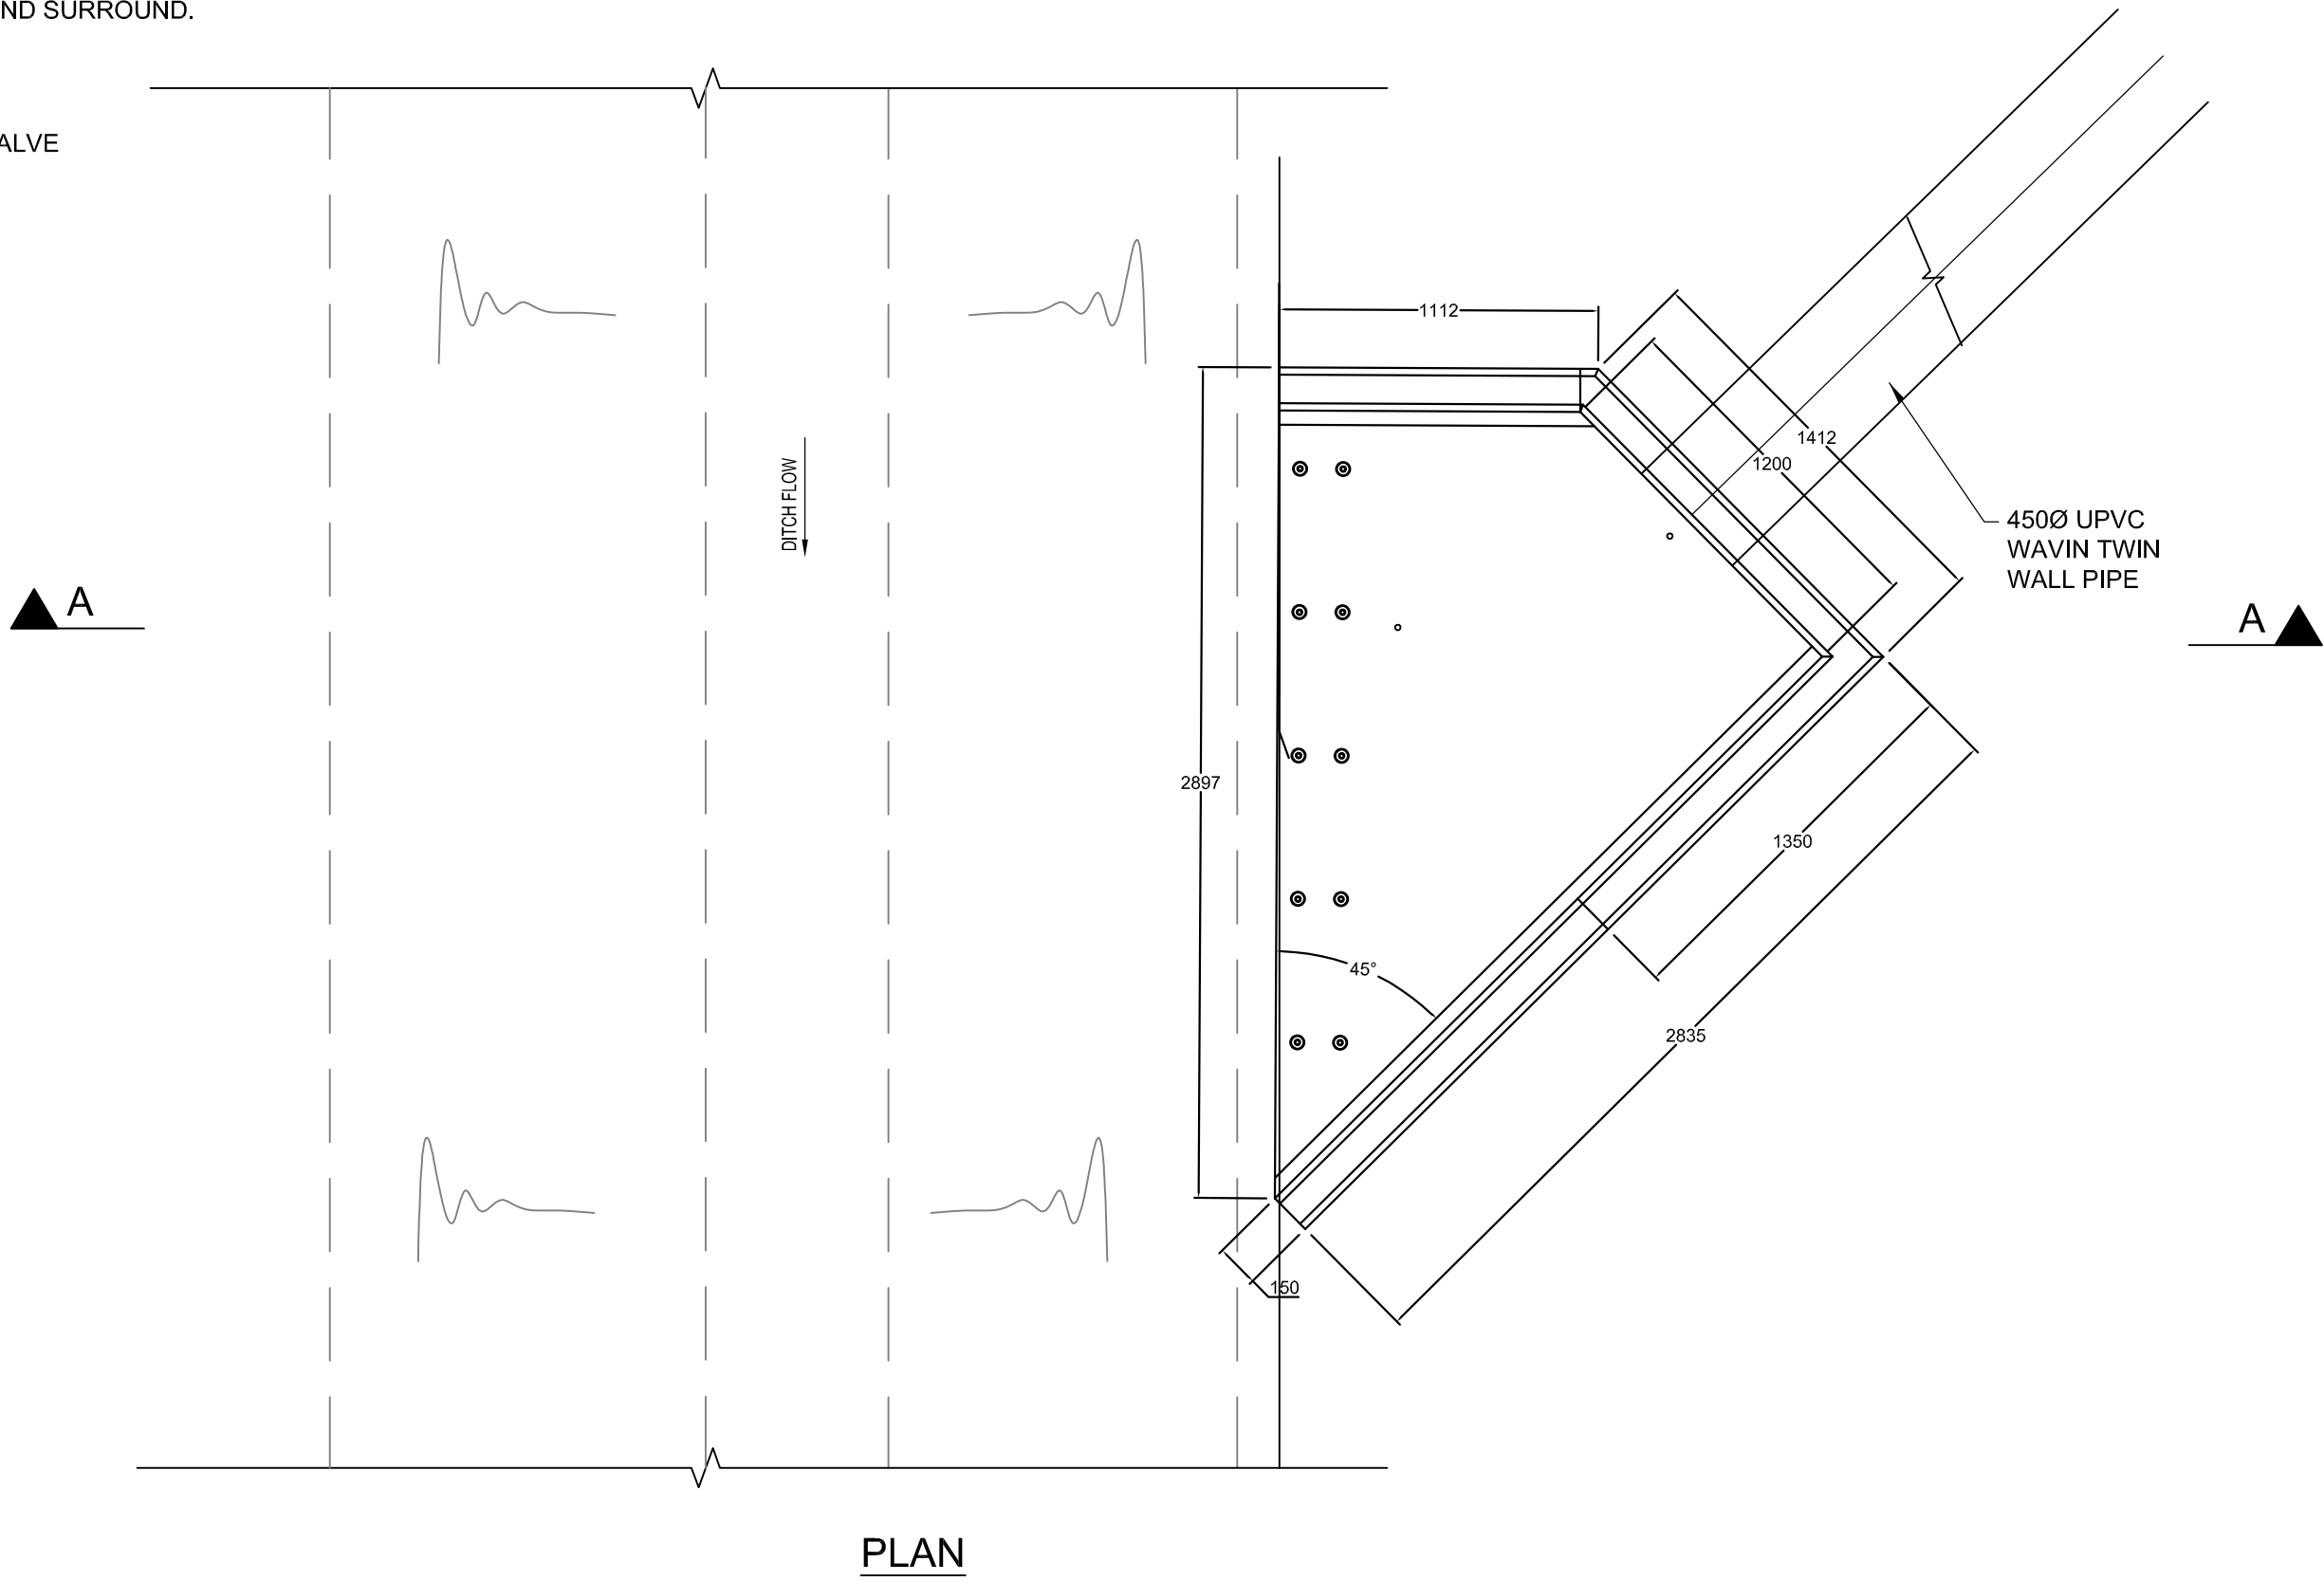
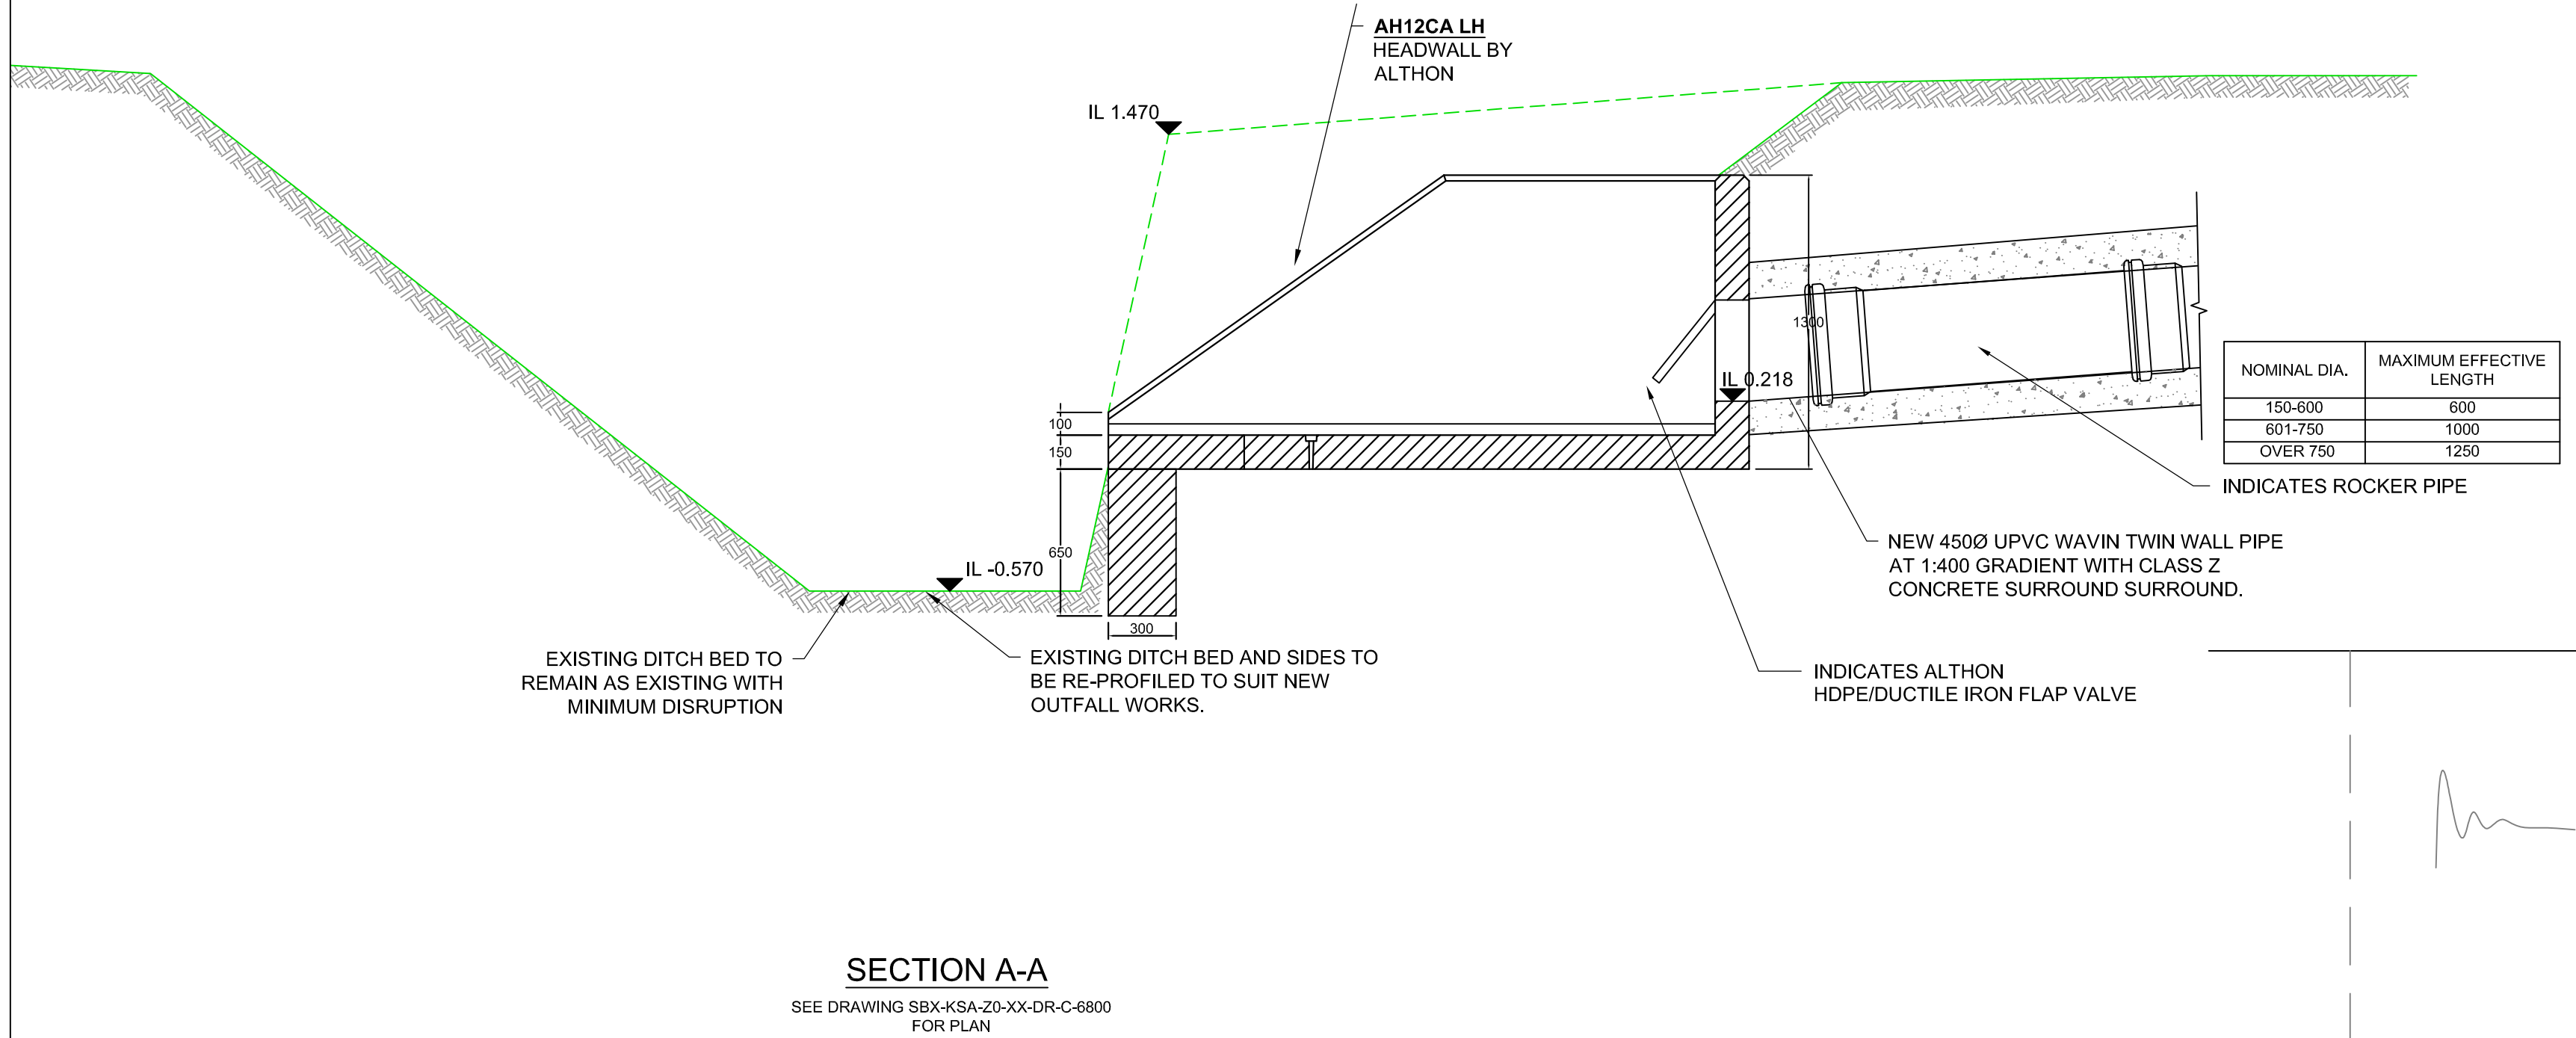


ARUN DISTRICT COUNCIL INFORMATION

HEADWALL 01

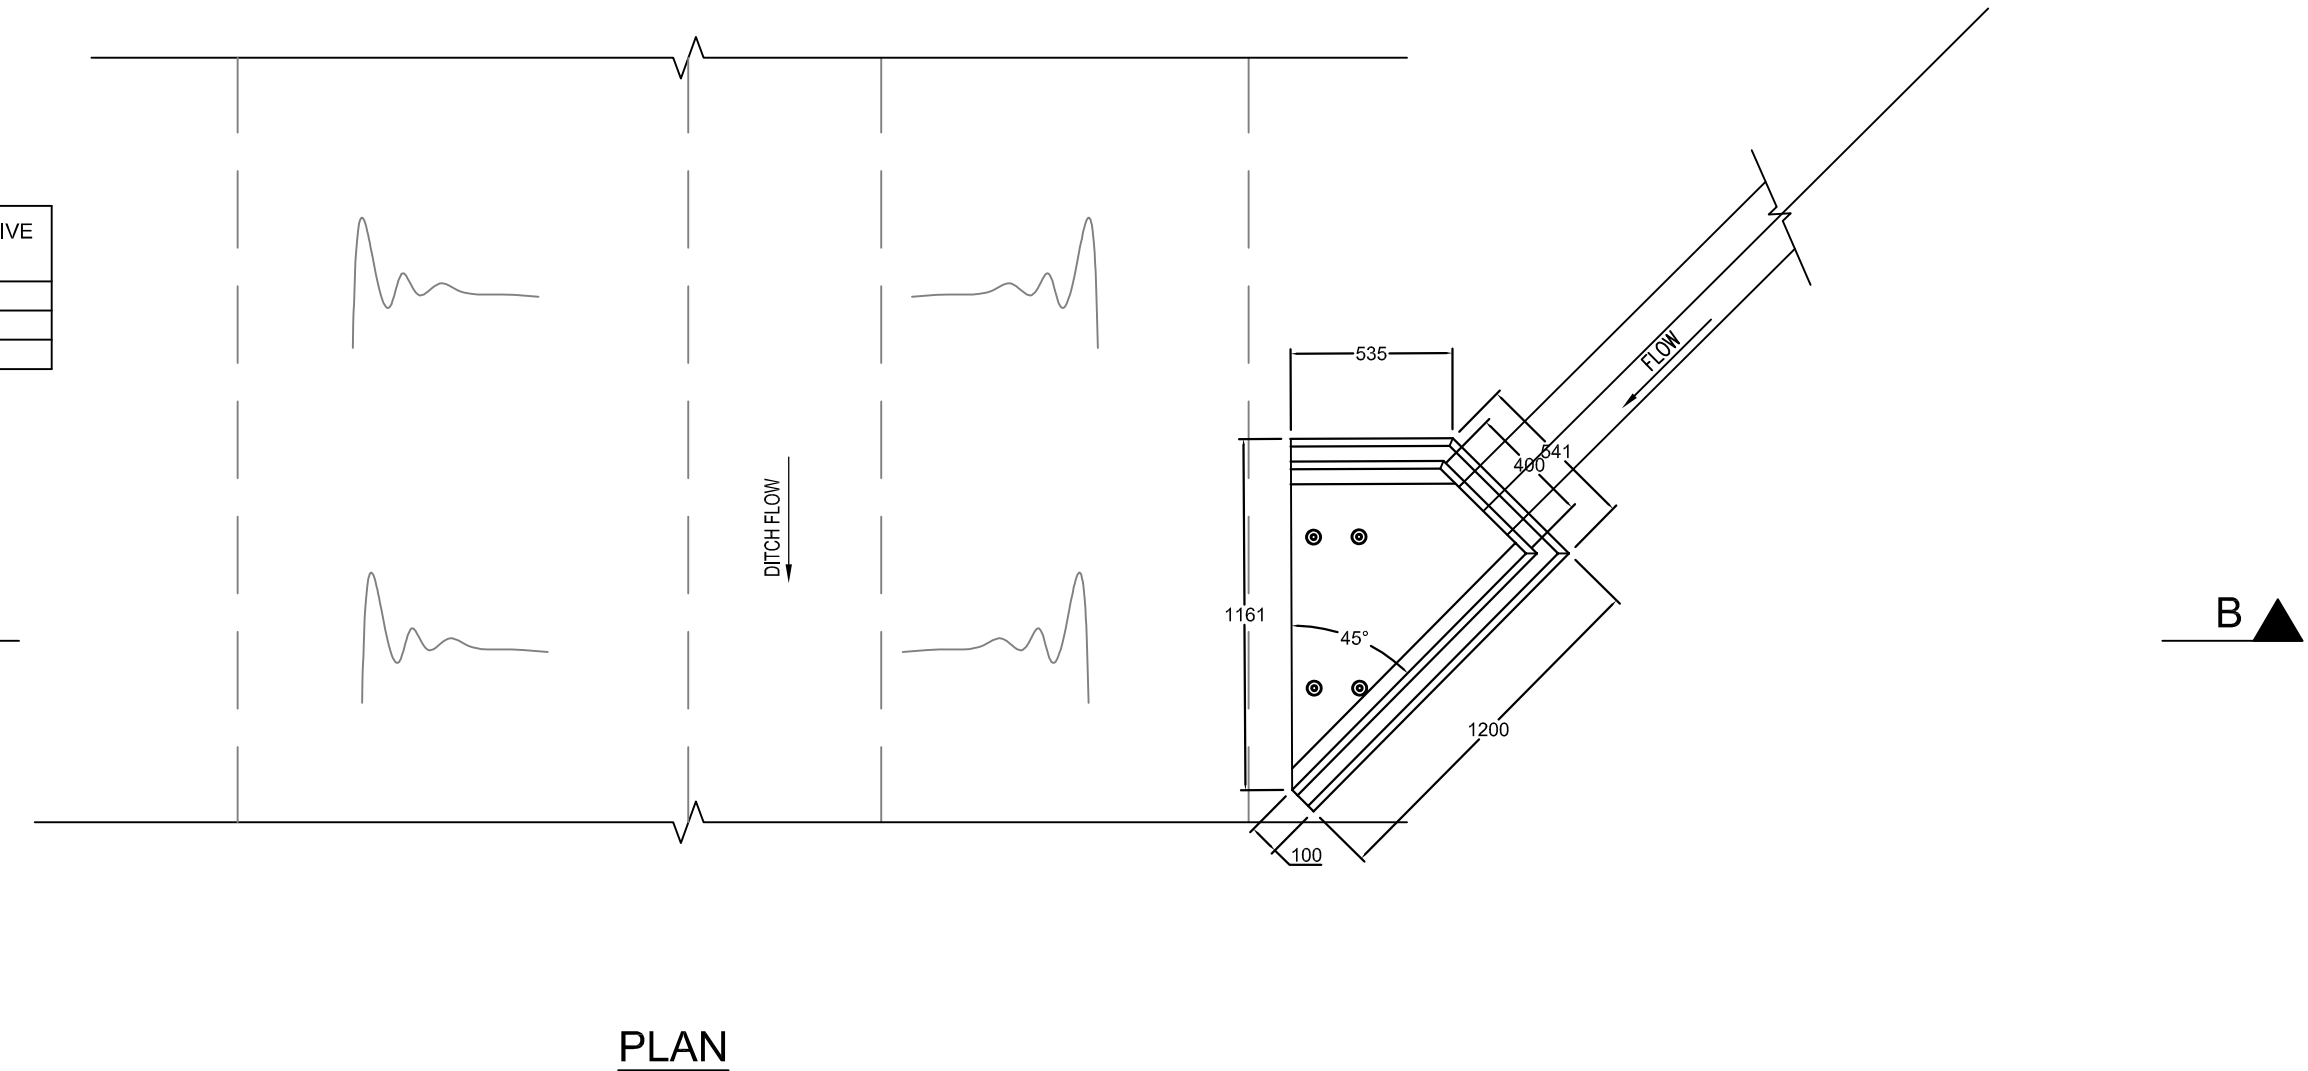

HEADWALL 02

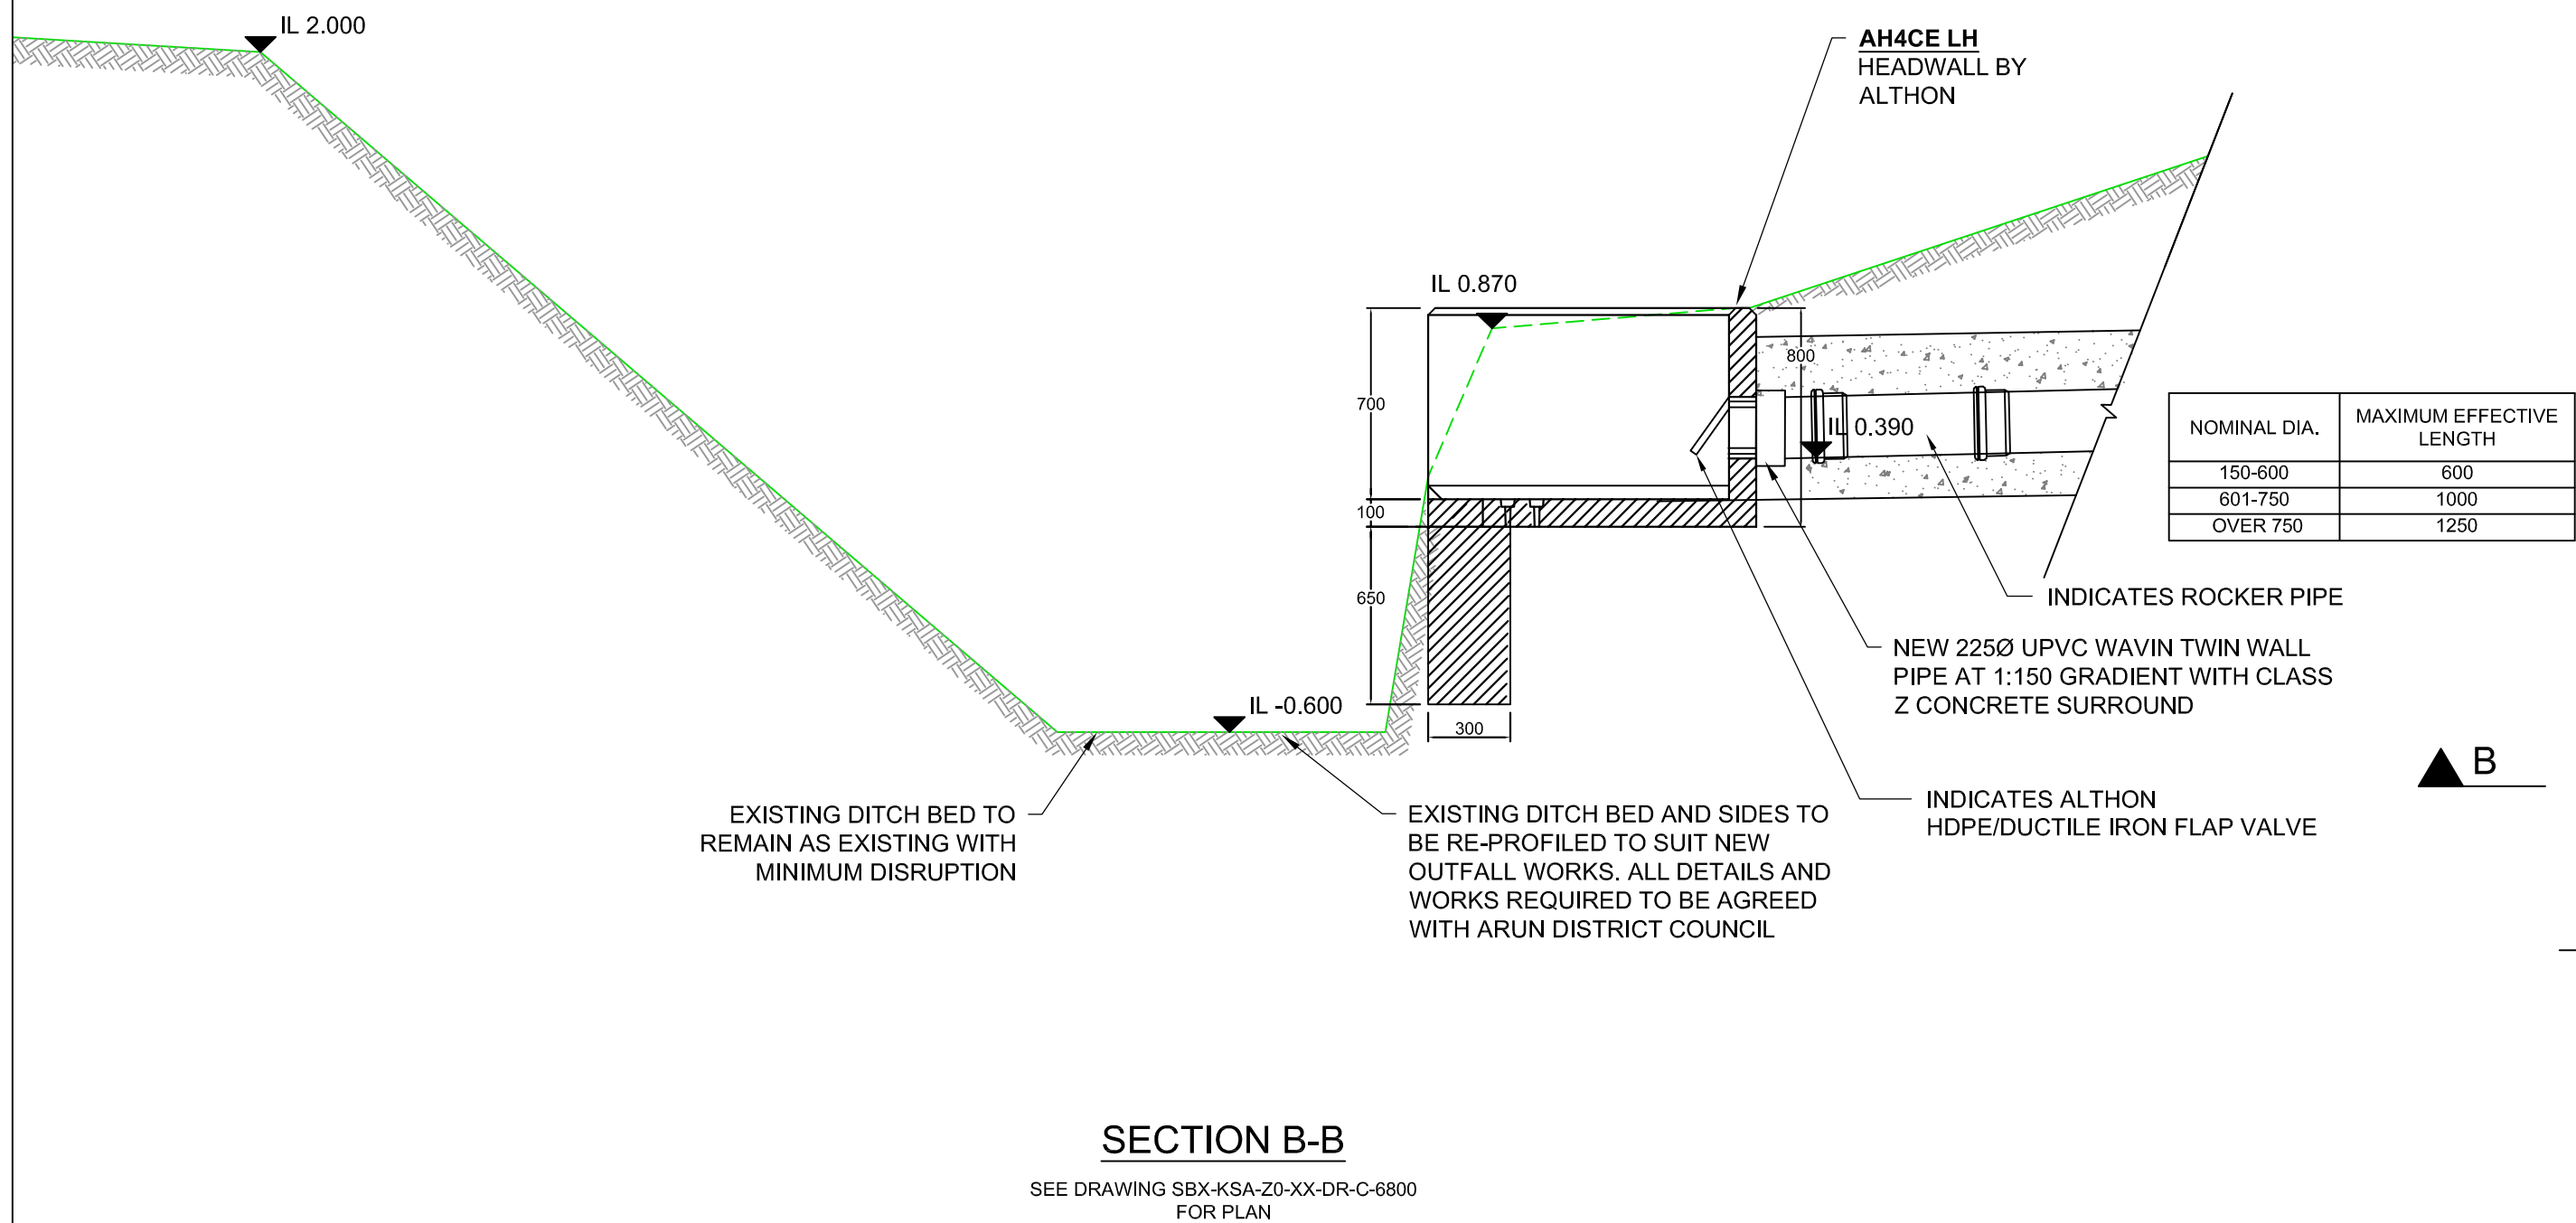

KEY PLAN

NOTES

- All dimensions are to be checked on site before the commencement of works. Any discrepancies are to be reported to the Architect & Engineer for verification. Figured dimensions only are to be taken from this drawing.
- The DWG file is issued for the purposes of coordination only and do not represent formal drawing issue and are not to be reprinted in any form. Formal issue of drawings is via DWF, Adobe PDF files and/or hard copies and their associated information issue sheets.
- Note that all care has been taken with the export of DWG files and their content, but we recommend that you make due dimensional checks before using any DWG file information. Any errors found are to be reported to Hydrock immediately.

AS BUILT ISSUE					
C04	O.DAVIS	22.07.21	D.GALLIMORE	22.07.21	D.GALLIMORE 22.07.21
HEALTH AND SAFETY FILE ISSUE					
C03	J.SHIMMIN	11.06.21	D.GALLIMORE	11.06.21	M. GRIFFIN 11.06.21
ISSUED FOR CONSTRUCTION					
C02	D. GALLIMORE	16/12/20	D.GALLIMORE	16/12/20	M. GRIFFIN 16/12/20
ISSUED FOR CONSTRUCTION					
C01	D. GALLIMORE	24/07/20	D.GALLIMORE	24/07/20	M. GRIFFIN 24/07/20
ISSUED FOR CONTRACT					
P04	R.HUNT	13/03/20	D.GALLIMORE	13/03/20	M. GRIFFIN 13/03/20
REVISED FOLLOWING COMMENTS (AS CLOUDED)					
P03	D. GALLIMORE	15/11/19	M. GRIFFIN	15/11/19	M. GRIFFIN 15/11/19
REVISED FOLLOWING COMMENTS (AS CLOUDED)					
P02	D. GALLIMORE	06/11/19	M. GRIFFIN	06/11/19	M. GRIFFIN 06/11/19
TENDER ISSUE					
P01	A.TODD	17/10/19	J.MAGEE	17/10/19	M.GRIFFIN 17/10/19
REVISION NOTES/COMMENTS					
REV	DRAWN BY	DATE	CHECKED BY	DATE	APPROVED BY DATE

Merchants' House North
Wapping Road
Bristol
BS1 4RW
t: +44 (0)117 945 9225
e: bristolcentral@hydrock.com

CLIENT		
LANDLINK ESTATES		
PROJECT		
SALTBOX BOGNOR REGIS		
TITLE		
HEADWALL DETAILS		
HYDROCK PROJECT NO. C-13319-C		SCALE @ A1 1:25
STATUS DESCRIPTION AS BUILT ISSUE		STATUS A
DRAWING NO. (PROJECT CODE-ORIGINATOR-ZONE-LEVEL-TYPE-ROLE-NUMBER) SAL-HYD-00-ZZ-DR-C-7110		REVISION C04