



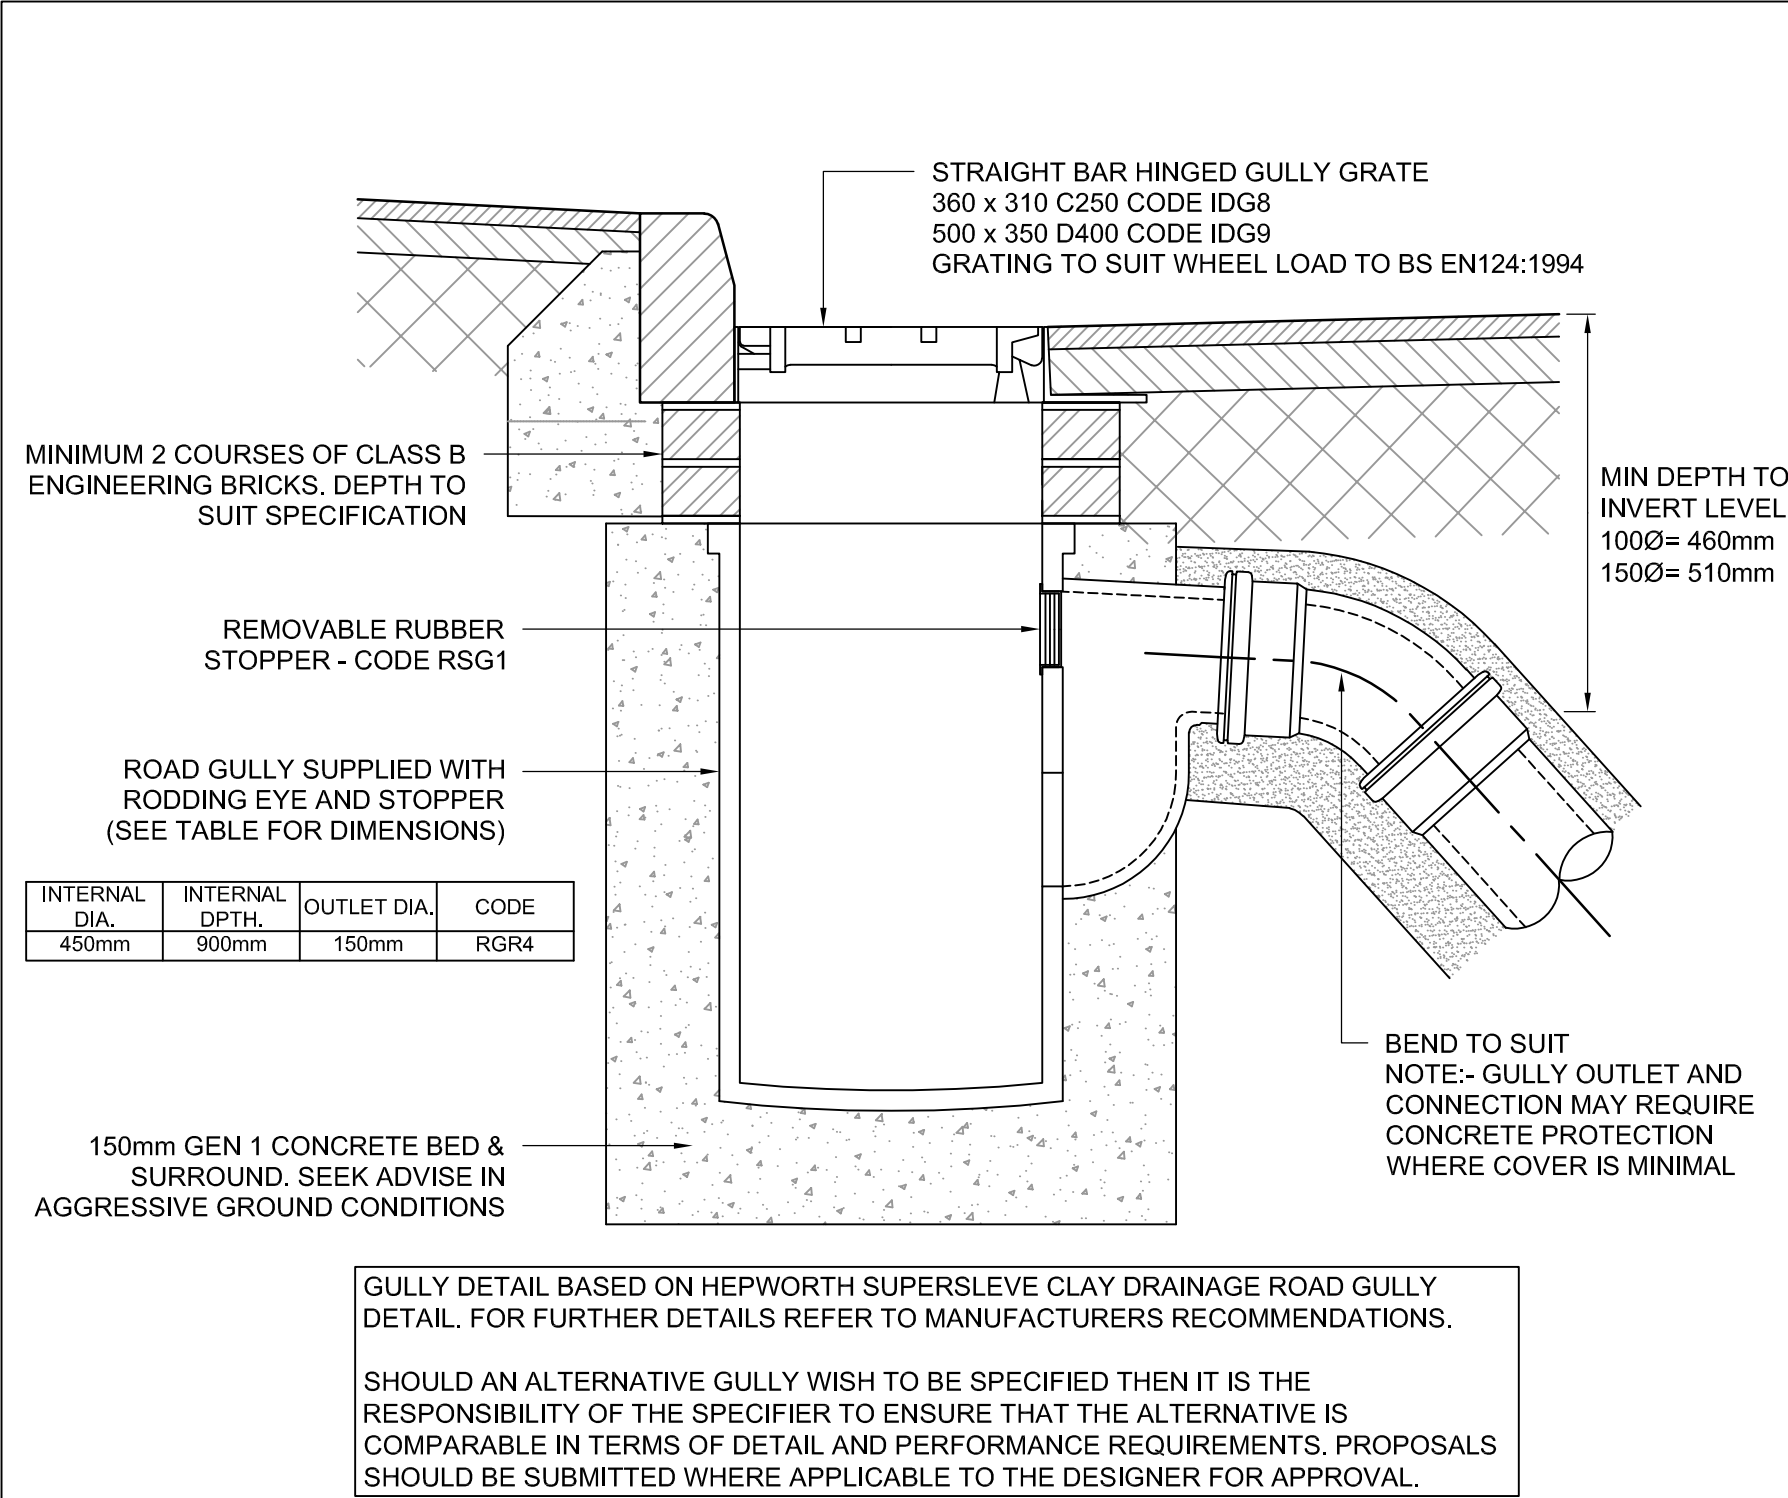


DETAIL RG: ROAD GULLY

SCALE 1:10

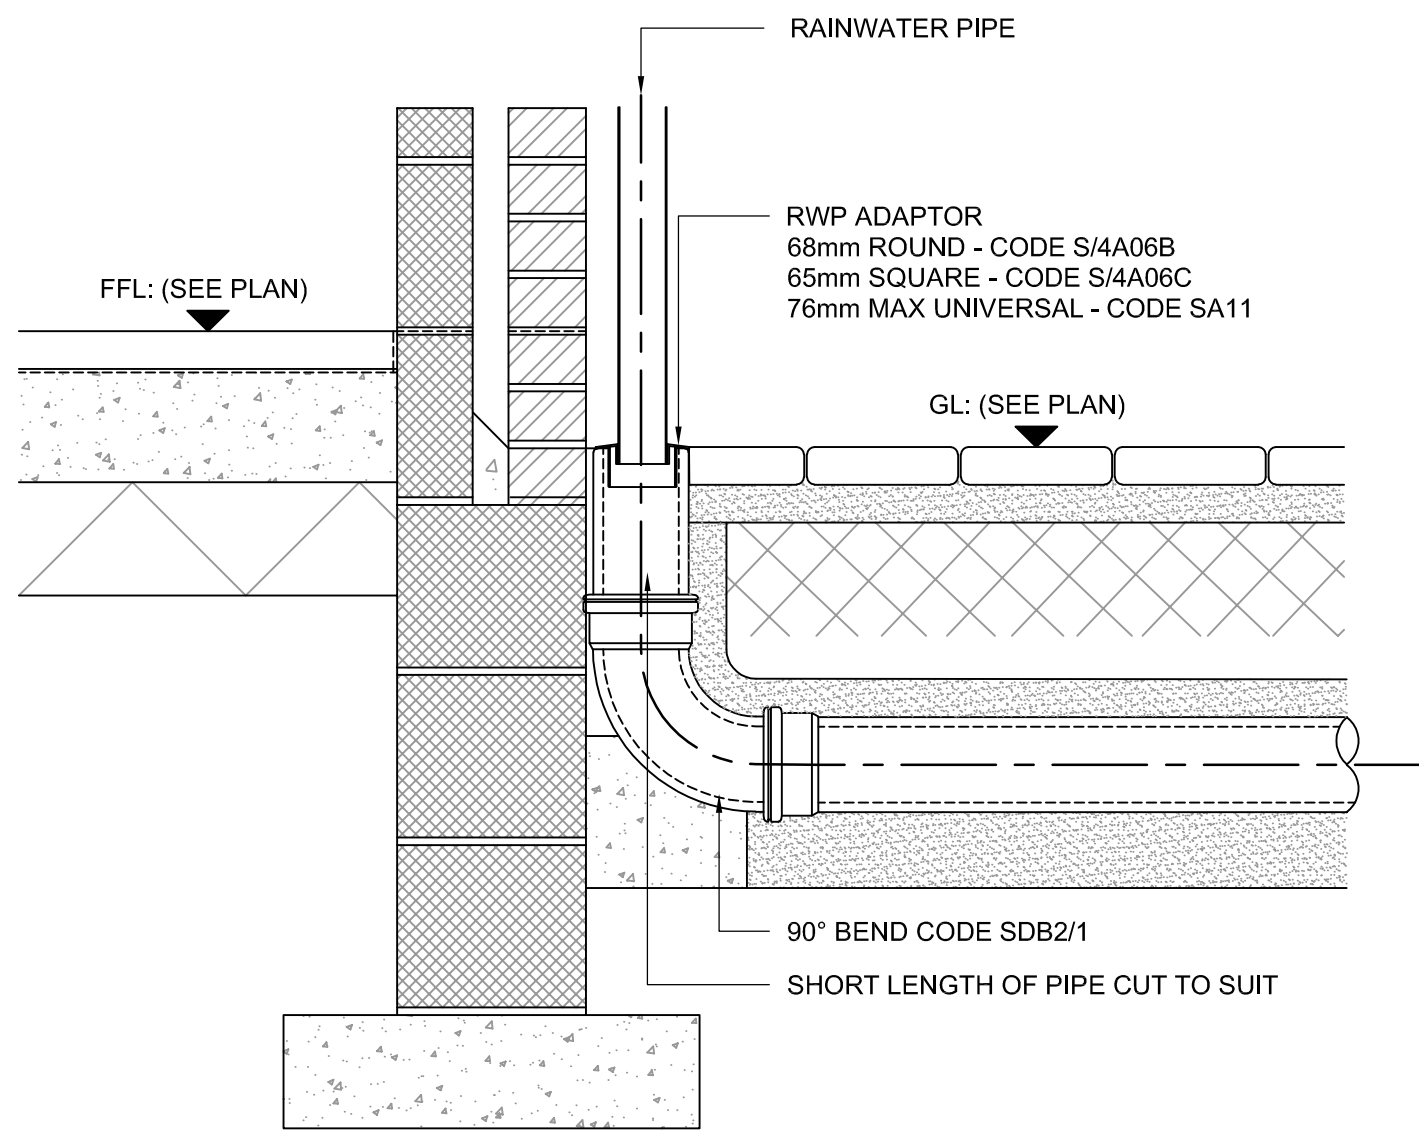


TYPICAL EXTERNAL RAINWATER PIPE 01 & 01A

SCALE 1:10

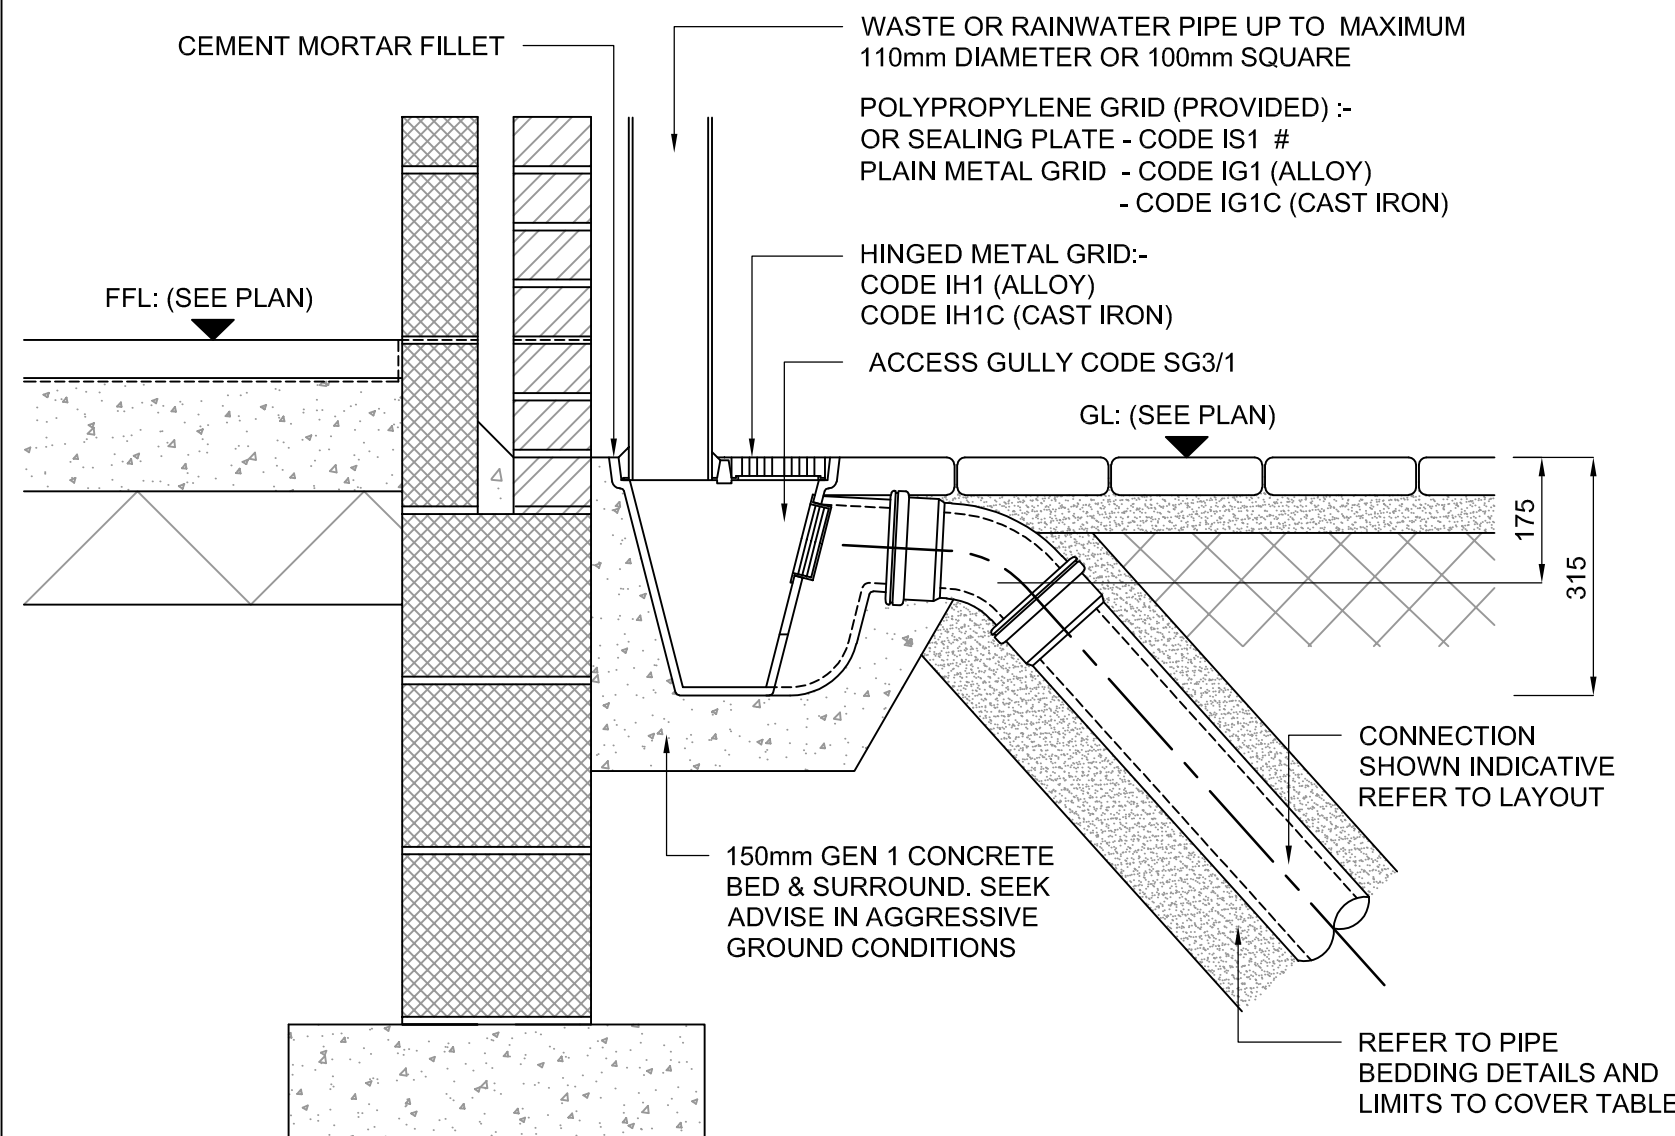

DETAIL AG: ACCESS GULLY


SCALE 1:10

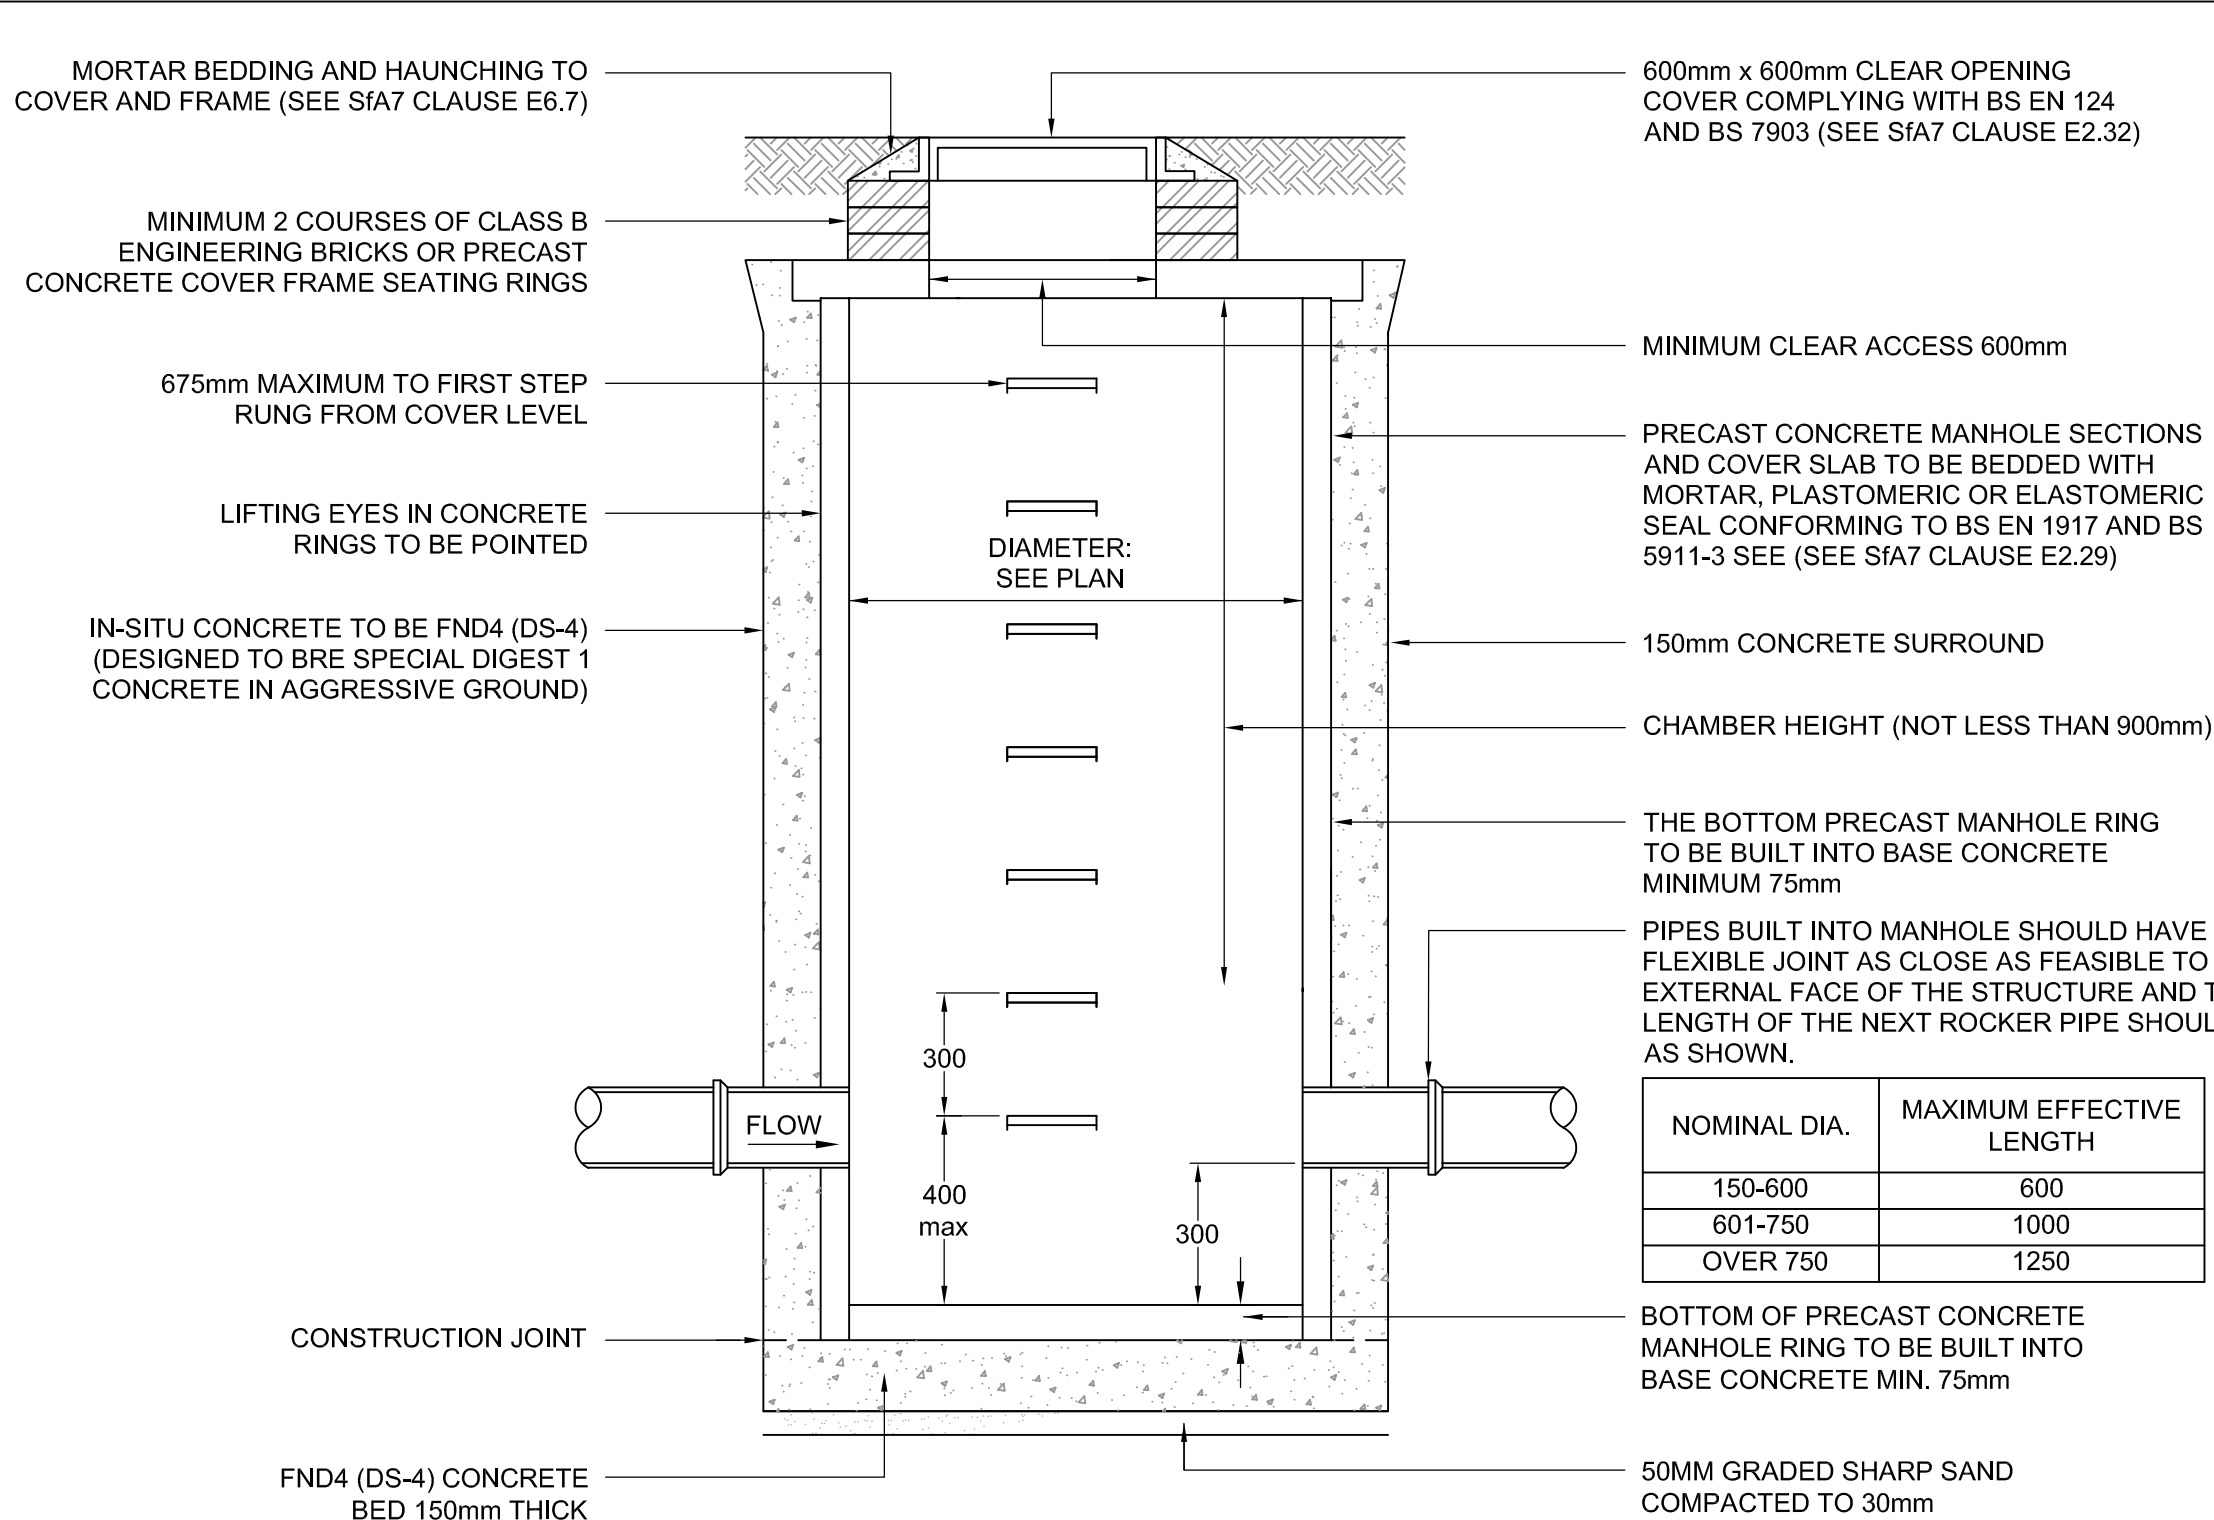


TYPICAL CATCHPIT DETAIL

SCALE 1:20

MAXIMUM DEPTH FROM COVER LEVEL TO SOFFIT OF PIPE 3.0m

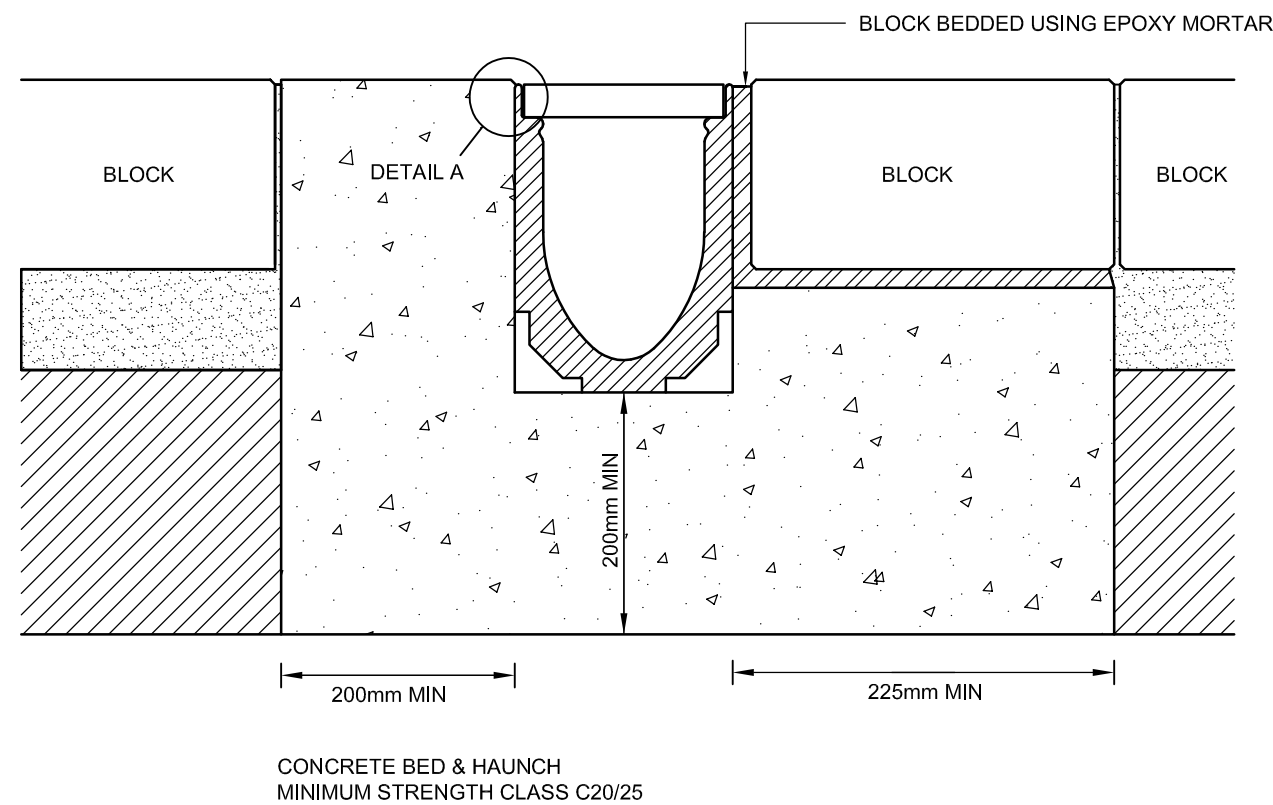


ACO MULTIDRAIN CHANNEL INSTALLATION FOR LOAD CLASS D400
(BLOCK PAVING)

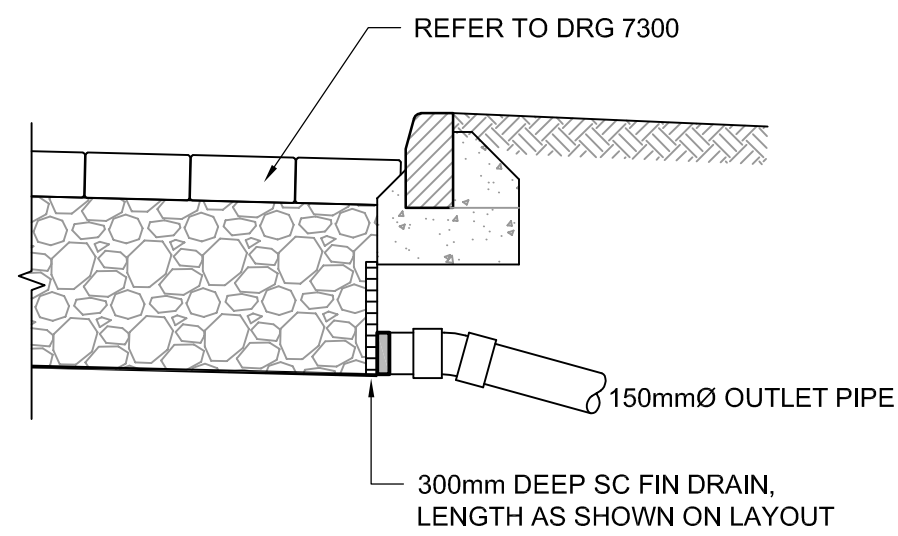


TYPICAL FIN DRAIN OUTLET DETAIL

SCALE 1:20

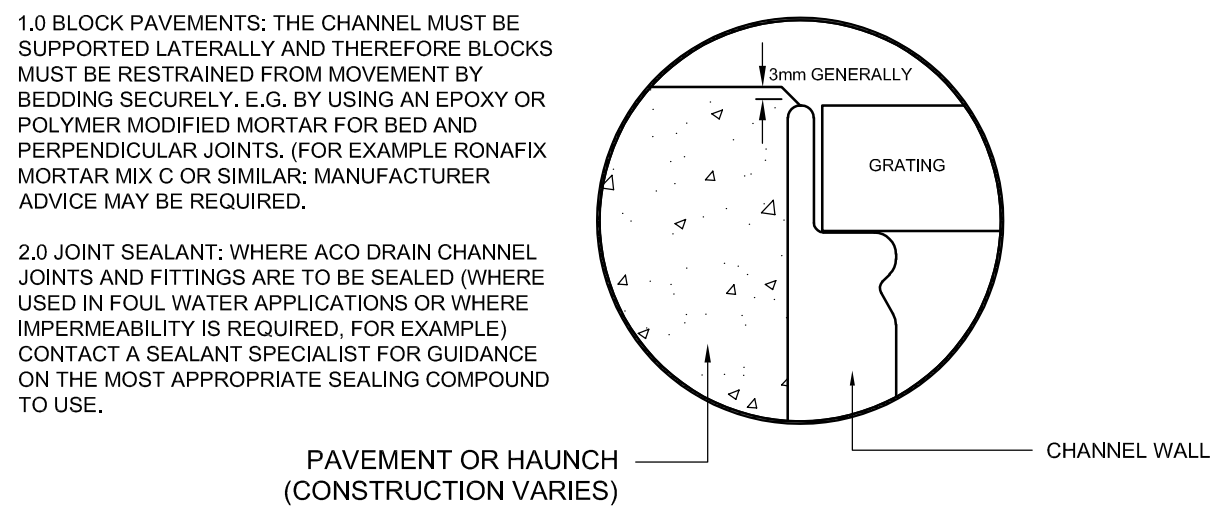


DETAIL A

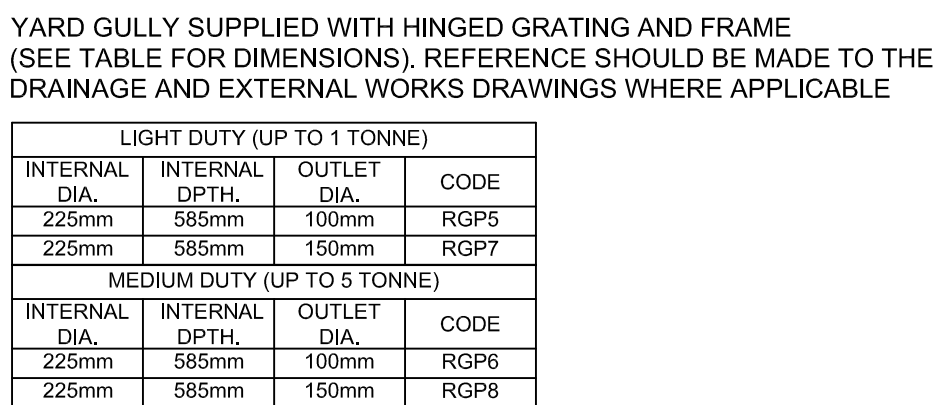

NOTE:-


THE DEPTH OF THE GULLY CAN BE INCREASED BY UP TO 300mm BY FITTING A 225mm COUPLING CODE VC1/3 AND A 300mm HIGH RAISING PIECE CODE SIC3/1 BETWEEN THE FRAME AND THE GULLY BODY.

EXTERNAL FINISHES SHOWN INDICATIVE

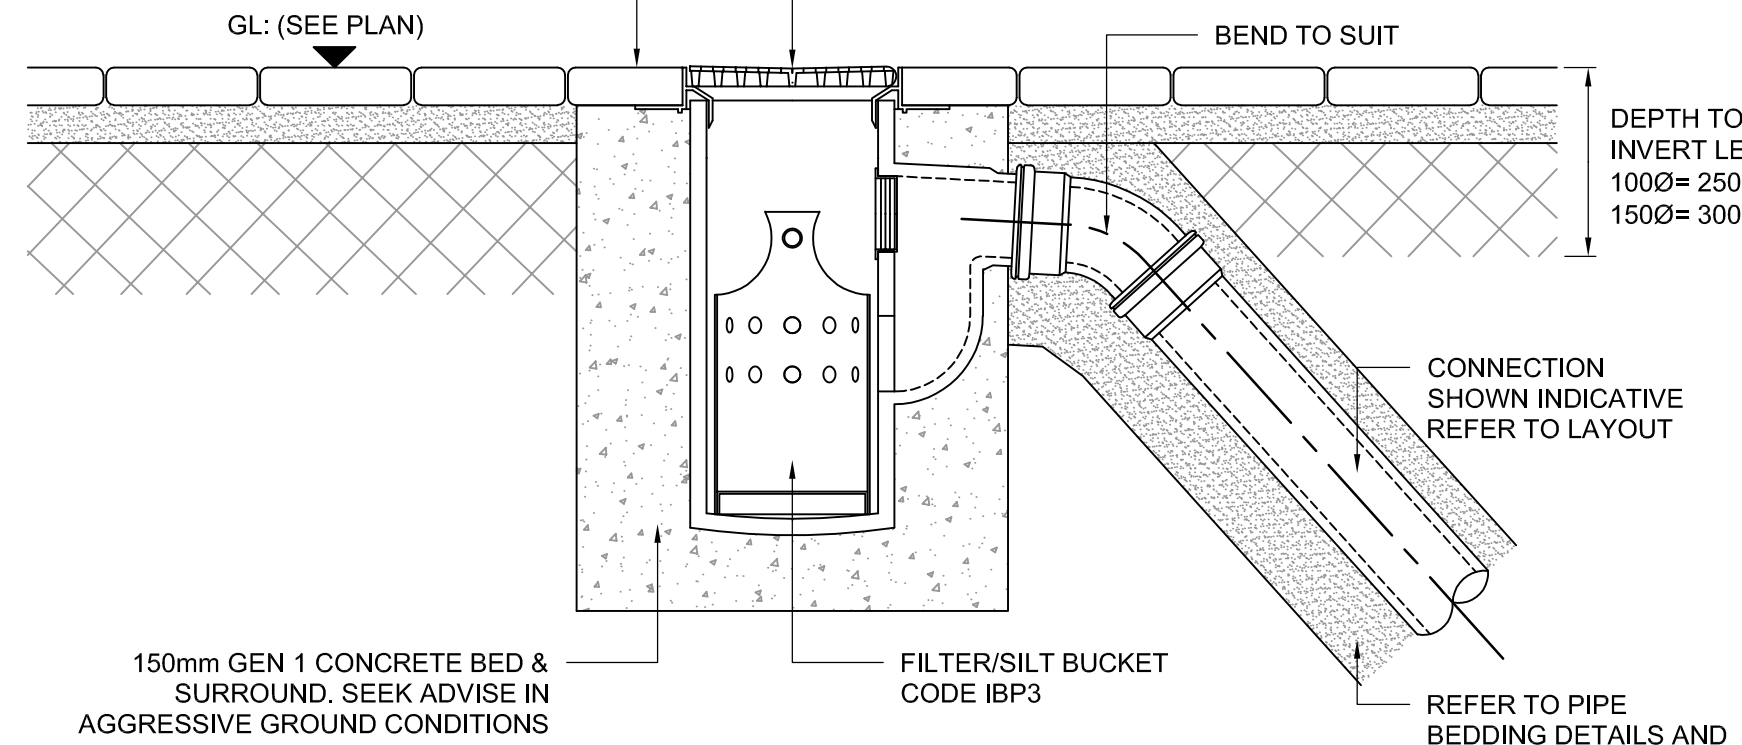

DETAIL YG: YARD GULLY

SCALE 1:10

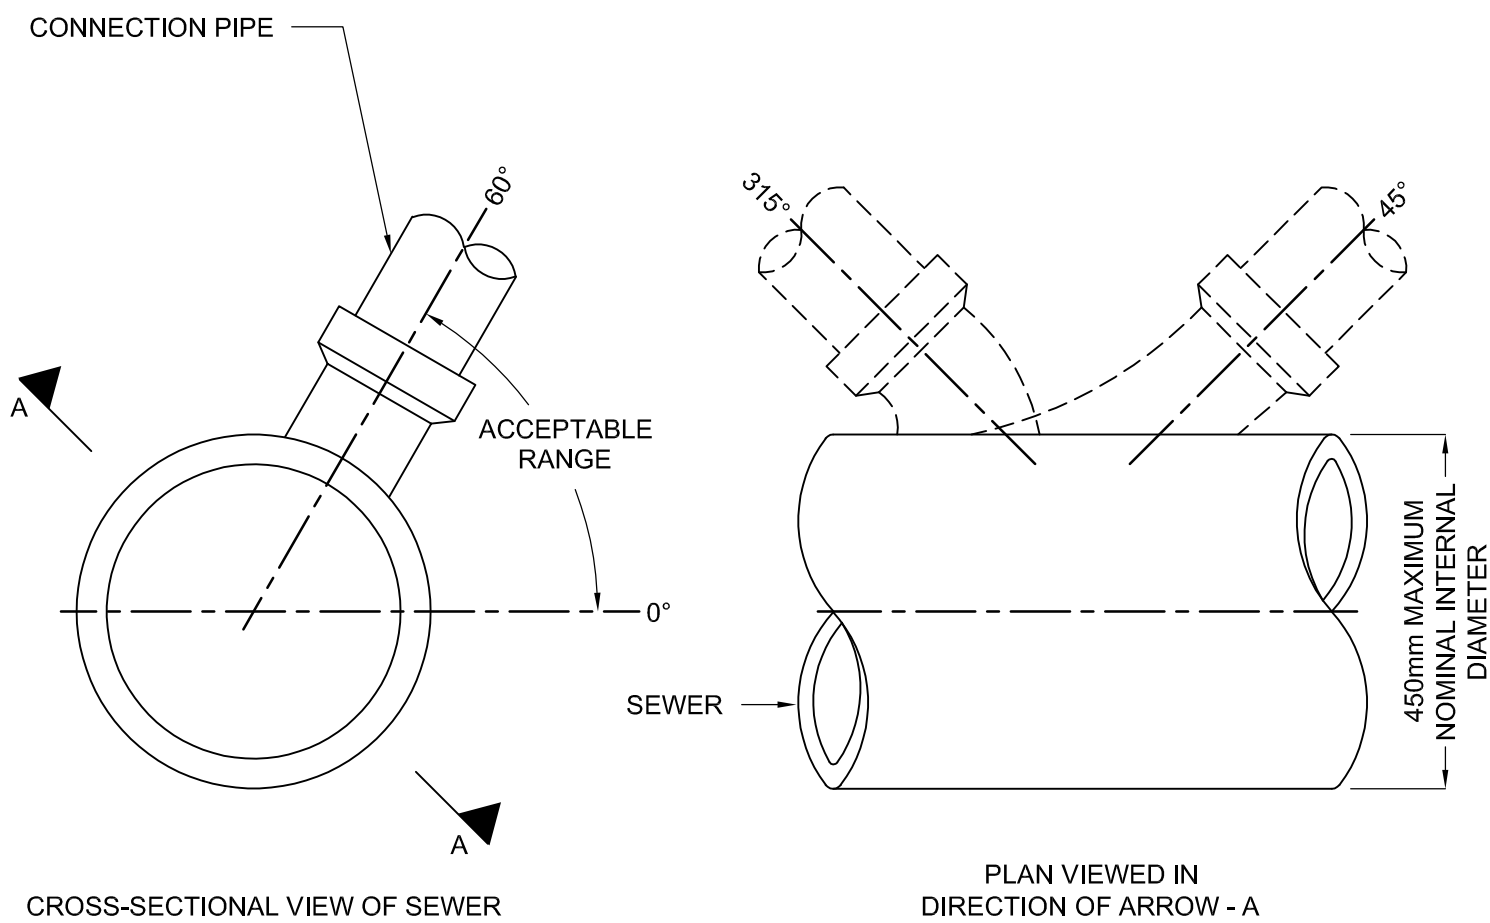

CROSS-SECTIONAL VIEW OF SEWER

PLAN VIEWED IN
DIRECTION OF ARROW - A

KEY PLAN

NOTES

1. All dimensions are to be checked on site before the commencement of works. Any discrepancies are to be reported to the Architect & Engineer for verification. Figured dimensions only are to be taken from this drawing.
2. The DWG file is issued for the purposes of coordination only and do not represent formal drawing issue and are not to be reprinted in any form. Formal issue of drawings is via DWG, Adobe PDF files and/or hard copies and their associated information issue sheets.
3. Note that all care has been taken with the export of DWG files and their content, but we recommend that you make due dimensional checks before using any DWG file information. Any errors found are to be reported to Hydrock immediately.

C03	AS BUILT ISSUE					
	J.SHIMMIN	27/07/21	D.GALLIMORE	27/07/21	J.MAGEE	27/07/21
C02	HEALTH AND SAFETY FILE ISSUE					
	J.SHIMMIN	11/06/21	D.GALLIMORE	11/06/21	M.GRIFFIN	11/06/21
C01	ISSUED FOR CONSTRUCTION					
	D.GALLIMORE	24/07/20	D.GALLIMORE	24/07/20	M.GRIFFIN	24/07/20
P05	ISSUED FOR CONTRACT					
	D.GALLIMORE	04/05/20	D.GALLIMORE	04/05/20	M.GRIFFIN	04/05/20
P04	ISSUED FOR CONTRACT					
	R.HUNT	13/03/20	D.GALLIMORE	13/03/20	M.GRIFFIN	13/03/20
P03	DRAWING TITLE CHANGED					
	R.HUNT	24/02/20	D.GALLIMORE	24/02/20	M.GRIFFIN	24/02/20
P02	TENDER ISSUE					
	R.HUNT	19/02/20	D.GALLIMORE	19/02/20	M.GRIFFIN	19/02/20
P01	TENDER ISSUE					
	R.HUNT	20/12/19	D.GALLIMORE	20/12/19	M.GRIFFIN	20/12/19
REV	REVISION NOTES/COMMENTS					
	DRAWN BY	DATE	CHECKED BY	DATE	APPROVED BY	DATE



CLIENT

LANDLINK ESTATES

PROJECT

SALTBOX
BOGNOR REGIS

TITLE

UNIT 4, 5 AND 8 DRAINAGE DETAILS
SHEET 1

HYDROCK PROJECT NO. C-13319-C		SCALE @ A1 AS SHOWN
STATUS DESCRIPTION AS BUILT ISSUE		STATUS A
DRAWING NO. (PROJECT CODE-ORIGINATOR-ZONE-LEVEL-TYPE-ROLE-NUMBER) SAL-HYD-PH2-ZZ-DR-C-7100		REVISION C03