



HEADWALL 03

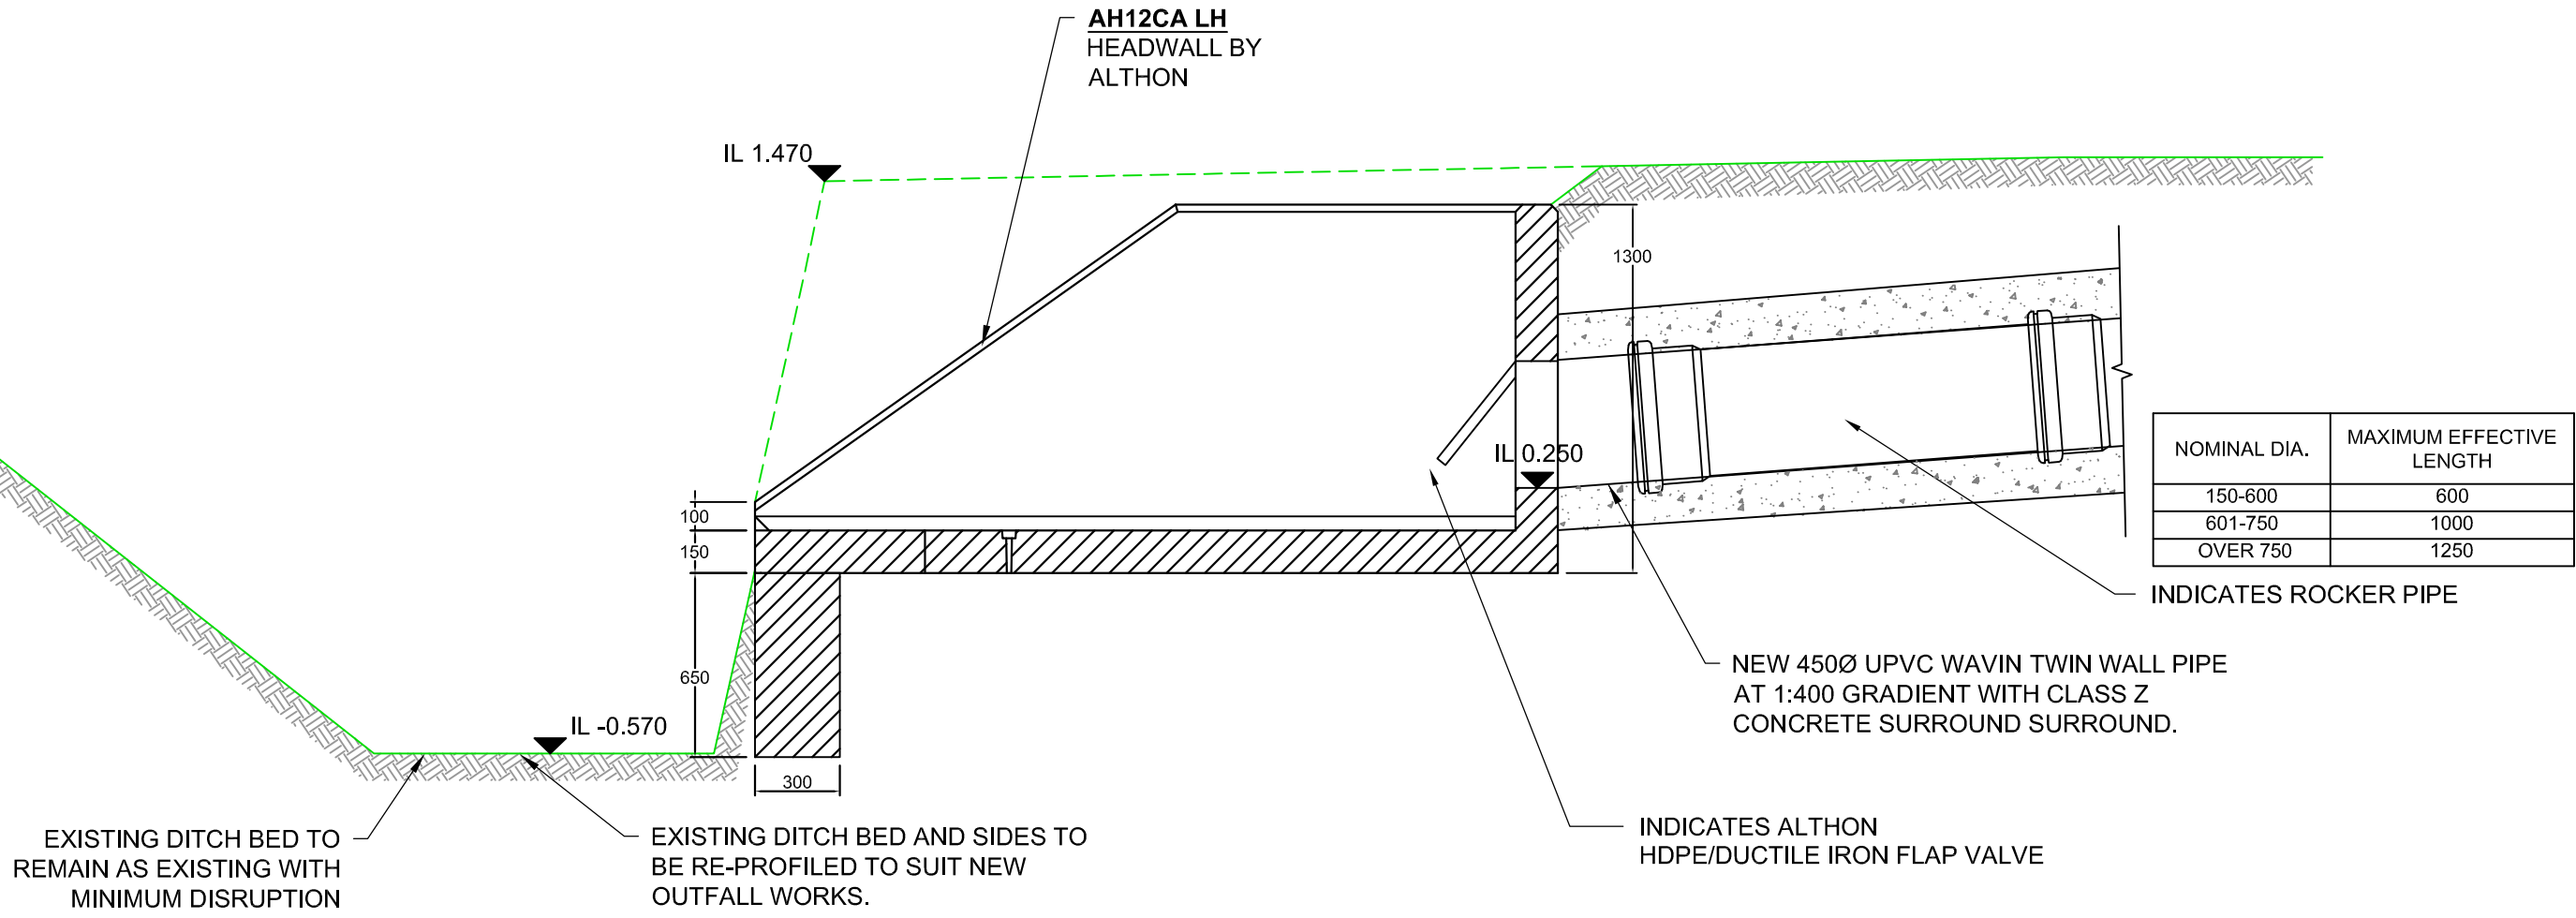

SECTION A-A
SEE DRAWING SBX-KSA-Z0-XX-DR-C-6800
FOR PLAN

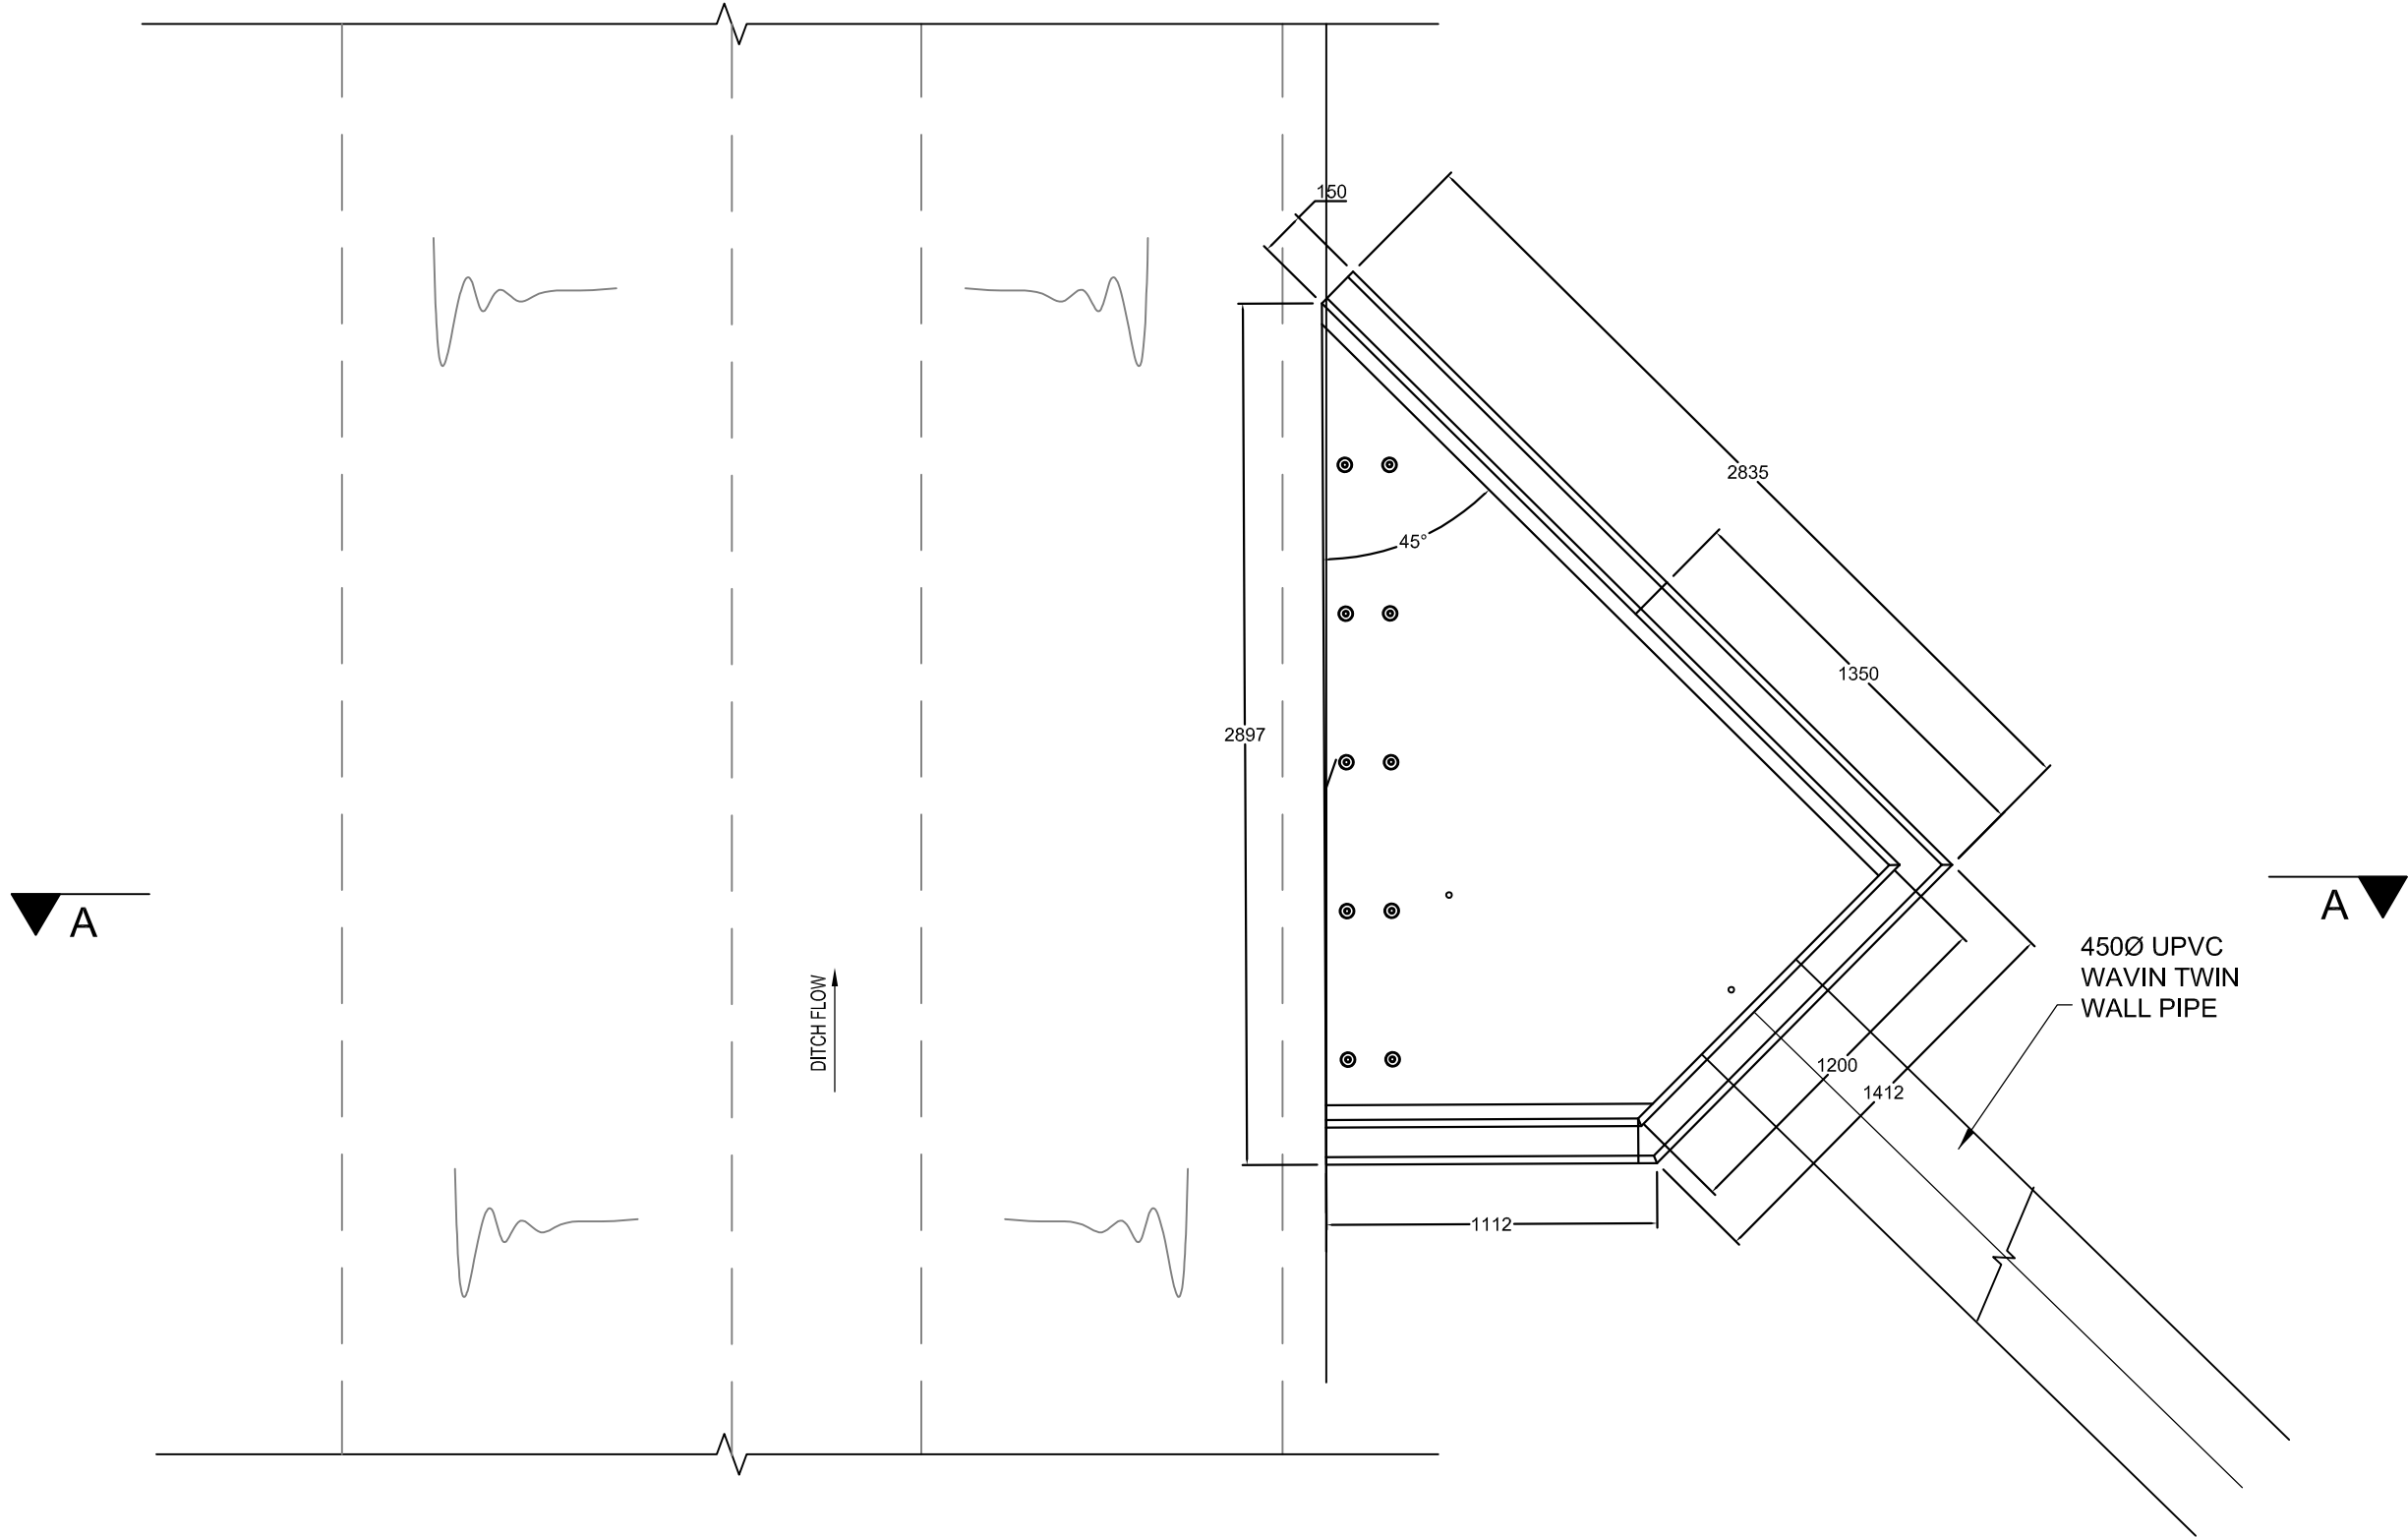

PLAN

KEY PLAN

NOTES

- All dimensions are to be checked on site before the commencement of works. Any discrepancies are to be reported to the Architect & Engineer for verification. Figured dimensions only are to be taken from this drawing.
- The DWG file is issued for the purposes of coordination only and do not represent formal drawing issue and are not to be reprinted in any form. Formal issue of drawings is via DWF, Adobe PDF files and/or hard copies and their associated information issue sheets.
- Note that all care has been taken with the export of DWG files and their content, but we recommend that you make due dimensional checks before using any DWG file information. Any errors found are to be reported to Hydrock immediately.

AS BUILT ISSUE					
C06	J.SHIMMIN	27.07.21	D.GALLIMORE	27.07.21	J. MAGEE
HEALTH AND SAFETY FILE ISSUE					
C05	J.SHIMMIN	11.06.21	D.GALLIMORE	11.06.21	M. GRIFFIN
EROSION BLANKET REMOVED AND HEADWALL DETAIL UPDATED					
C04	D. GALLIMORE	10/02/21	D.GALLIMORE	10/02/21	M. GRIFFIN
REVISED FOLLOWING ARUN COMMENTS					
C03	D. GALLIMORE	16/09/20	D.GALLIMORE	16/09/20	M. GRIFFIN
REVISED FOLLOWING ARUN COMMENTS					
C02	D. GALLIMORE	15/09/20	D.GALLIMORE	15/09/20	M. GRIFFIN
ISSUED FOR CONSTRUCTION					
C01	D. GALLIMORE	24/07/20	D.GALLIMORE	24/07/20	M. GRIFFIN
CONTRACT ISSUE					
P02	D. GALLIMORE	15/05/20	D. GALLIMORE	15/05/20	M.GRIFFIN
CONTRACT ISSUE					
P01	D. GALLIMORE	04/05/20	D. GALLIMORE	04/05/20	M.GRIFFIN
REVISION NOTES/COMMENTS					
REV	DRAWN BY	DATE	CHECKED BY	DATE	APPROVED BY



Merchants' House North
Wapping Road
Bristol
BS1 4RW
t: +44 (0)117 945 9225
e: bristolcentral@hydrock.com

CLIENT	
LANDLINK ESTATES	
PROJECT	
SALTBOX BOGNOR REGIS	
TITLE	
HEADWALL DETAILS	
HYDROCK PROJECT NO. C-13319-C	
SCALE @ A1 1:25	
STATUS DESCRIPTION AS BUILT ISSUE	
STATUS A	
DRAWING NO. (PROJECT CODE-ORIGINATOR-ZONE-LEVEL-TYPE-ROLE-NUMBER) SAL-HYD-PH2-00-ZZ-DR-C-7111	
REVISION C06	