


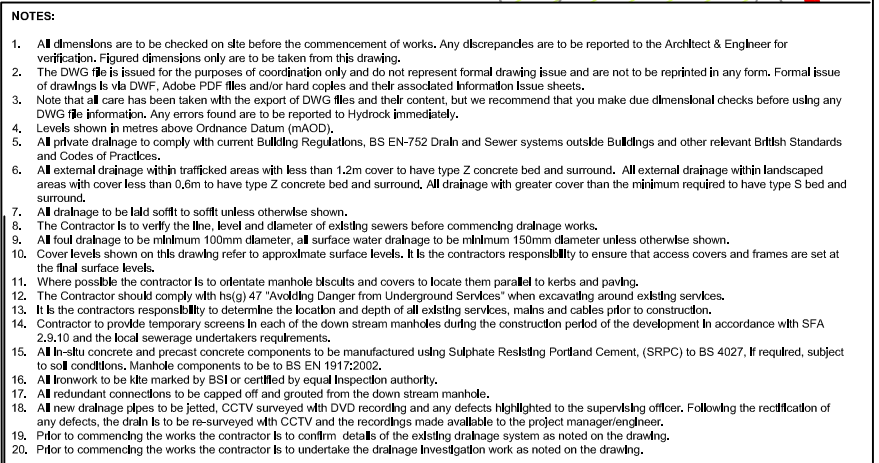


Hydrock  Merchants' House North
Wapping Road
Bristol
BS1 4RW
t: +44 (0)117 945 9225
e: bristolcentral@hydrock.com

PROJECT	SALTBOX BOGNOR REGIS
---------	-------------------------

HYDROCK PROJECT NO. C-13319-C	SCALE @ A1 1:250
----------------------------------	---------------------

STATUS DESCRIPTION	STATUS
AS BUILT ISSUE	A1
DRAWING NO. (PROJECT CODE-ORIGINATOR-ZONE-LEVEL-TYPE-ROLE-NUMBER)	REVISION
SAL-HYD-PH1-ZZ-DR-C-7021	C08

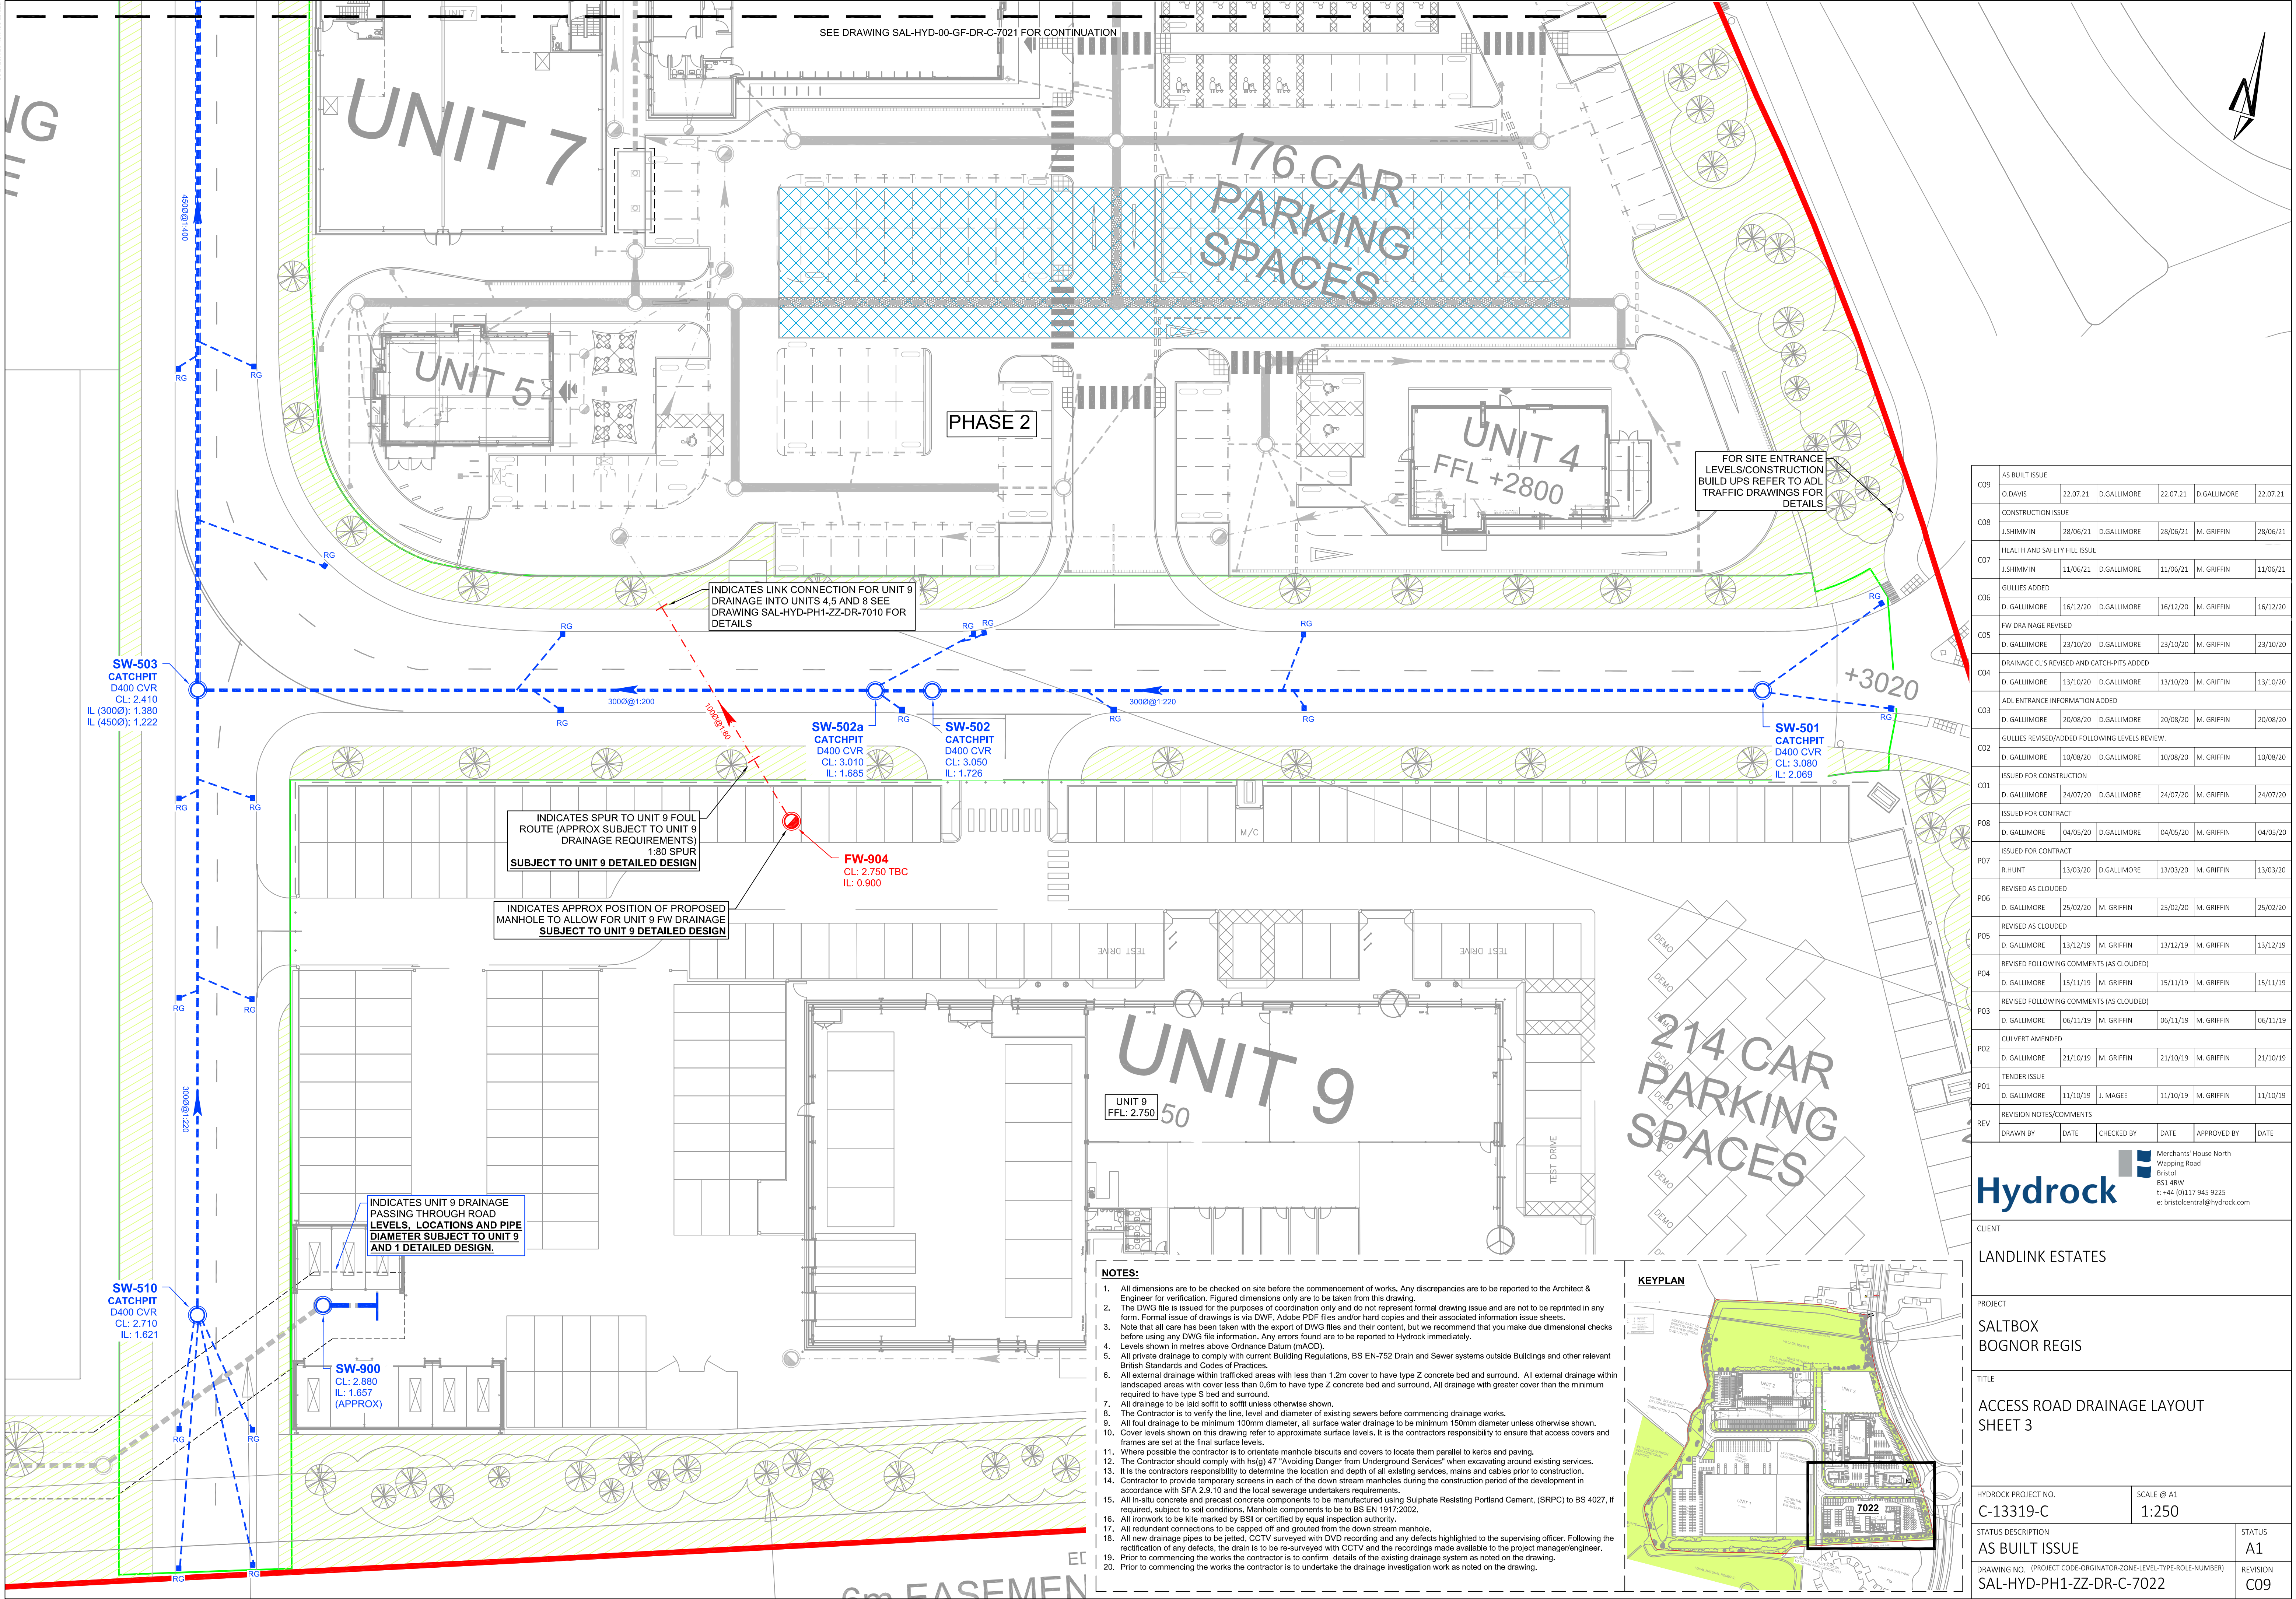

CD9	AS BUILT ISSUE					
	O.DAVIS	22.07.21	D.GALLIMORE	22.07.21	D.GALLIMORE	22.07.21
CD8	CONSTRUCTION ISSUE					
	J.SHIMMIN	28/06/21	D.GALLIMORE	28/06/21	M. GRIFFIN	28/06/21
CD7	HEALTH AND SAFETY FILE ISSUE					
	J.SHIMMIN	11/06/21	D.GALLIMORE	11/06/21	M. GRIFFIN	11/06/21
CD6	GULLIES ADDED					
	D. GALLIMORE	16/12/20	D.GALLIMORE	16/12/20	M. GRIFFIN	16/12/20
CD5	FW DRAINAGE REVISED					
	D. GALLIMORE	23/10/20	D.GALLIMORE	23/10/20	M. GRIFFIN	23/10/20
CD4	DRAINAGE CL'S REVISED AND CATCH-PITS ADDED					
	D. GALLIMORE	13/10/20	D.GALLIMORE	13/10/20	M. GRIFFIN	13/10/20
CD3	ADL ENTRANCE INFORMATION ADDED					
	D. GALLIMORE	20/08/20	D.GALLIMORE	20/08/20	M. GRIFFIN	20/08/20
CD2	GULLIES REVISED/ADDED FOLLOWING LEVELS REVIEW.					
	D. GALLIMORE	10/08/20	D.GALLIMORE	10/08/20	M. GRIFFIN	10/08/20
CD1	ISSUED FOR CONSTRUCTION					
	D. GALLIMORE	24/07/20	D.GALLIMORE	24/07/20	M. GRIFFIN	24/07/20
PO8	ISSUED FOR CONTRACT					
	D. GALLIMORE	04/05/20	D.GALLIMORE	04/05/20	M. GRIFFIN	04/05/20
PO7	ISSUED FOR CONTRACT					
	R.HUNT	13/03/20	D.GALLIMORE	13/03/20	M. GRIFFIN	13/03/20
PO6	REVISED AS CLOUDED					
	D. GALLIMORE	25/02/20	M. GRIFFIN	25/02/20	M. GRIFFIN	25/02/20
PO5	REVISED AS CLOUDED					
	D. GALLIMORE	13/12/19	M. GRIFFIN	13/12/19	M. GRIFFIN	13/12/19
PO4	REVISED FOLLOWING COMMENTS (AS CLOUDED)					
	D. GALLIMORE	15/11/19	M. GRIFFIN	15/11/19	M. GRIFFIN	15/11/19
PO3	REVISED FOLLOWING COMMENTS (AS CLOUDED)					
	D. GALLIMORE	06/11/19	M. GRIFFIN	06/11/19	M. GRIFFIN	06/11/19
PO2	CULVERT AMENDED					
	D. GALLIMORE	21/10/19	M. GRIFFIN	21/10/19	M. GRIFFIN	21/10/19
PO1	TENDER ISSUE					
	D. GALLIMORE	11/10/19	J. MAGEE	11/10/19	M. GRIFFIN	11/10/19
REV	REVISION NOTES/COMMENTS					
DRAWN BY	DATE	CHECKED BY	DATE	APPROVED BY	DATE	

Merchants' House North
Wapping Road
Bristol
BS1 4RW
t: +44 (0)117 945 9225
e: bristolcentral@hydrock.com

CLIENT

LANDLINK ESTATES

PROJECT

SALTBOX
BOGNOR REGIS

TITLE

ACCESS ROAD DRAINAGE LAYOUT
SHEET 3

HYDROCK PROJECT NO.
C-13319-C



SCALE @ A1
1:250

STATUS DESCRIPTION
AS BUILT ISSUE

DRAWING NO. (PROJECT CODE-ORIGINATOR-ZONE-LEVEL-TYPE-ROLE-NUMBER)
SAL-HYD-PH1-ZZ-DR-C-7022


STATUS
A1

REVISION
C09

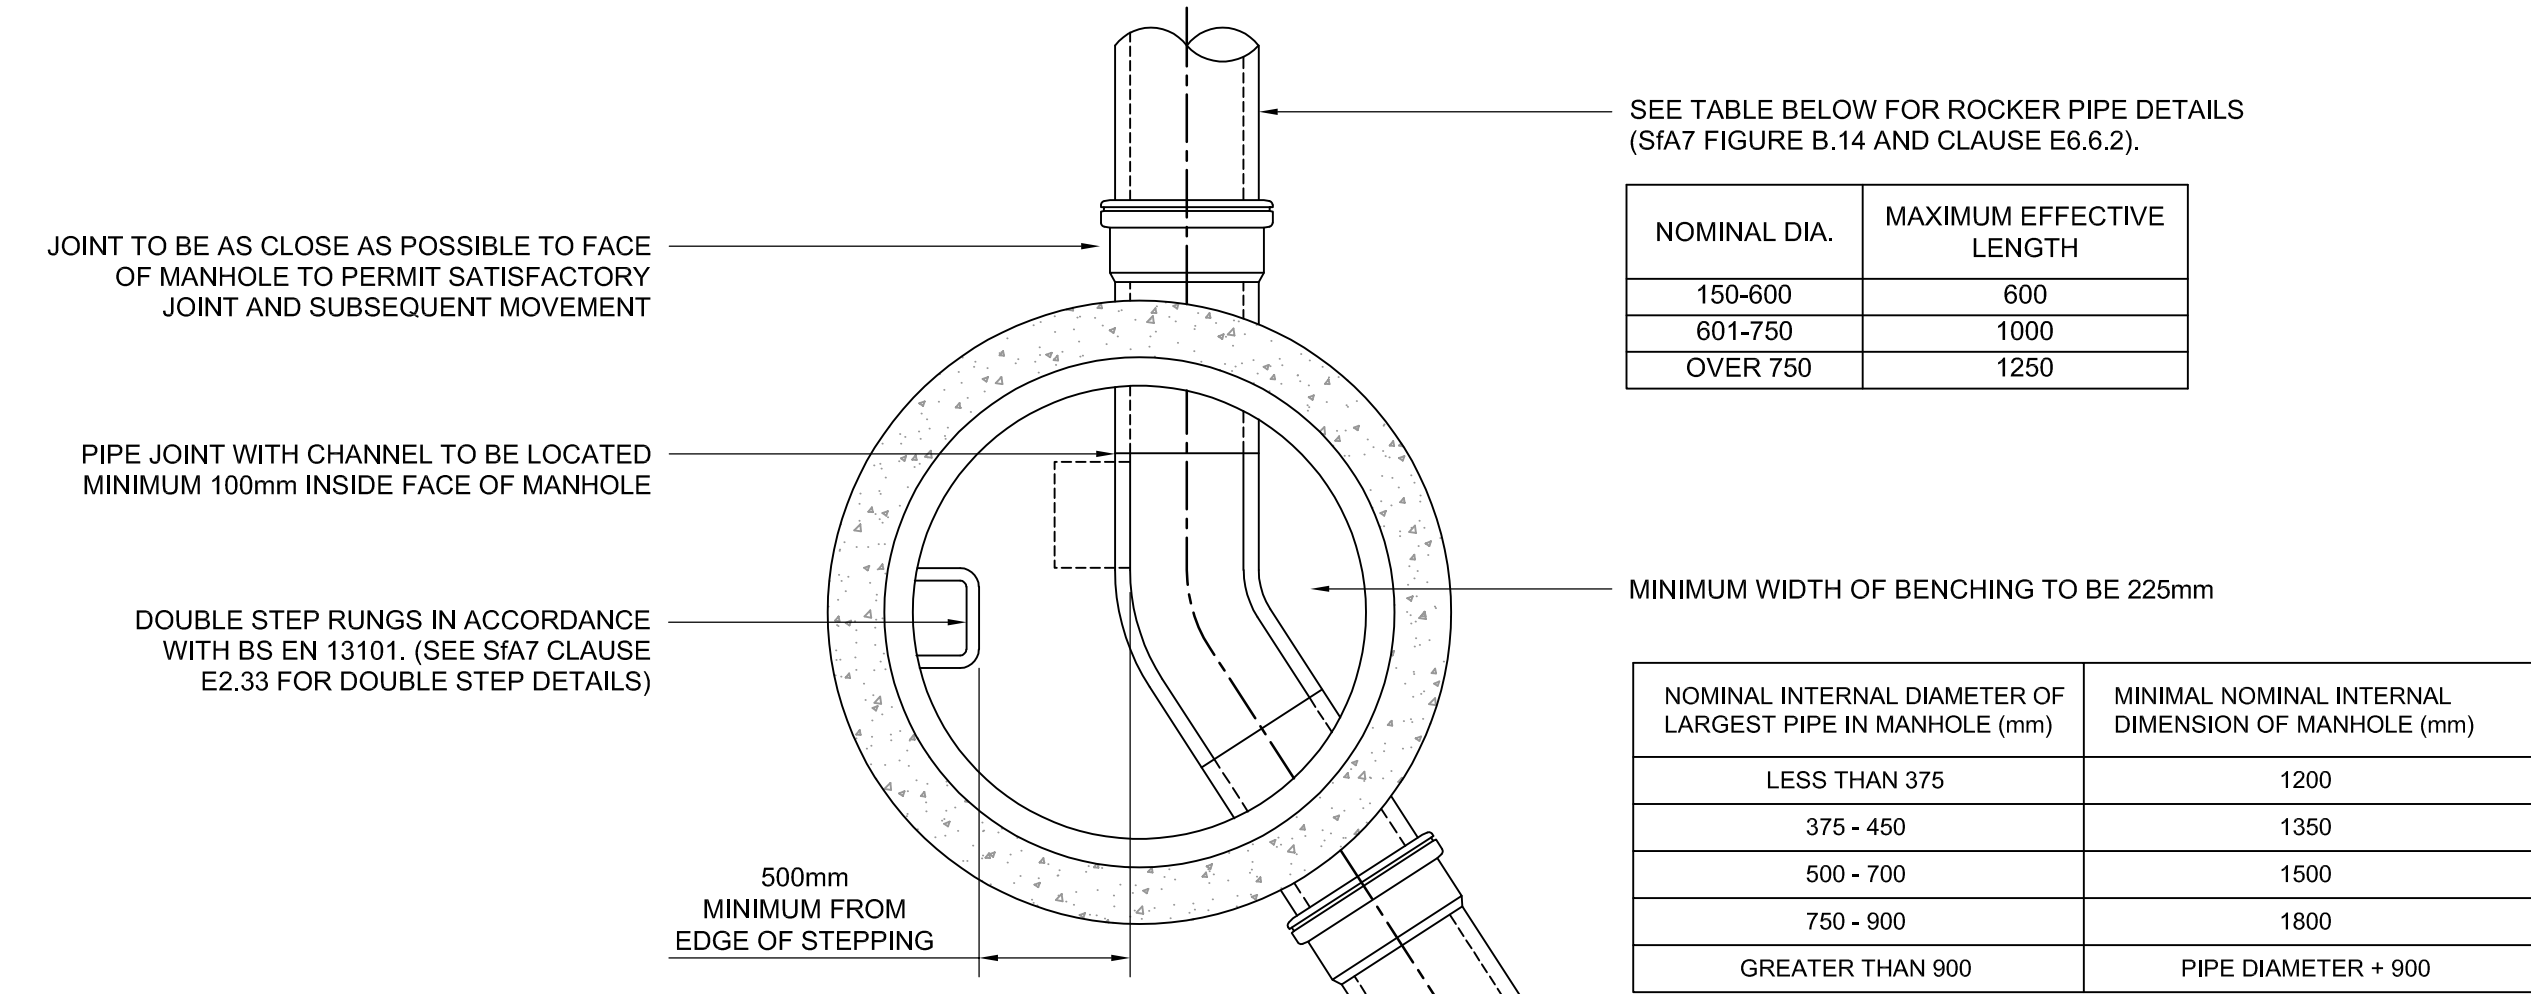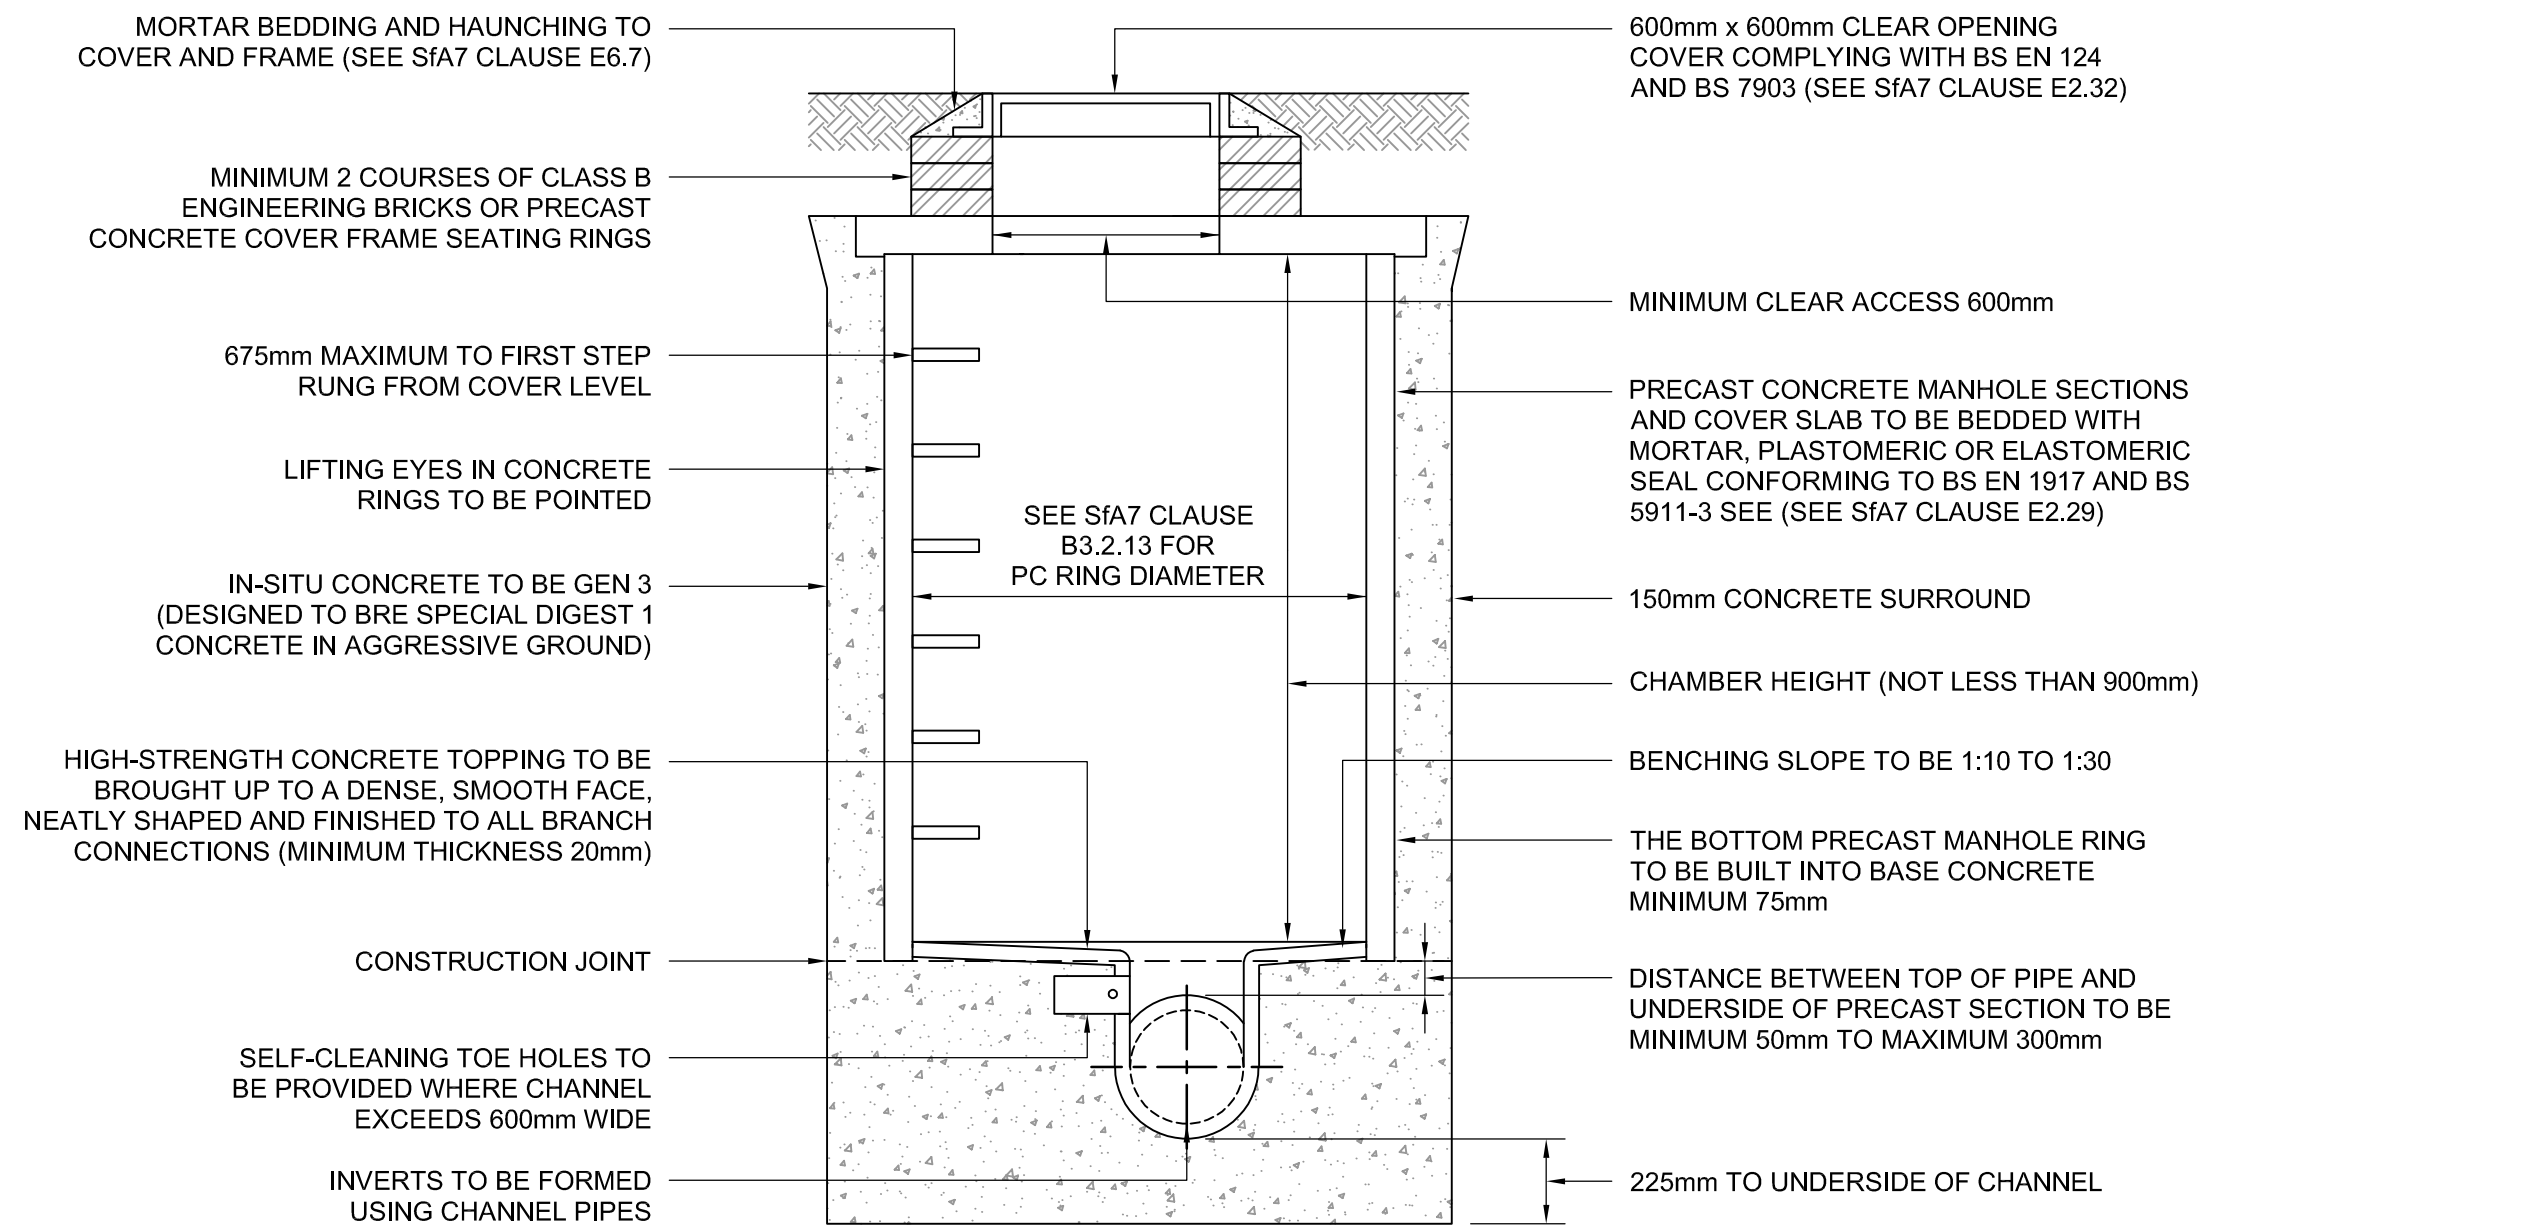


TYPICAL MANHOLE DETAIL - TYPE 2

SCALE 1:20
MAXIMUM DEPTH FROM COVER LEVEL TO SOFFIT OF PIPE 3.0m

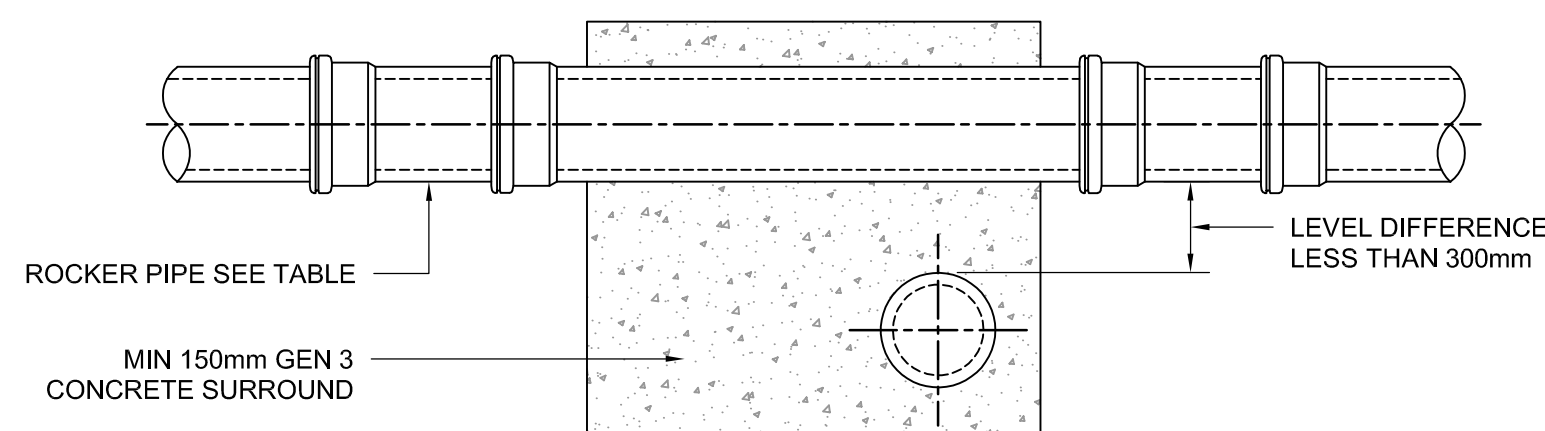

SECTION A-A

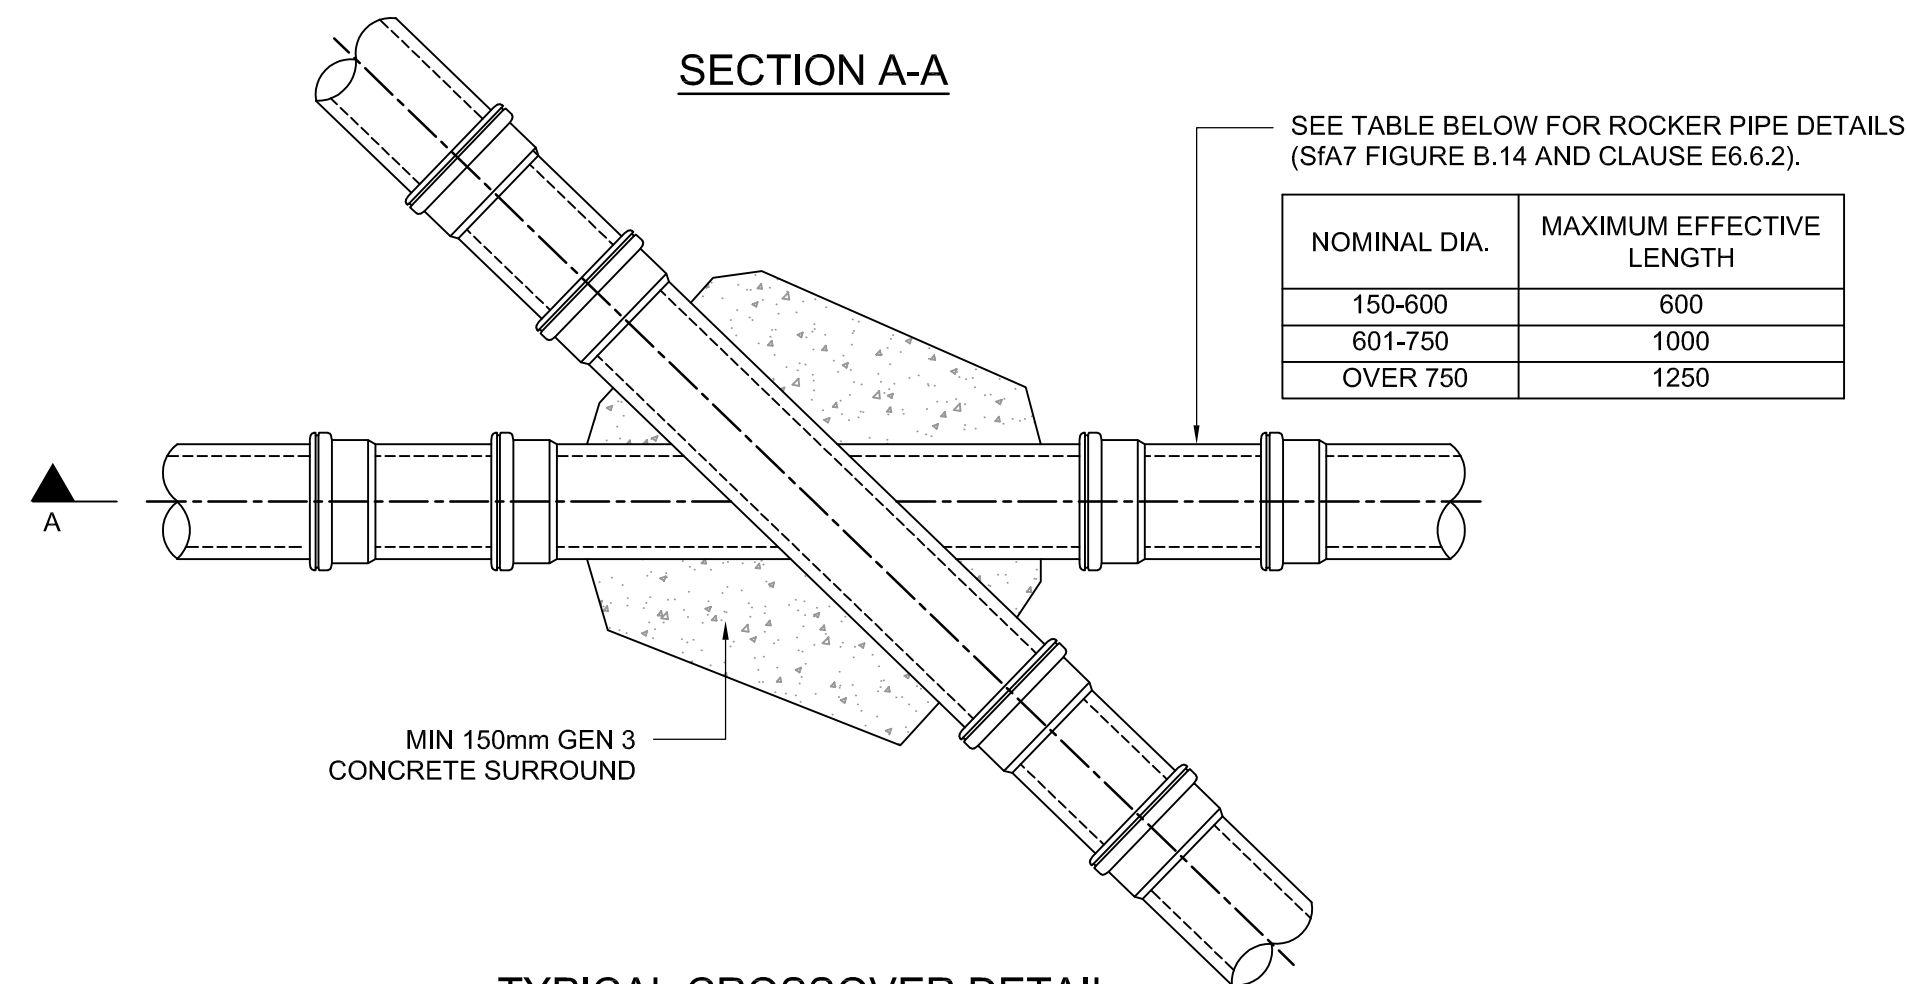


TYPICAL CROSSOVER DETAIL

SCALE 1:25


PIPES BUILT INTO MANHOLE SHOULD HAVE A FLEXIBLE JOINT AS CLOSE AS FEASIBLE TO THE EXTERNAL FACE OF THE STRUCTURE AND THE LENGTH OF THE NEXT ROCKER PIPE SHOULD BE AS SHOWN.

NOMINAL DIA.	MAXIMUM EFFECTIVE LENGTH
150-600	600
601-750	1000
OVER 750	1250

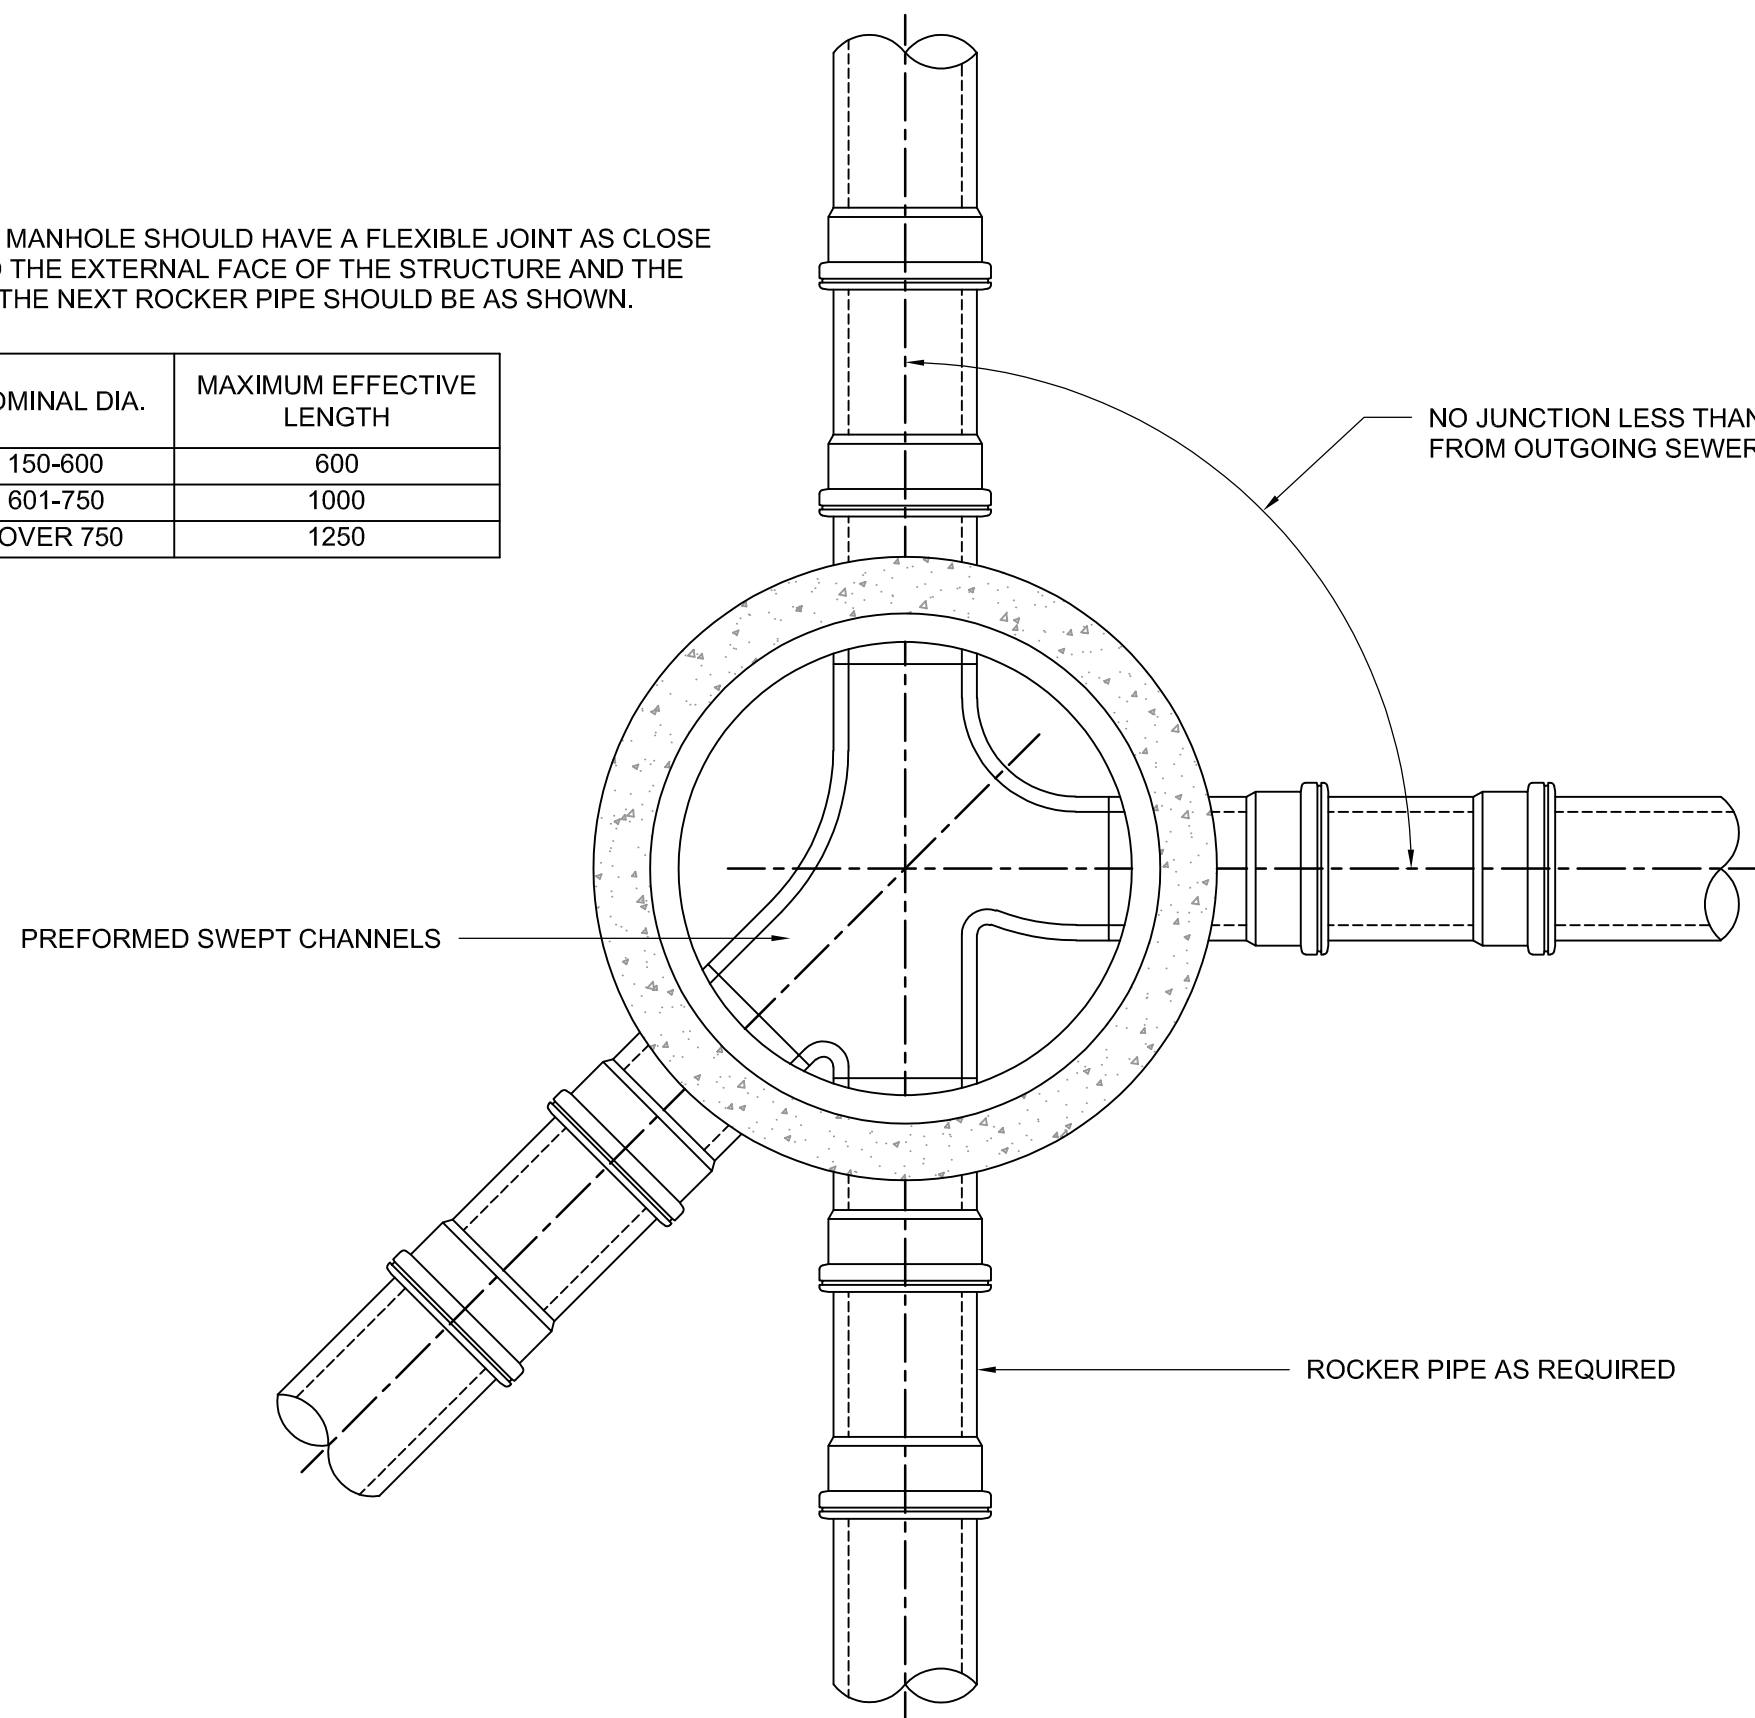


TYPICAL ARRANGEMENT OF PIPE JUNCTIONS WITHIN MANHOLES

SCALE 1:20

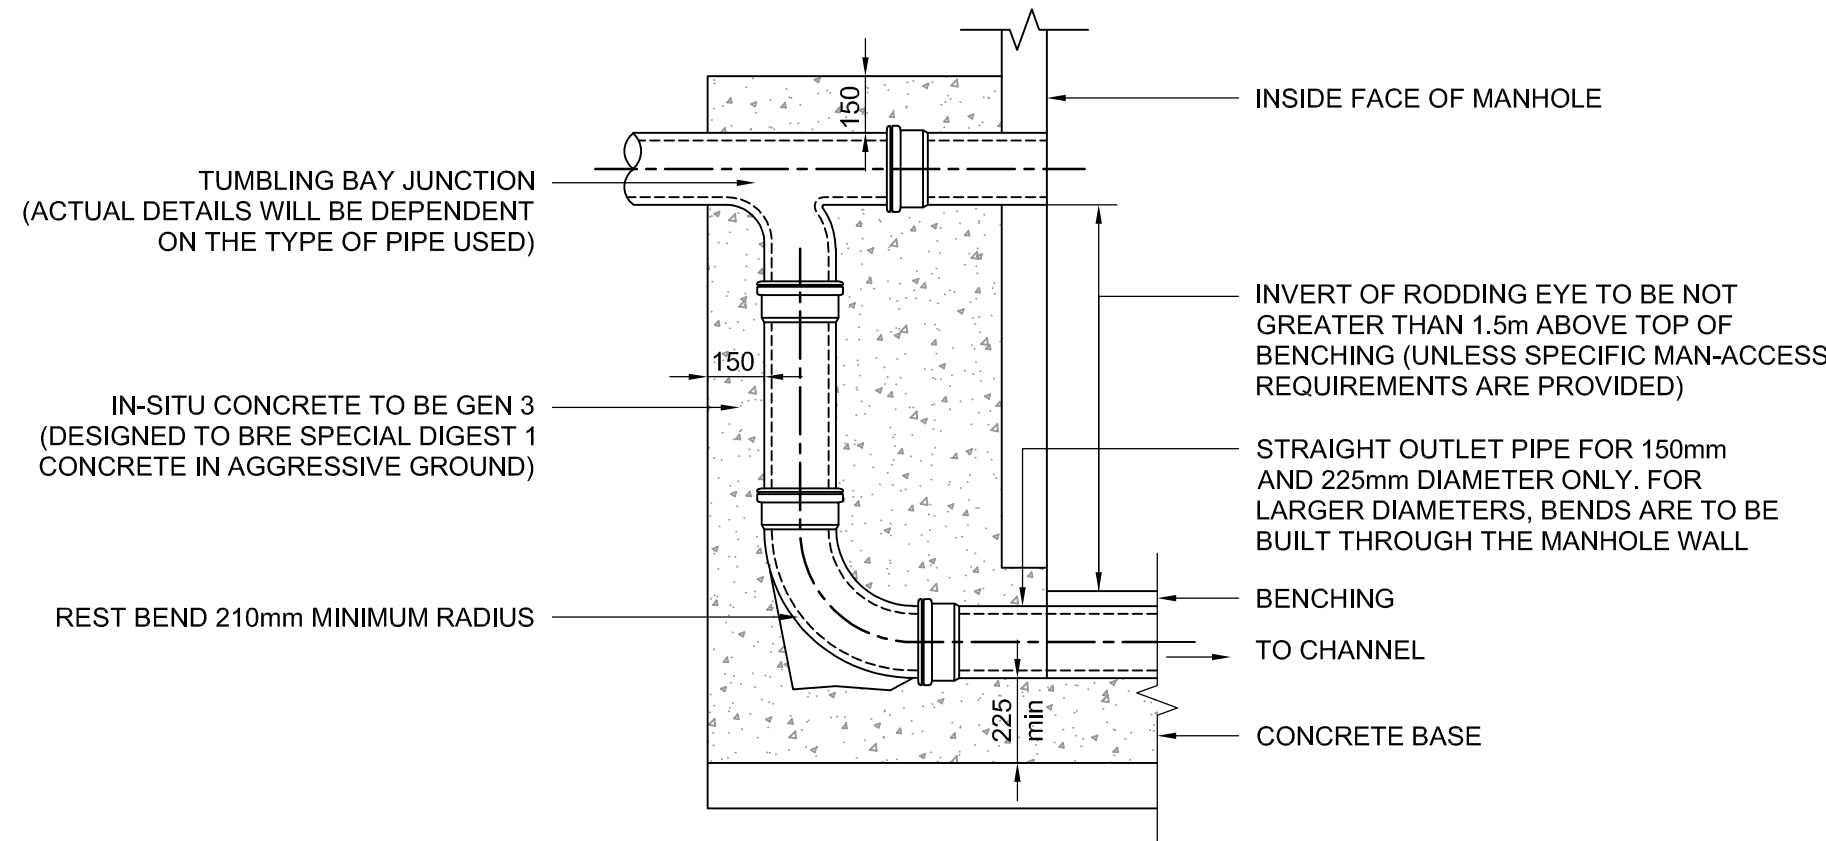

EXTERNAL VERTICAL BACKDROP

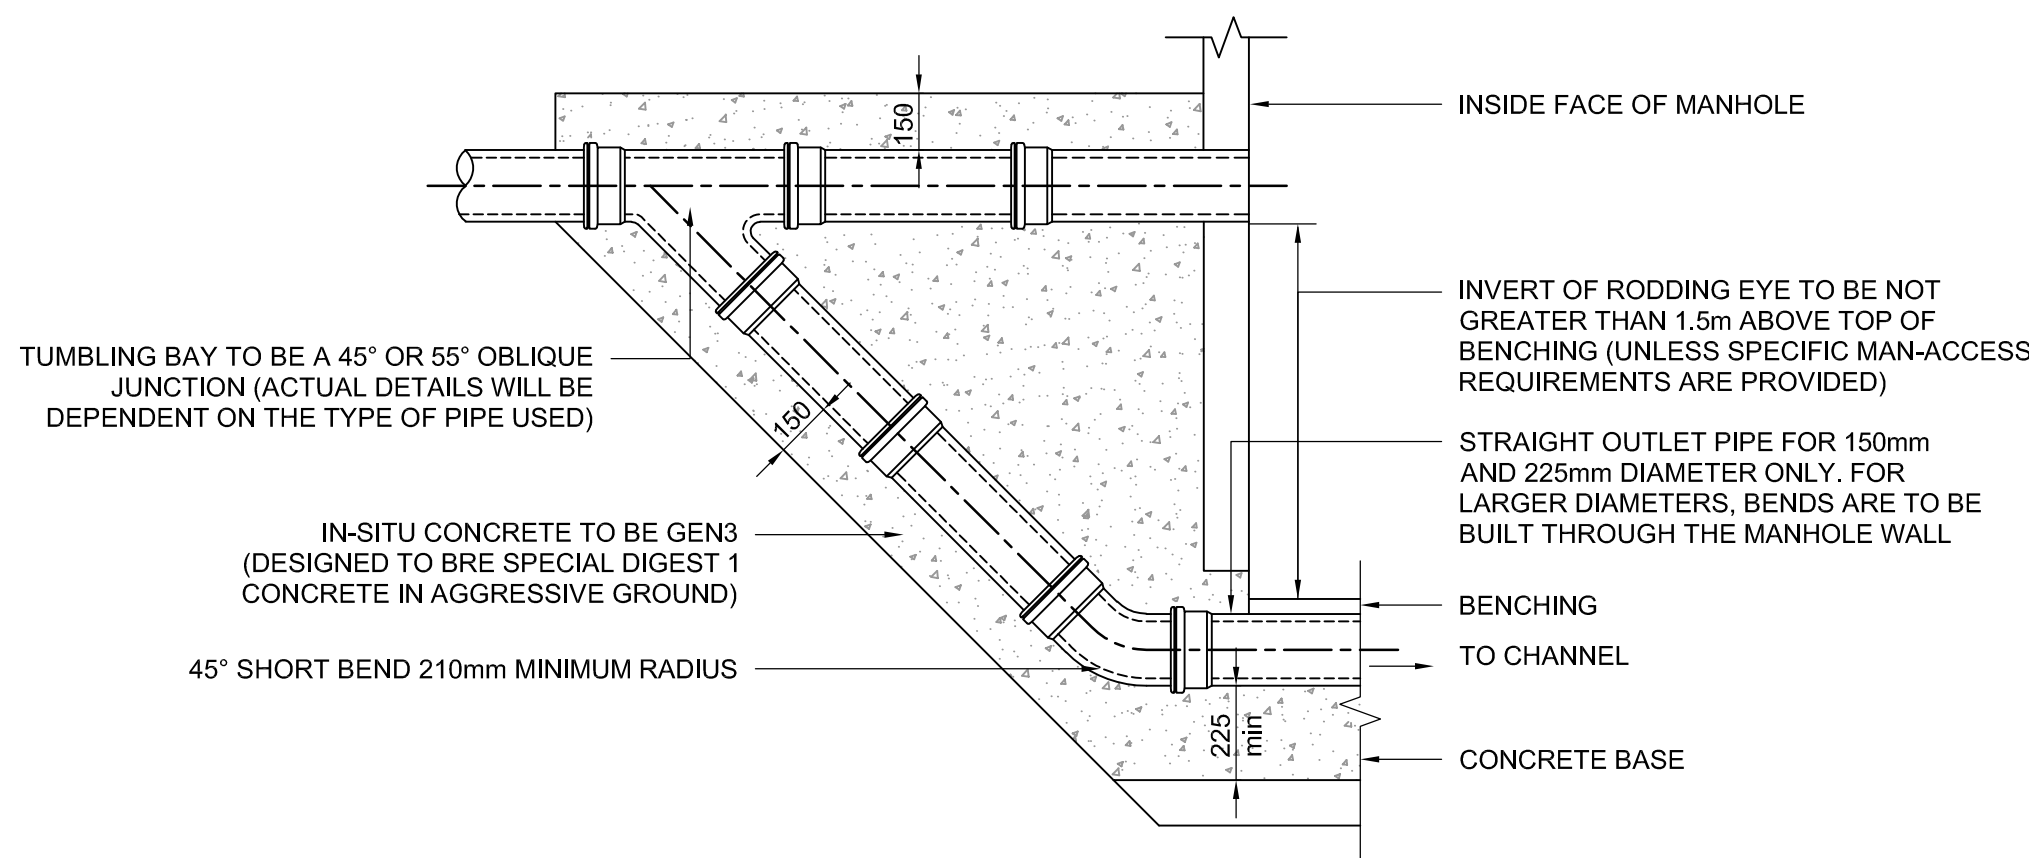

EXTERNAL RAMPED BACKDROP

NOTE: STEEPER GRADIENTS ARE PREFERRED TO THE USE OF BACKDROPS. TYPE OF BACKDROP TO BE USED TO BE AGREED WITH UNDERTAKER.

TYPICAL VERTICAL AND RAMPED BACKDROP DETAIL

SCALE 1:20

KEY PLAN

NOTES

- All dimensions are to be checked on site before the commencement of works. Any discrepancies are to be reported to the Architect & Engineer for verification. Figured dimensions only are to be taken from this drawing.
- The DWG file is issued for the purposes of coordination only and do not represent formal drawing issue and are not to be reprinted in any form. Formal issue of drawings is via DWF, Adobe PDF files and/or hard copies and their associated information issue sheets.
- Note that all care has been taken with the export of DWG files and their content, but we recommend that you make due dimensional checks before using any DWG file information. Any errors found are to be reported to Hydrock immediately.

C04	AS BUILT ISSUE	O.DAVIS	22.07.21	D.GALLIMORE	22.07.21	D.GALLIMORE	22.07.21
-----	----------------	---------	----------	-------------	----------	-------------	----------

C03	HEALTH AND SAFETY FILE ISSUE	J.SHIMMIN	11.06.21	D.GALLIMORE	11.06.21	M.GRIFFIN	11.06.21
-----	------------------------------	-----------	----------	-------------	----------	-----------	----------

C02	AS BUILT ISSUE	J.SHIMMIN	NYI	D.GALLIMORE	NYI	M.GRIFFIN	NYI
-----	----------------	-----------	-----	-------------	-----	-----------	-----

C01	ISSUED FOR CONSTRUCTION	D.GALLIMORE	24/07/20	D.GALLIMORE	24/07/20	M.GRIFFIN	24/07/20
-----	-------------------------	-------------	----------	-------------	----------	-----------	----------

P03	ISSUED FOR CONTRACT	R.HUNT	13/03/20	D.GALLIMORE	13/03/20	M.GRIFFIN	13/03/20
-----	---------------------	--------	----------	-------------	----------	-----------	----------

P02	REVISED FOLLOWING COMMENTS (AS CLOUDED)	D.GALLIMORE	06/11/19	M.GRIFFIN	06/11/19	M.GRIFFIN	06/11/19
-----	---	-------------	----------	-----------	----------	-----------	----------

P01	TENDER ISSUE	R.HUNT	11/10/19	D.GALLIMORE	11/10/19	M.GRIFFIN	11/10/19
-----	--------------	--------	----------	-------------	----------	-----------	----------

REV	REVISION NOTES/COMMENTS	DRAWN BY	DATE	CHECKED BY	DATE	APPROVED BY	DATE
-----	-------------------------	----------	------	------------	------	-------------	------

Merchants' House North
Wapping Road
Bristol
BS1 4RW
t: +44 (0)117 945 9225
e: bristolcentral@hydrock.com

CLIENT
LANDLINK ESTATES

PROJECT
SALTBOX BOGNOR REGIS

TITLE
DRAINAGE DETAILS SHEET 1

HYDROCK PROJECT NO. C-13319-C	SCALE @ A1 AS SHOWN
----------------------------------	------------------------

STATUS DESCRIPTION AS BUILT ISSUE	STATUS A
--------------------------------------	-------------

DRAWING NO. (PROJECT CODE-ORIGINATOR-ZONE-LEVEL-TYPE-ROLE-NUMBER) SAL-HYD-00-ZZ-DR-C-7100	REVISION C04
--	-----------------

