




MAN DISTRICT COUNCIL INFORMATION

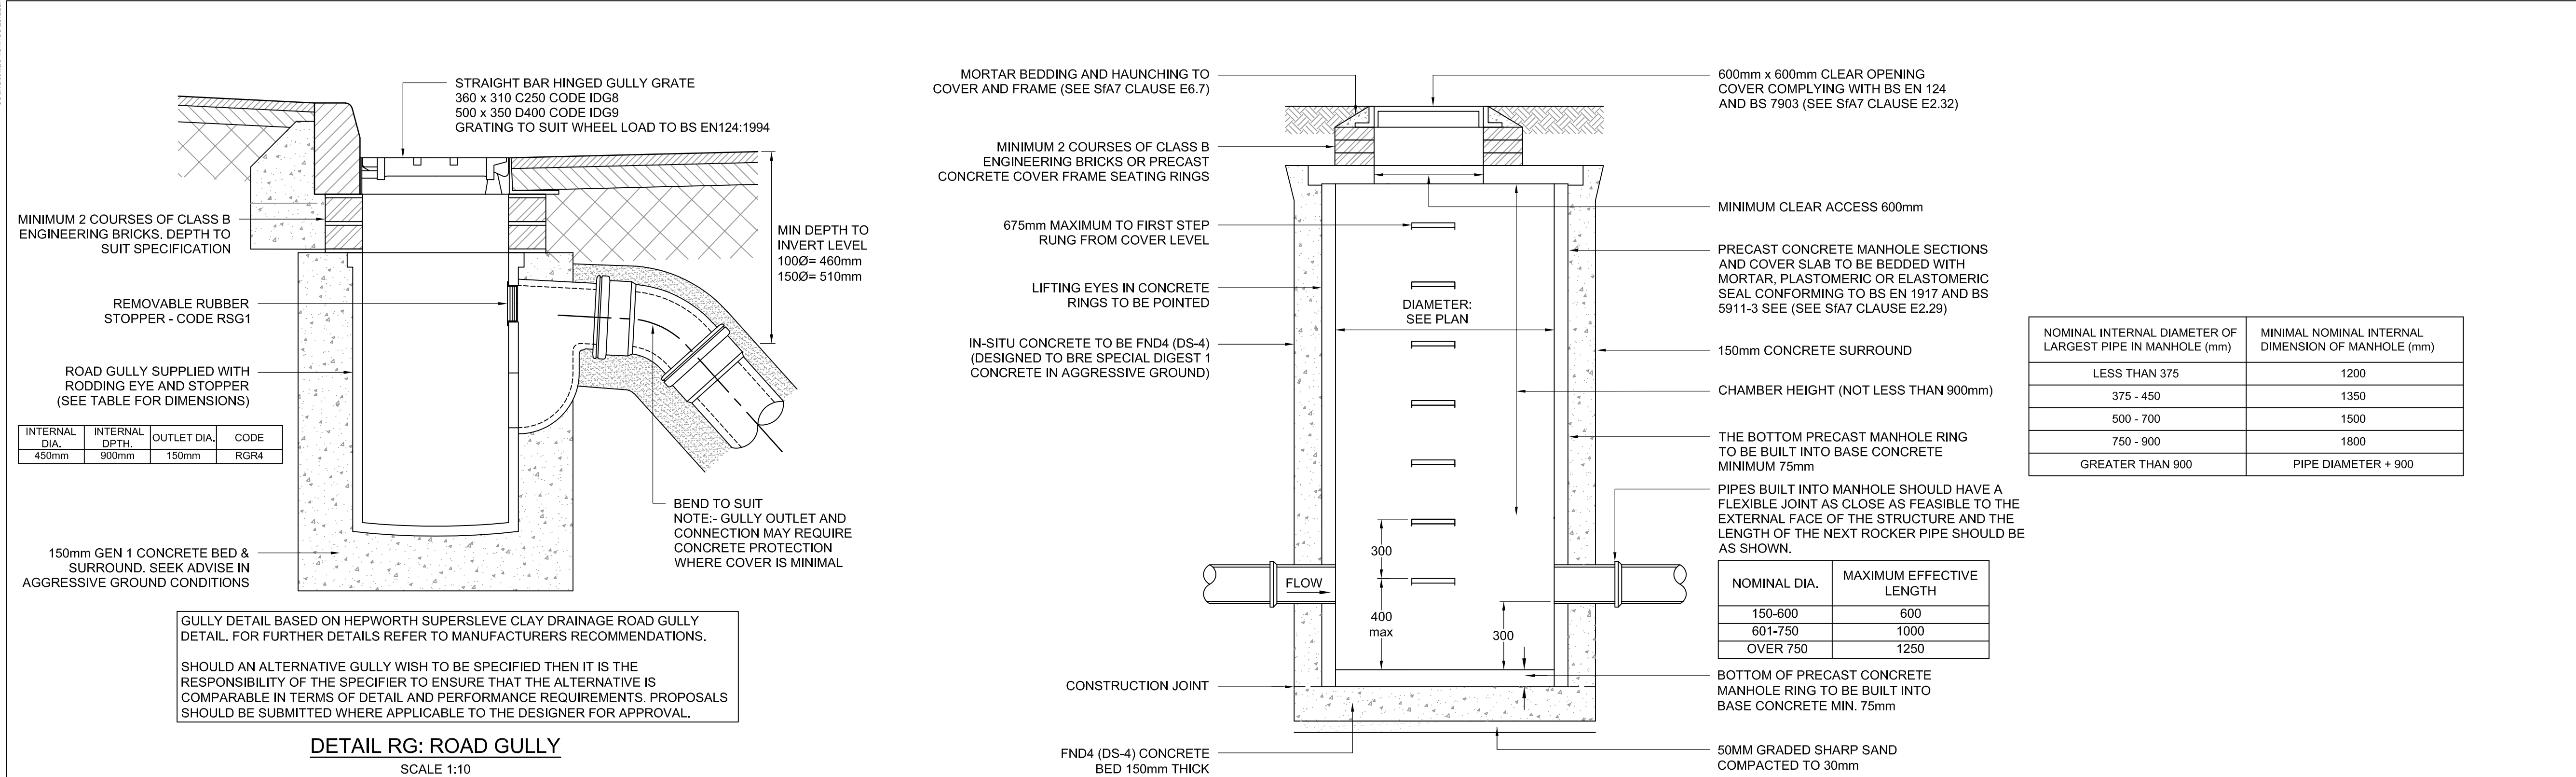


DETAIL RG: ROAD GULLY
SCALE 1:10

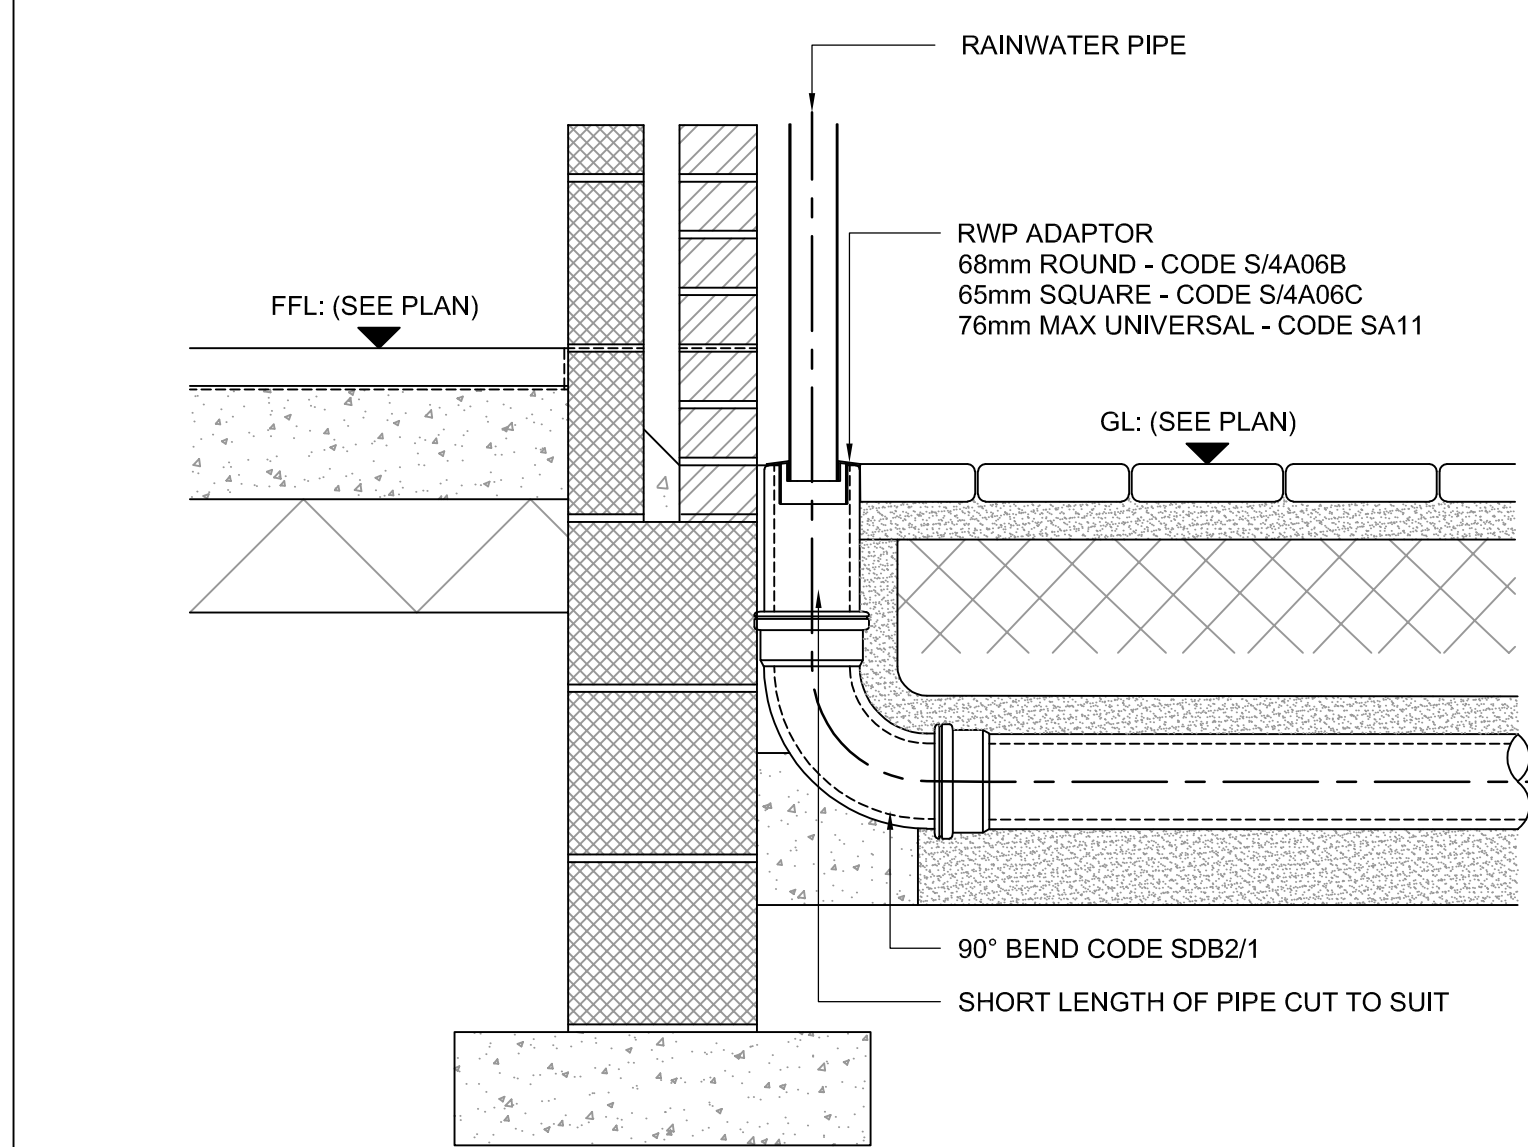


TYPICAL EXTERNAL RAINWATER PIPE 01 & 01A
SCALE 1:10

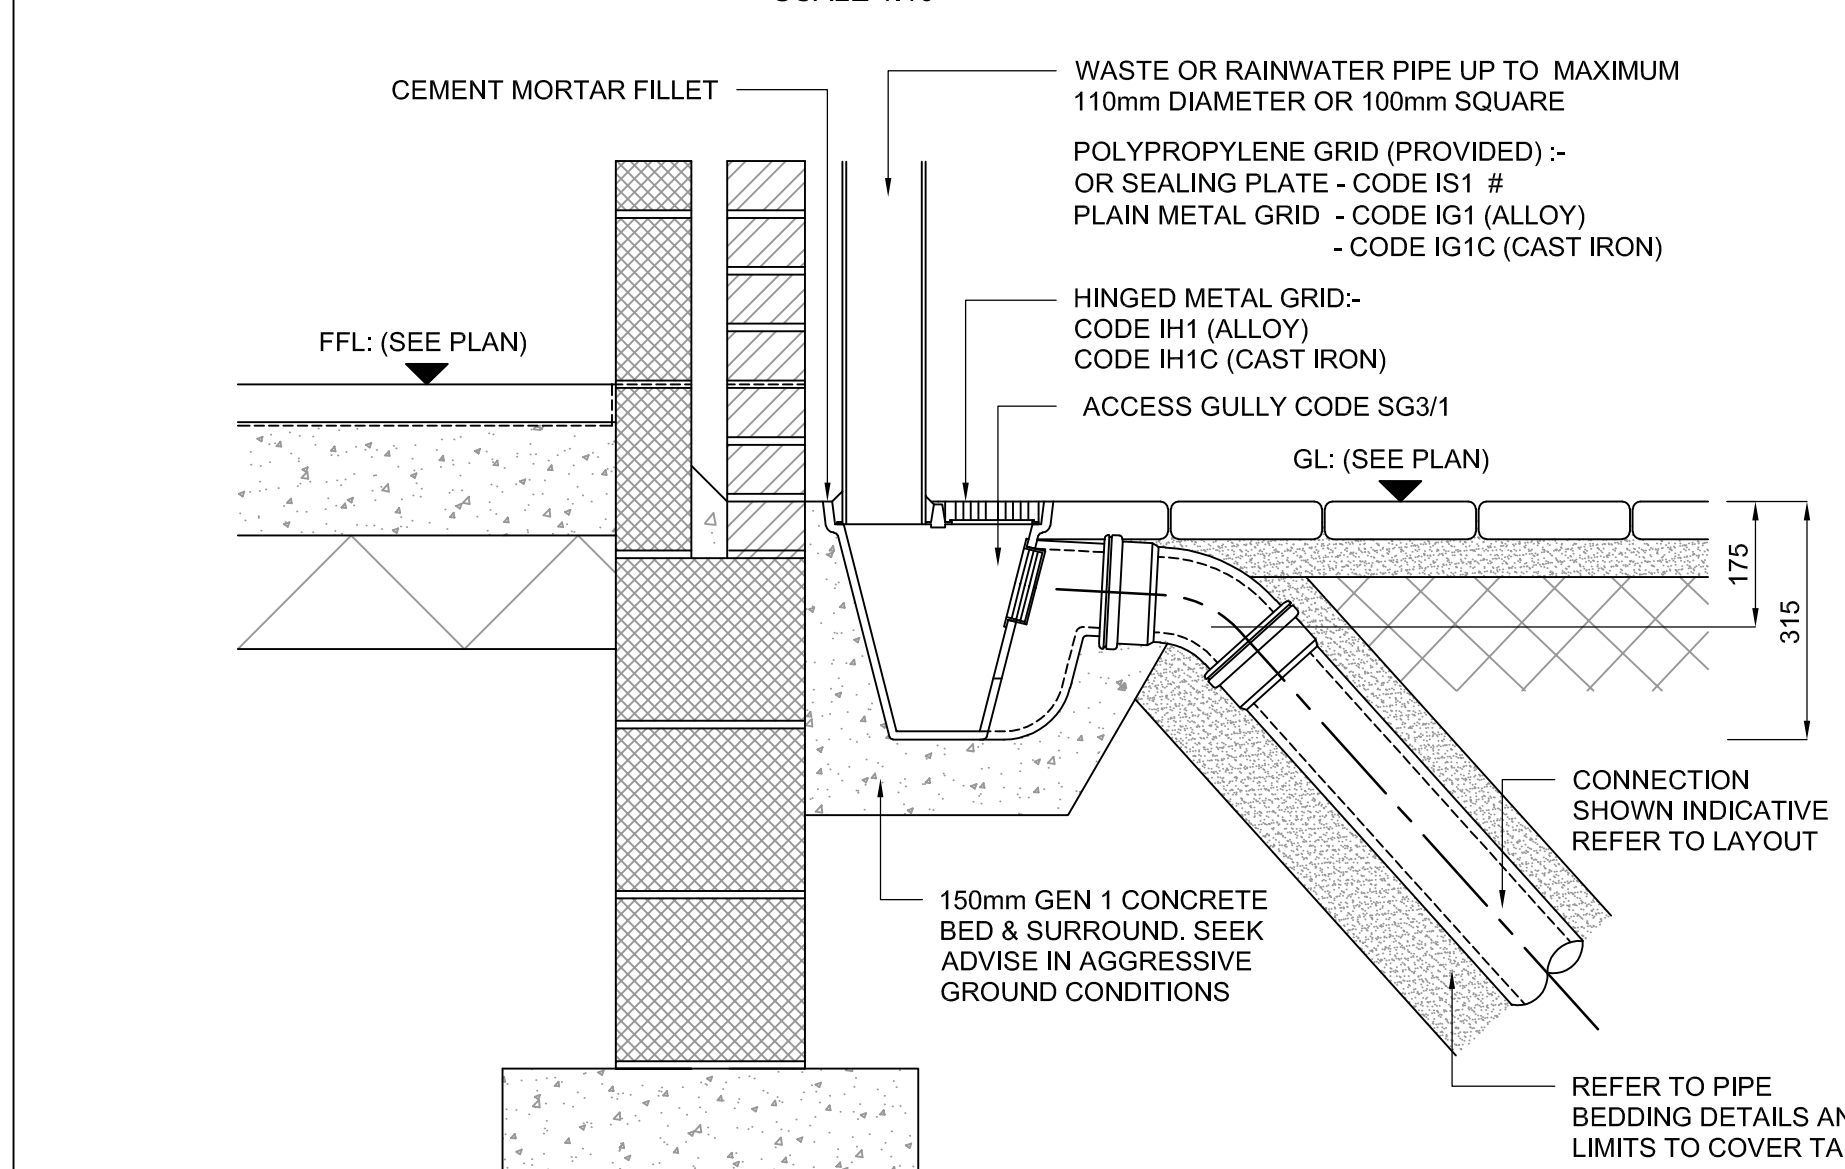


DETAIL AG: ACCESS GULLY
SCALE 1:10

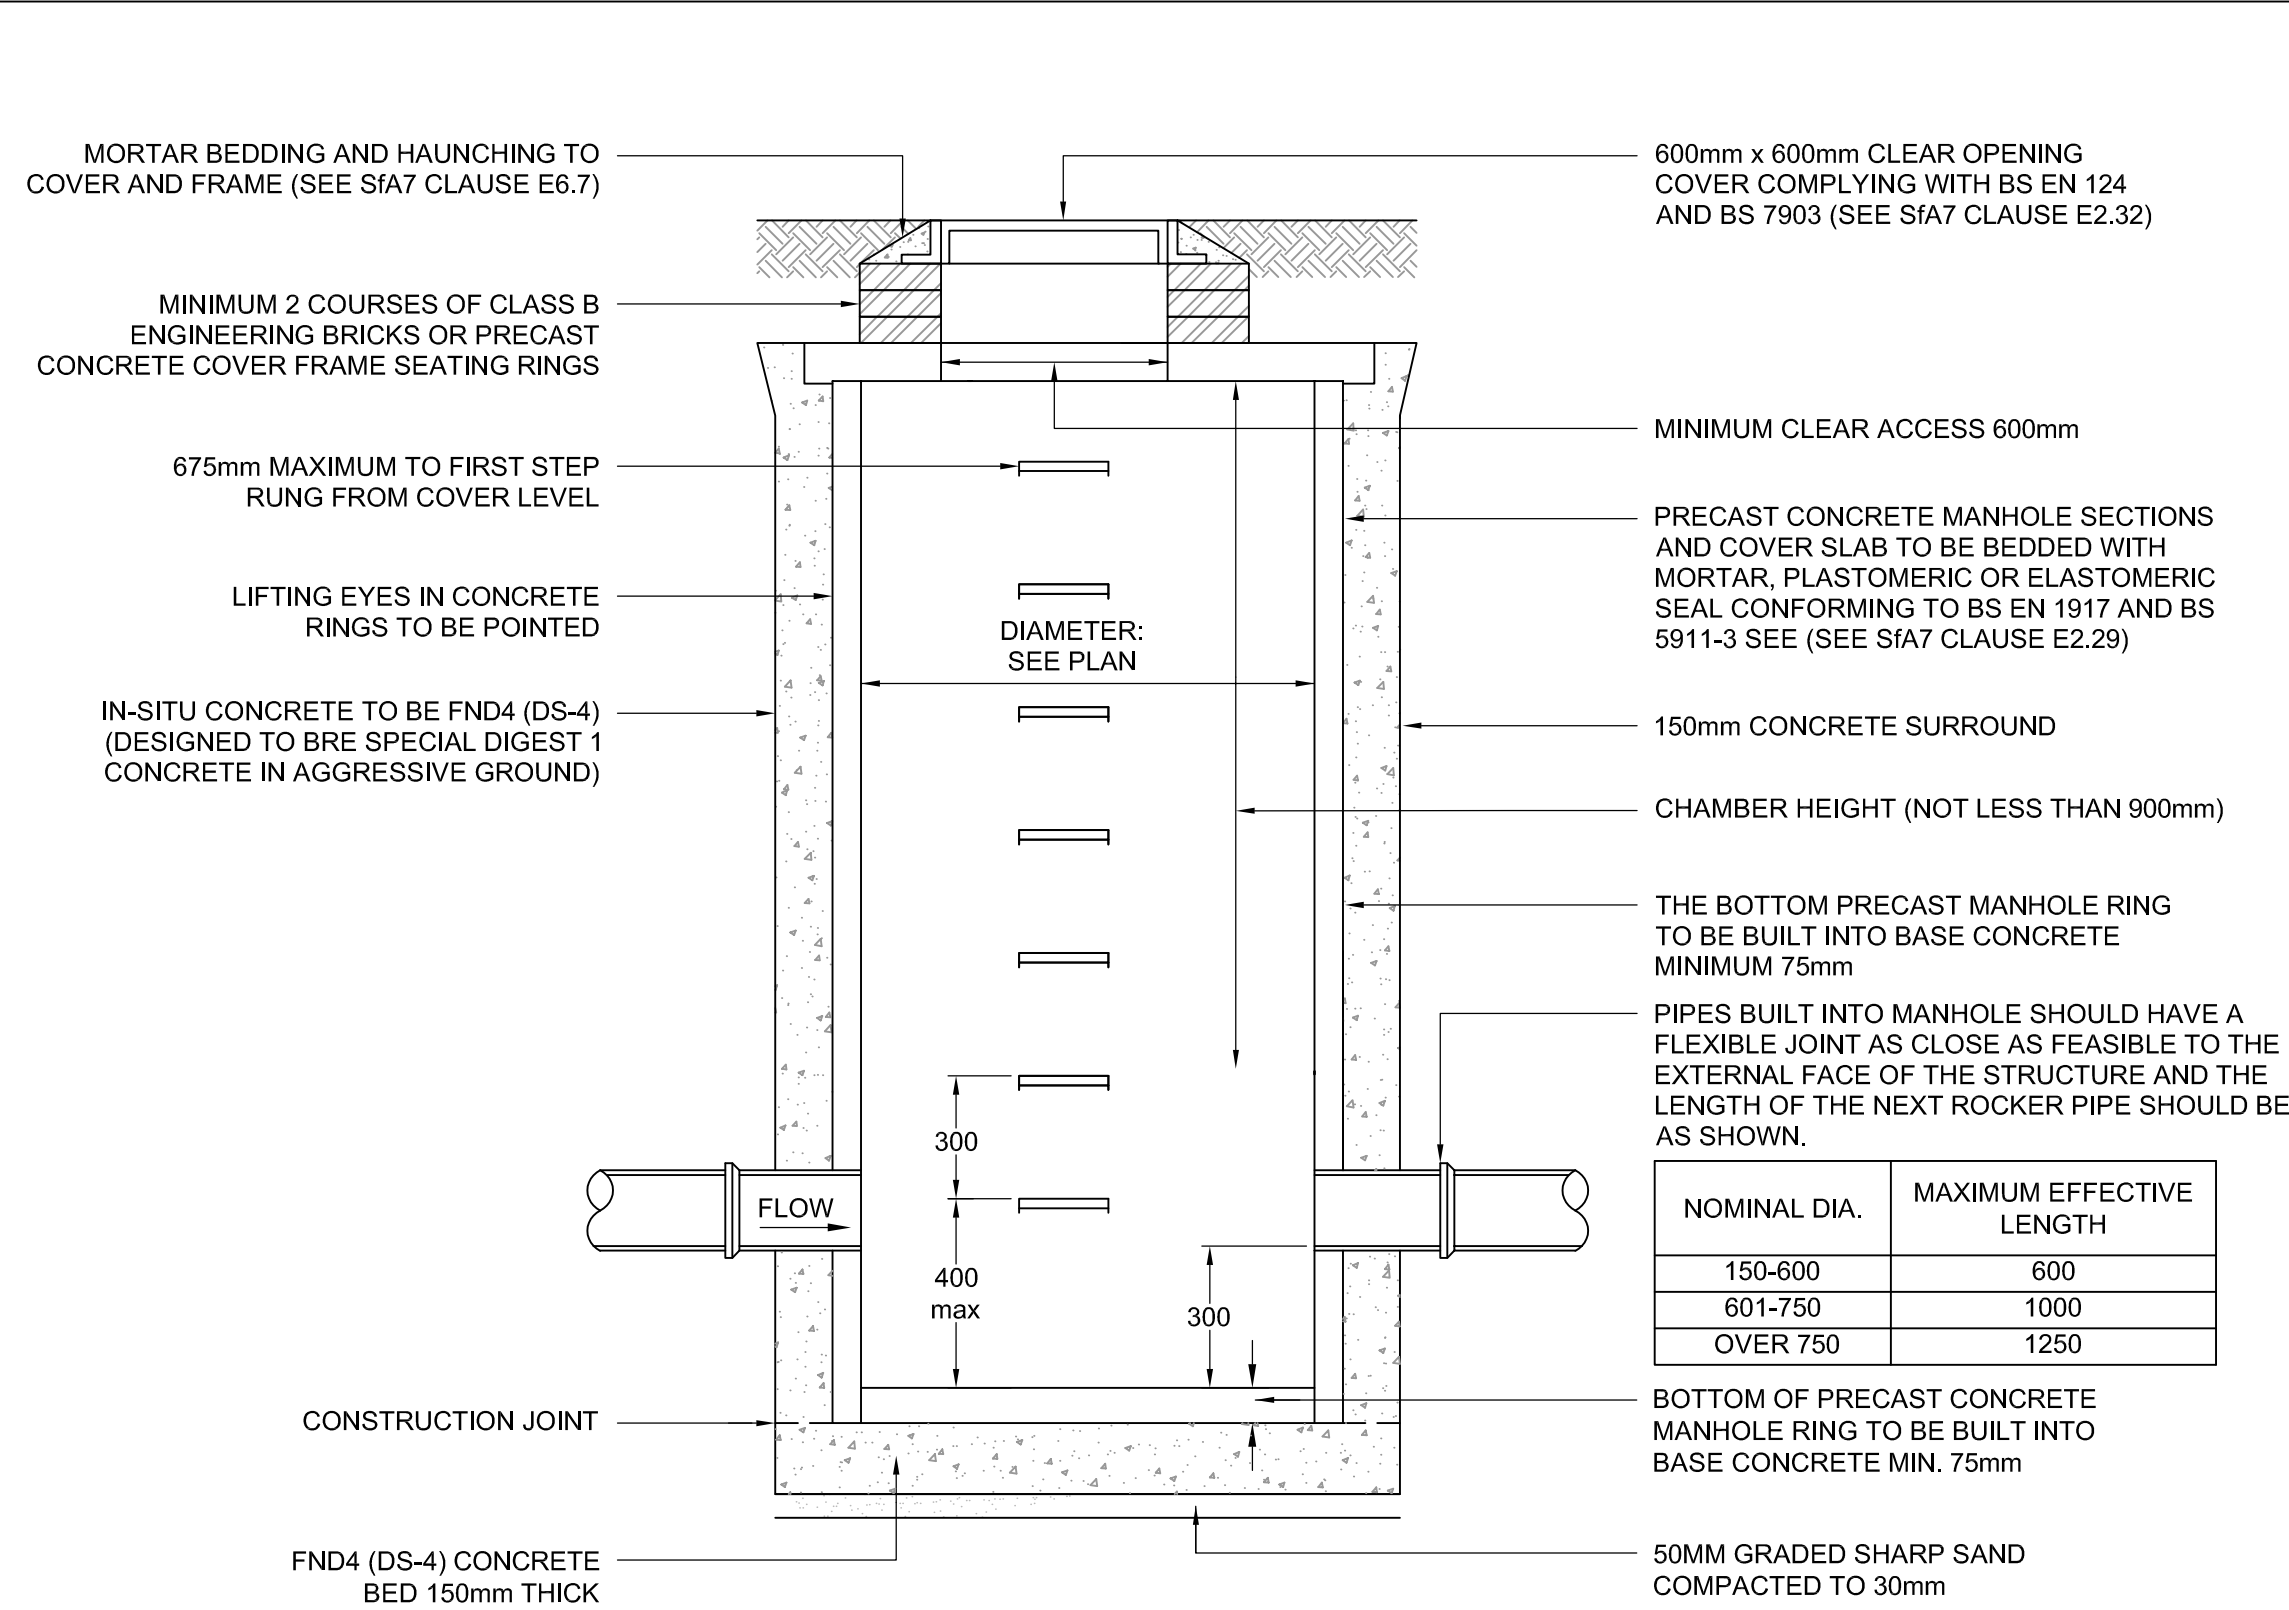

TYPICAL CATCHPIT DETAIL
SCALE 1:20
MAXIMUM DEPTH FROM COVER LEVEL TO SOFFIT OF PIPE 3.0m

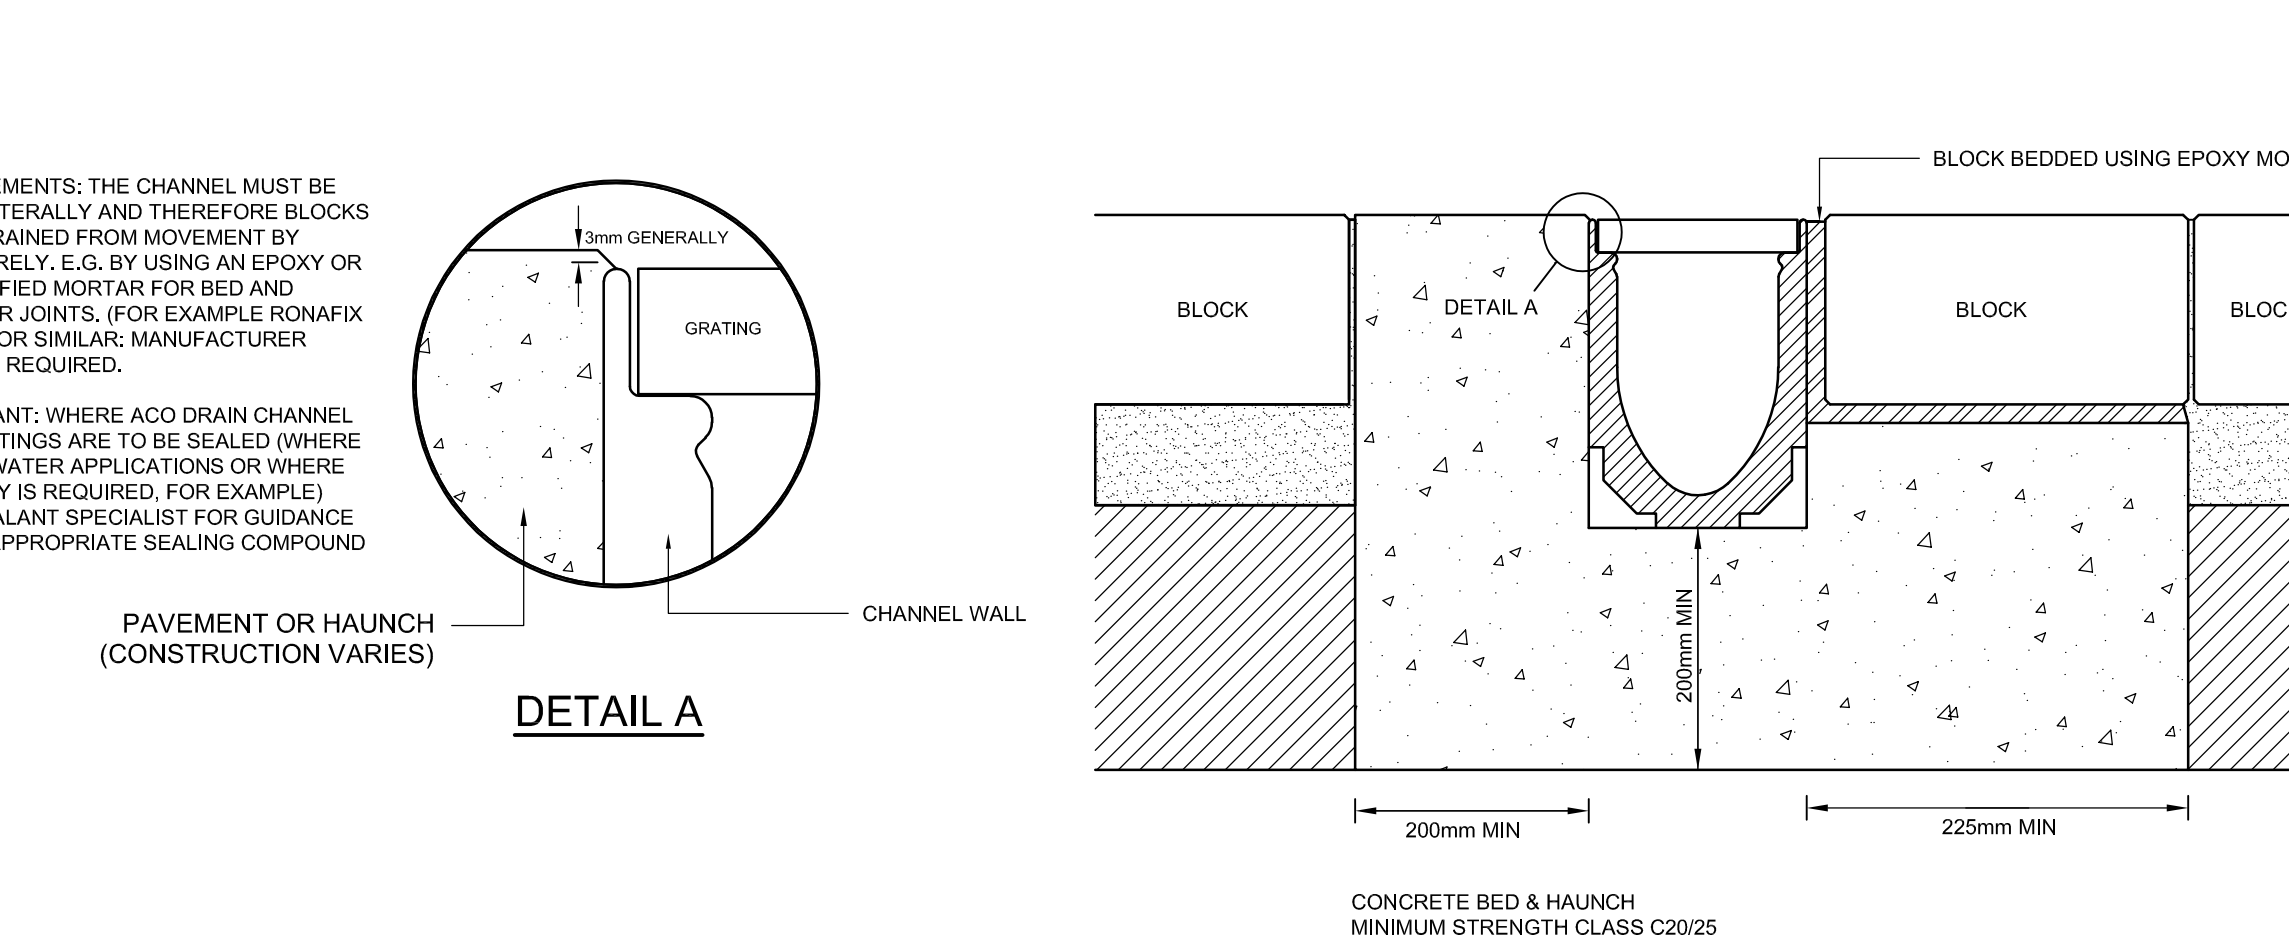

ACO MULTIDRAIN CHANNEL INSTALLATION FOR LOAD CLASS D400
(BLOCK PAVING)

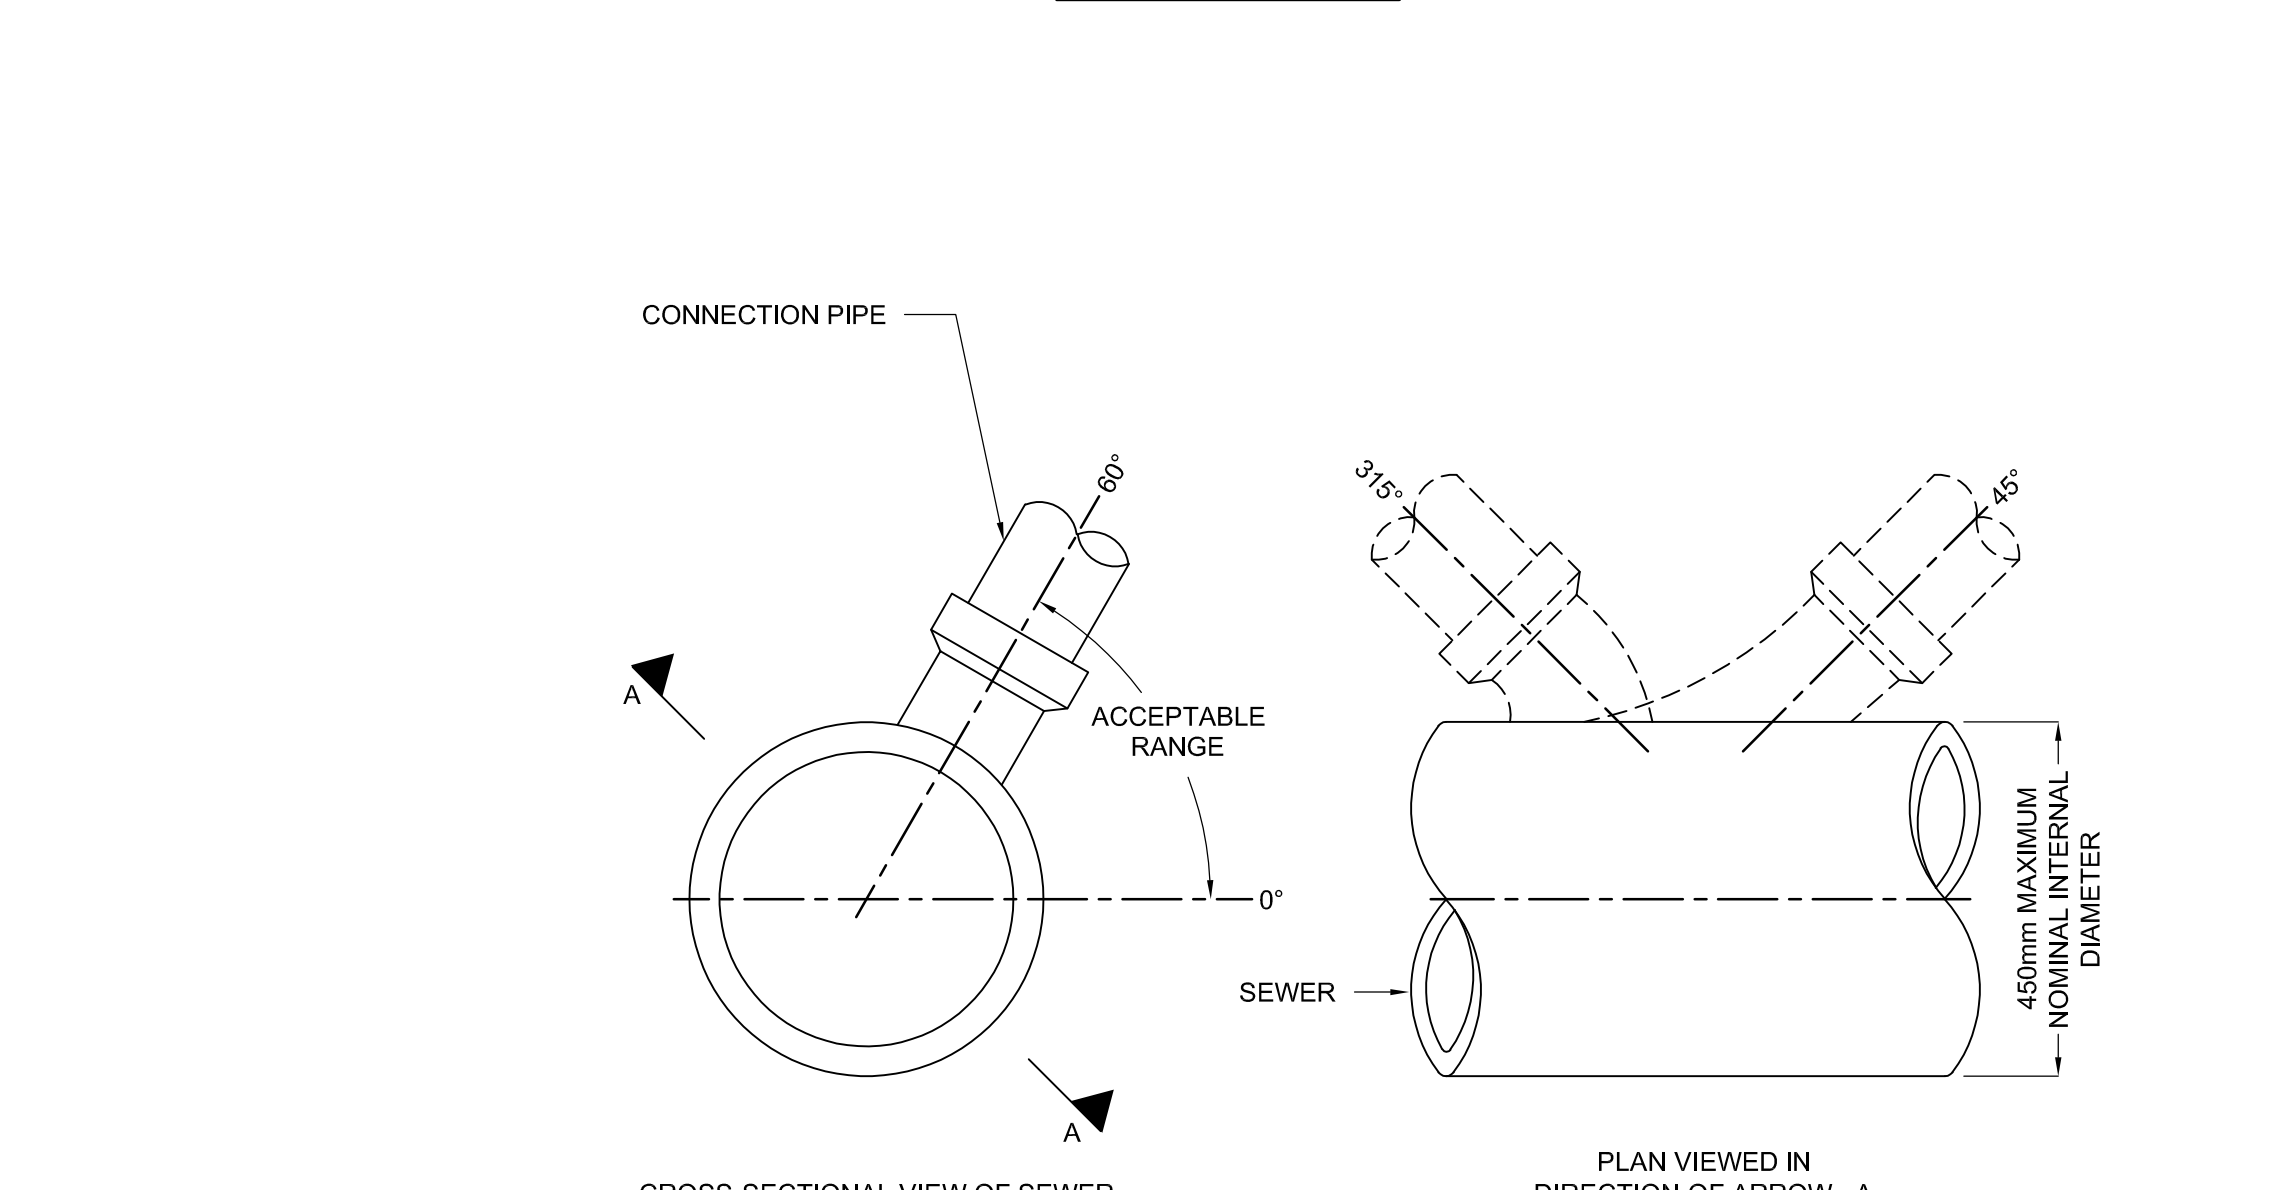

CONNECTIONS TO SEWER
SCALE 1:20

KEY PLAN

NOTES


- All dimensions are to be checked on site before the commencement of works. Any discrepancies are to be reported to the Architect & Engineer for verification. Figured dimensions only are to be taken from this drawing.
- The DWG file is issued for the purposes of coordination only and do not represent formal drawing issue and are not to be reprinted in any form. Formal issue of drawings is via DWF, Adobe PDF files and/or hard copies and their associated information issue sheets.
- Note that all care has been taken with the export of DWG files and their content, but we recommend that you make due dimensional checks before using any DWG file information. Any errors found are to be reported to Hydrock immediately.

NOMINAL INTERNAL DIAMETER OF LARGEST PIPE IN MANHOLE (mm)	MINIMAL NOMINAL INTERNAL DIMENSION OF MANHOLE (mm)
LESS THAN 375	1200
375 - 450	1350
500 - 700	1500
750 - 900	1800
GREATER THAN 900	PIPE DIAMETER + 900


NOMINAL DIA.	MAXIMUM EFFECTIVE LENGTH
150-600	600
601-750	1000
OVER 750	1250

C04	AS BUILT ISSUE				
	O.DAVIS	22.07.21	D.GALLIMORE	22.07.21	D.GALLIMORE
C03	HEALTH AND SAFETY FILE ISSUE				
	J.SHIMMIN	11.06.21	D.GALLIMORE	11.06.21	M. GRIFFIN
C02	AS BUILT ISSUE				
	J.SHIMMIN	NYI	D.GALLIMORE	NYI	M. GRIFFIN
C01	ISSUED FOR CONSTRUCTION				
	D. GALLIMORE	24/07/20	D.GALLIMORE	24/07/20	M. GRIFFIN
P05	ISSUED FOR CONTRACT				
	D. GALLIMORE	04/05/20	D.GALLIMORE	04/05/20	M. GRIFFIN
P04	ISSUED FOR CONTRACT				
	R.HUNT	13/03/20	D.GALLIMORE	13/03/20	M. GRIFFIN
P03	REVISED FOLLOWING COMMENTS (AS CLOUDED)				
	D. GALLIMORE	15/11/19	M. GRIFFIN	15/11/19	M. GRIFFIN
P02	REVISED FOLLOWING COMMENTS (AS CLOUDED)				
	D. GALLIMORE	06/11/19	M. GRIFFIN	06/11/19	M. GRIFFIN
P01	TENDER ISSUE				
	R.HUNT	11/10/19	D.GALLIMORE	11/10/19	M.GRIFFIN
REV	REVISION NOTES/COMMENTS				
	DRAWN BY	DATE	CHECKED BY	DATE	APPROVED BY

Merchants' House North
Wapping Road
Bristol
BS1 4RW
t: +44 (0)117 945 9225
e: bristolcentral@hydrock.com

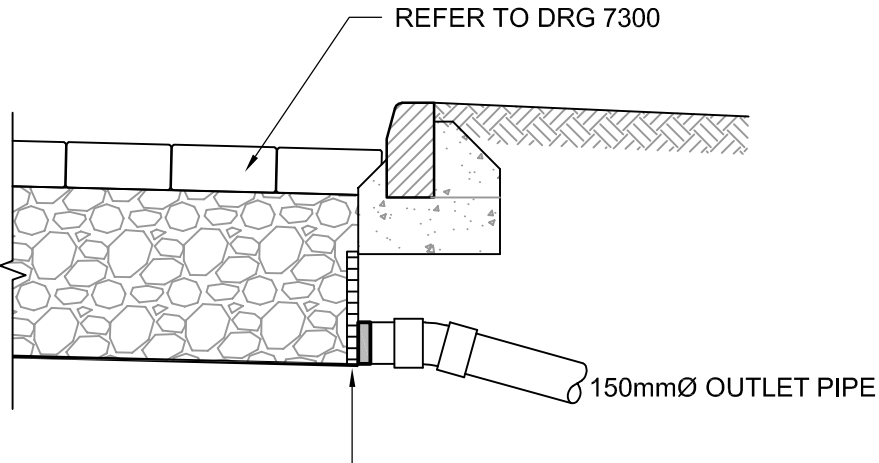 REFER TO DRG 7300 150mmØ OUTLET PIPE 300mm DEEP SC FIN DRAIN, LENGTH AS SHOWN ON LAYOUT TYPICAL FIN DRAIN OUTLET DETAIL SCALE 1:20	CLIENT		LANDLINK ESTATES	
	PROJECT			
	SALTBOX BOGNOR REGIS			
	TITLE			
	DRAINAGE DETAILS SHEET 3			
HYDROCK PROJECT NO.		SCALE @ A1		
C-13319-C		AS SHOWN		
STATUS DESCRIPTION			STATUS	
AS BUILT ISSUE			A	
DRAWING NO. (PROJECT CODE-ORIGINATOR-ZONE-LEVEL-TYPE-ROLE-NUMBER)			REVISION	
SAL-HYD-00-ZZ-DR-C-7102			C04	

TYPICAL FIN DRAIN OUTLET DETAIL
SCALE 1:20

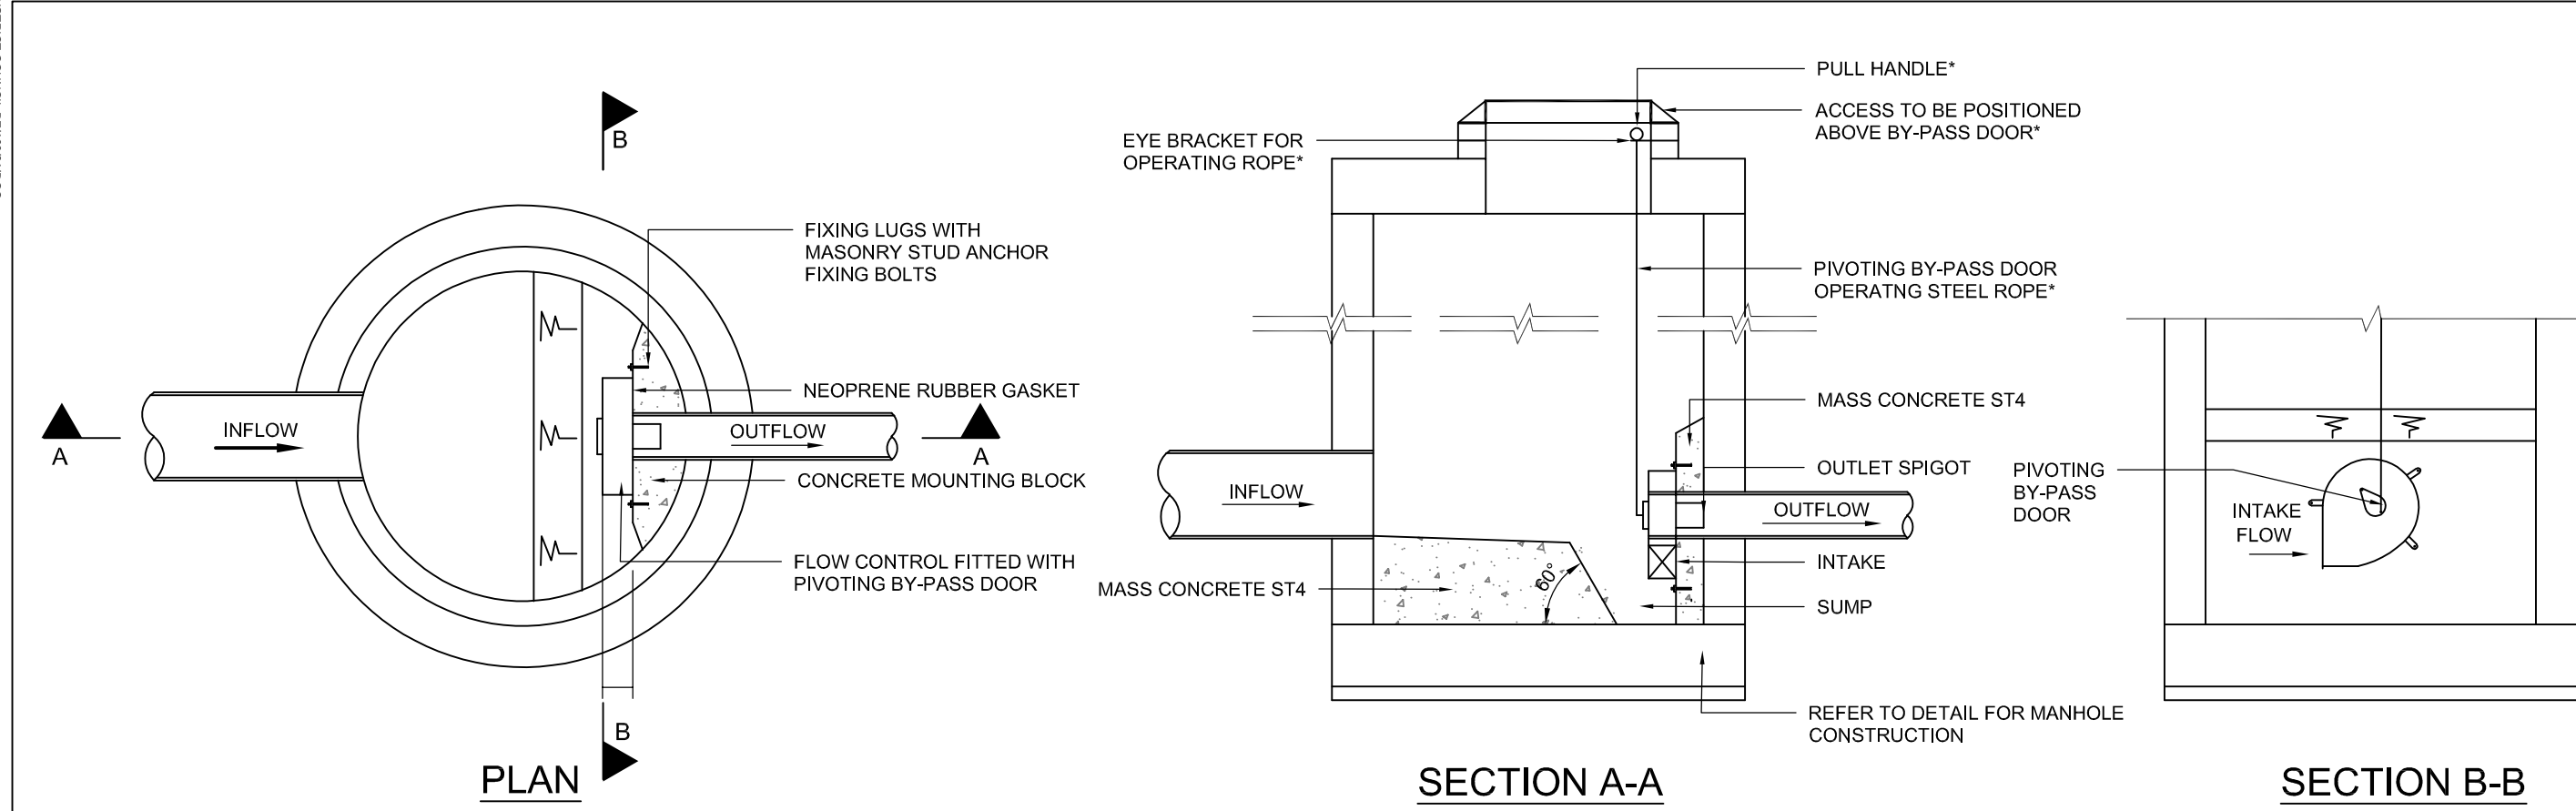


TYPICAL DESIGN LAYOUT FOR PROPOSED
FLOW CONTROL IN CIRCULAR MANHOLE
SCALE 1:25

Technical Specification		
Control Point	Head (m)	Flow (l/s)
Primary Design	1.260	3.800
Flush-Flo™	0.380	3.805
Kick-Flo	0.779	3.048
Mean Flow		3.342

Hydro-Brake Optimum Flow Control including:

3 mm grade 304L stainless steel
Integral stainless steel pivoting by-pass
door allowing clear line of sight through to
outlet, c/w stainless steel operating rope
Beech blasted finish to maximise corrosion
resistance
Stainless steel fixings
Rubber gasket to seal outlet

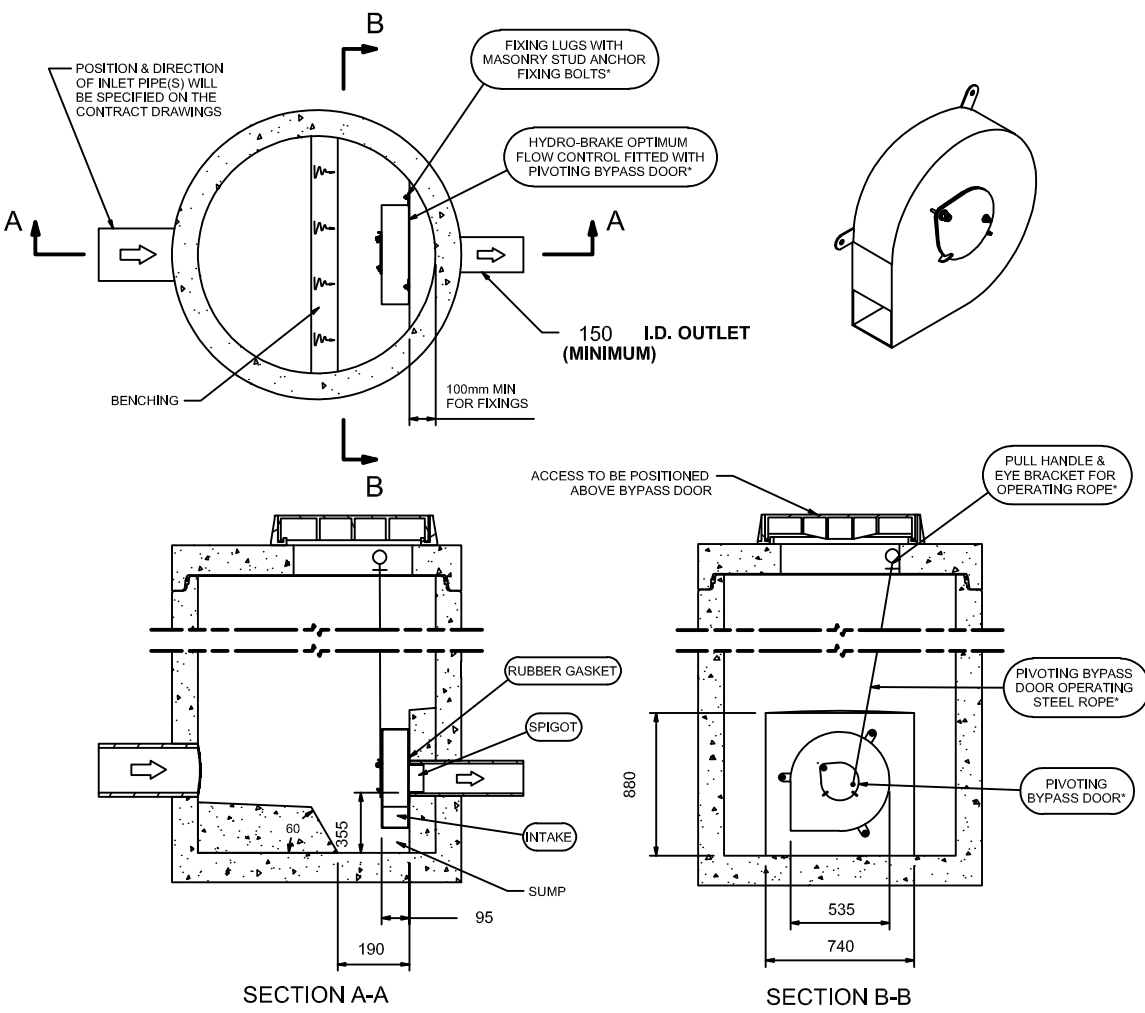


UNIT 2 FC-201
DETAIL FROM HYDRO INTERNATIONAL
SCALE NTS
(REFER TO C-7010 FOR LOCATION)

Technical Specification		
Control Point	Head (m)	Flow (l/s)
Primary Design	1.280	3.204
Flush-Flo™	0.353	3.068
Kick-Flo	0.721	2.464
Mean Flow		2.737


Hydro-Brake Optimum Flow Control including:

3 mm grade 304L stainless steel
Integral stainless steel pivoting by-pass
door allowing clear line of sight through to
outlet, c/w stainless steel operating rope
Beech blasted finish to maximise corrosion
resistance
Stainless steel fixings
Rubber gasket to seal outlet

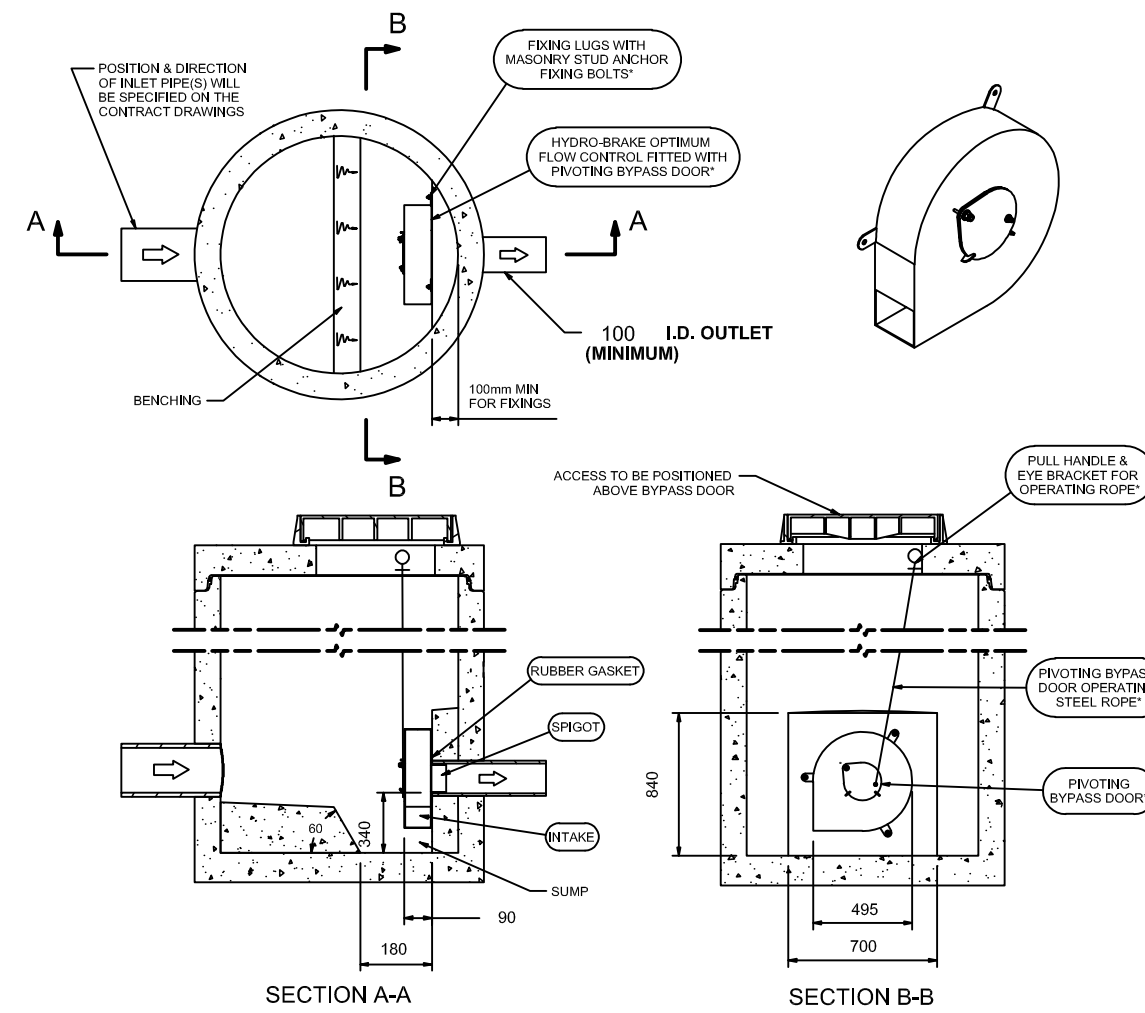


ACCESS ROAD FC-501
DETAIL FROM HYDRO INTERNATIONAL
SCALE 1:20
(REFER TO C-7020 FOR LOCATION)


NOTE:
ALL FLOW CONTROL MANHOLES TO BE
READ IN CONJUNCTION WITH TYPE 2
MANHOLE DETAIL ON DRAWING 7100

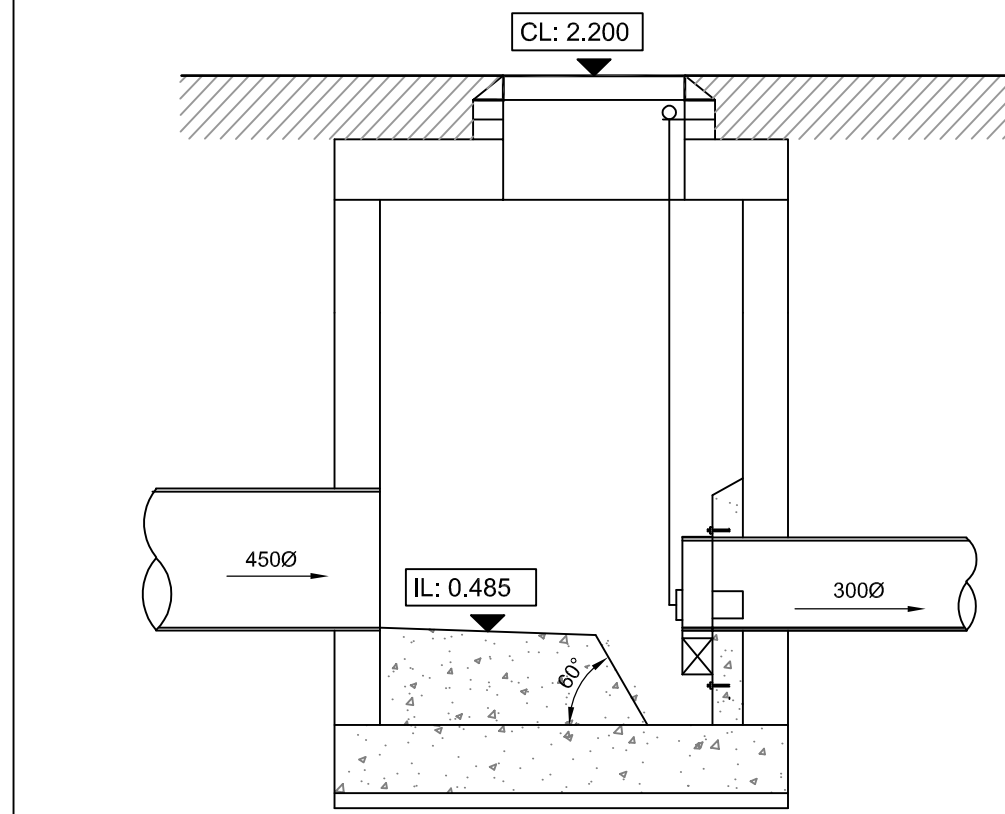


UNIT 2 FC-201
FLOW CONTROL IN CIRCULAR MANHOLE
SCALE 1:20
(REFER TO C-7010 FOR LOCATION)

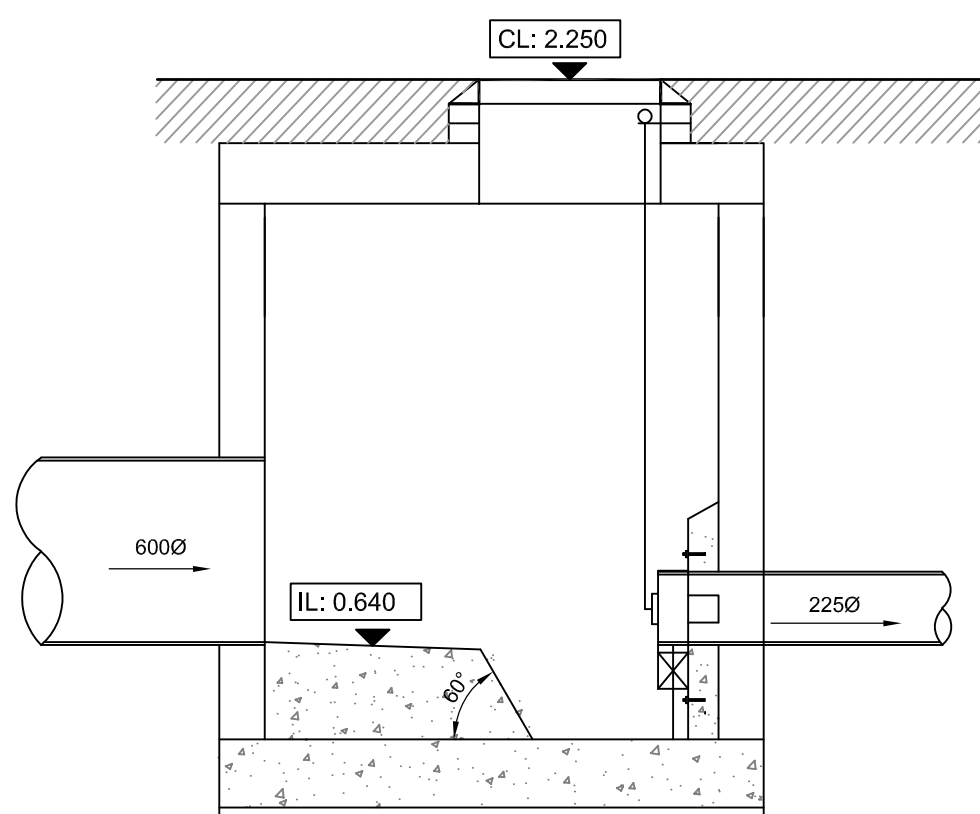


ACCESS ROAD FC-501
FLOW CONTROL IN CIRCULAR MANHOLE
SCALE 1:20
(REFER TO C-7020 FOR LOCATION)

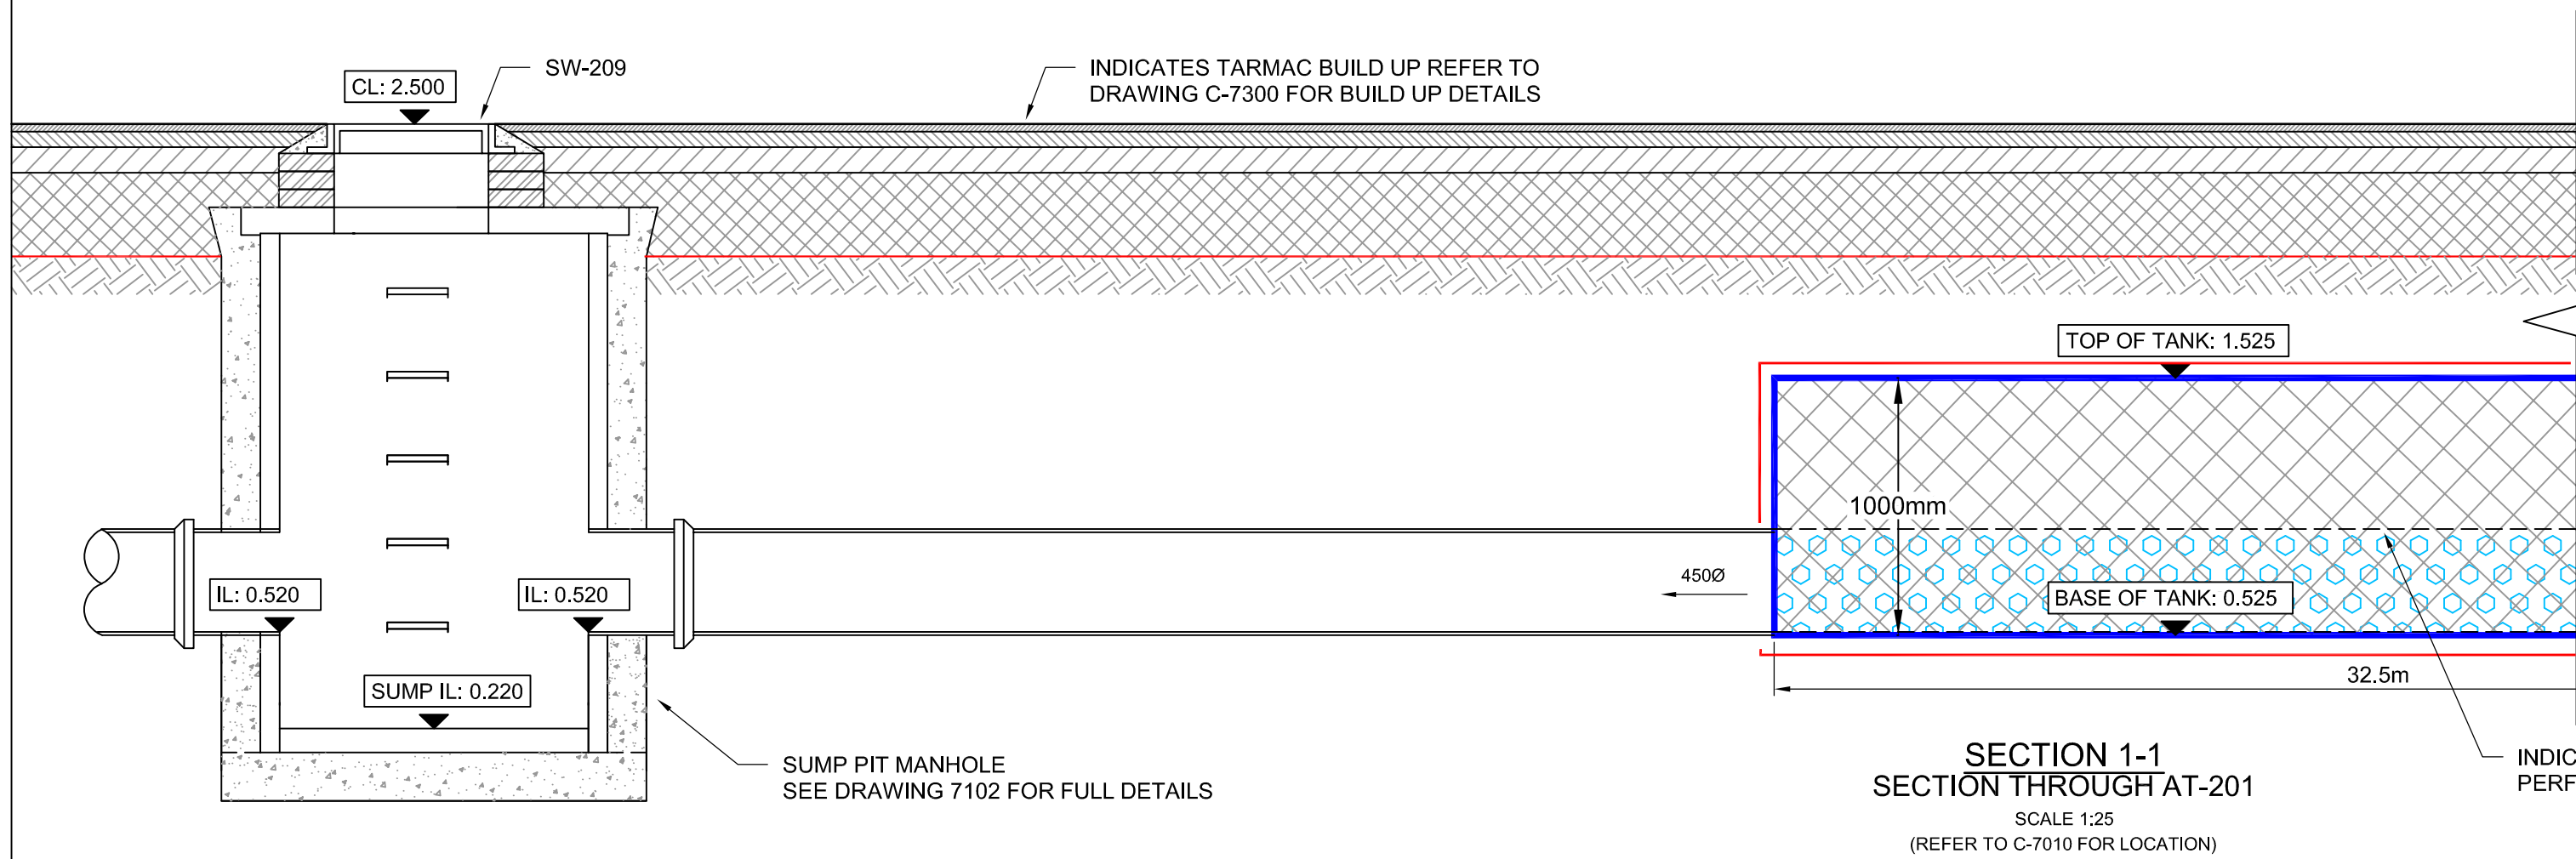

SECTION 1-1
SECTION THROUGH AT-201
SCALE 1:25
(REFER TO C-7010 FOR LOCATION)

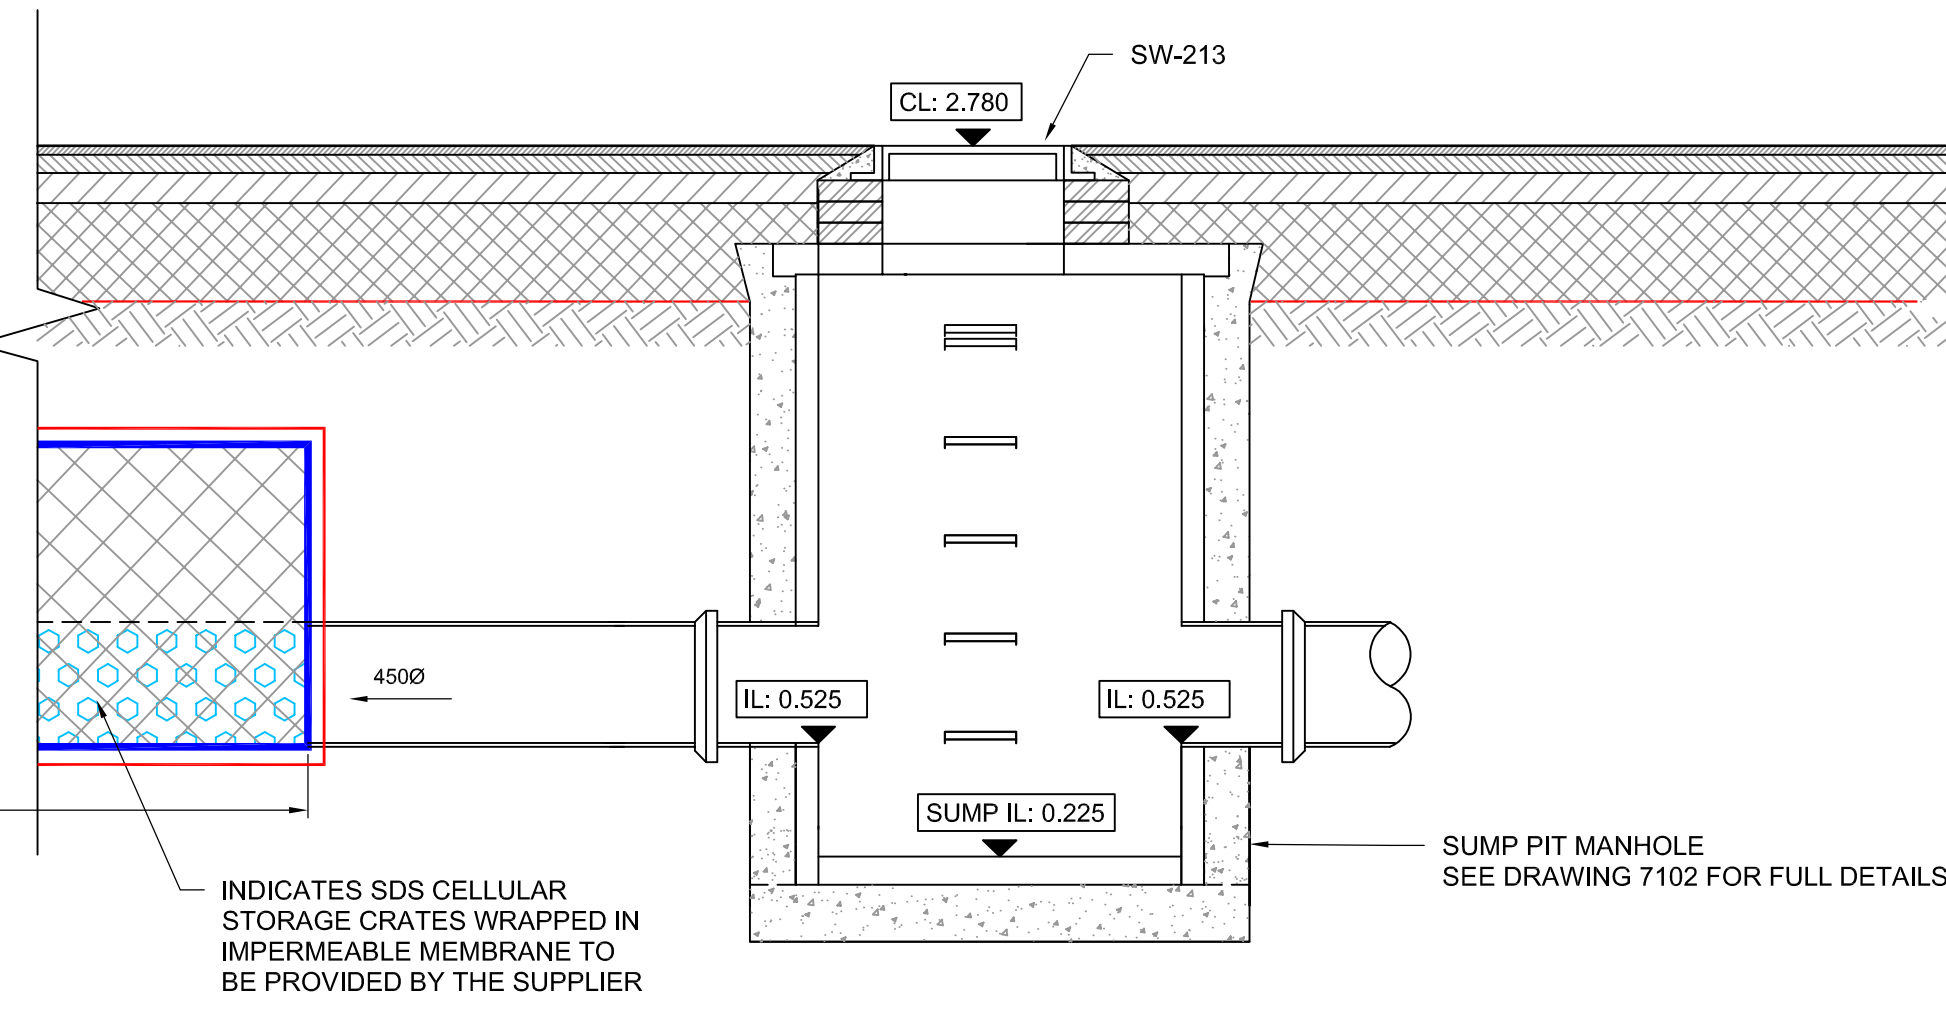

INDICATES MIN 3000 T JUNCTION RODDING POINT (D400
CVR) FOR ACCESS TO SDS GEOLIGHT TANK
SUBJECT TO SDS SPRCIFICATION

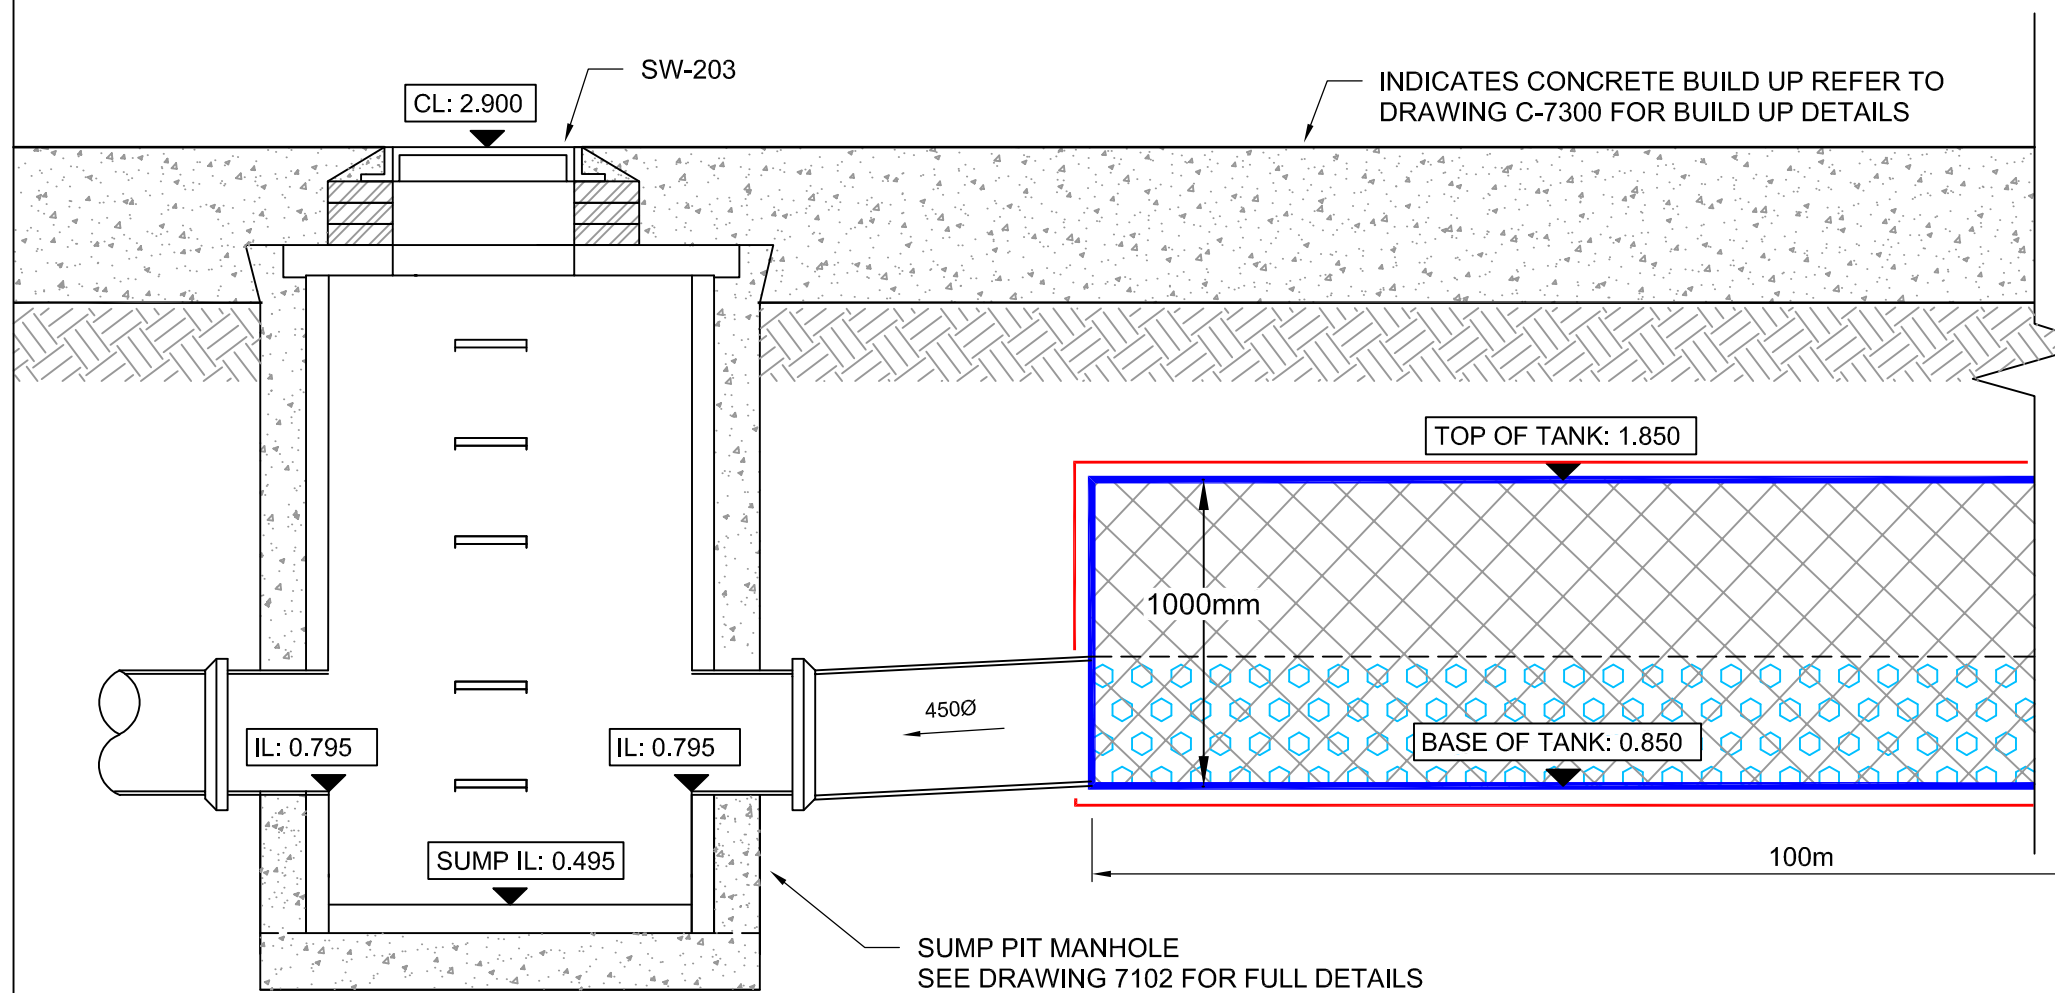

SECTION 2-2
SECTION THROUGH AT-202
SCALE 1:25
(REFER TO C-7010 FOR LOCATION)

T JUNCTION TYPICAL ACCESS
REFER TO AT-201 & AT-202 & AT-401
SCALE 1:25
(REFER TO C-7010 FOR LOCATION)

KEY PLAN


NOTES

- All dimensions are to be checked on site before the commencement of works. Any discrepancies are to be reported to the Architect & Engineer for verification. Figured dimensions only are to be taken from this drawing.
- The DWG file is issued for the purposes of coordination only and do not represent formal drawing issue and are not to be reprinted in any form. Formal issue of drawings is via DWF, Adobe PDF files and/or hard copies and their associated information issue sheets.
- Note that all care has been taken with the export of DWG files and their content, but we recommend that you make due dimensional checks before using any DWG file information. Any errors found are to be reported to Hydrock immediately.


C03	AS BUILT ISSUE					
	O.DAVIS	22.07.21	D.GALLIMORE	22.07.21	D.GALLIMORE	22.07.21
C02	HEALTH AND SAFETY FILE ISSUE					
	J.SHIMMIN	11.06.21	D.GALLIMORE	11.06.21	M. GRIFFIN	11.06.21
C01	ISSUED FOR CONSTRUCTION					
	D. GALLIMORE	24/07/20	D.GALLIMORE	24/07/20	M. GRIFFIN	24/07/20
P09	ISSUED FOR CONTRACT					
	D. GALLIMORE	28/05/20	D.GALLIMORE	28/05/20	M. GRIFFIN	28/05/20
P08	ISSUED FOR CONTRACT					
	D. GALLIMORE	15/05/20	D.GALLIMORE	15/05/20	M. GRIFFIN	15/05/20
P07	ISSUED FOR CONTRACT					
	R.HUNT	13/03/20	D.GALLIMORE	13/03/20	M. GRIFFIN	13/03/20
P06	REVISED FOLLOWING COMMENTS (AS CLOUDED)					
	D. GALLIMORE	13/12/19	M. GRIFFIN	13/12/19	M. GRIFFIN	13/12/19
P05	REVISED FOLLOWING COMMENTS (AS CLOUDED)					
	D. GALLIMORE	20/11/19	M. GRIFFIN	20/11/19	M. GRIFFIN	20/11/19
P04	REVISED FOLLOWING COMMENTS (AS CLOUDED)					
	D. GALLIMORE	15/11/19	M. GRIFFIN	15/11/19	M. GRIFFIN	15/11/19
P03	REVISED FOLLOWING COMMENTS (AS CLOUDED)					
	D. GALLIMORE	06/11/19	M. GRIFFIN	06/11/19	M. GRIFFIN	06/11/19
P02	TENDER ISSUE					
	R.HUNT	17/10/19	D.GALLIMORE	17/10/19	M.GRIFFIN	17/10/19
P01	TENDER ISSUE					
	R.HUNT	11/10/19	D.GALLIMORE	11/10/19	M.GRIFFIN	11/10/19
REV	REVISION NOTES/COMMENTS					
	DRAWN BY	DATE	CHECKED BY	DATE	APPROVED BY	DATE

Hydrock Merchants' House North
Wapping Road
Bristol
BS1 4RW
t: +44 (0)117 945 9225
e: bristolcentral@hydrock.com

CLIENT		LANDLINK ESTATES	
PROJECT		SALTBOX BOGNOR REGIS	
TITLE		DRAINAGE DETAILS SHEET 4	
HYDROCK PROJECT NO. C-13319-C		SCALE @ A1 AS SHOWN	
STATUS DESCRIPTION AS BUILT ISSUE		STATUS A	
DRAWING NO. (PROJECT CODE-ORIGINATOR-ZONE-LEVEL-TYPE-ROLE-NUMBER) SAL-HYD-PH1-ZZ-DR-C-7103		REVISION C03	

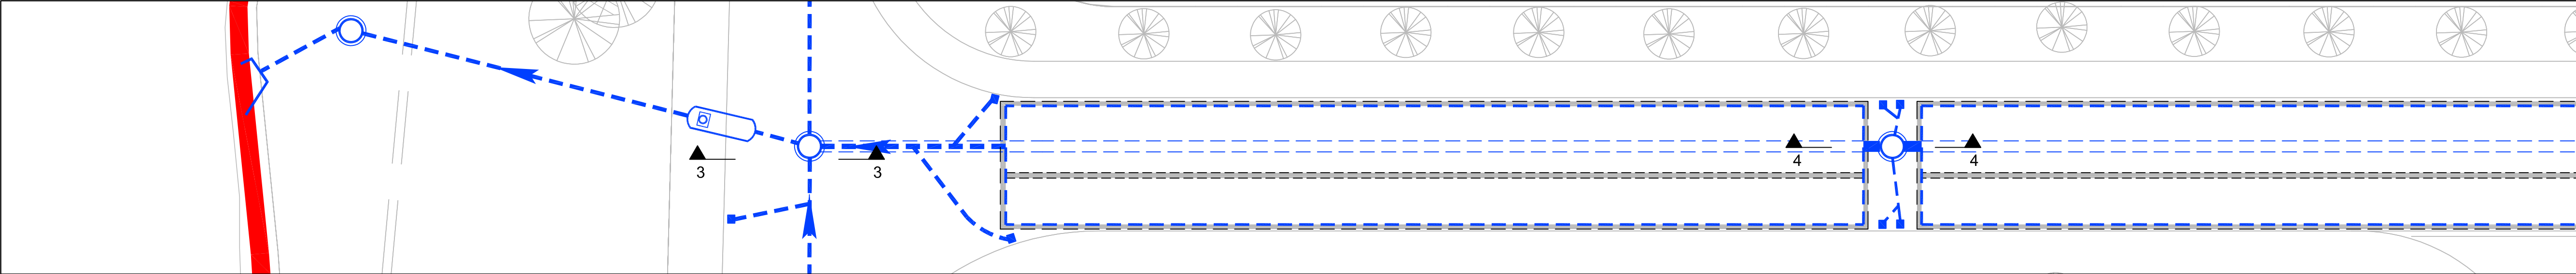


KEY PLAN

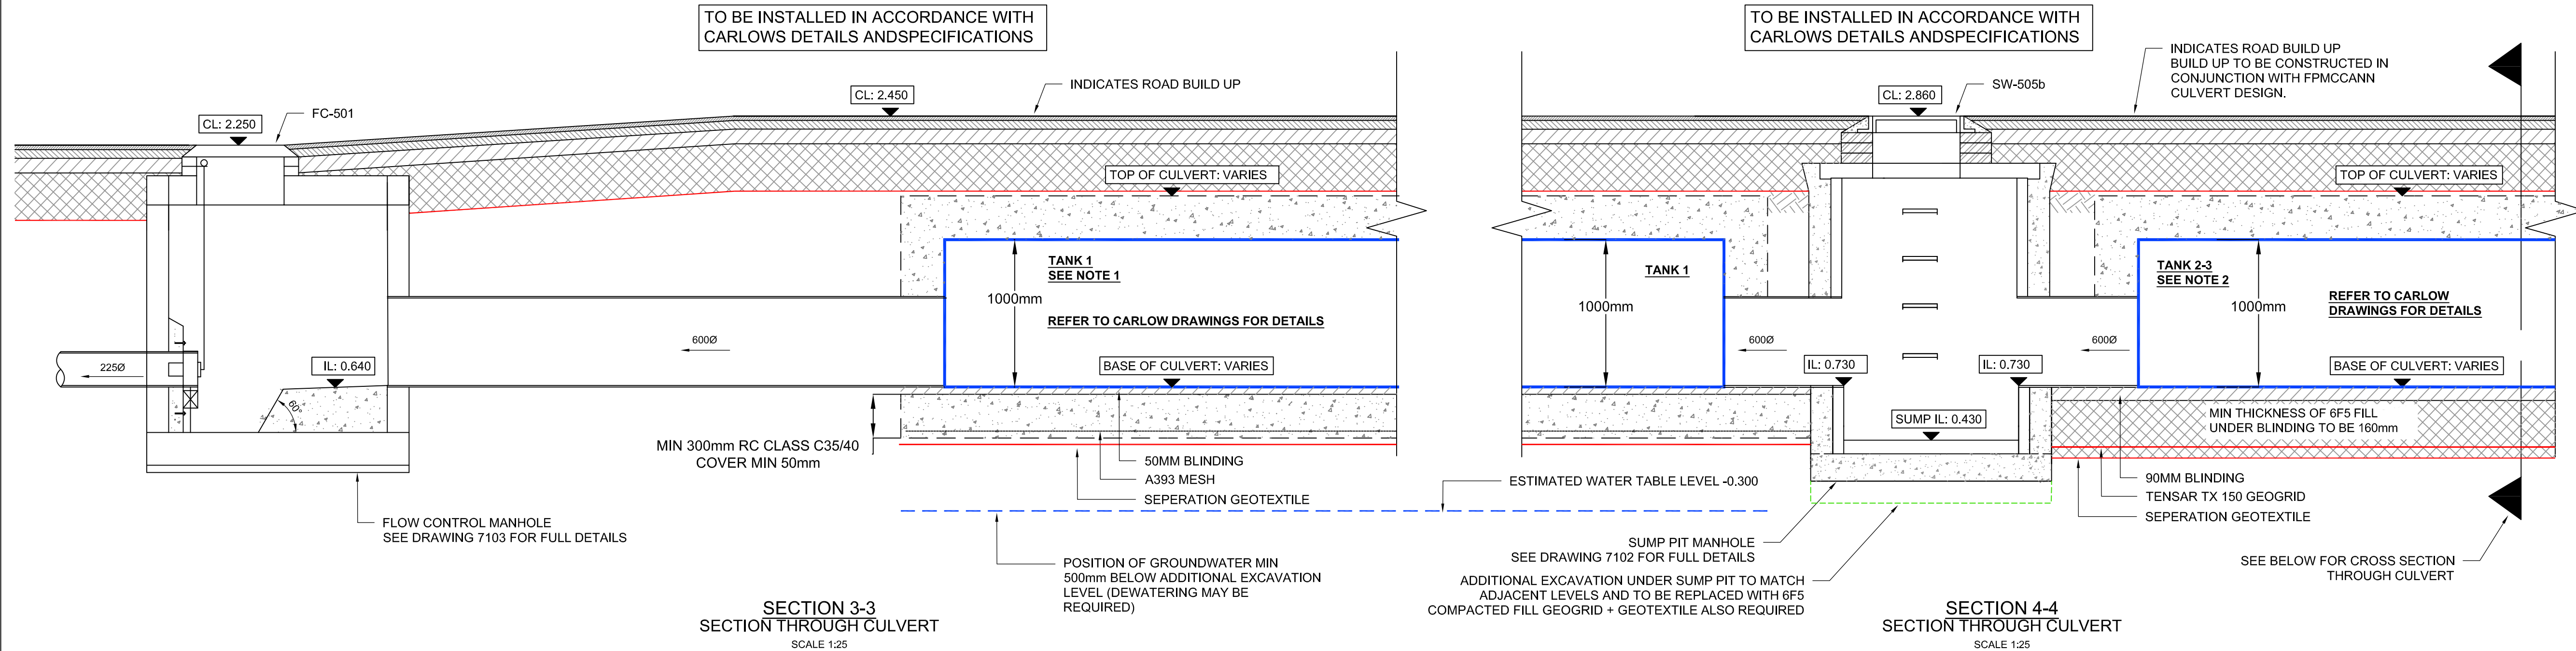

NOTES

- All dimensions are to be checked on site before the commencement of works. Any discrepancies are to be reported to the Architect & Engineer for verification. Figured dimensions only are to be taken from this drawing.
- The DWG file is issued for the purposes of coordination only and do not represent formal drawing issue and are not to be reprinted in any form. Formal issue of drawings is via DWF, Adobe PDF files and/or hard copies and their associated information issue sheets.
- Note that all care has been taken with the export of DWG files and their content, but we recommend that you make due dimensional checks before using any DWG file information. Any errors found are to be reported to Hydrock immediately.

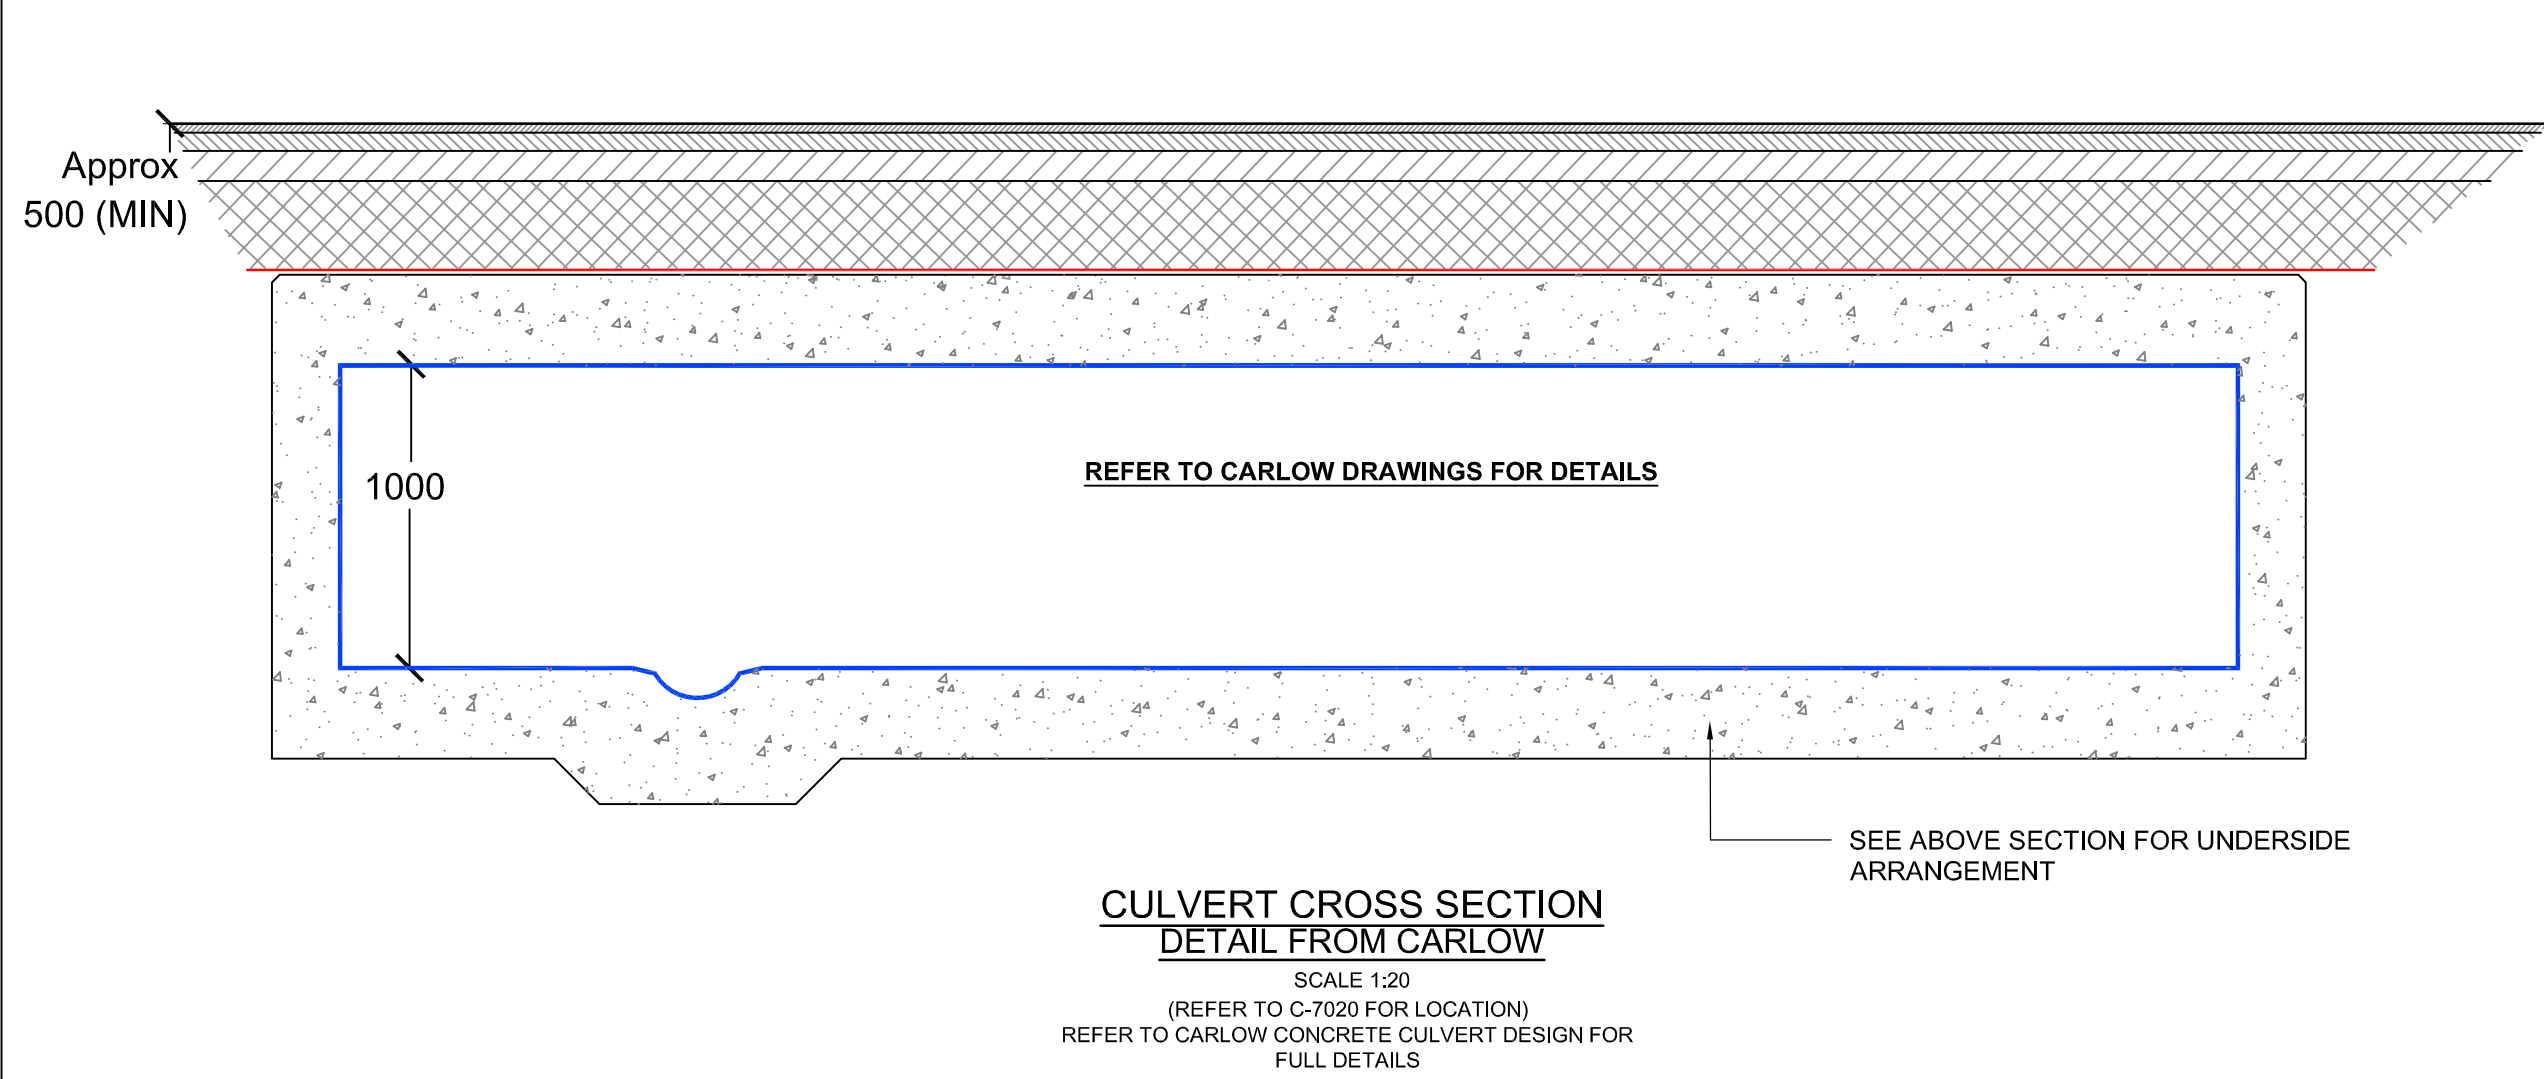

NOTE 1: (TANK 1)

THE ADDITIONAL EXCAVATION (STRIP) WILL REMOVE MIN 150mm OF SOIL TO FIND NON-SATURATED SOILS. ADDITIONAL EXCAVATION MAY BE REQUIRED AT LOCALIZED AREAS

THE ADDITIONAL EXCAVATION CAN BE EXECUTED IN FULL AS LONG AS THE AREAS IS TO BE SEALED WITH GEOTEXTILE PLUS 300mm C35/40 RC IN THE VERY SAME DAY. OTHERWISE, STAGES WILL BE REQUIRED.

FOLLOWED THE 150mm STRIP, SEPARATION WITH GEOTEXTILE IS REQUIRED, FOLLOWED WITH MIN 50mm OF C35/40 CONCRETE (CONCRETE COVER). UPON, A393 MESH IS TO BE INSTALLED AND THEN TOP UP WITH 250mm OF SAME CLASS CONCRETE. THE RESULT WILL BE 300mm RC SLAB.

UPON, 50mm OF BLINDING CONCRETE TO BE EXECUTED PRIOR TO CULVERT INSTALLATION

FOR ALL AREAS ALREADY EXCAVATED BUT NOT YET ADDITIONALLY EXCAVATED, A PLASTIC/IMPERMEABLE MEMBRANE WILL BE PROVIDED TO PROTECT THE FORMATION LEVEL FROM RAINFALL.


NOTE 2: (TANK 2&3)

THE ADDITIONAL EXCAVATION MUST BE EXECUTED IN SMALL SECTION AREAS (STAGES). THEN A SEPARATION GEOTEXTILE IS TO BE INSTALLED ON THE BASE OF EACH STAGE FOLLOWED WITH 50mm OF CLASS 6F5/TYPE 1. UPON, A 3D GEOGRID TO BE INSTALLED AND THEN TOP UP WITH 110mm OF SAME CLASS 6F5/TYPE 1 FILL THAT NEEDS TO BE COMPACTED TO METHOD 6 (SWH S600). UPON, 90mm OF BLINDING CONCRETE TO BE EXECUTED.

EACH STAGE WOULD BE COMPLETED SEPARATELY BEFORE THE EXECUTION OF THE BLINDING TO REDUCE TRAFFICKING AND EXPOSURE OF THE EXCAVATION SURFACE.

FOR ALL EXCAVATED FILLED AREAS NOT YET WITH THE BLINDING, A PLASTIC/IMPERMEABLE MEMBRANE TO BE PROVIDED TO PROTECT THE FORMATION LEVEL FROM RAINFALL.

C04	AS BUILT ISSUE	O.DAVIS	22.07.21	D.GALLIMORE	22.07.21	D.GALLIMORE	22.07.21
C03	HEALTH AND SAFETY FILE ISSUE	J.SHIMMIN	11.06.21	D.GALLIMORE	11.06.21	M. GRIFFIN	11.06.21
C02	REVISED AS CLOUDED	D. GALLIMORE	16/11/20	D.GALLIMORE	16/11/20	M. GRIFFIN	16/11/20
C01	ISSUED FOR CONSTRUCTION	D. GALLIMORE	24/07/20	D.GALLIMORE	24/07/20	M. GRIFFIN	24/07/20
P10	ISSUED FOR CONTRACT	D. GALLIMORE	28/05/20	D.GALLIMORE	28/05/20	M. GRIFFIN	28/05/20
P09	ISSUED FOR CONTRACT	D. GALLIMORE	15/05/20	D.GALLIMORE	15/05/20	M. GRIFFIN	15/05/20
P08	ISSUED FOR CONTRACT	R.HUNT	13/03/20	D.GALLIMORE	13/03/20	M. GRIFFIN	13/03/20
P07	CULVERT REVISED	D. GALLIMORE	25/02/20	M. GRIFFIN	25/02/20	M. GRIFFIN	25/02/20
P06	REVISED AS CLOUDED	D. GALLIMORE	13/12/19	M. GRIFFIN	13/12/19	M. GRIFFIN	13/12/19
P05	REVISED FOLLOWING COMMENTS (CLOUDED)	D. GALLIMORE	22/11/19	M. GRIFFIN	22/11/19	M. GRIFFIN	22/11/19
P04	REVISED FOLLOWING COMMENTS (CLOUDED)	D. GALLIMORE	22/11/19	M. GRIFFIN	22/11/19	M. GRIFFIN	22/11/19
P03	REVISED FOLLOWING COMMENTS (CLOUDED)	D. GALLIMORE	20/11/19	M. GRIFFIN	20/11/19	M. GRIFFIN	20/11/19
P02	ISSUED FOR TENDER	D. GALLIMORE	15/11/19	M. GRIFFIN	15/11/19	M. GRIFFIN	15/11/19
P01	ISSUED FOR TENDER	D. GALLIMORE	06/11/19	M. GRIFFIN	06/11/19	M. GRIFFIN	06/11/19
REV	REVISION NOTES/COMMENTS	DRAWN BY	DATE	CHECKED BY	DATE	APPROVED BY	DATE

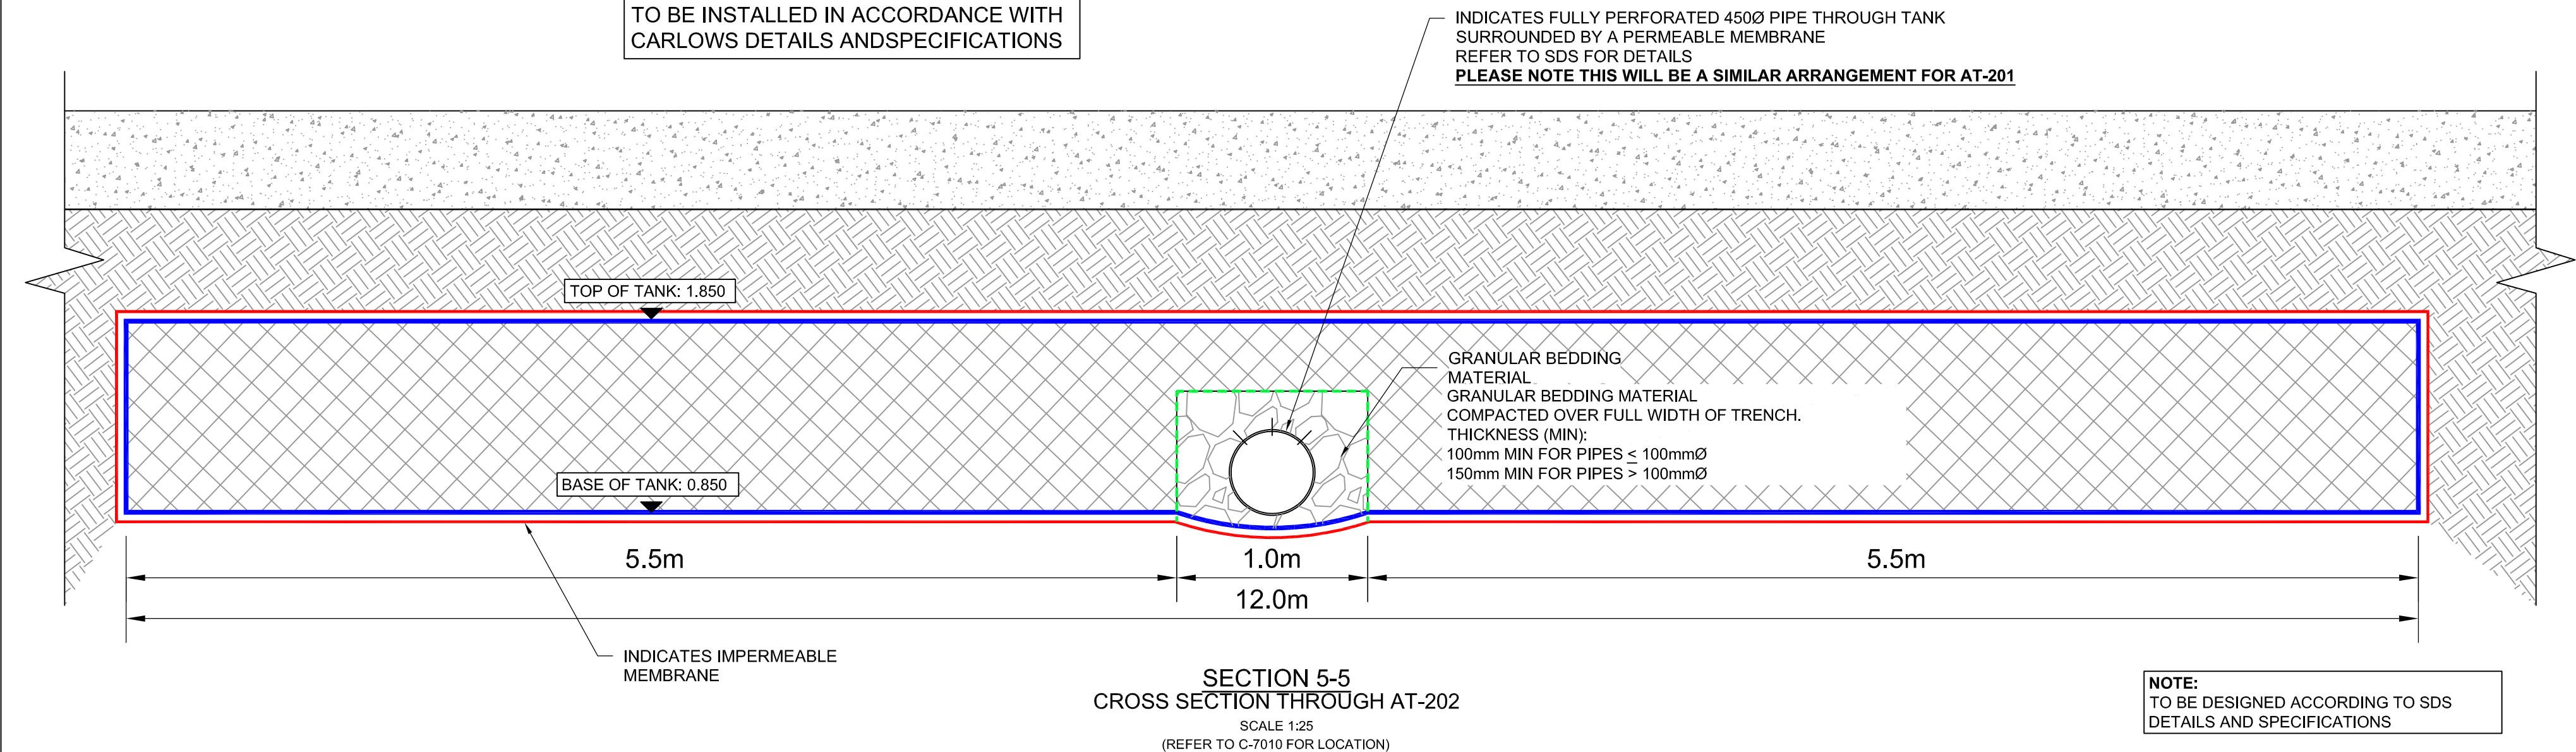



Merchants' House North
Wapping Road
Bristol
BS1 4RW
t: +44 (0)117 945 9225
e: bristolcentral@hydrock.com

CLIENT

LANDLINK ESTATES

PROJECT


SALTBOX
BOGNOR REGIS

TITLE

DRAINAGE DETAILS
SHEET 5

HYDROCK PROJECT NO. C-13319-C	SCALE @ A1 AS SHOWN	STATUS AS BUILT ISSUE
DRAWING NO. (PROJECT CODE-ORIGINATOR-ZONE-LEVEL-TYPE-ROLE-NUMBER) SAL-HYD-00-ZZ-DR-C-7104		REVISION C04


HEADWALL 01

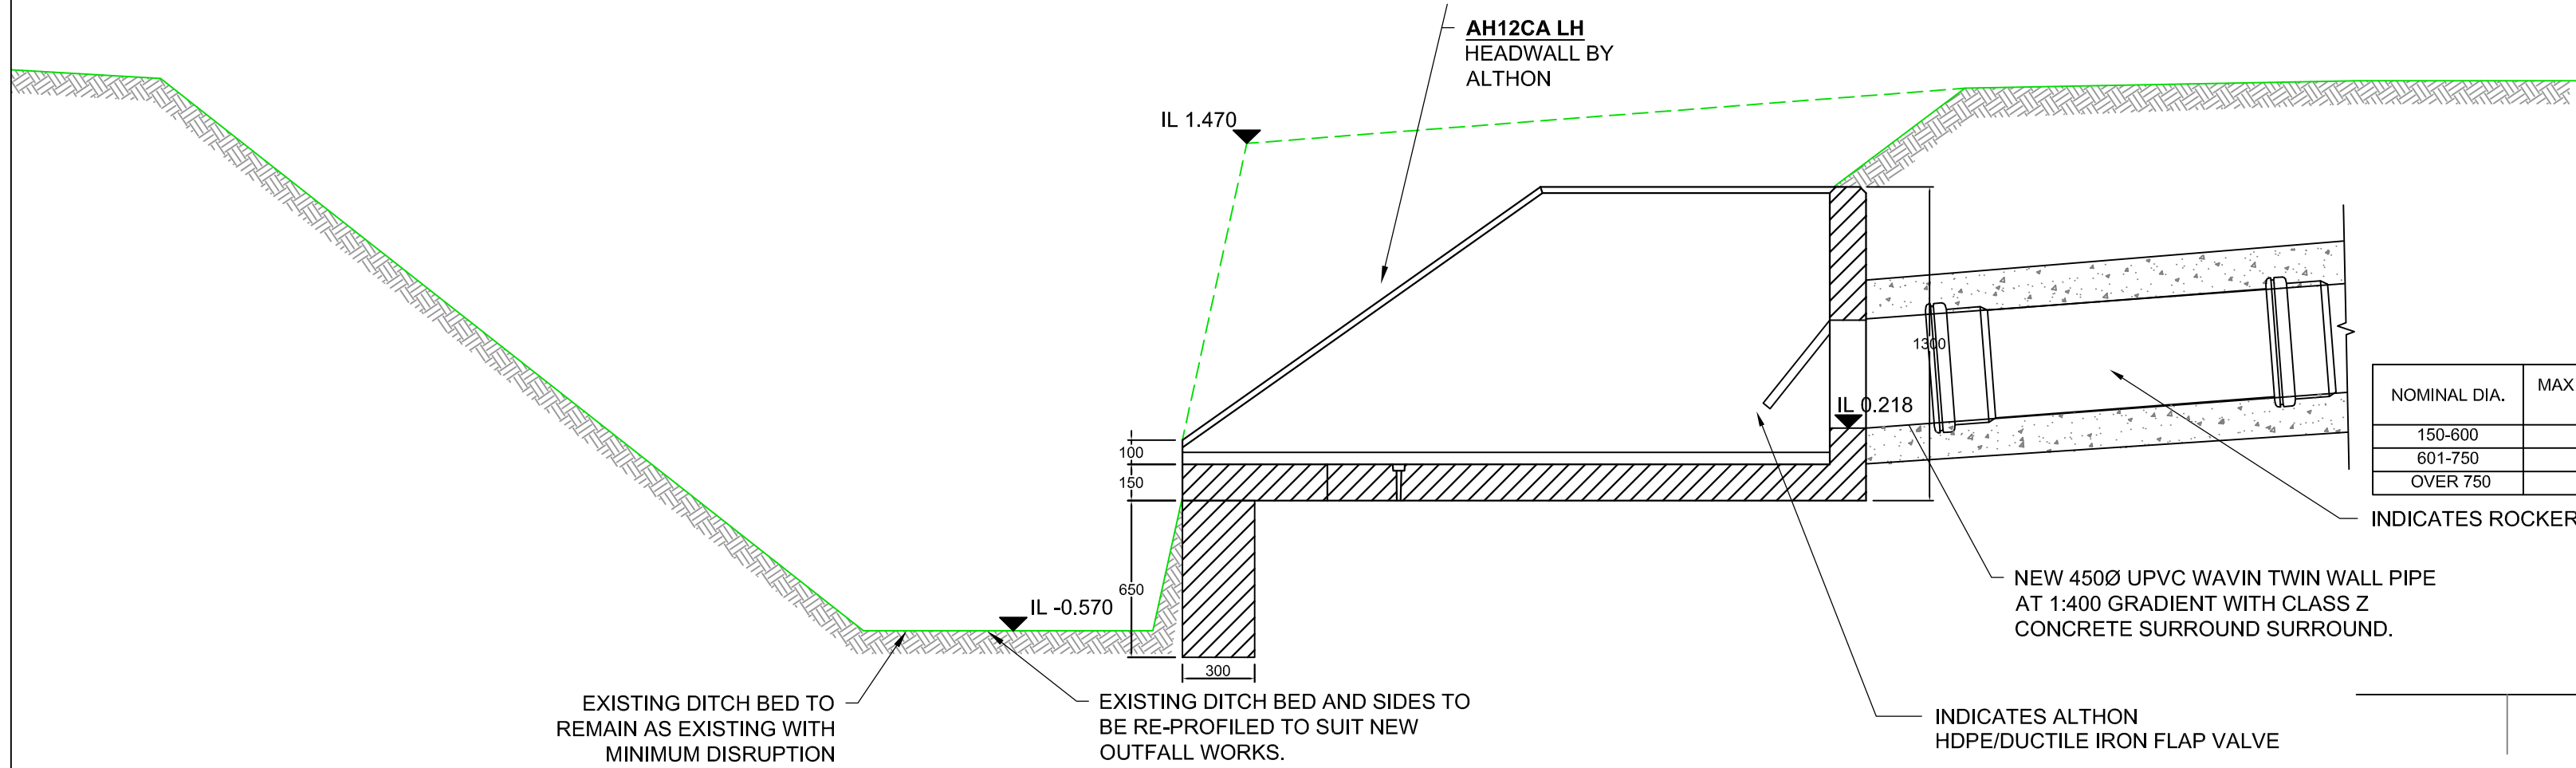

SECTION A-A
SEE DRAWING SBX-KSA-Z0-XX-DR-C-6800
FOR PLAN


A

A

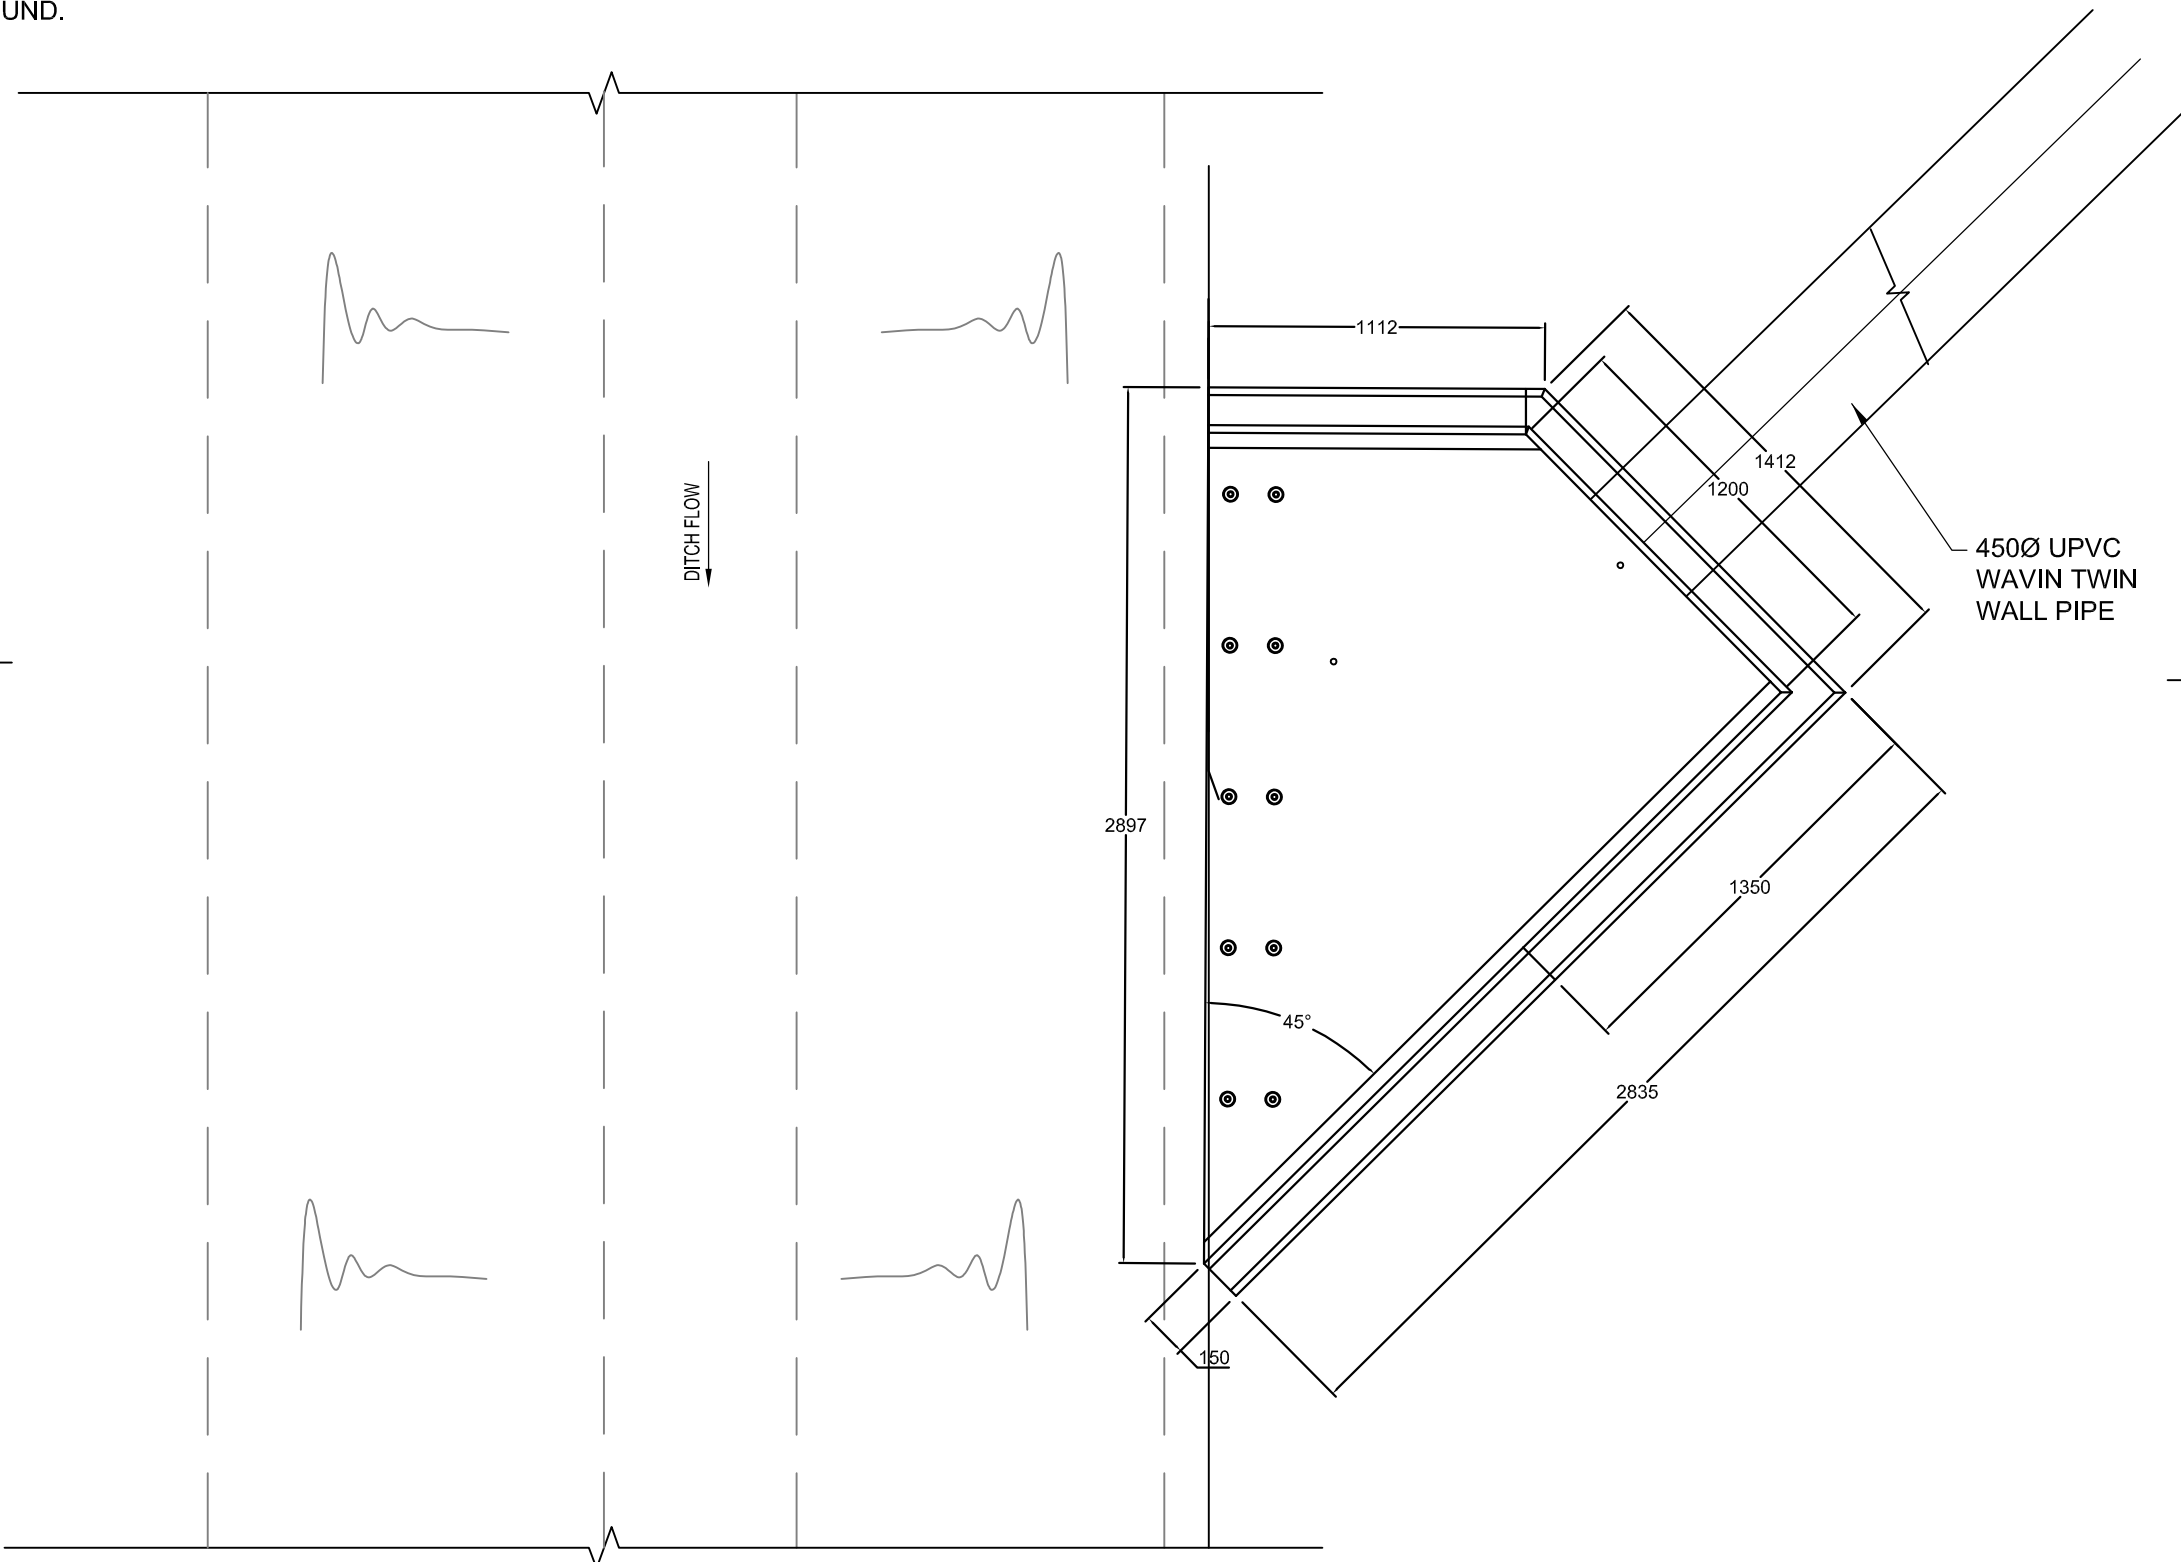

PLAN


HEADWALL 02

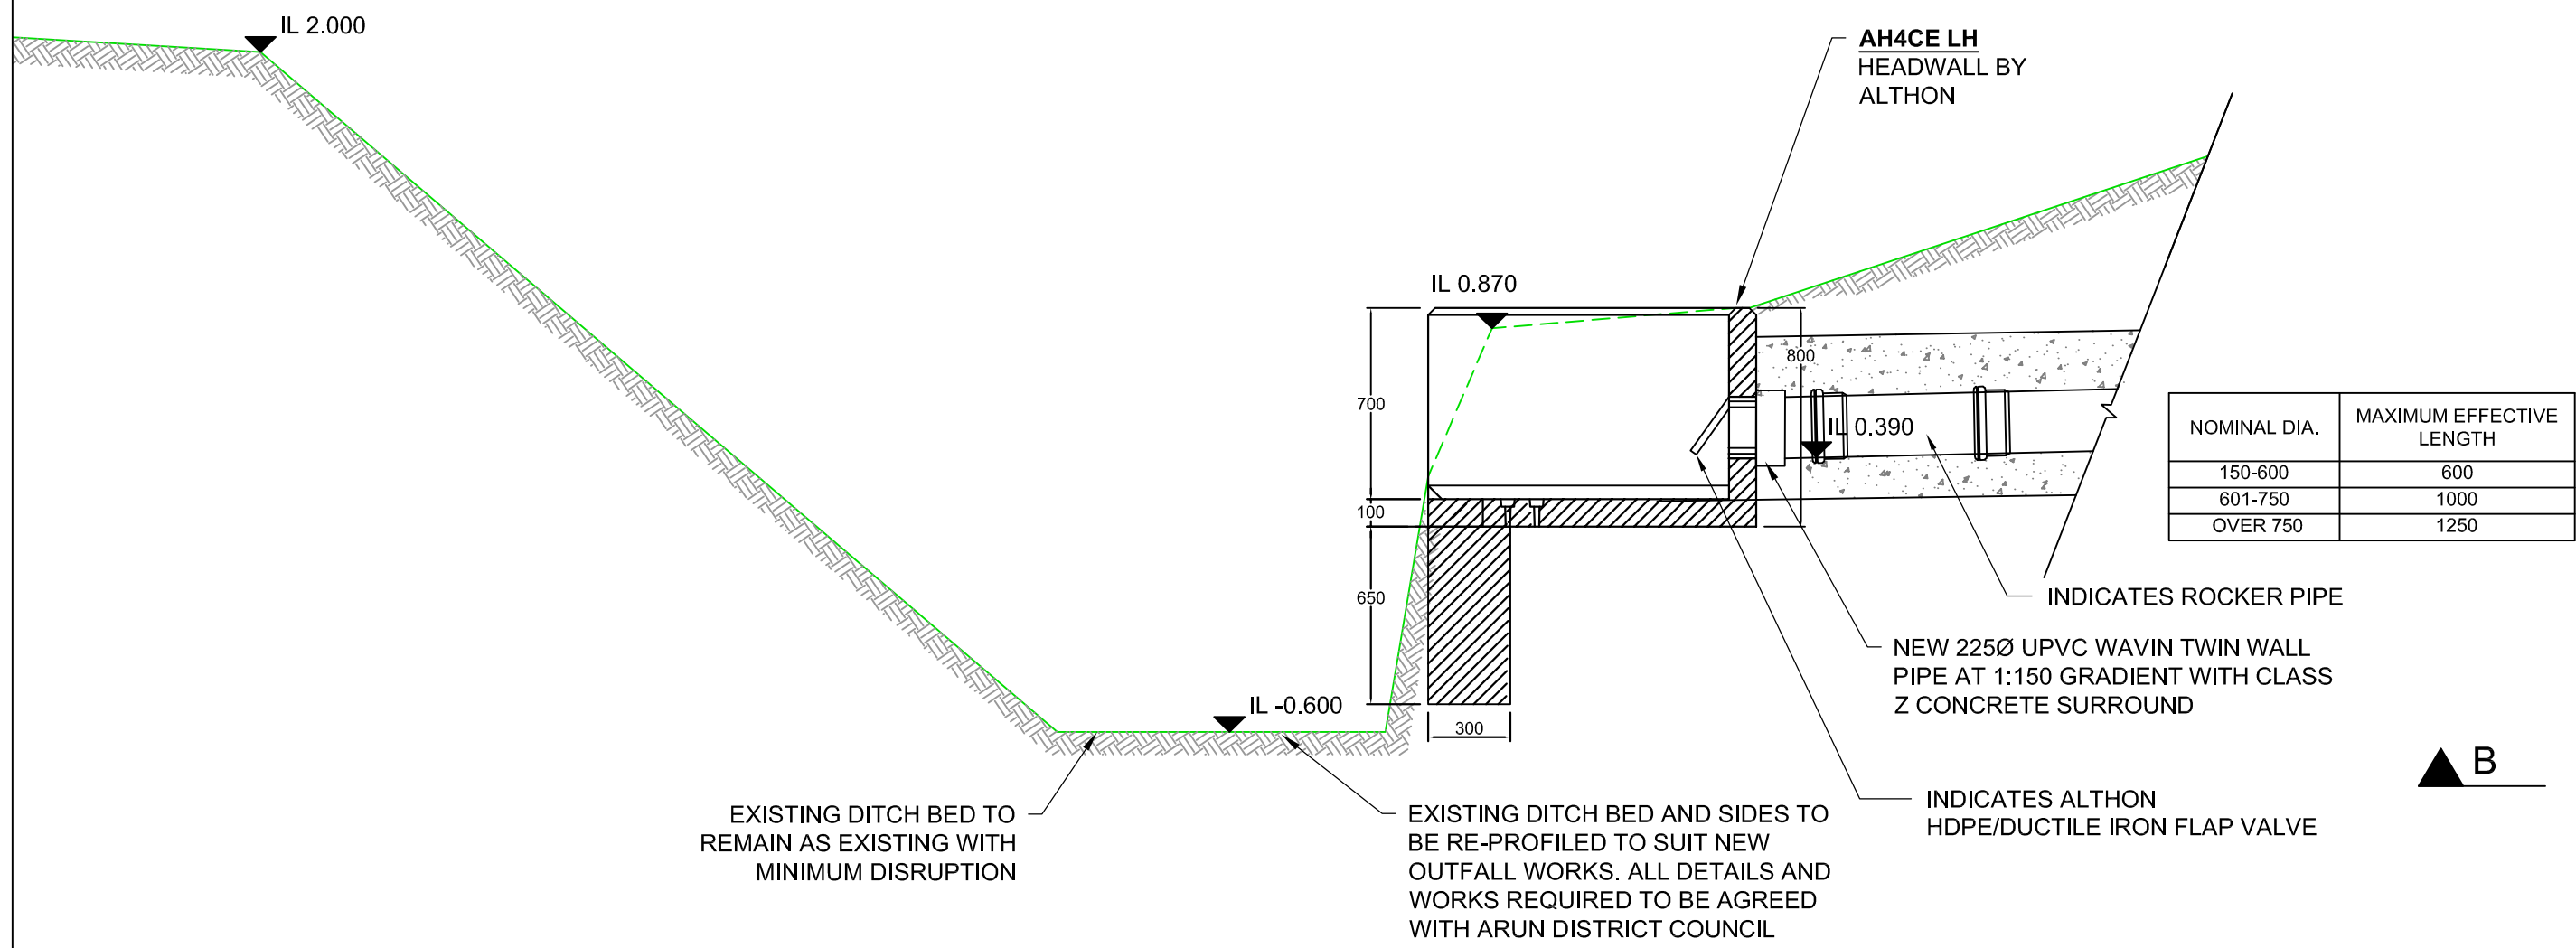

SECTION B-B
SEE DRAWING SBX-KSA-Z0-XX-DR-C-6800
FOR PLAN

B

B

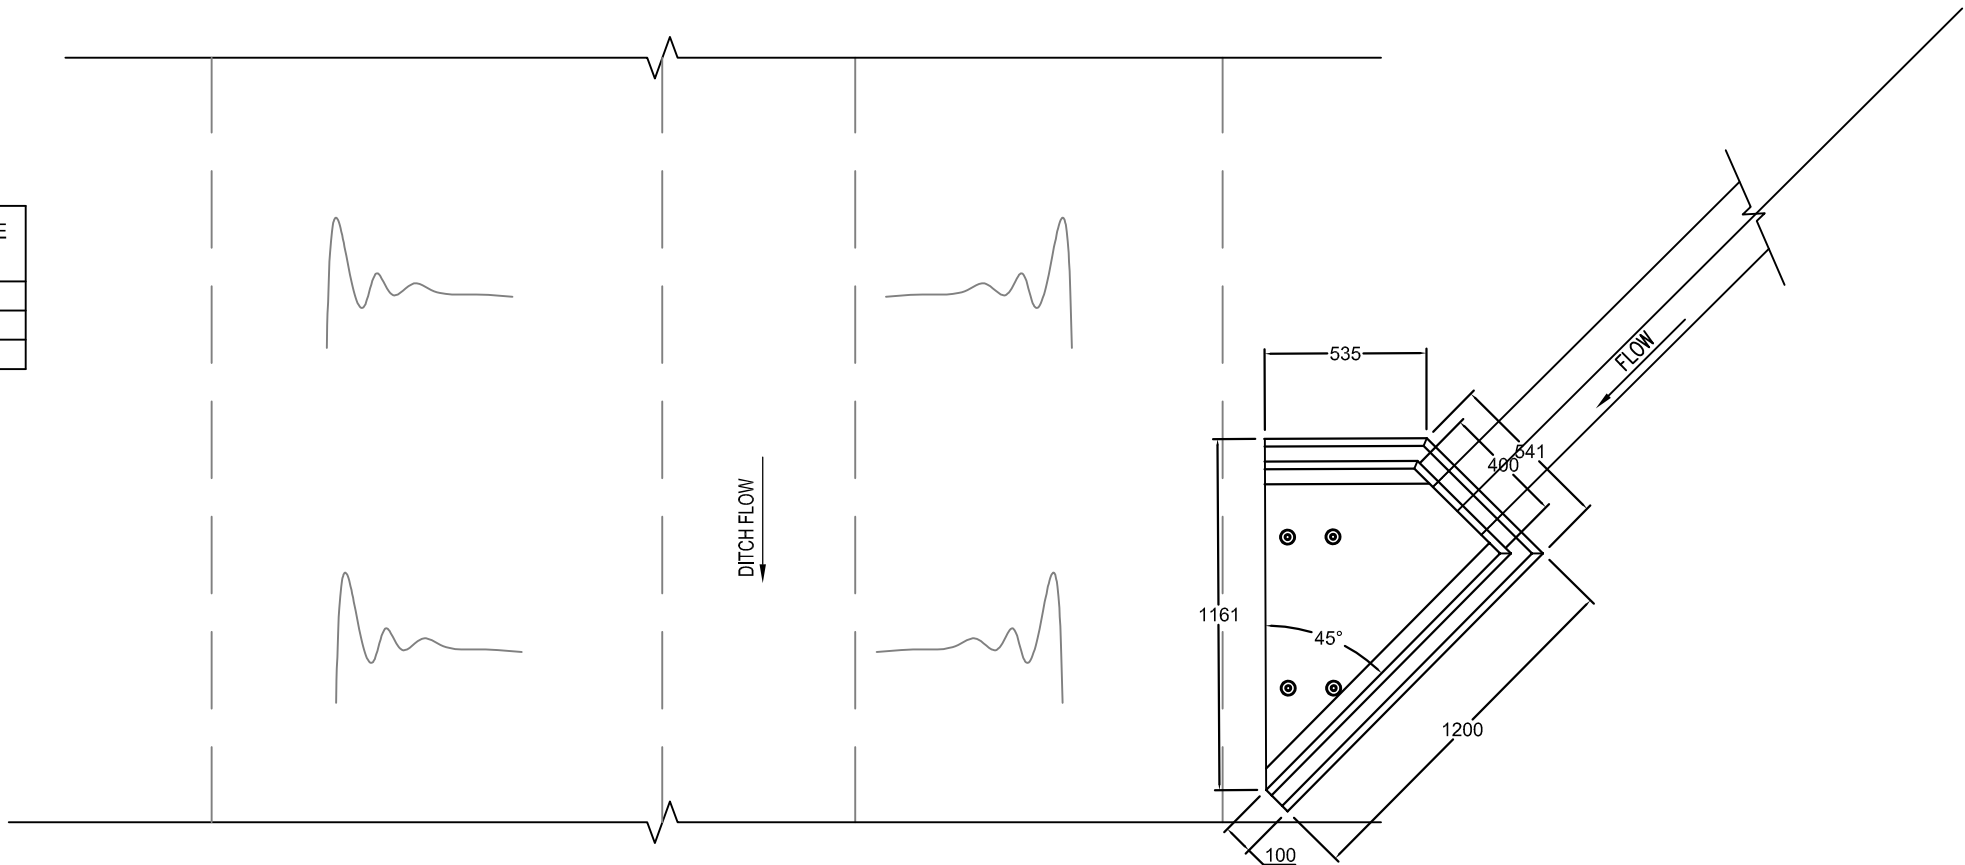

PLAN

KEY PLAN


NOTES

- All dimensions are to be checked on site before the commencement of works. Any discrepancies are to be reported to the Architect & Engineer for verification. Figured dimensions only are to be taken from this drawing.
- The DWG file is issued for the purposes of coordination only and do not represent formal drawing issue and are not to be reprinted in any form. Formal issue of drawings is via DWF, Adobe PDF files and/or hard copies and their associated information issue sheets.
- Note that all care has been taken with the export of DWG files and their content, but we recommend that you make due dimensional checks before using any DWG file information. Any errors found are to be reported to Hydrock immediately.

AS BUILT ISSUE					
C04	O.DAVIS	22.07.21	D.GALLIMORE	22.07.21	D.GALLIMORE 22.07.21
HEALTH AND SAFETY FILE ISSUE					
C03	J.SHIMMIN	11.06.21	D.GALLIMORE	11.06.21	M. GRIFFIN 11.06.21
ISSUED FOR CONSTRUCTION					
C02	D. GALLIMORE	16/12/20	D.GALLIMORE	16/12/20	M. GRIFFIN 16/12/20
ISSUED FOR CONSTRUCTION					
C01	D. GALLIMORE	24/07/20	D.GALLIMORE	24/07/20	M. GRIFFIN 24/07/20
ISSUED FOR CONTRACT					
P04	R.HUNT	13/03/20	D.GALLIMORE	13/03/20	M. GRIFFIN 13/03/20
REVISED FOLLOWING COMMENTS (AS CLOUDED)					
P03	D. GALLIMORE	15/11/19	M. GRIFFIN	15/11/19	M. GRIFFIN 15/11/19
REVISED FOLLOWING COMMENTS (AS CLOUDED)					
P02	D. GALLIMORE	06/11/19	M. GRIFFIN	06/11/19	M. GRIFFIN 06/11/19
TENDER ISSUE					
P01	A.TODD	17/10/19	J.MAGEE	17/10/19	M.GRIFFIN 17/10/19
REVISION NOTES/COMMENTS					
REV	DRAWN BY	DATE	CHECKED BY	DATE	APPROVED BY DATE

Merchants' House North
Wapping Road
Bristol
BS1 4RW
t: +44 (0)117 945 9225
e: bristolcentral@hydrock.com

CLIENT		
LANDLINK ESTATES		
PROJECT		
SALTBOX BOGNOR REGIS		
TITLE		
HEADWALL DETAILS		
HYDROCK PROJECT NO. C-13319-C		SCALE @ A1 1:25
STATUS DESCRIPTION AS BUILT ISSUE		STATUS A
DRAWING NO. (PROJECT CODE-ORIGINATOR-ZONE-LEVEL-TYPE-ROLE-NUMBER) SAL-HYD-00-ZZ-DR-C-7110		REVISION C04

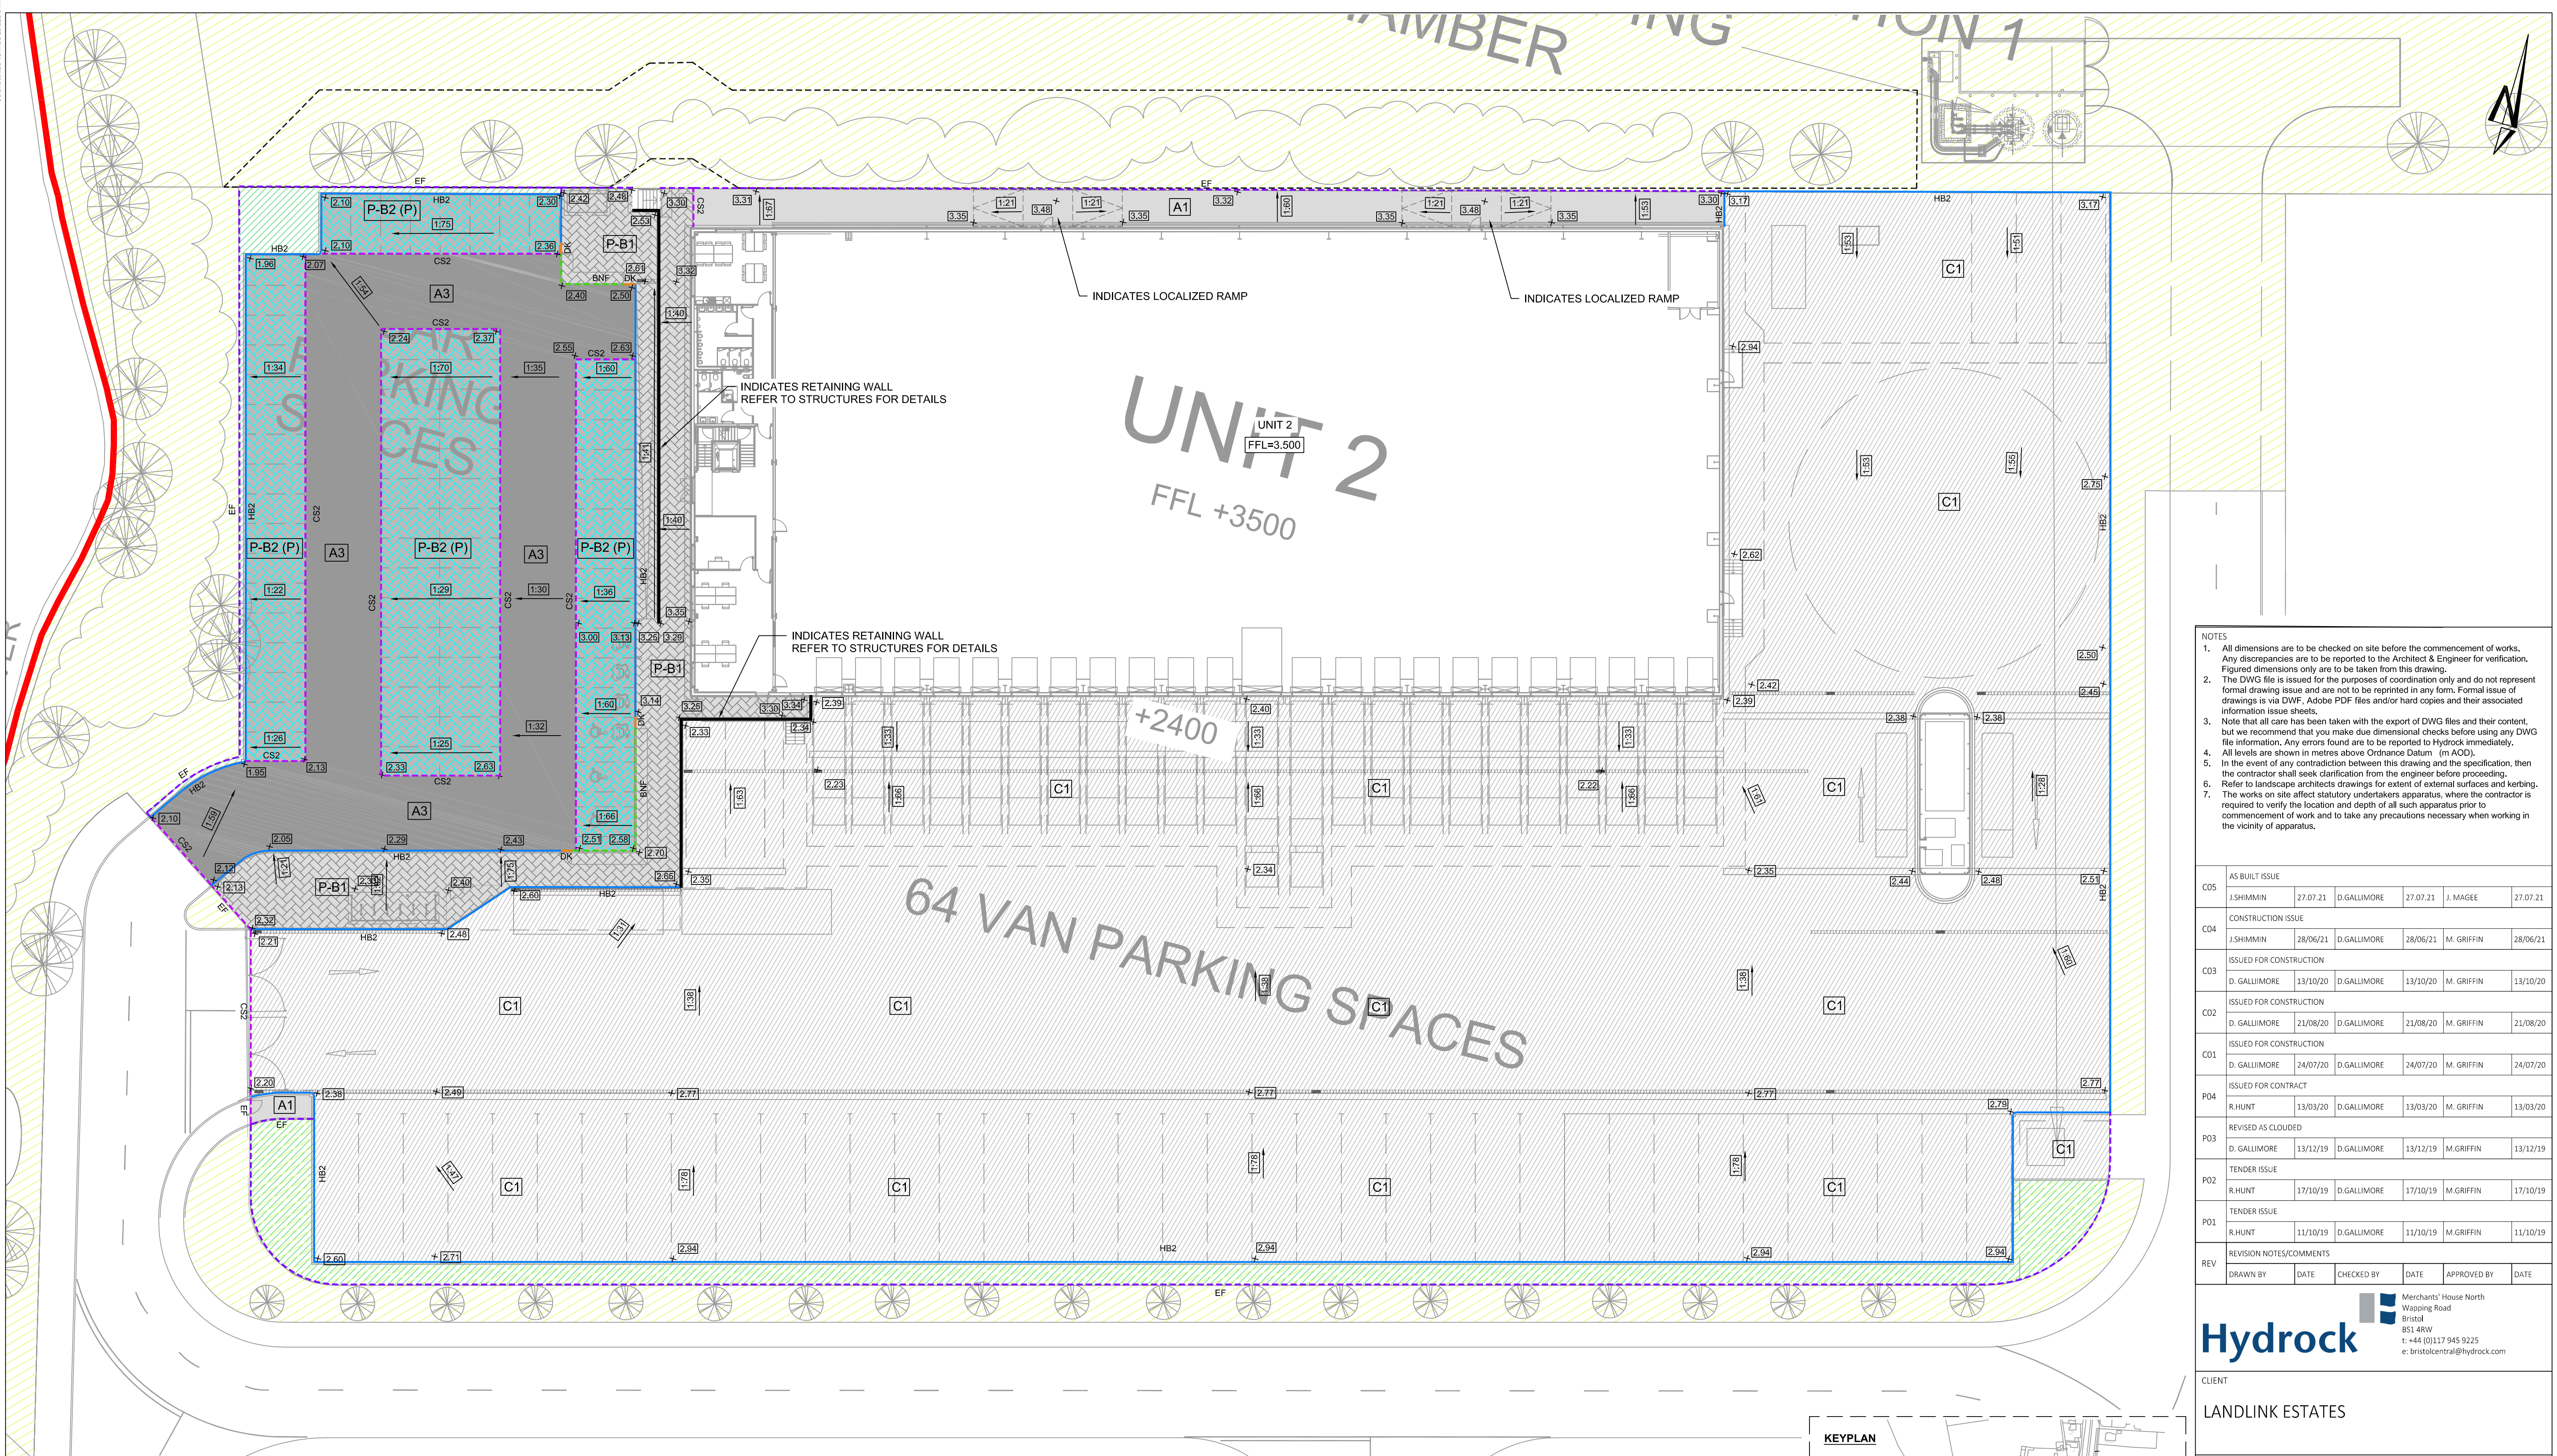

- NOTES
1. All dimensions are to be checked on site before the commencement of works. Any discrepancies are to be reported to the Architect & Engineer for verification. Figured dimensions only are to be taken from this drawing.
 2. The DWG file is issued for the purposes of coordination only and do not represent formal drawing issue and are not to be reprinted in any form. Formal issue of drawings is via DWG, Adobe PDF files and/or hard copies and their associated information issue sheets.
 3. Note that all care has been taken with the export of DWG files and their content, but we recommend that you make due dimensional checks before using any DWG file information. Any errors found are to be reported to Hydrock immediately.
 4. All levels are shown in metres above Ordnance Datum (m AOD).
 5. In the event of any contradiction between this drawing and the specification, then the contractor shall seek clarification from the engineer before proceeding.
 6. Refer to landscape architects drawings for extent of external surfaces and kerbing.
 7. The works on site affect statutory undertakers apparatus, where the contractor is required to verify the location and depth of all such apparatus prior to commencement of work and to take any precautions necessary when working in the vicinity of apparatus.

AS BUILT ISSUE					
C05	J.SHIMMIN	27.07.21	D.GALLIMORE	27.07.21	J. MAGEE 27.07.21
CONSTRUCTION ISSUE					
C04	J.SHIMMIN	28/06/21	D.GALLIMORE	28/06/21	M. GRIFFIN 28/06/21
ISSUED FOR CONSTRUCTION					
C03	D. GALLIMORE	13/10/20	D.GALLIMORE	13/10/20	M. GRIFFIN 13/10/20
ISSUED FOR CONSTRUCTION					
C02	D. GALLIMORE	21/08/20	D.GALLIMORE	21/08/20	M. GRIFFIN 21/08/20
ISSUED FOR CONSTRUCTION					
C01	D. GALLIMORE	24/07/20	D.GALLIMORE	24/07/20	M. GRIFFIN 24/07/20
ISSUED FOR CONTRACT					
P04	R.HUNT	13/03/20	D.GALLIMORE	13/03/20	M. GRIFFIN 13/03/20
REVISED AS CLOUDED					
P03	D. GALLIMORE	13/12/19	D.GALLIMORE	13/12/19	M.GRIFFIN 13/12/19
TENDER ISSUE					
P02	R.HUNT	17/10/19	D.GALLIMORE	17/10/19	M.GRIFFIN 17/10/19
TENDER ISSUE					
P01	R.HUNT	11/10/19	D.GALLIMORE	11/10/19	M.GRIFFIN 11/10/19
REVISION NOTES/COMMENTS					
REV	DRAWN BY	DATE	CHECKED BY	DATE	APPROVED BY DATE


Merchants' House North
Wapping Road
Bristol
BS1 4RW
t: +44 (0)117 945 9225
e: bristolcentral@hydrock.com


CLIENT		LANDLINK ESTATES	
PROJECT		SALTBOX BOGNOR REGIS	
TITLE		UNIT 2 EXTERNAL WORKS	
HYDROCK PROJECT NO. C-13319-C		SCALE @ A1 1:250	
STATUS DESCRIPTION AS BUILT ISSUE		STATUS A	
DRAWING NO. (PROJECT CODE-ORIGINATOR-ZONE-LEVEL-TYPE-ROLE-NUMBER) SAL-HYD-PH1-ZZ-DR-C-7210		REVISION C05	

- LEGEND - SURFACE TYPES
- TARMAC:
- TYPE A1: ASPHALT PAVING CONSTRUCTION - PEDESTRIAN LOADING ONLY
 - TYPE A3: ASPHALT PAVING CONSTRUCTION - CARS, LIGHT VEHICLES & OCCASIONAL HGVS
- CONCRETE:
- TYPE C1: CONCRETE
- POROUS BLOCK:
- TYPE P-B2 (P): POROUS BLOCK PAVING CONSTRUCTION - CARS, LIGHT VEHICLES, NO COMMERCIAL VEHICLES
- BLOCK:
- TYPE P-B1: BLOCK PAVING CONSTRUCTION - PEDESTRIAN LOADING ONLY

- LEGEND - KERB TYPES
- HB2 HALF BATTERED KERB (TYPE HB2: 125mm UPSTAND)
 - SP SPLAY KERB (TYPE SP: 125mm UPSTAND)
 - BNF BULLNOSED KERB (TYPE BN: LAID FLUSH)
 - BN 6mm BULLNOSED KERB (TYPE BN: 6mm UPSTAND)
 - BN 25mm BULLNOSED KERB (TYPE BN: 25mm UPSTAND)
 - CS2 CHANNEL SQUARE KERB (TYPE CS2: LAID FLUSH)
 - EF FLAT TOP EDGING KERB (TYPE EF: LAID FLUSH)
 - TK TRANSITION KERB (TYPE TK/TR: UPSTAND KERB TO DROPPED KERB)
 - DK DROPPER KERB (TYPE DK/DR: UPSTAND KERB TO DROPPED KERB)

- LEGEND - LEVELS AND GRADIENTS
- + 00.000 PROPOSED SPOT LEVEL
 - + (00.00) EXISTING SPOT LEVEL
 - 1:100 PROPOSED GRADIENT
 - (1:100) EXISTING GRADIENT

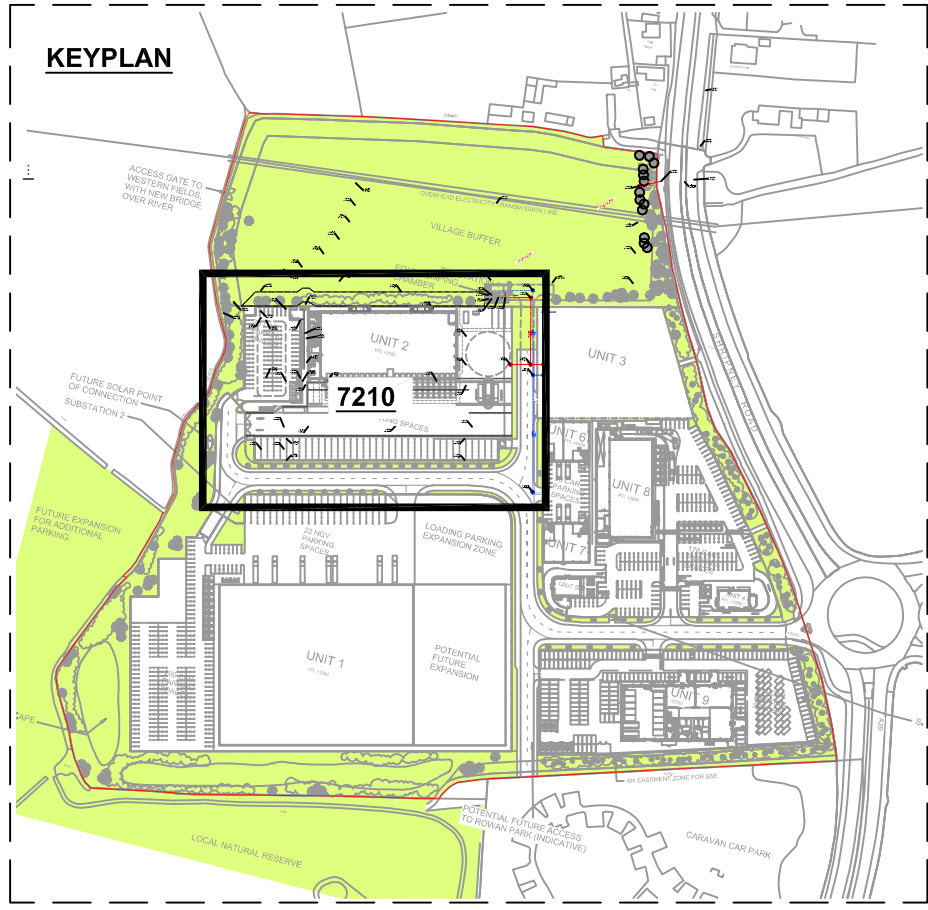

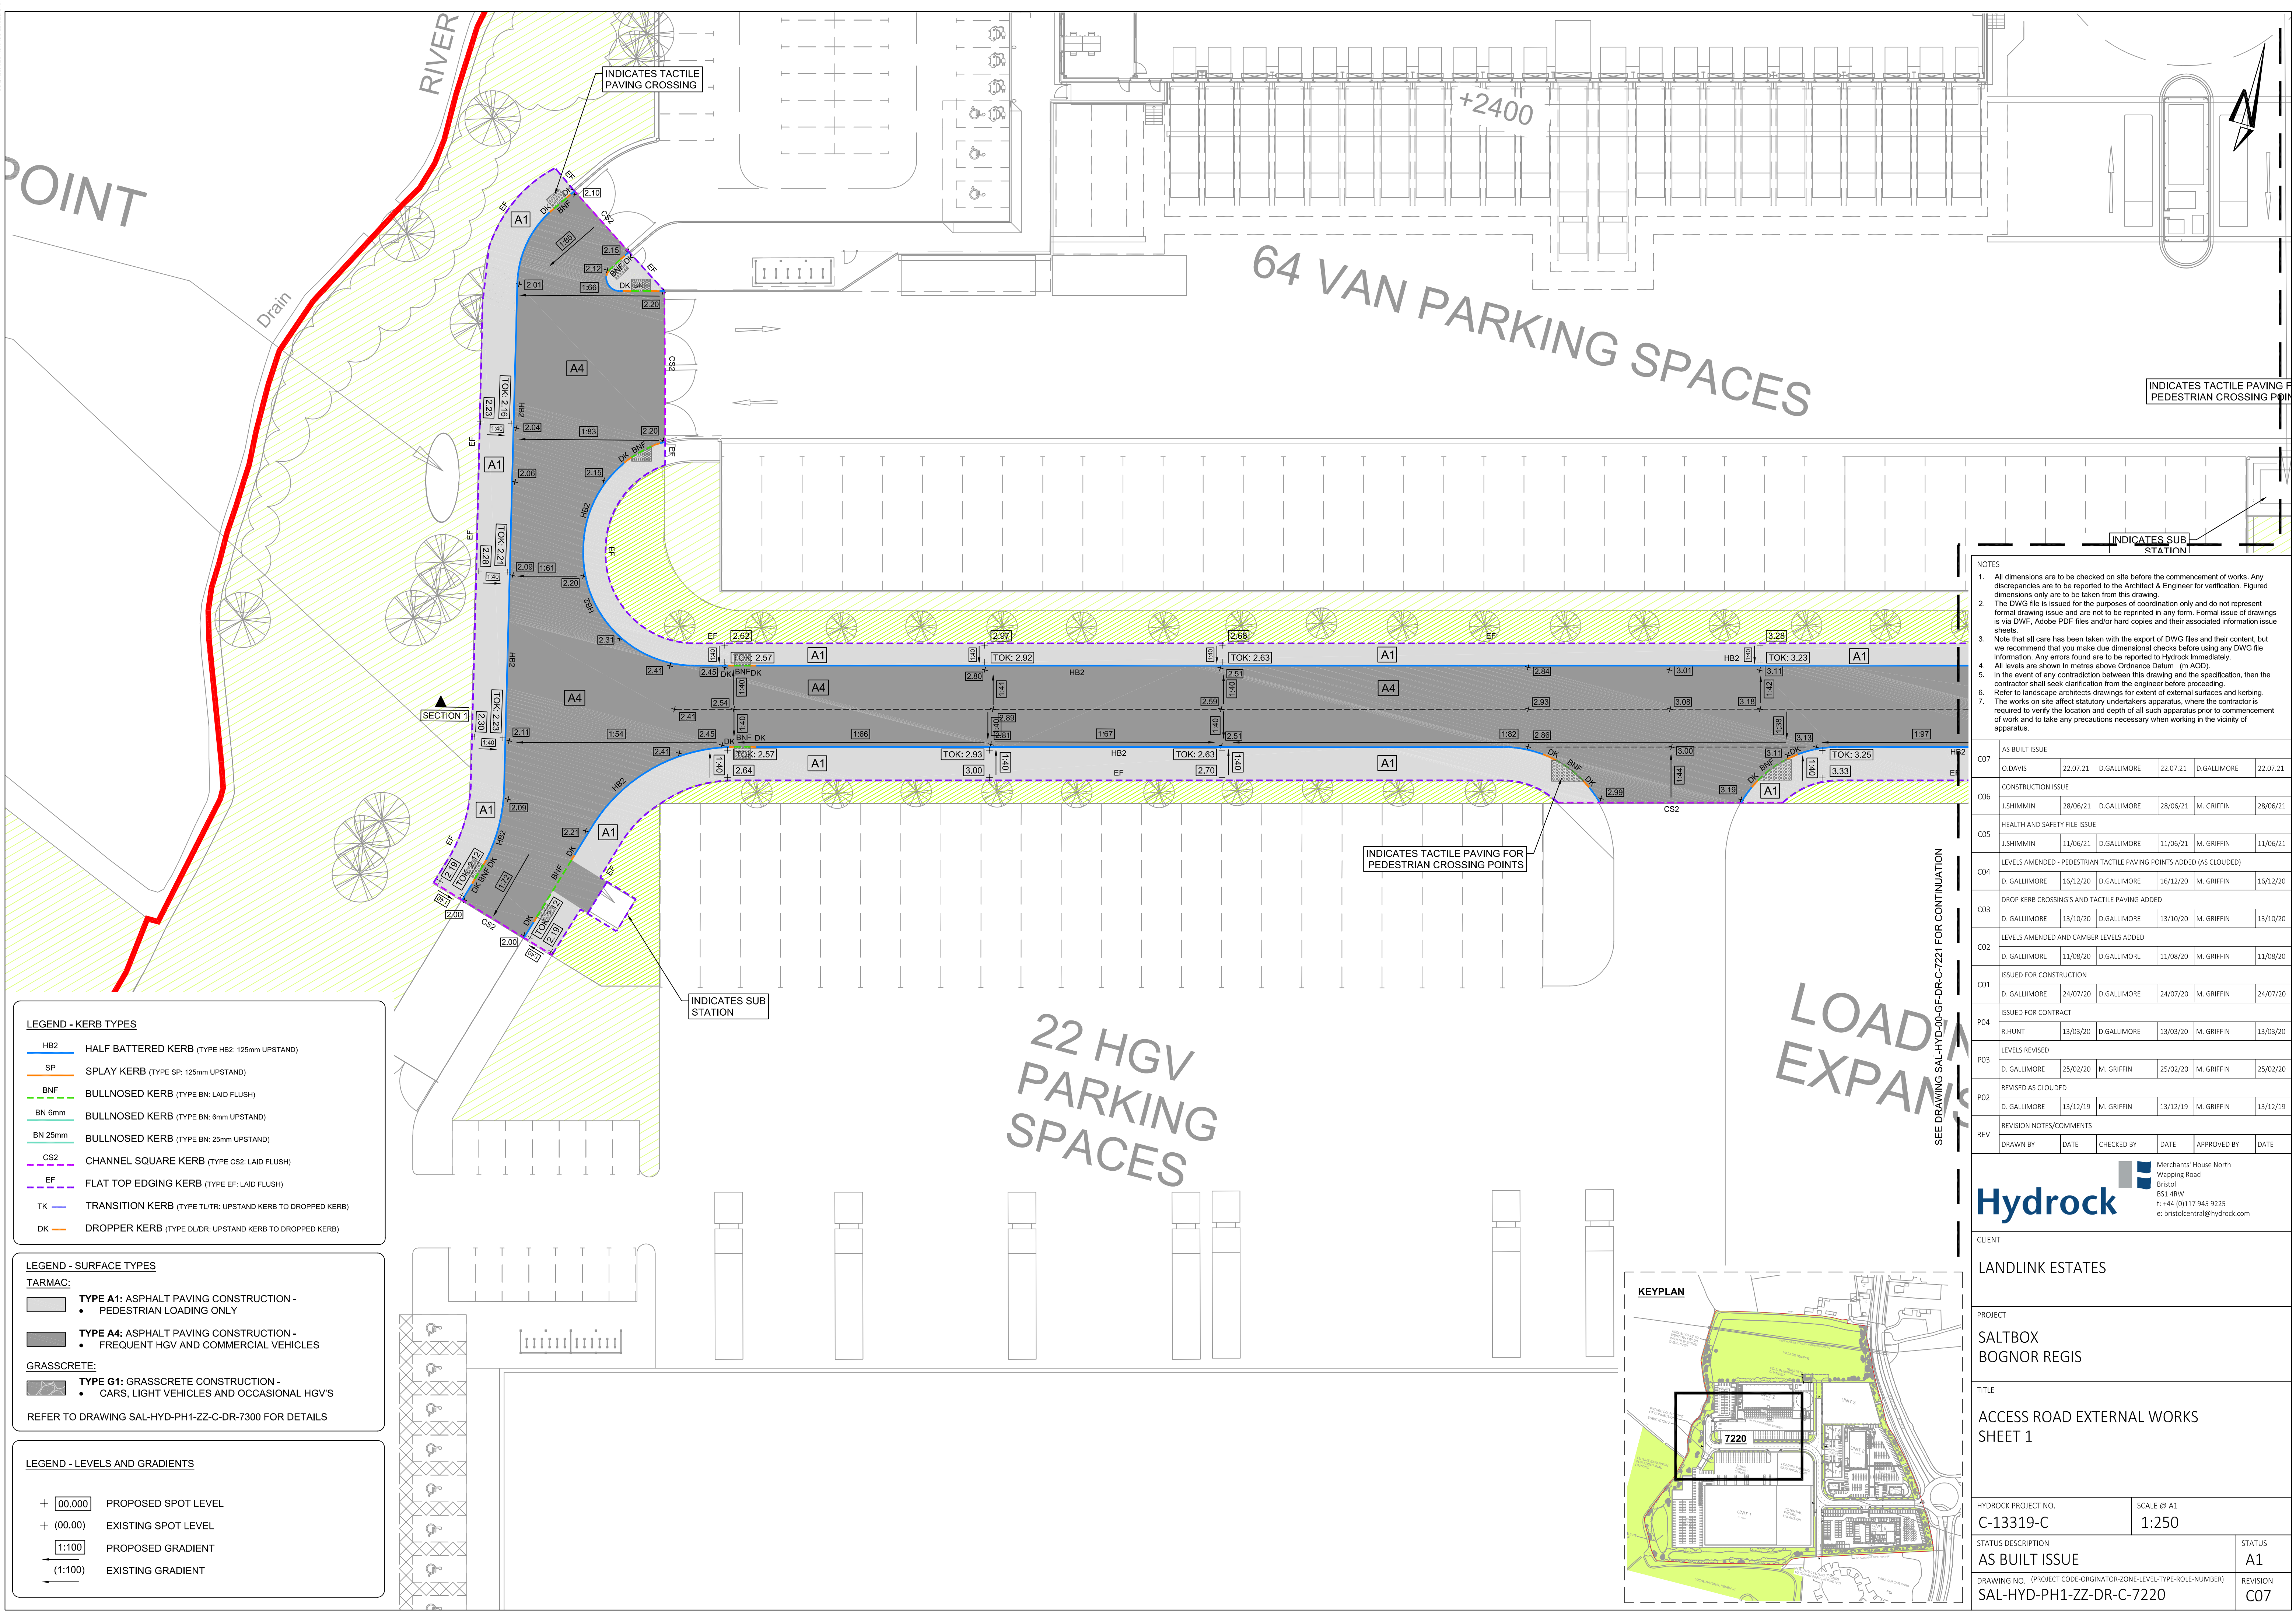

PLAN DISTRICT COUNCIL INFORMATION

POINT

Drain

RIVER

64 VAN PARKING SPACES

22 HGV PARKING SPACES

LOADING EXPANSION

LEGEND - KERB TYPES

- HB2 HALF BATTERED KERB (TYPE HB2: 125mm UPSTAND)
- SP SPLAY KERB (TYPE SP: 125mm UPSTAND)
- BNF BULLNOSED KERB (TYPE BN: LAID FLUSH)
- BN 6mm BULLNOSED KERB (TYPE BN: 6mm UPSTAND)
- BN 25mm BULLNOSED KERB (TYPE BN: 25mm UPSTAND)
- CS2 CHANNEL SQUARE KERB (TYPE CS2: LAID FLUSH)
- EF FLAT TOP EDGING KERB (TYPE EF: LAID FLUSH)
- TK TRANSITION KERB (TYPE TL/TR: UPSTAND KERB TO DROPPED KERB)
- DK DROPPER KERB (TYPE DL/DR: UPSTAND KERB TO DROPPED KERB)

LEGEND - SURFACE TYPES

TARMAC:

- TYPE A1: ASPHALT PAVING CONSTRUCTION - PEDESTRIAN LOADING ONLY
- TYPE A4: ASPHALT PAVING CONSTRUCTION - FREQUENT HGV AND COMMERCIAL VEHICLES

GRASSCRETE:

- TYPE G1: GRASSCRETE CONSTRUCTION - CARS, LIGHT VEHICLES AND OCCASIONAL HGV'S

REFER TO DRAWING SAL-HYD-PH1-ZZ-C-DR-7300 FOR DETAILS

LEGEND - LEVELS AND GRADIENTS

- + 00.000 PROPOSED SPOT LEVEL
- + (00.00) EXISTING SPOT LEVEL
- 1:100 PROPOSED GRADIENT
- (1:100) EXISTING GRADIENT

- NOTES**
- All dimensions are to be checked on site before the commencement of works. Any discrepancies are to be reported to the Architect & Engineer for verification. Figured dimensions only are to be taken from this drawing.
 - The DWG file is issued for the purposes of coordination only and does not represent formal drawing issue and are not to be reprinted in any form. Formal issue of drawings is via DWG, Adobe PDF files and/or hard copies and their associated information issue sheets.
 - Note that all care has been taken with the export of DWG files and their content, but we recommend that you make due dimensional checks before using any DWG file information. Any errors found are to be reported to Hydrock immediately.
 - All levels are shown in metres above Ordnance Datum (m AOD).
 - In the event of any contradiction between this drawing and the specification, then the contractor shall seek clarification from the engineer before proceeding.
 - Refer to landscape architects drawings for extent of external surfaces and kerbing.
 - The works on site affect statutory undertakers apparatus, where the contractor is required to verify the location and depth of all such apparatus prior to commencement of work and to take any precautions necessary when working in the vicinity of apparatus.

C07	AS BUILT ISSUE	O.DAVIS	22.07.21	D.GALLIMORE	22.07.21	D.GALLIMORE	22.07.21
C06	CONSTRUCTION ISSUE	J.SHIMMIN	28/06/21	D.GALLIMORE	28/06/21	M. GRIFFIN	28/06/21
C05	HEALTH AND SAFETY FILE ISSUE	J.SHIMMIN	11/06/21	D.GALLIMORE	11/06/21	M. GRIFFIN	11/06/21
C04	LEVELS AMENDED - PEDESTRIAN TACTILE PAVING POINTS ADDED (AS CLOUDED)	D. GALLIMORE	16/12/20	D.GALLIMORE	16/12/20	M. GRIFFIN	16/12/20
C03	DROP KERB CROSSINGS AND TACTILE PAVING ADDED	D. GALLIMORE	13/10/20	D.GALLIMORE	13/10/20	M. GRIFFIN	13/10/20
C02	LEVELS AMENDED AND CAMBER LEVELS ADDED	D. GALLIMORE	11/08/20	D.GALLIMORE	11/08/20	M. GRIFFIN	11/08/20
C01	ISSUED FOR CONSTRUCTION	D. GALLIMORE	24/07/20	D.GALLIMORE	24/07/20	M. GRIFFIN	24/07/20
P04	ISSUED FOR CONTRACT	R.HUNT	13/03/20	D.GALLIMORE	13/03/20	M. GRIFFIN	13/03/20
P03	LEVELS REVISED	D. GALLIMORE	25/02/20	M. GRIFFIN	25/02/20	M. GRIFFIN	25/02/20
P02	REVISED AS CLOUDED	D. GALLIMORE	13/12/19	M. GRIFFIN	13/12/19	M. GRIFFIN	13/12/19
REV	REVISION NOTES/COMMENTS	DRAWN BY	DATE	CHECKED BY	DATE	APPROVED BY	DATE

Hydrock Merchants' House North
Wapping Road
Bristol
BS1 4RW
t: +44 (0)117 945 9225
e: bristolcentral@hydrock.com

CLIENT
LANDLINK ESTATES

PROJECT
**SALTBOX
BOGNOR REGIS**

TITLE ACCESS ROAD EXTERNAL WORKS SHEET 1	HYDROCK PROJECT NO. C-13319-C	SCALE @ A1 1:250	STATUS AS BUILT ISSUE	A1
DRAWING NO. (PROJECT CODE-ORIGINATOR-ZONE-LEVEL-TYPE-ROLE-NUMBER) SAL-HYD-PH1-ZZ-DR-C-7220	REVISION C07			

