


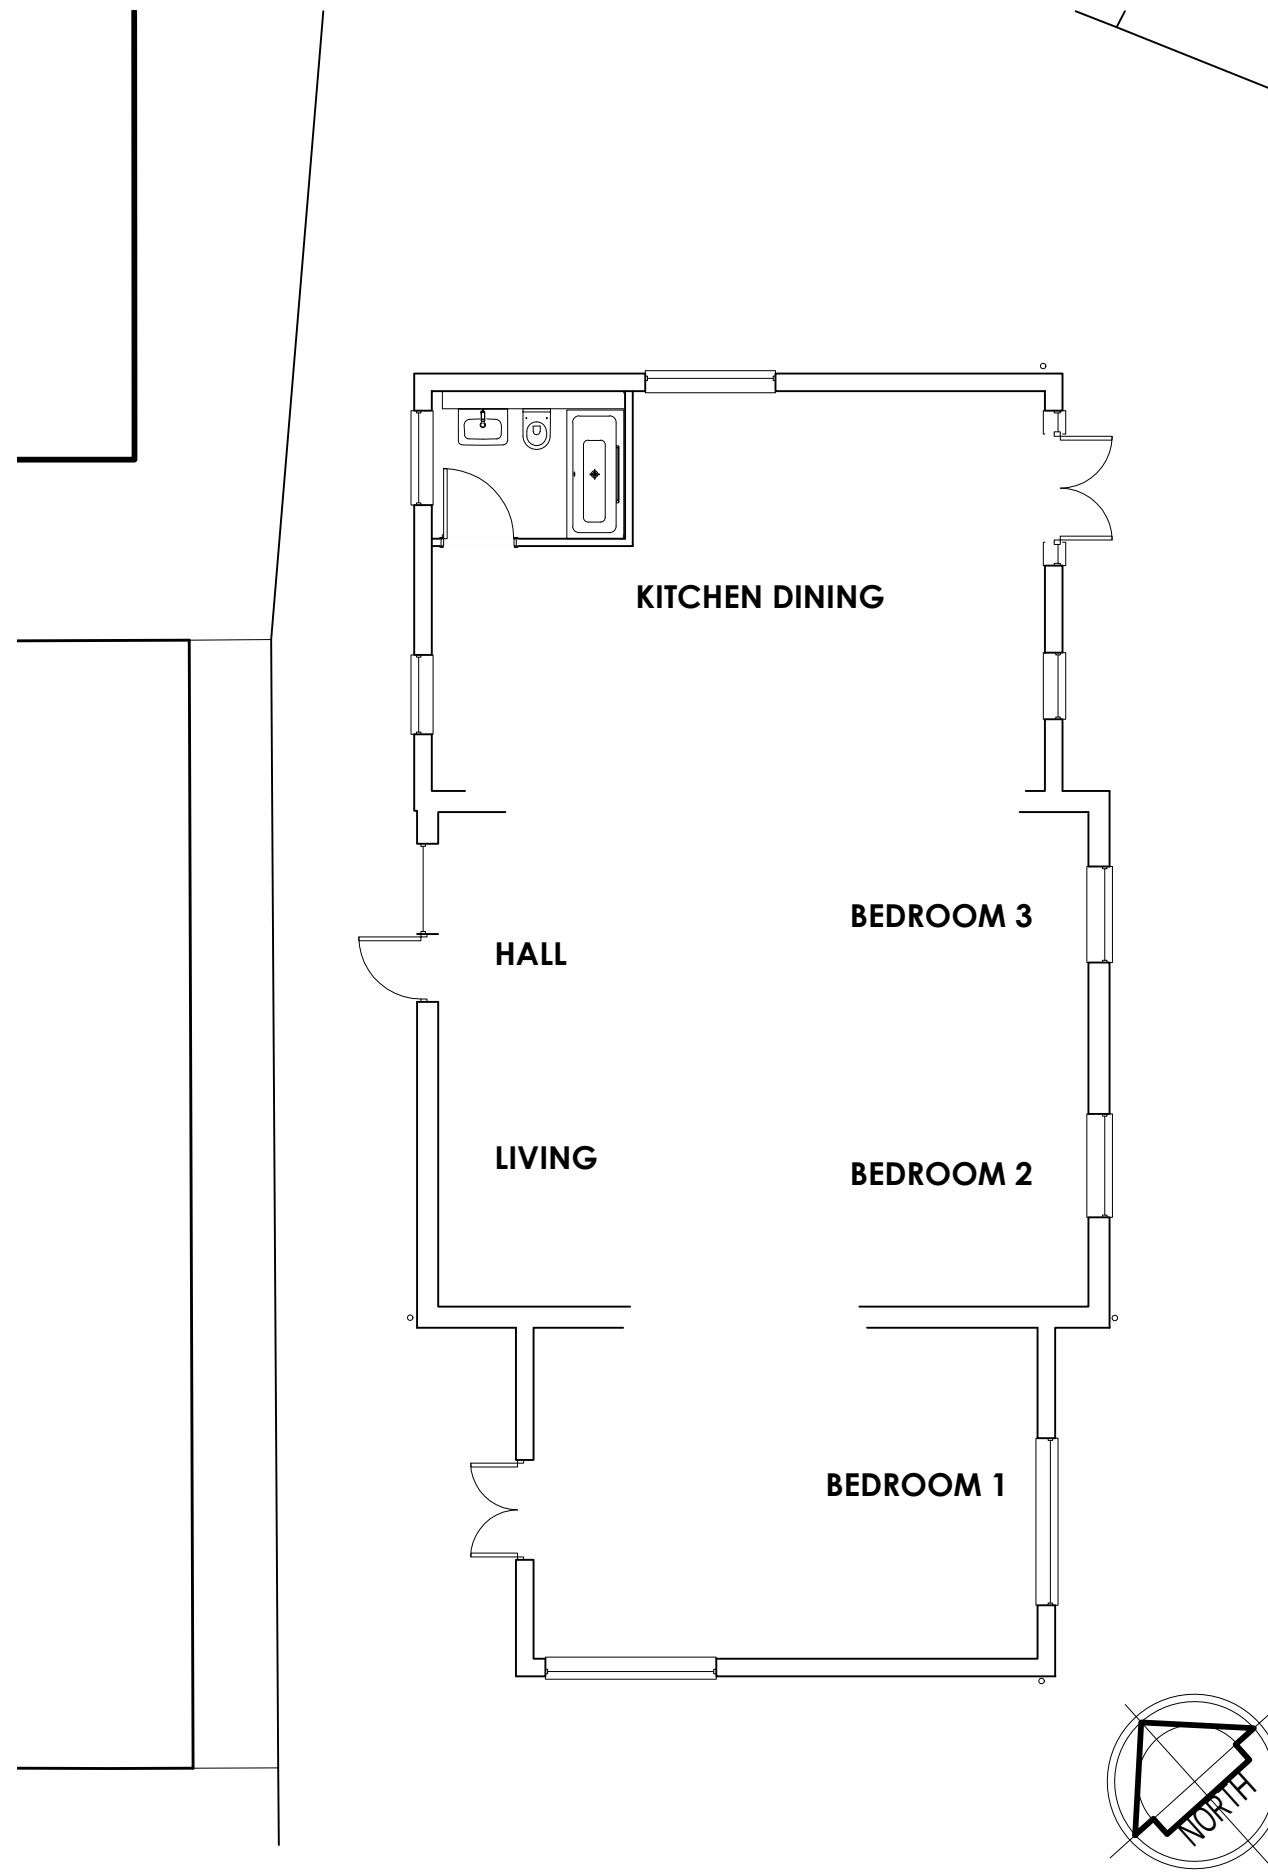

Floor plan 1:100 @ A3

steve hunting
ba (hons) arch. dipl. arch


8 Somerset gardens, Bognor Regis, West Sussex PO21 2AA Tel: 07986 049230 Email: steve.sharch@googlemail. com



Project: Extensions & New garage at: 266 Chichester Road,
Bognor Regis. PO21 5AX.
Drawing : PLANNING: As Built House floor plan & Elevations
Client: Ms Louisa Ussher



South West elevation 1:100 @ A3

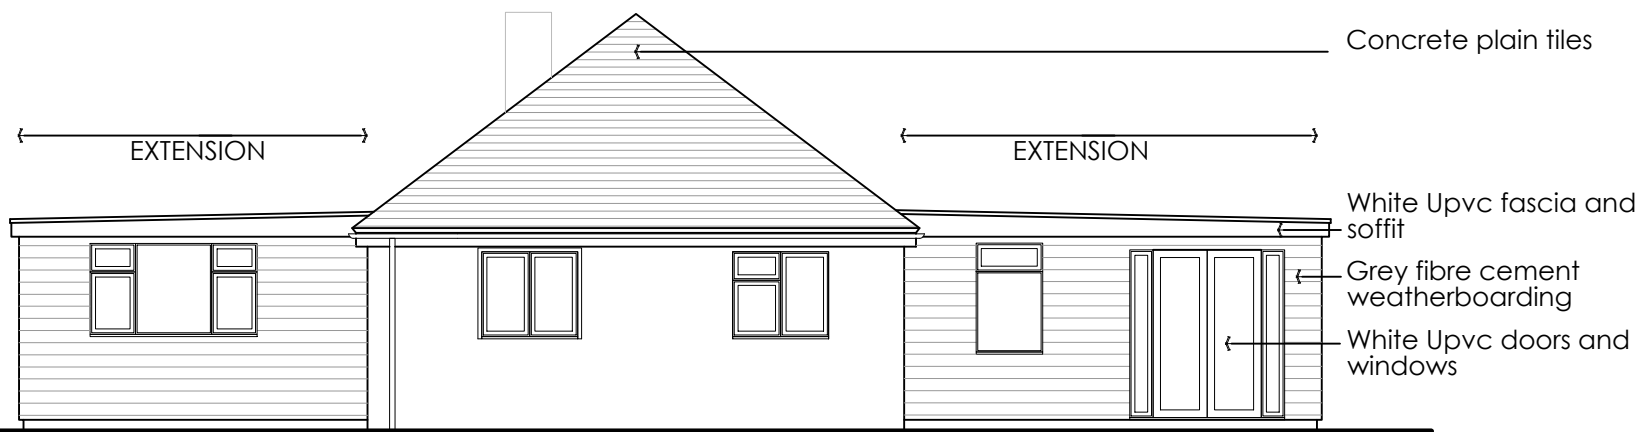

South East elevation 1:100 @ A3



North East elevation 1:100 @ A3



North West elevation 1:100 @ A3

Scale: 1:100 @ A3

Drawn by: SH

Date: Nov 2021

Project No: P21-0

Drwg No:

02