



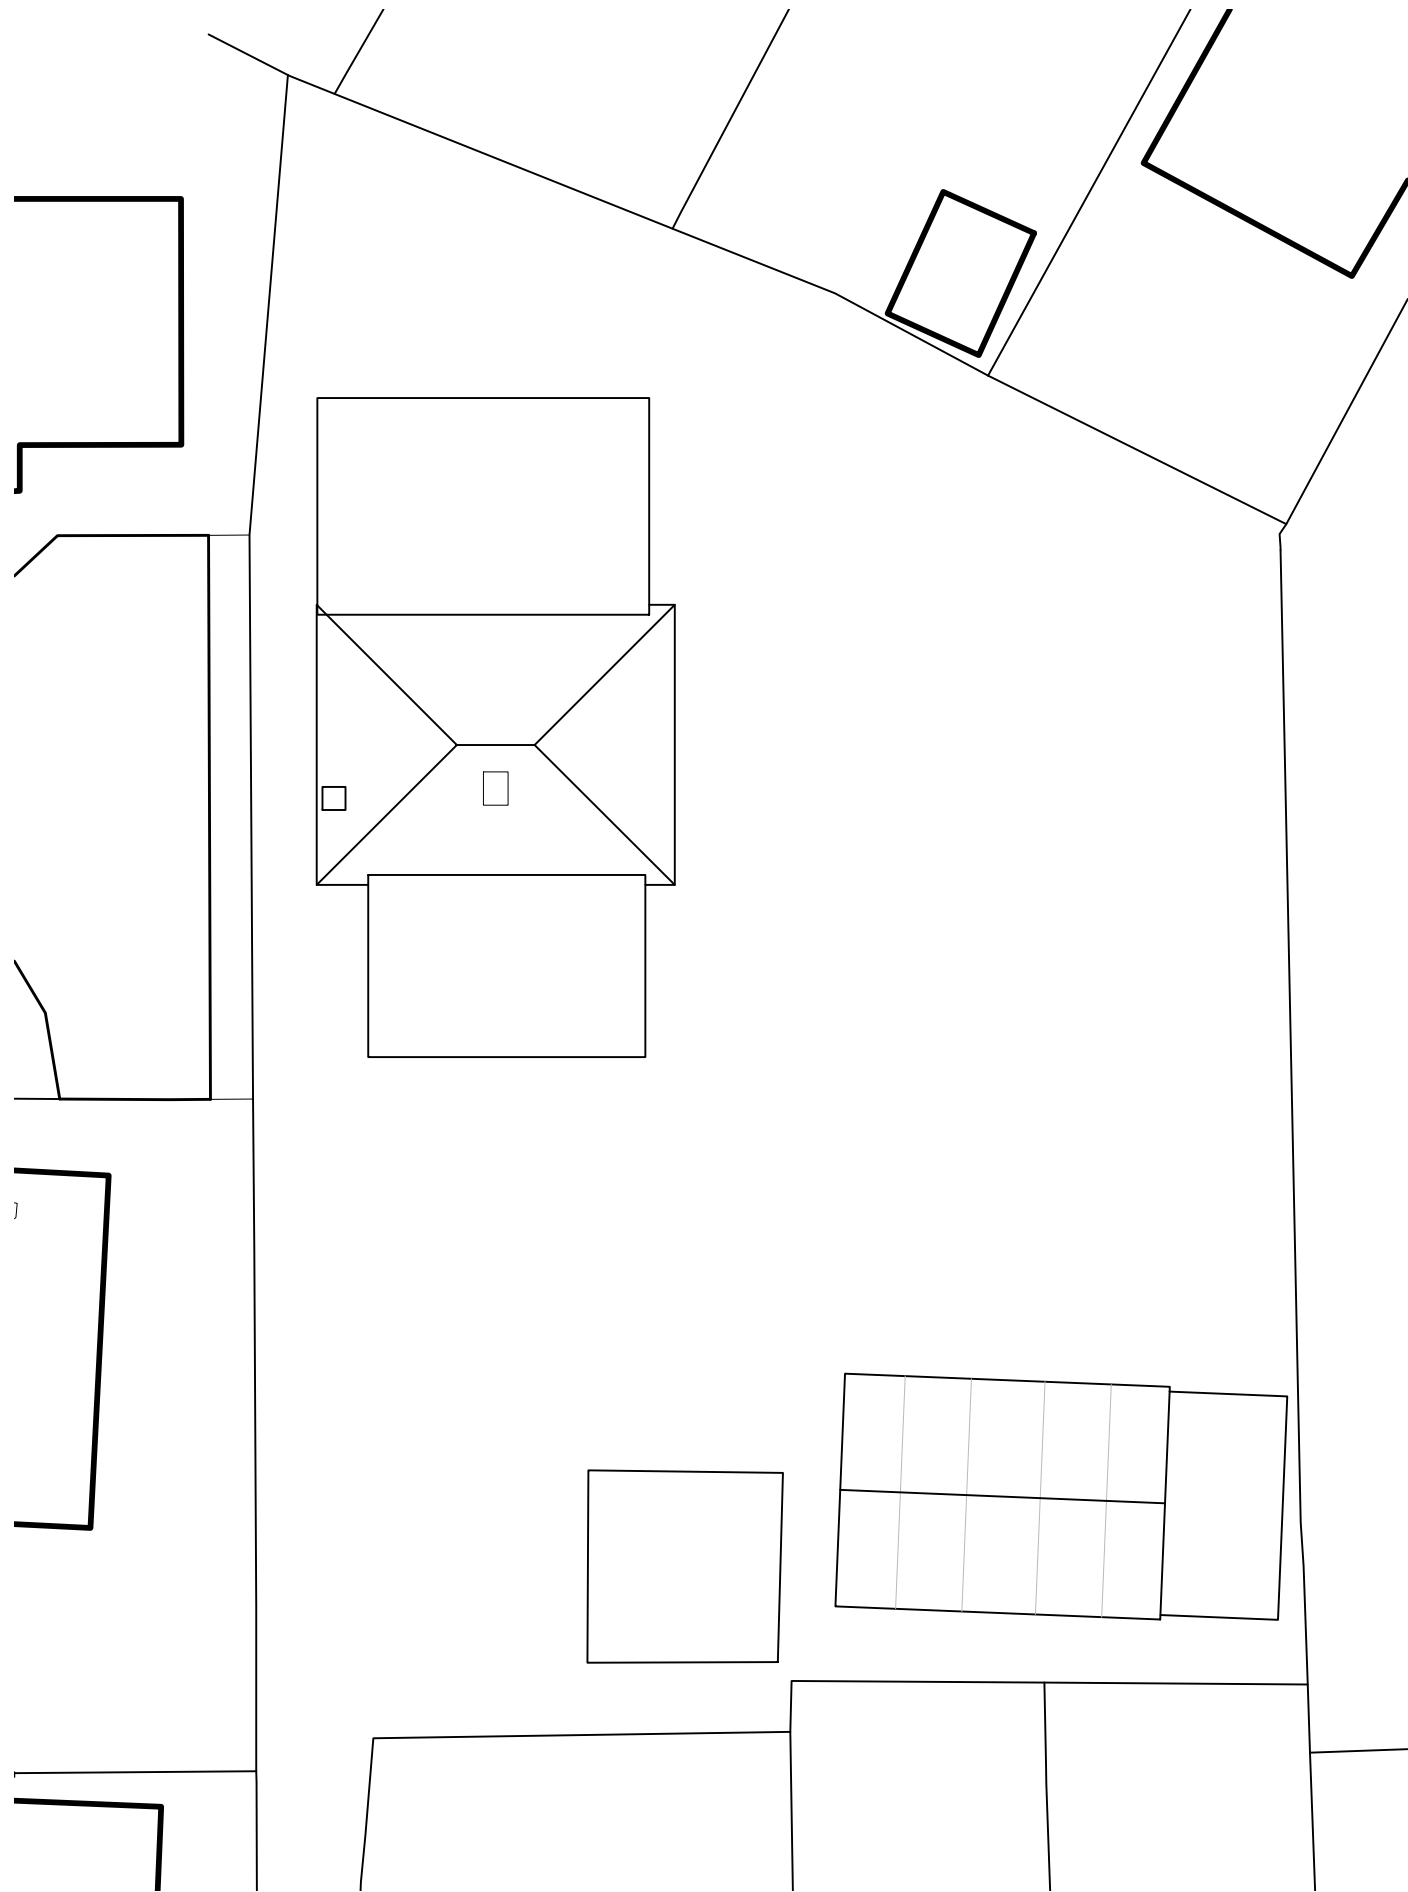

Site plan 1:200 @ A3



steve hunting
ba (hons) arch. dipl. arch

8 Somerset gardens, Bognor Regis, West Sussex PO21 2AA Tel: 07986 049230 Email: steve.sharch@googlemail. com

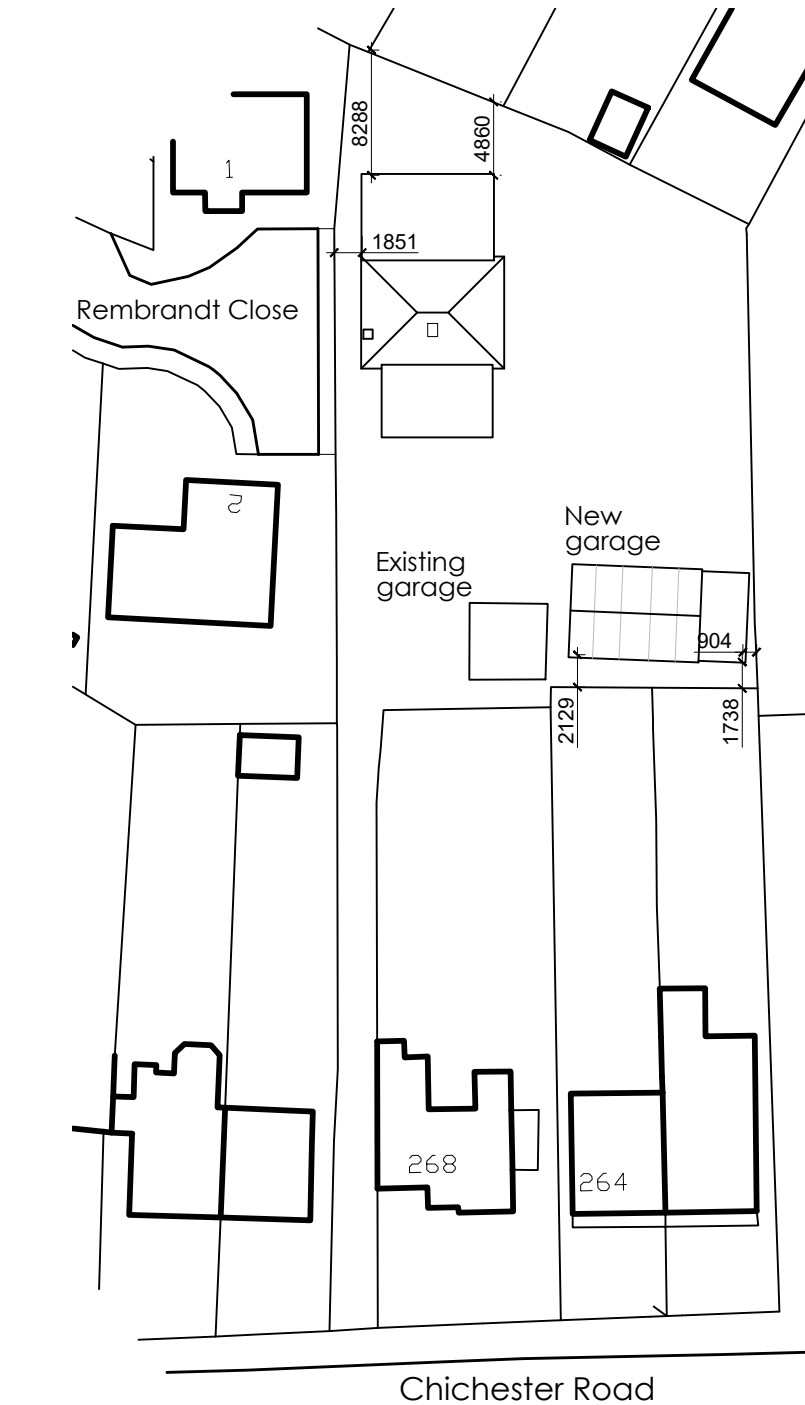

Block plan 1:500 @ A3


0 5 10 15 20 25

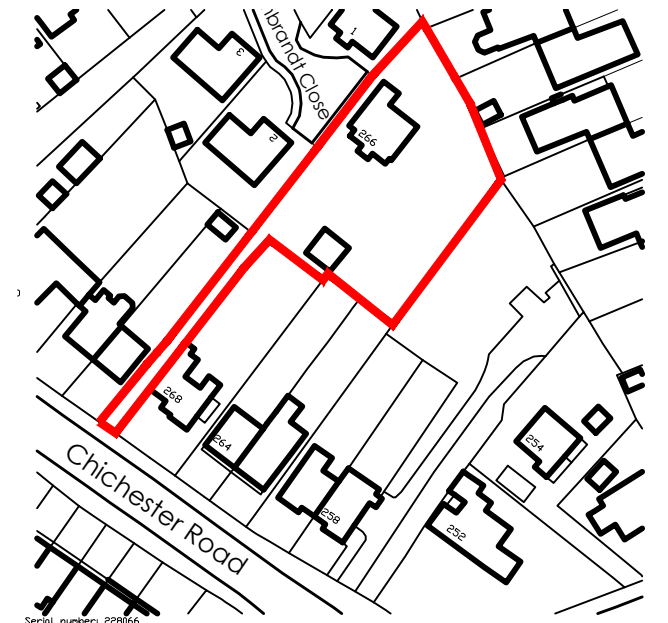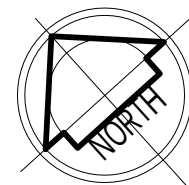

Serial number: 228066
© Crown copyright and database right 2021
Drainage Survey licence 100048957
Reproduction in whole or in part is prohibited
without the prior permission of DrainageSurvey

Site Location plan 1:1250 @ A3

0 5 10 15 20 25 30 35 40 45 50 55 60

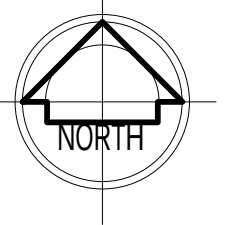

Project: Extensions & New garage at: 266 Chichester Road,
Bognor Regis. PO21 5AX.
Drawing : PLANNING: As Built Location Block & Site plans
Client: Ms Louisa Ussher

Scale: 1:1250, 1:500
& 1:200 @A3
Drawn by: SH
Date: Nov 2021

Project No: P21-0
Drwg No: 01