



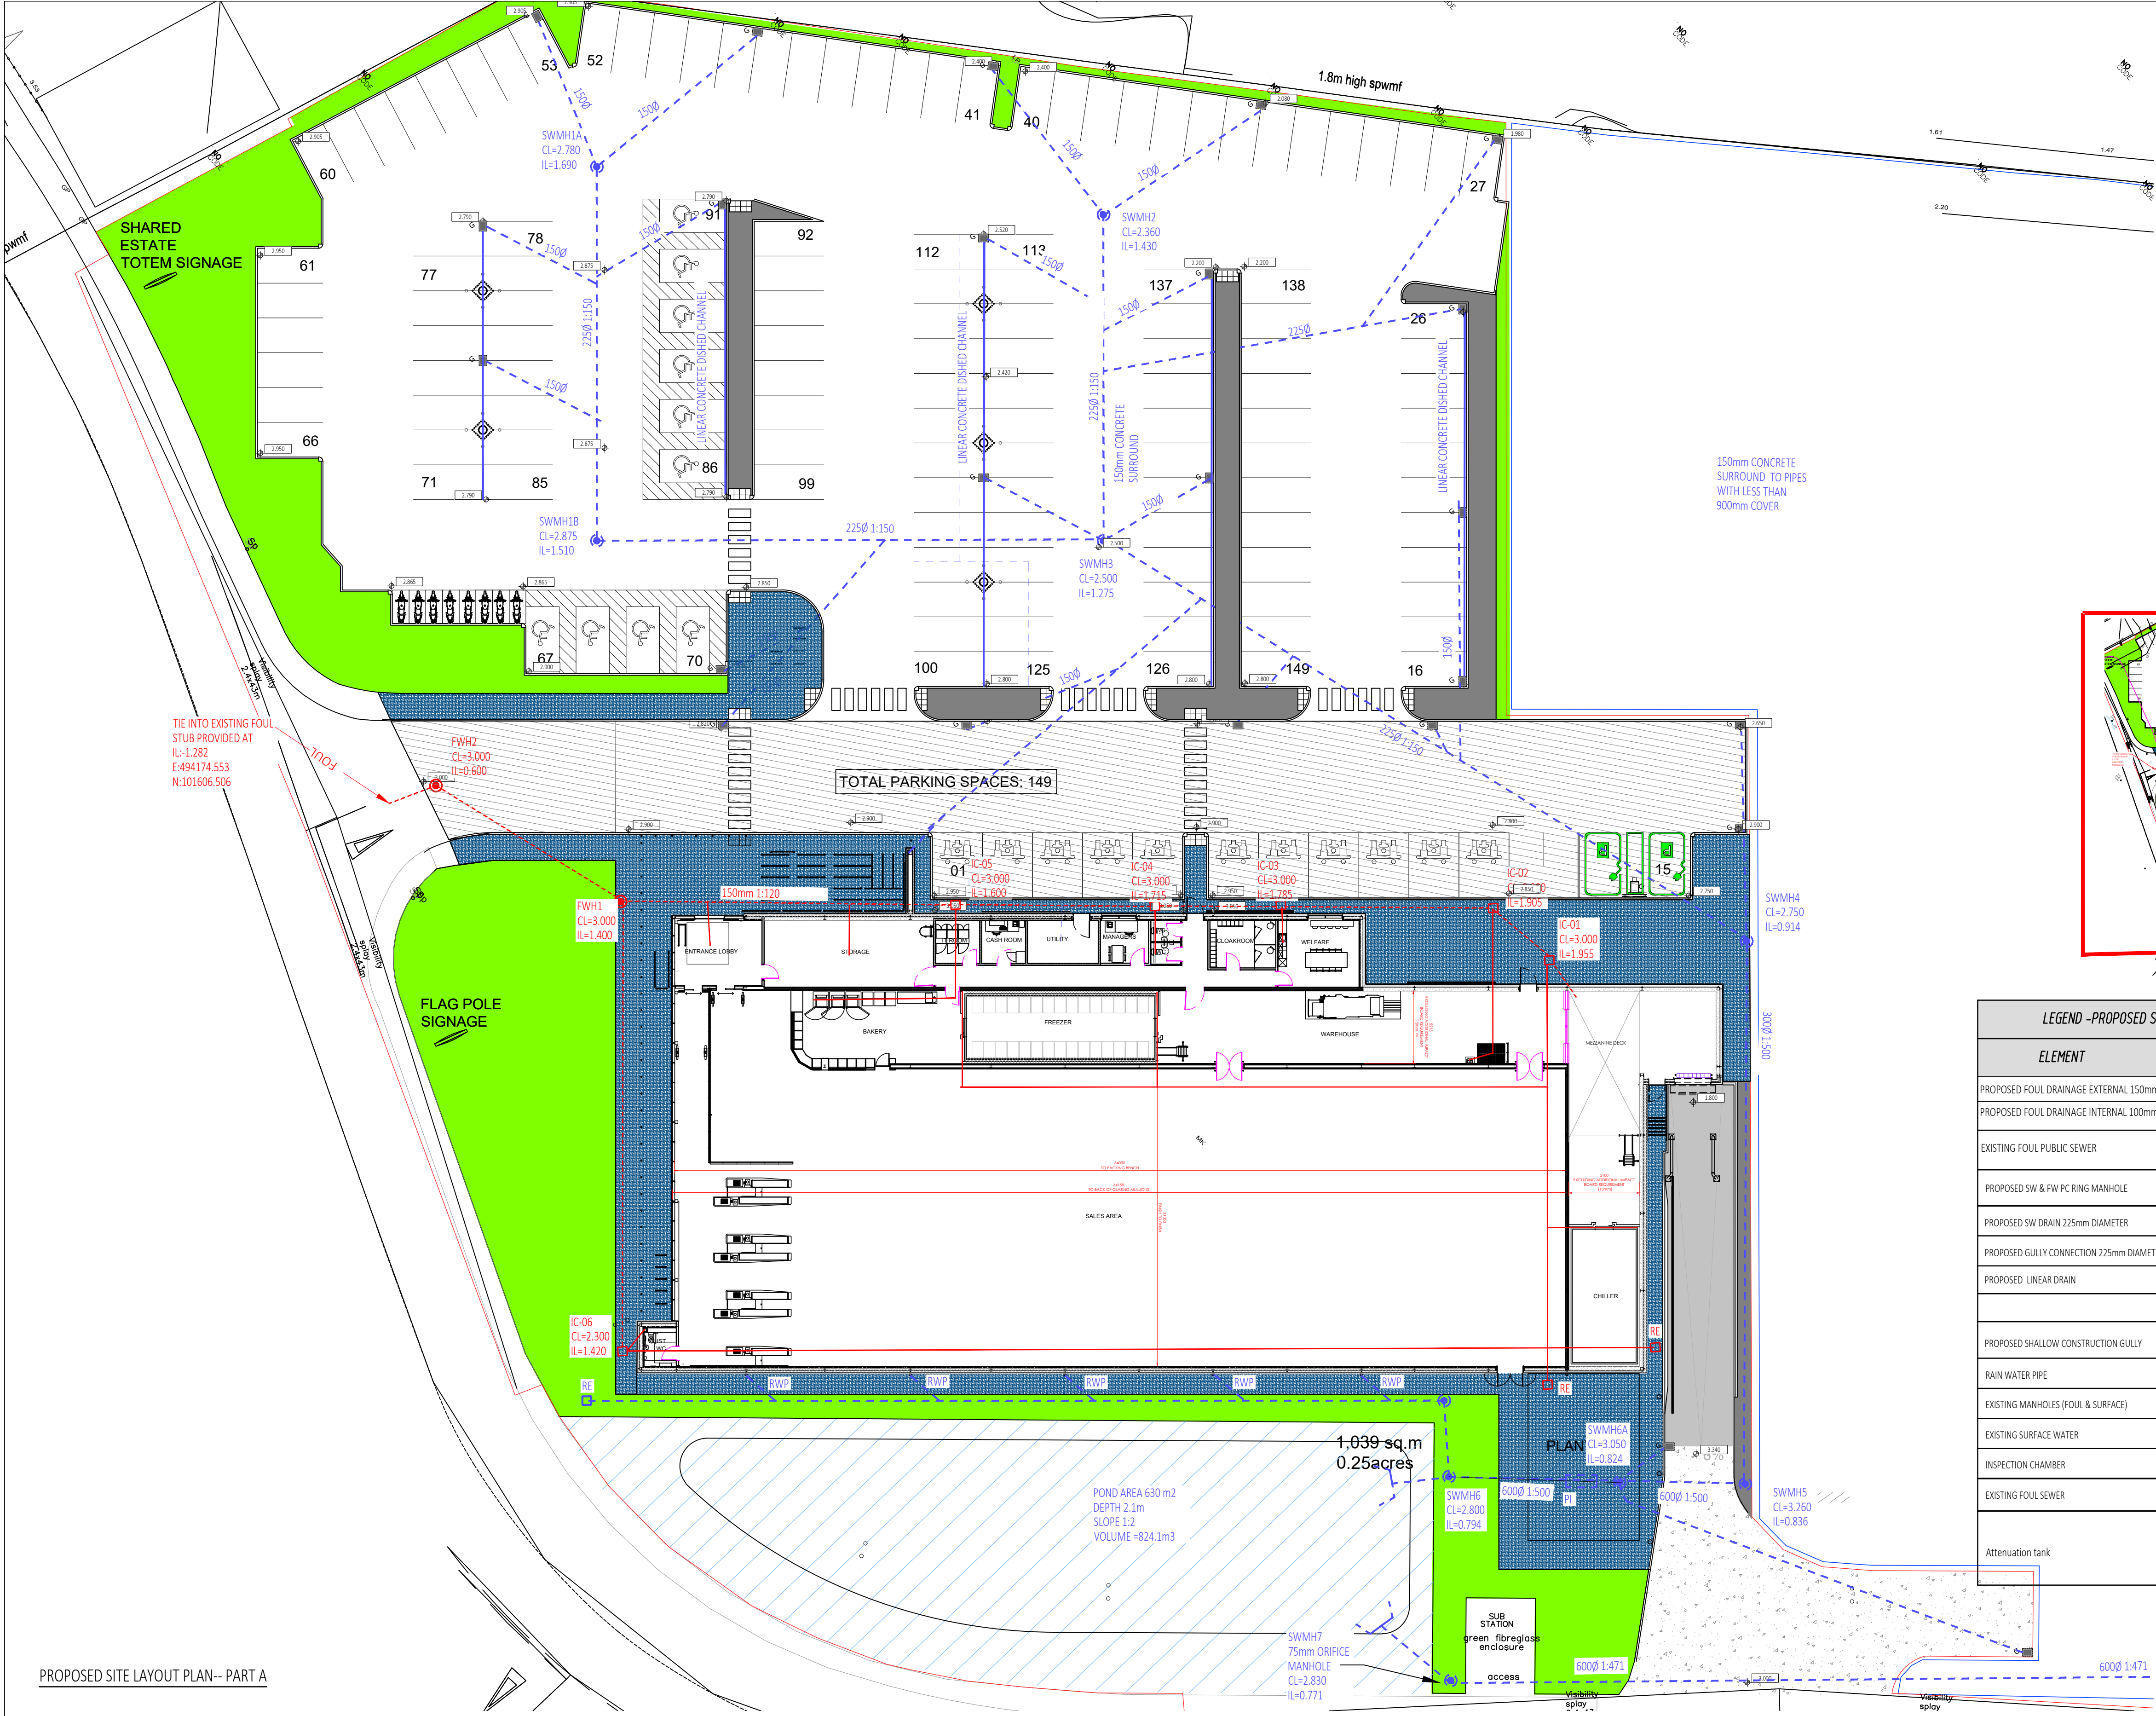


PROPOSED SITE LAYOUT PLAN-- PART A

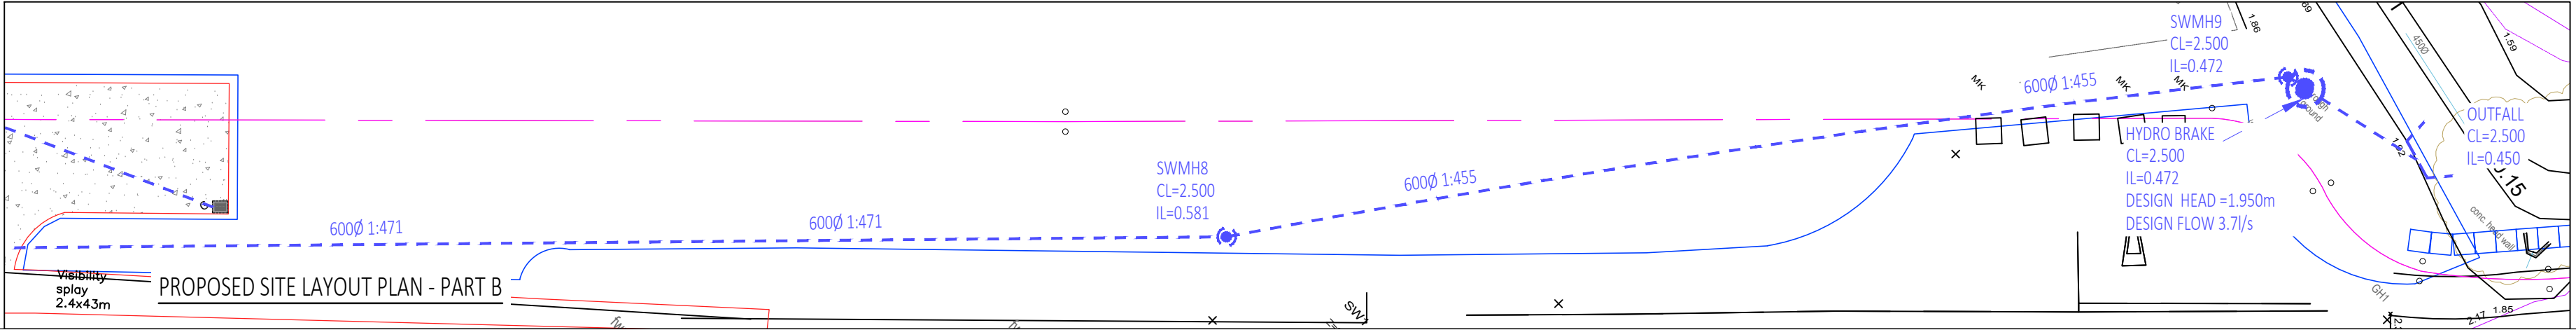

PROPOSED SITE LAYOUT PLAN - PART B

MANHOLE SCHEDULE				
MANHOLE / INSPECTION CHAMBER NUMBER	COVER LEVEL	INVERT LEVEL	TYPE	DIAMETER
SWMH1A	2.780	1.690	MANHOLE	1.05m
SWMH1B	2.875	1.510	MANHOLE	1.05m
SWMH2	2.380	1.430	MANHOLE	1.05m
SWMH3	2.500	1.275	MANHOLE	1.05m
SWMH4	2.750	0.914	MANHOLE	1.20m
SWMH5	3.260	0.836	MANHOLE	1.20m
SWMH6A	3.050	0.824	MANHOLE	1.20m
SWMH6	2.800	0.794	MANHOLE	1.20m
SWMH7	2.830	0.771	MANHOLE	1.20m
SWMH8	2.500	0.581	MANHOLE	1.20m
SWMH9	2.500	0.472	MANHOLE	1.20m
I/C 01	3.000	1.955	MANHOLE	1.05m
I/C 02	3.000	1.905	MANHOLE	1.05m
I/C 03	3.000	1.785	MANHOLE	1.05m
I/C 04	3.000	1.715	MANHOLE	1.05m
I/C 05	3.000	1.600	MANHOLE	1.05m
FWH 01	3.000	1.400	MANHOLE	1.05m
FWH 02	3.000	0.600	MANHOLE	1.05m
EXISTING FOUL PIPE CONNECTION	TBC	TBC	TBC	

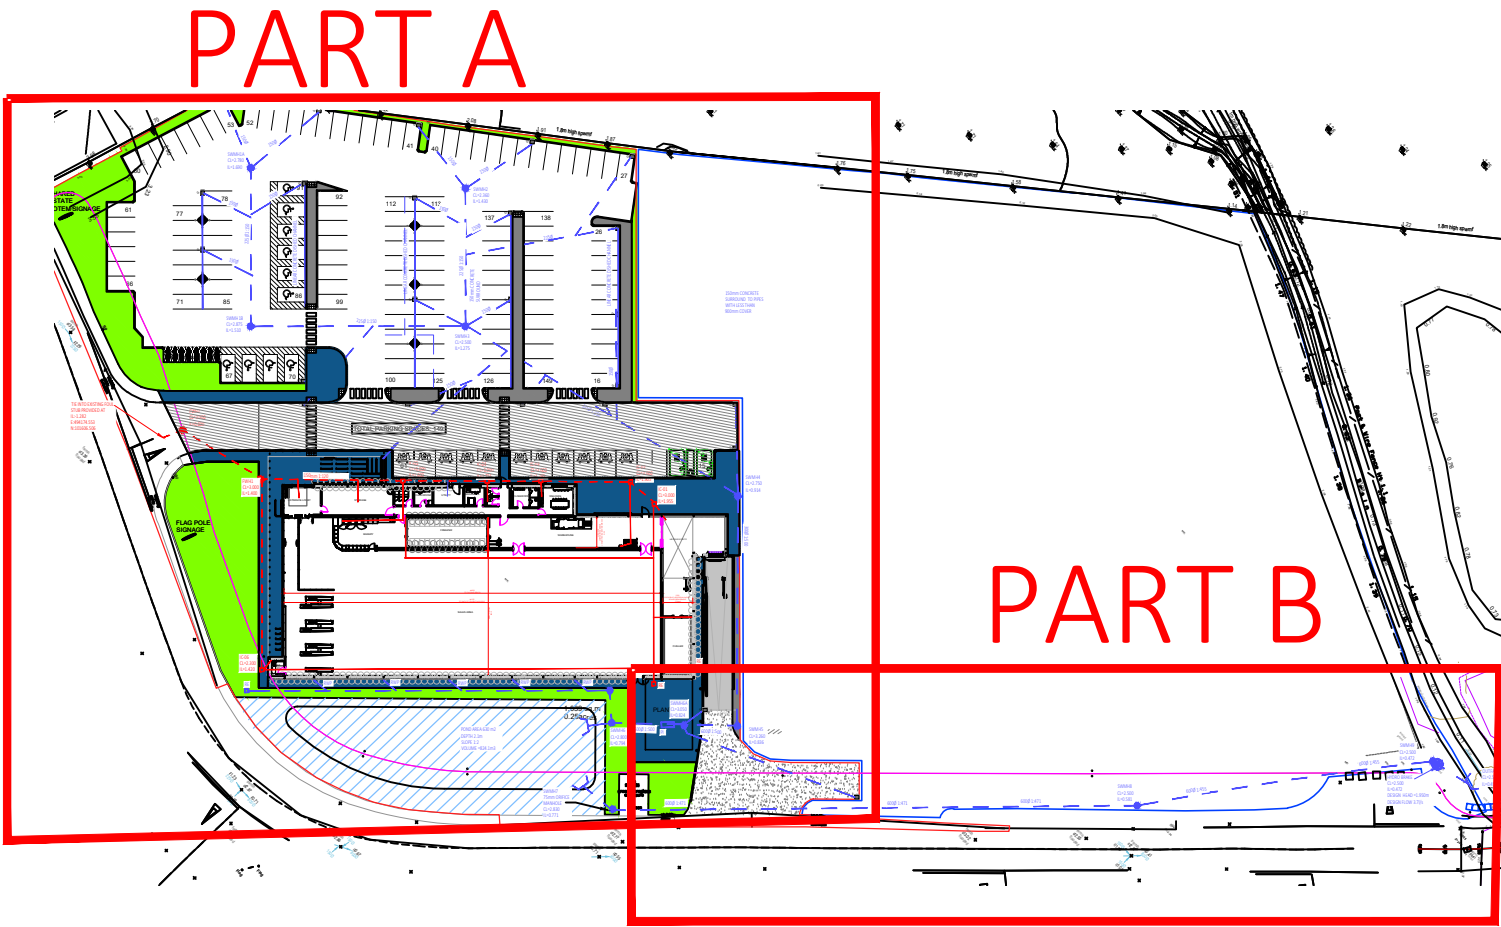

LEGEND -PROPOSED SITE DRAINAGE	
ELEMENT	SHOWN AS
PROPOSED FOUL DRAINAGE EXTERNAL 150mm Ø	---
PROPOSED FOUL DRAINAGE INTERNAL 100mm Ø	---
EXISTING FOUL PUBLIC SEWER	---
PROPOSED SW & FW PC RING MANHOLE	● ●
PROPOSED SW DRAIN 225mm DIAMETER	---
PROPOSED GULLY CONNECTION 225mm DIAMETER	---
PROPOSED LINEAR DRAIN	---
PROPOSED SHALLOW CONSTRUCTION GULLY	G
RAIN WATER PIPE	RWP
EXISTING MANHOLES (FOUL & SURFACE)	● ●
EXISTING SURFACE WATER	---
INSPECTION CHAMBER	□
EXISTING FOUL SEWER	---
Attenuation tank	---

NOTE:
ALL LANDSCAPING PLANTING SHOWN IS INDICATIVE ONLY.
PLEASE REFER TO LANDSCAPING ARCHITECTS LAYOUT FOR DETAILS

CN3	28.10.2020	KM	ISSUED FOR COMMENT
CN2	30.06.2020	AM	ISSUED FOR COMMENT
CN1	23.06.2020	KM	ISSUED FOR COMMENT
REV	DATE	BY	DESCRIPTION
<div><div>SDS-UK(Structural Design Solutions) Ltd, BRIDGE HOUSE, 25-27 THE BRIDGE, WEALDSTONE, HARROW, HA3 9AB. Tel: +353 (0)94-9034914 Fax: +353 (0)94-9034698 info@structuraldesign.ie www.structuraldesign.ie SDS-UK(Structural Design Solutions) Ltd.</div><div>Client: ADSTON CONSTRUCTION</div><div>Project Title: PROPOSED NEW LIDL FOODSTORE AT OLDLANDS FARM, STEYNING WAY, BOGNOR REGIS, PO22 9NN</div><div>Drawing Title: SITE LAYOUT SURFACE WATER & FOUL DRAINAGE</div><div>Scale: 1:250</div><div>Paper Size: @ A1</div><div>Status: CONSTRUCTION</div><div>Drawn By: KM</div><div>Checked By: MM</div><div>Date: JUNE 2020</div><div>Project No: 20144</div><div>Drawing No: 3021</div><div>Rev: CN3</div></div>			

VICTORIA GEORGE-TAYLOR

From: [REDACTED]
Sent: 16 February 2021 10:56
To: VICTORIA GEORGE-TAYLOR
Cc: DANIEL LEACH
Subject: FW: As Built Drainage Bognor Regis

Victoria,

See below.

Kind Regards,

Rory Harte

For & on Behalf of

Adston
[REDACTED]



NI: Unit 4, The Square, Manderwood Park, Drumhew, Lisnaskea, Co. Fermanagh, BT92 0FP ☎+4428 67721488
1 Milltown East Ind. Est., Upper Dromore Road, Warrenpoint, Co. Down, BT34 3PN ☎+4428 4176 7237
ROI: Unit 11, Creeny Business Park, Belturbet, Co. Cavan ☎+35349 9529200 📠 +35349 9529292

Registration Numbers: N.I. 605512 R.O.I. 115886 www.adstonconstruction.com

[REDACTED]

This email and any files transmitted with it are solely intended for the use of the addressee(s) and may contain information that is confidential and privileged. If you receive this email in error, please advise us by return email immediately. Please also disregard the contents of the email, delete it and destroy any copies immediately.

Adston and its subsidiaries do not accept liability for the views expressed in the email or for the consequences of any computer viruses that may be transmitted with this email. This email is also subject to copyright. No part of it should be reproduced, adapted or transmitted without the written consent of the copyright owner.

From: Mark Mulchrone [REDACTED]
Sent: Tuesday 16 February 2021 10:15
To: Rory Harte [REDACTED]
Cc: DANIEL LEACH [REDACTED]
Subject: RE: As Built Drainage Bognor Regis

Hi Rory,

I can confirm that drainage is installed in accordance with the approved design strategy, reference 3993-H-RP-1A-0500-201 Drainage Strategy P03 by Ramboll. Furthermore the submitted as constructed drawing reference 20144-3021-CN4 by SDS, is an accurate record of this.

If you have any further queries please do not hesitate to contact me.

Regards,
Mark Mulchrone
Project Manager

SDS Design Engineers

Civil and Structural Engineers

HO - Unit 9, N5 Business Park, Moneen Road, Castlebar. Co. Mayo F23 E283 Ireland **T:** +353(0)949034914

Dublin - 46 Dawson Street, Dublin 2 **T:** +353(0)16877480

London - Bridge House, 25-27 The Bridge, Wealdstone. Harrow. HA3 5AB UK **T:** +44(0)2030266724

Qatar - P O. Box 2514, Doha. Qatar

T +353 (0)94 90 34914 **Ext** 515



W www.structuraldesign.ie

