


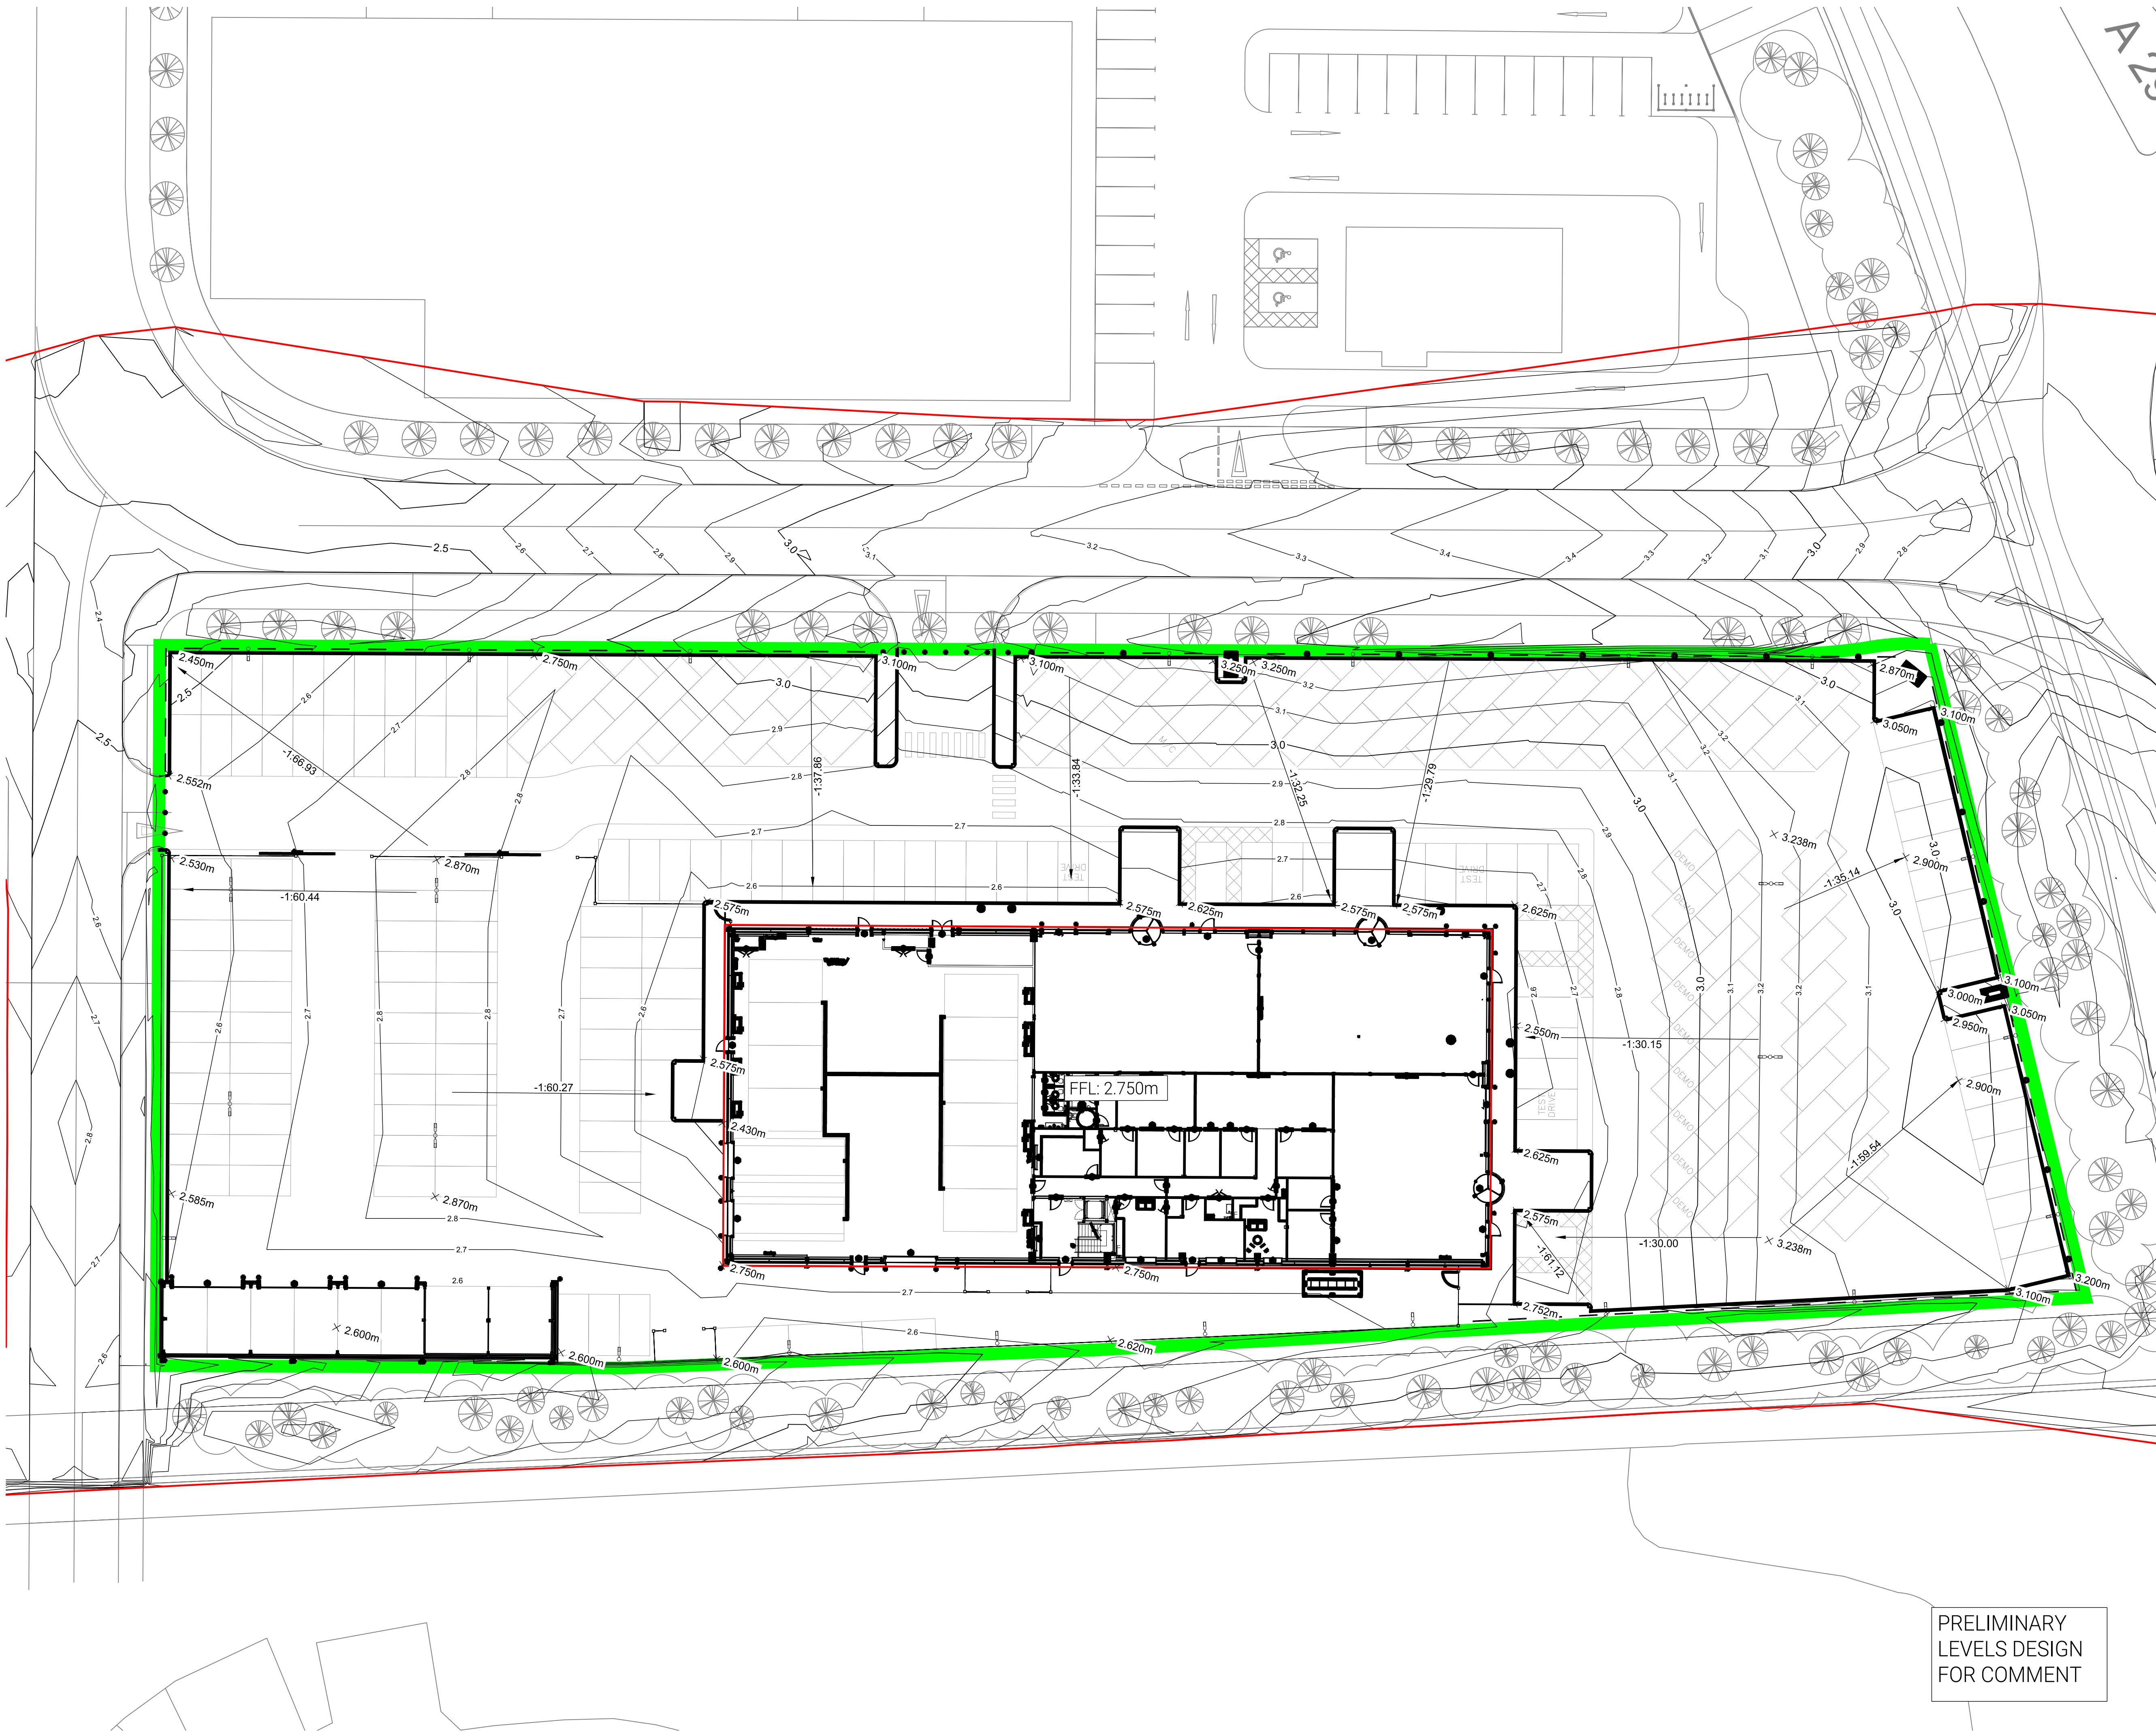

- Notes:**
1. This drawing is to be read in conjunction with all relevant architects, engineers and specialist sub-contractors drawings and the specification.
 2. All setting out to be in accordance with the architects drawings. Any discrepancies between the engineers and the architects drawings to be referred to the architect before proceeding. Dimensions must not be scaled.
 3. All asphalt concrete materials to be provided and laid in accordance with EN13108-1 and 5, BS 594987:2007 and PD6691:2007.
 4. Capping layer material to be in accordance with the Highway Authority 'Specification for Highway Works' table 6/1, 6/2 and 6/4. contractor to provide certificates to confirm compliance.
 5. Well graded crushed material to be clean and free of plastic, metal, plaster etc, passing a 75mm screen on compacting plant and graded to have a uniformly coefficient greater than 10. contractor to provide certificates to confirm compliance.
 6. Contractor to allow for all works on the public highway to be in accordance with the local Highway Authority requirements. contractor to allow for applying for all 'road opening licence's and paying all necessary fees.
 7. Overlapping elements of stepped joints shall normally be 300mm except where this places the joint in the wheel track, whereupon on c class and unclassified roads the overlap may be reduced to 150mm, and on a and b class roads the overlapping elements shall be extended in accordance with lan 154/12. any overlapping elements less than 300mm shall be agreed with the wsc engineer and/or wsc inspector.
 8. Insitu concrete paving to be in accordance with BS 8500-1 and BS EN 206-1.
 9. All highways macadam materials to be in accordance with the Highways Agency 'Specification for Highway Works' series 900 for roads and series 1100 for footways.
 10. All precast concrete kerbs, channels, edgings and quadrants to be manufactured and laid in accordance with BS EN 1340 - 2003.
 11. All pavements constructed with concrete, clay or natural stone pavers to be in accordance with BS 7533 all relevant parts.
 12. Concrete block pavers including permeable blocks to be in accordance with BS EN 1386.
 13. Clay pavers to be in accordance with BS EN 1344.
 14. Sand bedding layer to pavers to be in accordance with the table in BS 7533-3 annex D. All pavers to be laid and compacted in accordance with all relevant parts of BS 7533.
 15. Unless specified elsewhere all pavers will be laid in a 45° herringbone pattern.
 16. Block paving immediately adjacent to features like drainage channels to be fixed in place using epoxy mortar minimum 14mm thick.
 17. Contractor to allow for saw cutting all joints where new works extend into existing highway construction. Allow for painting of joints with bitumen emulsion reinstatement of chase all in accordance with highway authority requirements.
 18. Preformed internal and external angle kerbs to be used where appropriate, mitring of kerbs is not acceptable

T2	06.12.21	Revised to as-built road levels
T1	15.11.21	Drawn
Rev.	Date	Description



Calinotto

Jonkeri House

43 Commercial Rd

Poole BH14 9HJ

01202 237237

info@calinotto.co.uk

www.calinotto.co.uk

Client

RICHMOND MOTOR GROUP

Project Title

Saltbox

Drawing Title

External Levels Layout

Drawing Status

For Information

Originator No.	Rev by	Chk by	Scale
114378	DB	PW	1:250 @A1

PROJECT ORIGINATOR ZONE LEVEL TYPE ROLE NO.	Revision
114378-CAL-XX-XX-DR-D-0200	T2

PRELIMINARY
LEVELS DESIGN
FOR COMMENT