


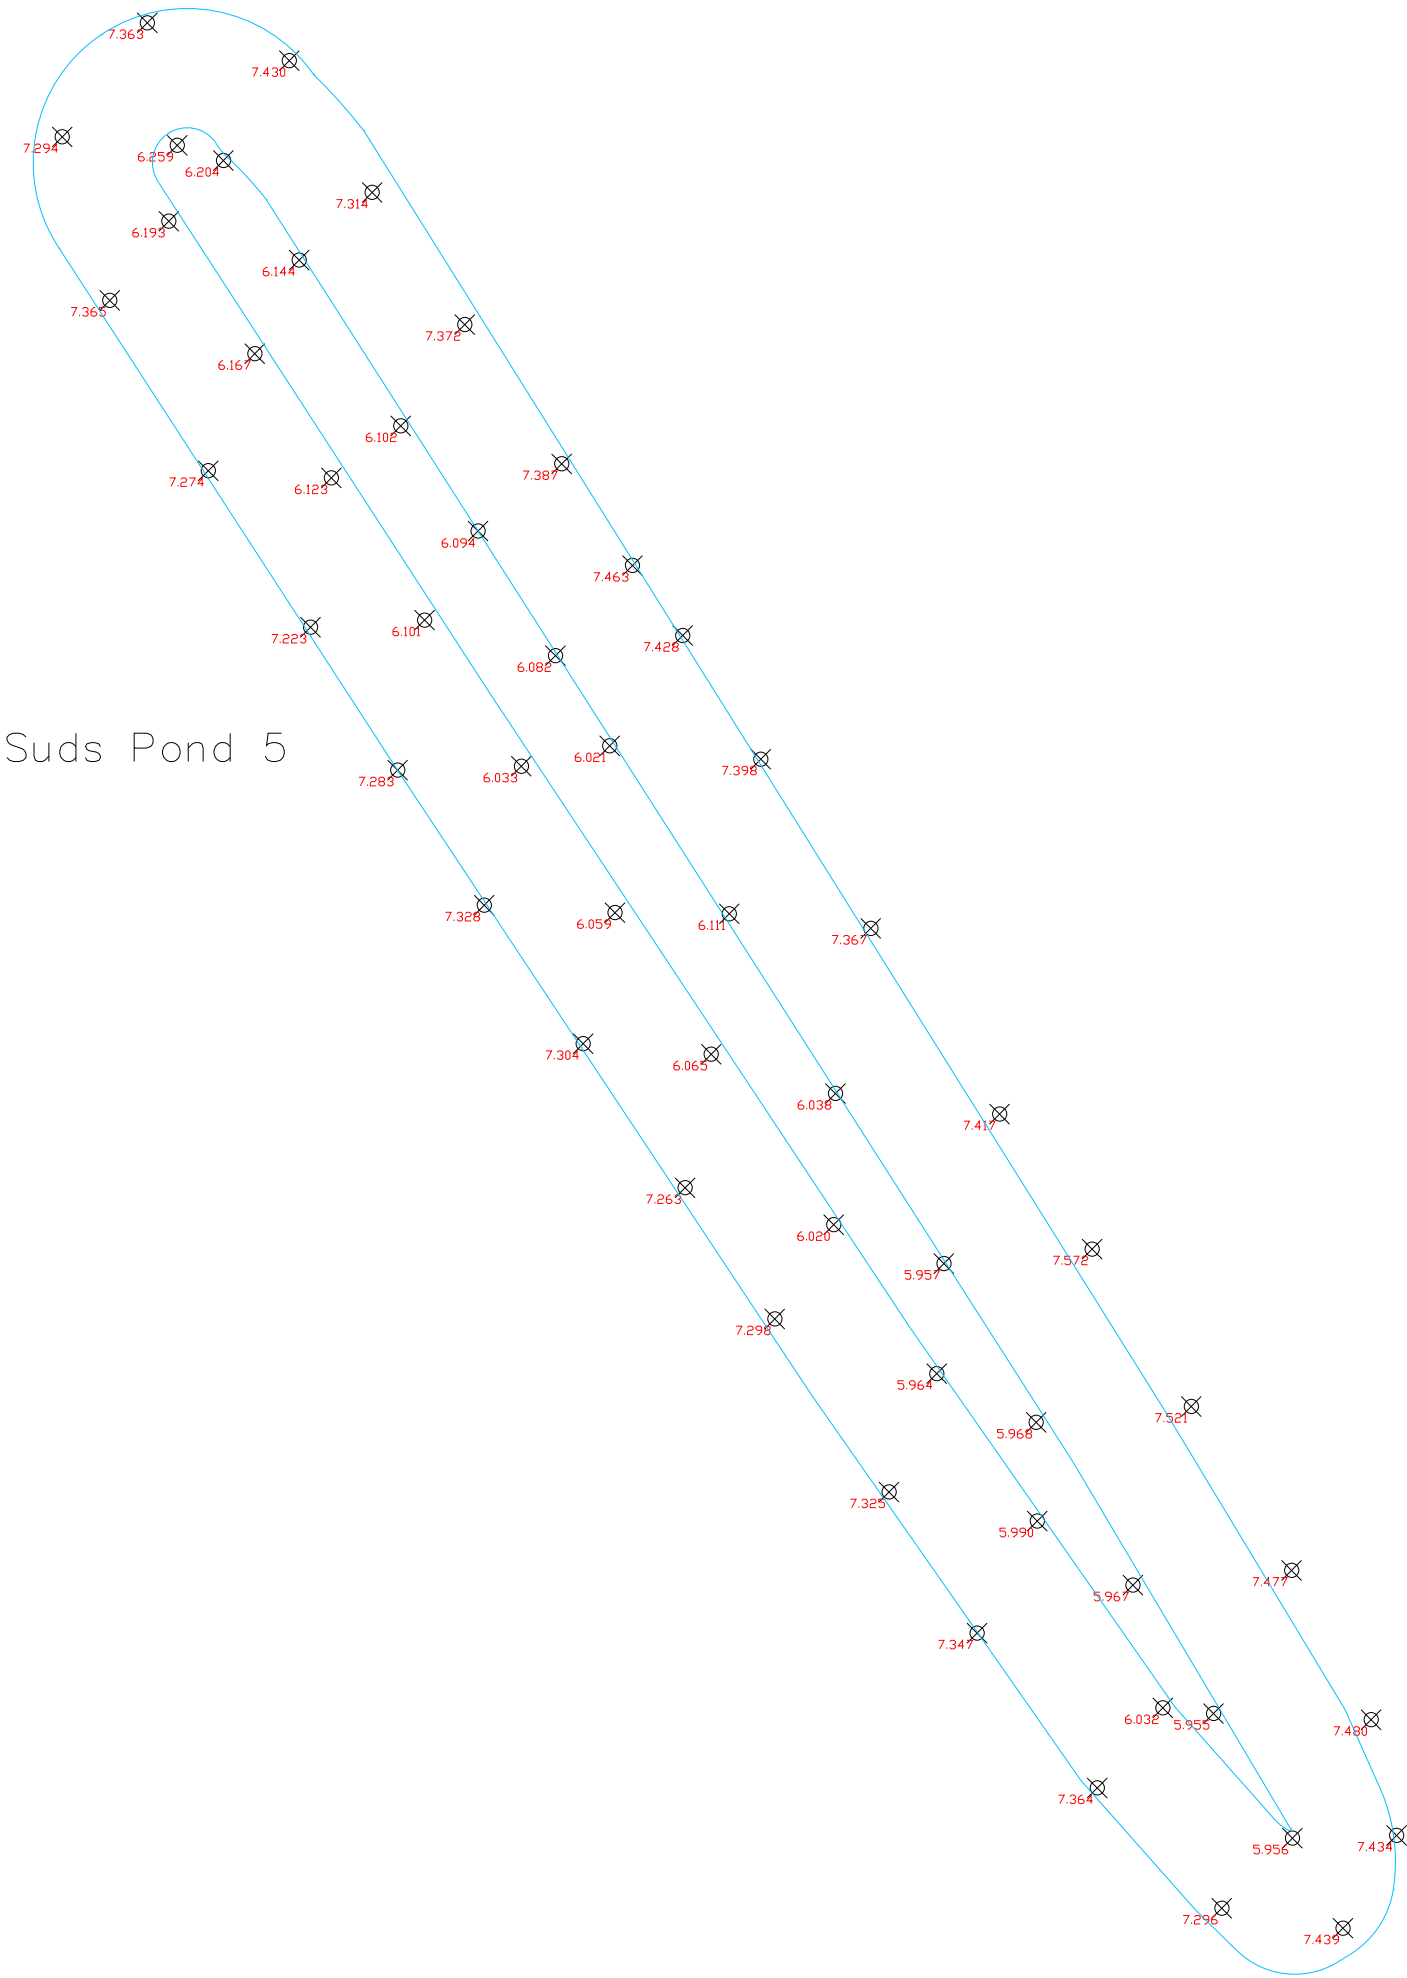

NOTES

AB	DESCRIPTION	SIG	CHK	DATE
BERSTED				
SUDS POND 5 TOPSOIL LEVEL SURVEY				
				
AB MODEL		DRAWING STATUS AS-BUILT		
DRAWN AM	CHECKED MB	DATE 11/04/2025	DRAWING NUMBER ABS1	REV /