


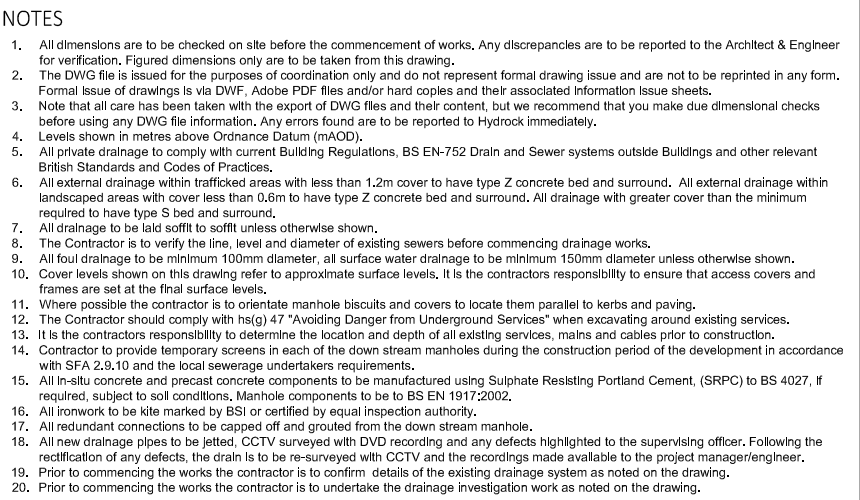

C05	AS BUILT ISSUE					
	J.SHIMMIN	27/07/21	D.GALLIMORE	27/07/21	J. MAGEE	27/07/21
C04	ISSUED FOR CONSTRUCTION					
	J.SHIMMIN	28/06/21	D.GALLIMORE	28/06/21	M. GRIFFIN	28/06/21
C03	ISSUED FOR CONSTRUCTION					
	D. GALLIMORE	29/03/21	D.GALLIMORE	29/03/21	M. GRIFFIN	29/03/21
C02	ISSUED FOR CONSTRUCTION					
	D. GALLIMORE	03/02/21	D.GALLIMORE	24/07/20	M. GRIFFIN	24/07/20
C01	ISSUED FOR CONSTRUCTION					
	D. GALLIMORE	24/07/20	D.GALLIMORE	24/07/20	M. GRIFFIN	24/07/20
P02	ISSUED FOR CONTRACT					
	R.HUNT	13/03/20	D.GALLIMORE	13/03/20	M. GRIFFIN	13/03/20
P01	TENDER ISSUE					
	D. GALLIMORE	13/12/19	D. GALLIMORE	13/12/19	M. GRIFFIN	13/12/19

Hydrock

 Merchants' House North
Wapping Road
Bristol
BS1 4RW
t: +44 (0)117 945 9225
e: bristolcentral@hydrock.com

CLIENT _____

LANDLINK ESTATES

PROJECT

SALTBOX

BOGNOR REGIS

TITLE

UNIT 2 DRAINAGE LAYOUT
SHEET 2

HYDROCK PROJECT NO. C-13319-C		SCALE @ A1 1:250
STATUS DESCRIPTION AS BUILT ISSUE		STATUS A
DRAWING NO. (PROJECT CODE-ORIGINATOR-ZONE-LEVEL-TYPE-ROLE-NUMBER) SAL-HYD-PH1-ZZ-DR-C-7011		REVISION C05