


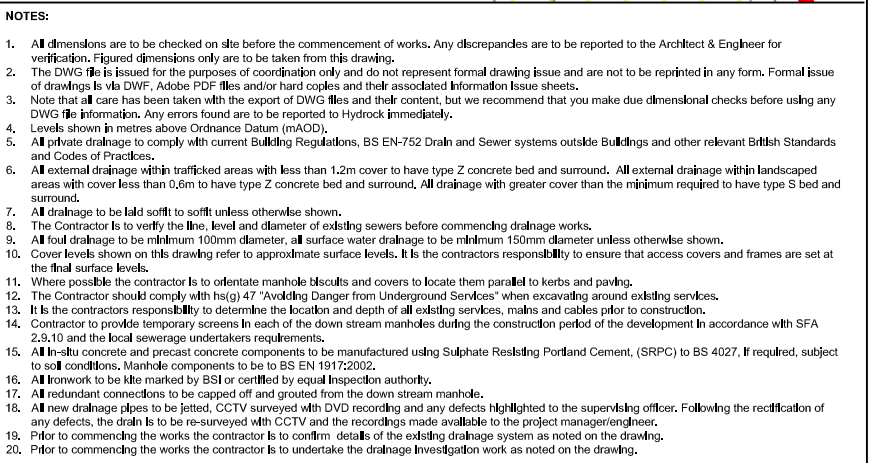

Hydrock

 Merchants' House North
Wapping Road
Bristol
BS1 4RW
t: +44 (0)117 945 9225
e: bristolcentral@hydrock.com

CLIENT _____

LANDLINK ESTATES

PROJECT

SALTBOX
BOGNOR REGIS

TITLE
ACCESS ROAD DRAINAGE LAYOUT SHEET 2

HYDROCK PROJECT NO. C-13319-C	SCALE @ A1 1:250
----------------------------------	---------------------

STATUS DESCRIPTION	STATUS
AS BUILT ISSUE	A1

DRAWING NO. (PROJECT CODE-ORIGINATOR-ZONE-LEVEL-TYPE-ROLE-NUMBER)	REVISION
SAL-HYD-PH1-ZZ-DR-C-7021	C08