


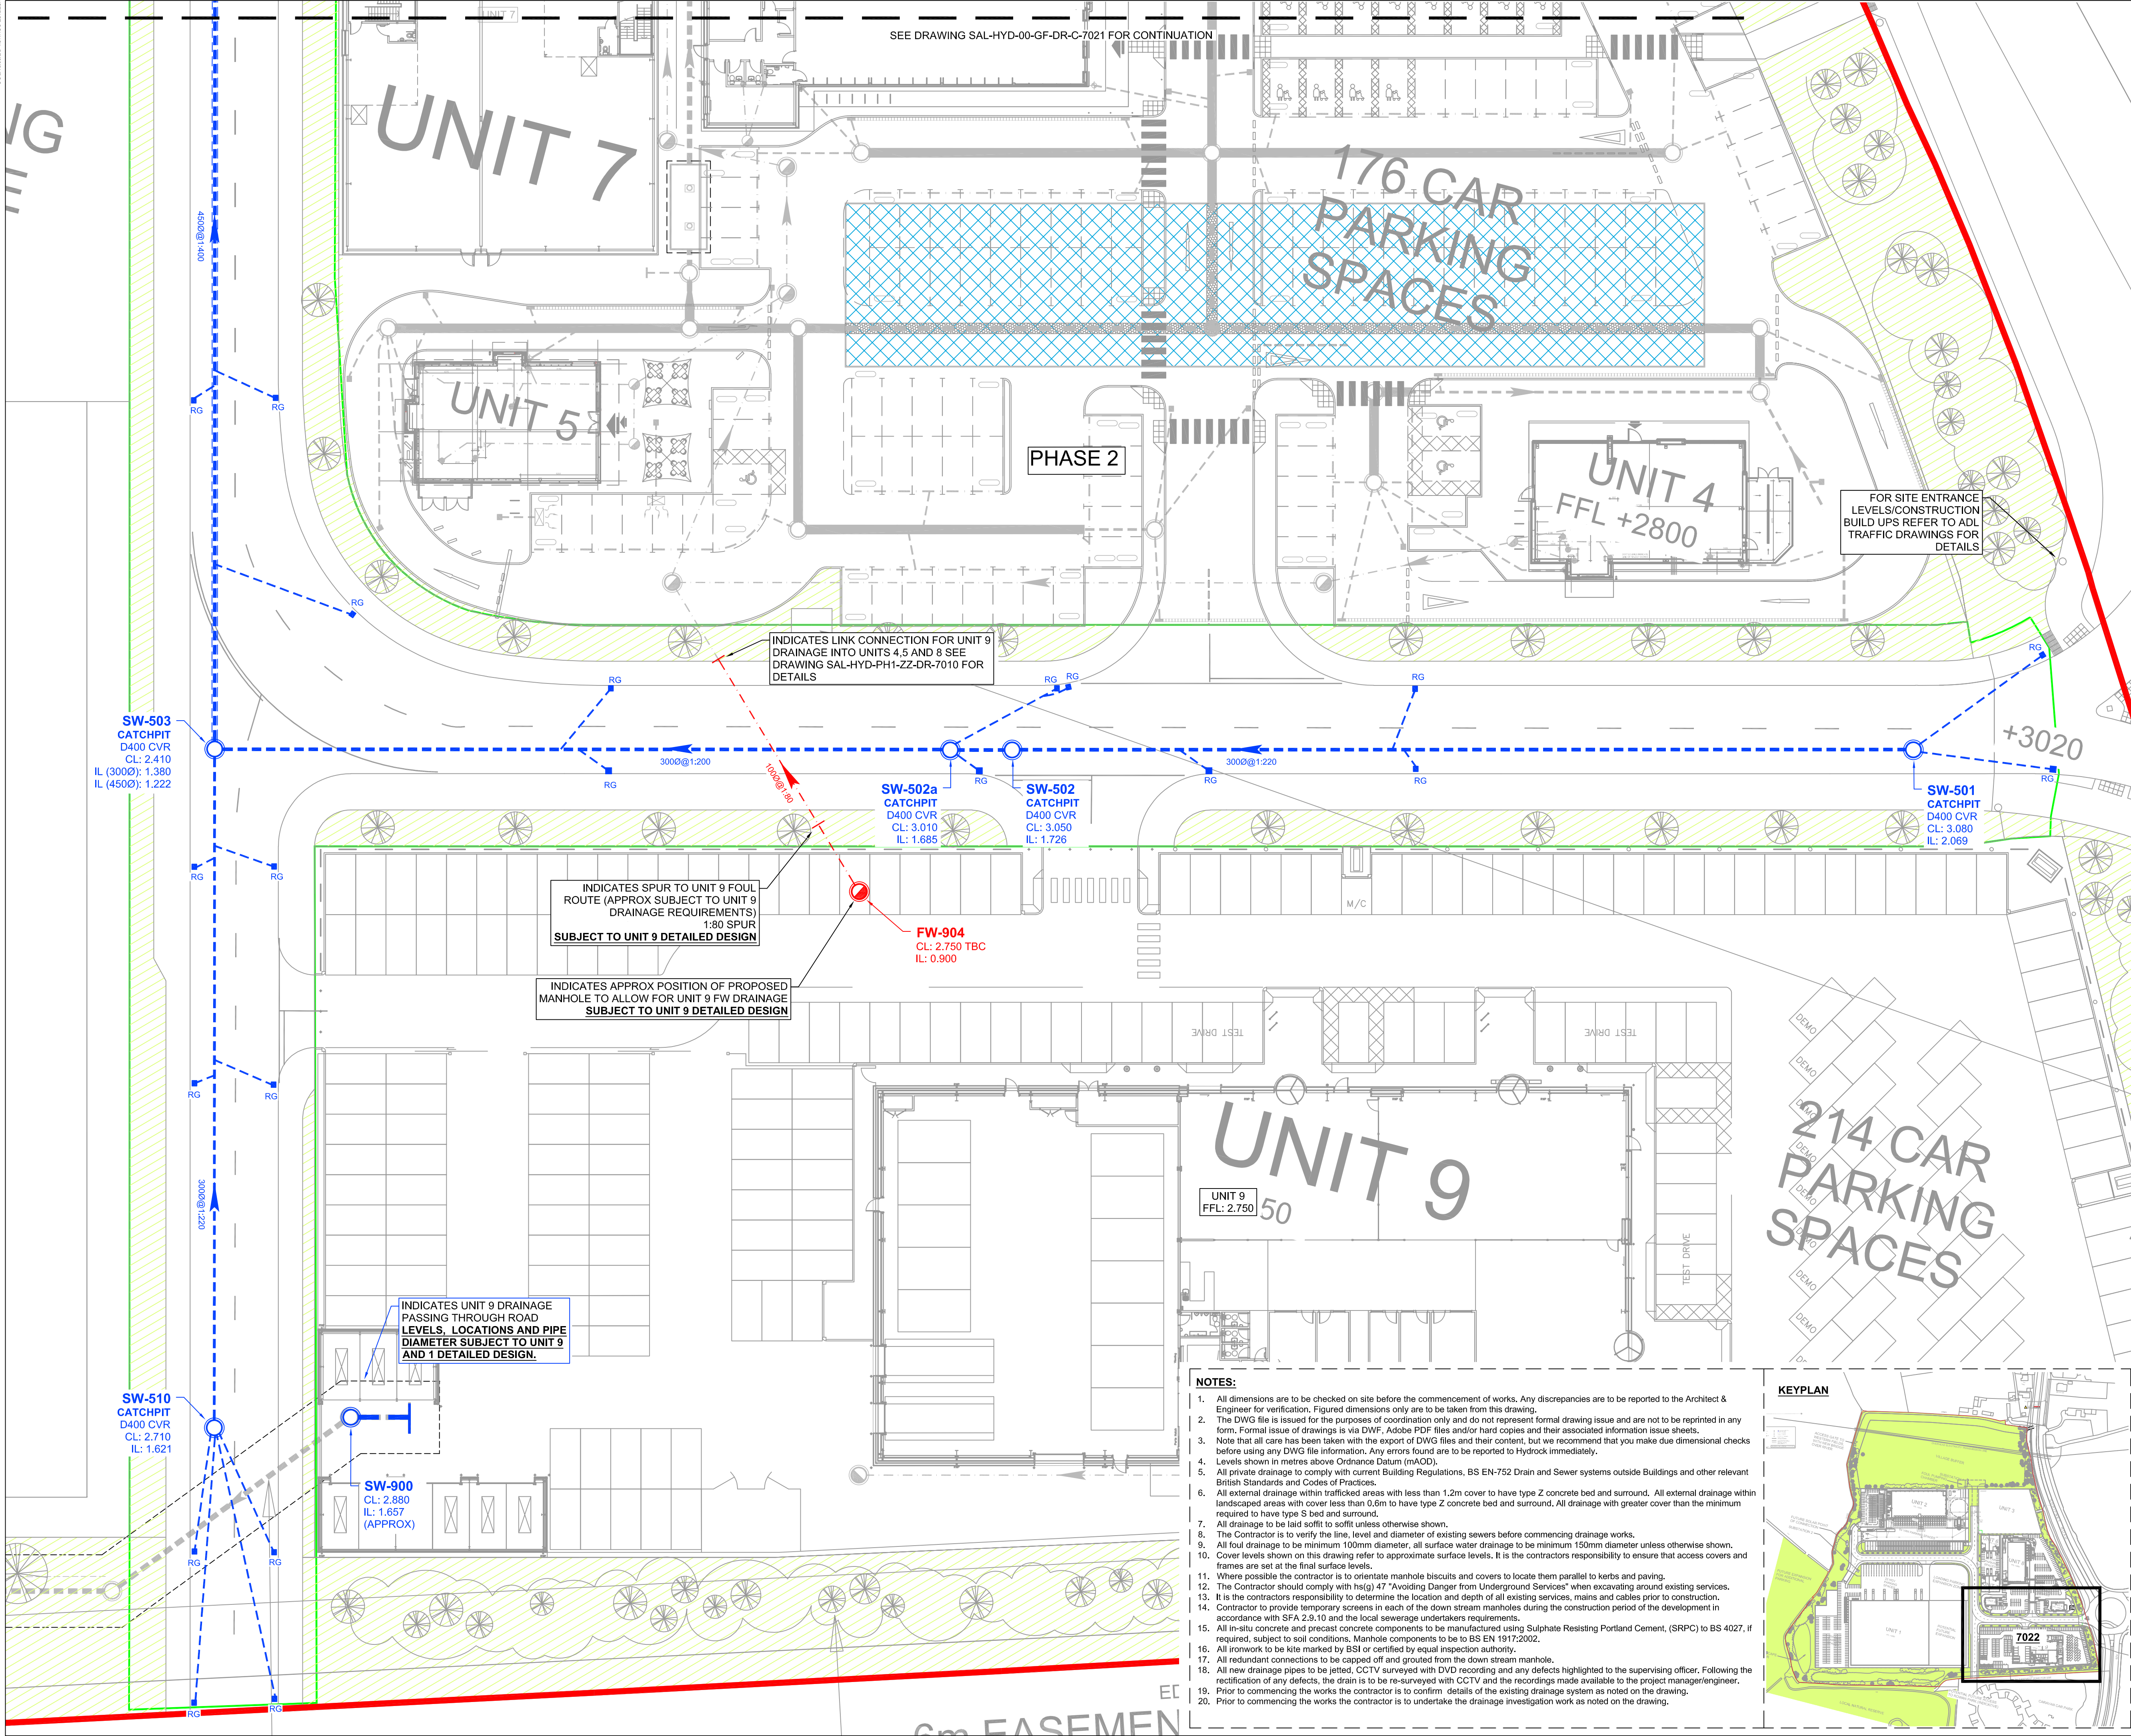

CD9	AS BUILT ISSUE					
	O.DAVIS	22.07.21	D.GALLIMORE	22.07.21	D.GALLIMORE	22.07.21
CD8	CONSTRUCTION ISSUE					
	J.SHIMMIN	28/06/21	D.GALLIMORE	28/06/21	M. GRIFFIN	28/06/21
CD7	HEALTH AND SAFETY FILE ISSUE					
	J.SHIMMIN	11/06/21	D.GALLIMORE	11/06/21	M. GRIFFIN	11/06/21
CD6	GULLIES ADDED					
	D. GALLIMORE	16/12/20	D.GALLIMORE	16/12/20	M. GRIFFIN	16/12/20
CD5	FW DRAINAGE REVISED					
	D. GALLIMORE	23/10/20	D.GALLIMORE	23/10/20	M. GRIFFIN	23/10/20
CD4	DRAINAGE CL'S REVISED AND CATCH-PITS ADDED					
	D. GALLIMORE	13/10/20	D.GALLIMORE	13/10/20	M. GRIFFIN	13/10/20
CD3	ADL ENTRANCE INFORMATION ADDED					
	D. GALLIMORE	20/08/20	D.GALLIMORE	20/08/20	M. GRIFFIN	20/08/20
CD2	GULLIES REVISED/ADDED FOLLOWING LEVELS REVIEW.					
	D. GALLIMORE	10/08/20	D.GALLIMORE	10/08/20	M. GRIFFIN	10/08/20
CD1	ISSUED FOR CONSTRUCTION					
	D. GALLIMORE	24/07/20	D.GALLIMORE	24/07/20	M. GRIFFIN	24/07/20
PO8	ISSUED FOR CONTRACT					
	D. GALLIMORE	04/05/20	D.GALLIMORE	04/05/20	M. GRIFFIN	04/05/20
PO7	ISSUED FOR CONTRACT					
	R.HUNT	13/03/20	D.GALLIMORE	13/03/20	M. GRIFFIN	13/03/20
PO6	REVISED AS CLOUDED					
	D. GALLIMORE	25/02/20	M. GRIFFIN	25/02/20	M. GRIFFIN	25/02/20
PO5	REVISED AS CLOUDED					
	D. GALLIMORE	13/12/19	M. GRIFFIN	13/12/19	M. GRIFFIN	13/12/19
PO4	REVISED FOLLOWING COMMENTS (AS CLOUDED)					
	D. GALLIMORE	15/11/19	M. GRIFFIN	15/11/19	M. GRIFFIN	15/11/19
PO3	REVISED FOLLOWING COMMENTS (AS CLOUDED)					
	D. GALLIMORE	06/11/19	M. GRIFFIN	06/11/19	M. GRIFFIN	06/11/19
PO2	CULVERT AMENDED					
	D. GALLIMORE	21/10/19	M. GRIFFIN	21/10/19	M. GRIFFIN	21/10/19
PO1	TENDER ISSUE					
	D. GALLIMORE	11/10/19	J. MAGEE	11/10/19	M. GRIFFIN	11/10/19
REV	REVISION NOTES/COMMENTS					
	DRAWN BY	DATE	CHECKED BY	DATE	APPROVED BY	DATE

Merchants' House North
Wapping Road
Bristol
BS1 4RW
t: +44 (0)117 945 9225
e: bristolcentral@hydrock.com

CLIENT		LANDLINK ESTATES	
PROJECT		SALTBOX BOGNOR REGIS	
TITLE		ACCESS ROAD DRAINAGE LAYOUT SHEET 3	
HYDROCK PROJECT NO. C-13319-C		SCALE @ A1 1:250	
STATUS DESCRIPTION AS BUILT ISSUE		STATUS A1	
DRAWING NO. (PROJECT CODE-ORIGINATOR-ZONE-LEVEL-TYPE-ROLE-NUMBER) SAL-HYD-PH1-ZZ-DR-C-7022		REVISION C09	

- NOTES:**
- All dimensions are to be checked on site before the commencement of works. Any discrepancies are to be reported to the Architect & Engineer for verification. Figured dimensions only are to be taken from this drawing.
 - The DWG file is issued for the purposes of coordination only and do not represent formal drawing issue and are not to be reprinted in any form. Formal issue of drawings is via DWG. Adobe PDF files and/or hard copies and their associated information issue sheets.
 - Note that all care has been taken with the export of DWG files and their content, but we recommend that you make due dimensional checks before using any DWG file information. Any errors found are to be reported to Hydrock immediately.
 - Levels shown in metres above Ordnance Datum (mAOD).
 - All private drainage to comply with current Building Regulations, BS EN-752 Drain and Sewer systems outside Buildings and other relevant British Standards and Codes of Practices.
 - All external drainage within trafficked areas with less than 1.2m cover to have type Z concrete bed and surround. All external drainage within landscaped areas with cover less than 0.6m to have type Z concrete bed and surround. All drainage with greater cover than the minimum required to have type S bed and surround.
 - All drainage to be laid soffit to soffit unless otherwise shown.
 - The Contractor is to verify the line, level and diameter of existing sewers before commencing drainage works.
 - All foul drainage to be minimum 100mm diameter, all surface water drainage to be minimum 150mm diameter unless otherwise shown.
 - Cover levels shown on this drawing refer to approximate surface levels. It is the contractors responsibility to ensure that access covers and frames are set at the final surface levels.
 - Where possible the contractor is to orientate manhole biscuits and covers to locate them parallel to kerbs and paving.
 - The Contractor should comply with hsl(g) 47 "Avoiding Danger from Underground Services" when excavating around existing services.
 - It is the contractors responsibility to determine the location and depth of all existing services, mains and cables prior to construction.
 - Contractor to provide temporary screens in each of the down stream manholes during the construction period of the development in accordance with SFA 2.9.10 and the local sewerage undertakers requirements.
 - All in-situ concrete and precast concrete components to be manufactured using Sulphate Resisting Portland Cement (SRPC) to BS 4027, if required, subject to soil conditions. Manhole components to be to BS EN 1917:2002.
 - All ironwork to be kite marked by BSI or certified by equal inspection authority.
 - All redundant connections to be capped off and grouted from the down stream manhole.
 - All new drainage pipes to be jetted, CCTV surveyed with DVD recording and any defects highlighted to the supervising officer. Following the rectification of any defects, the drain is to be re-surveyed with CCTV and the recordings made available to the project manager/engineer.
 - Prior to commencing the works the contractor is to confirm details of the existing drainage system as noted on the drawing.
 - Prior to commencing the works the contractor is to undertake the drainage investigation work as noted on the drawing.

