


NON-DISTRICT COUNCIL INFORMATION

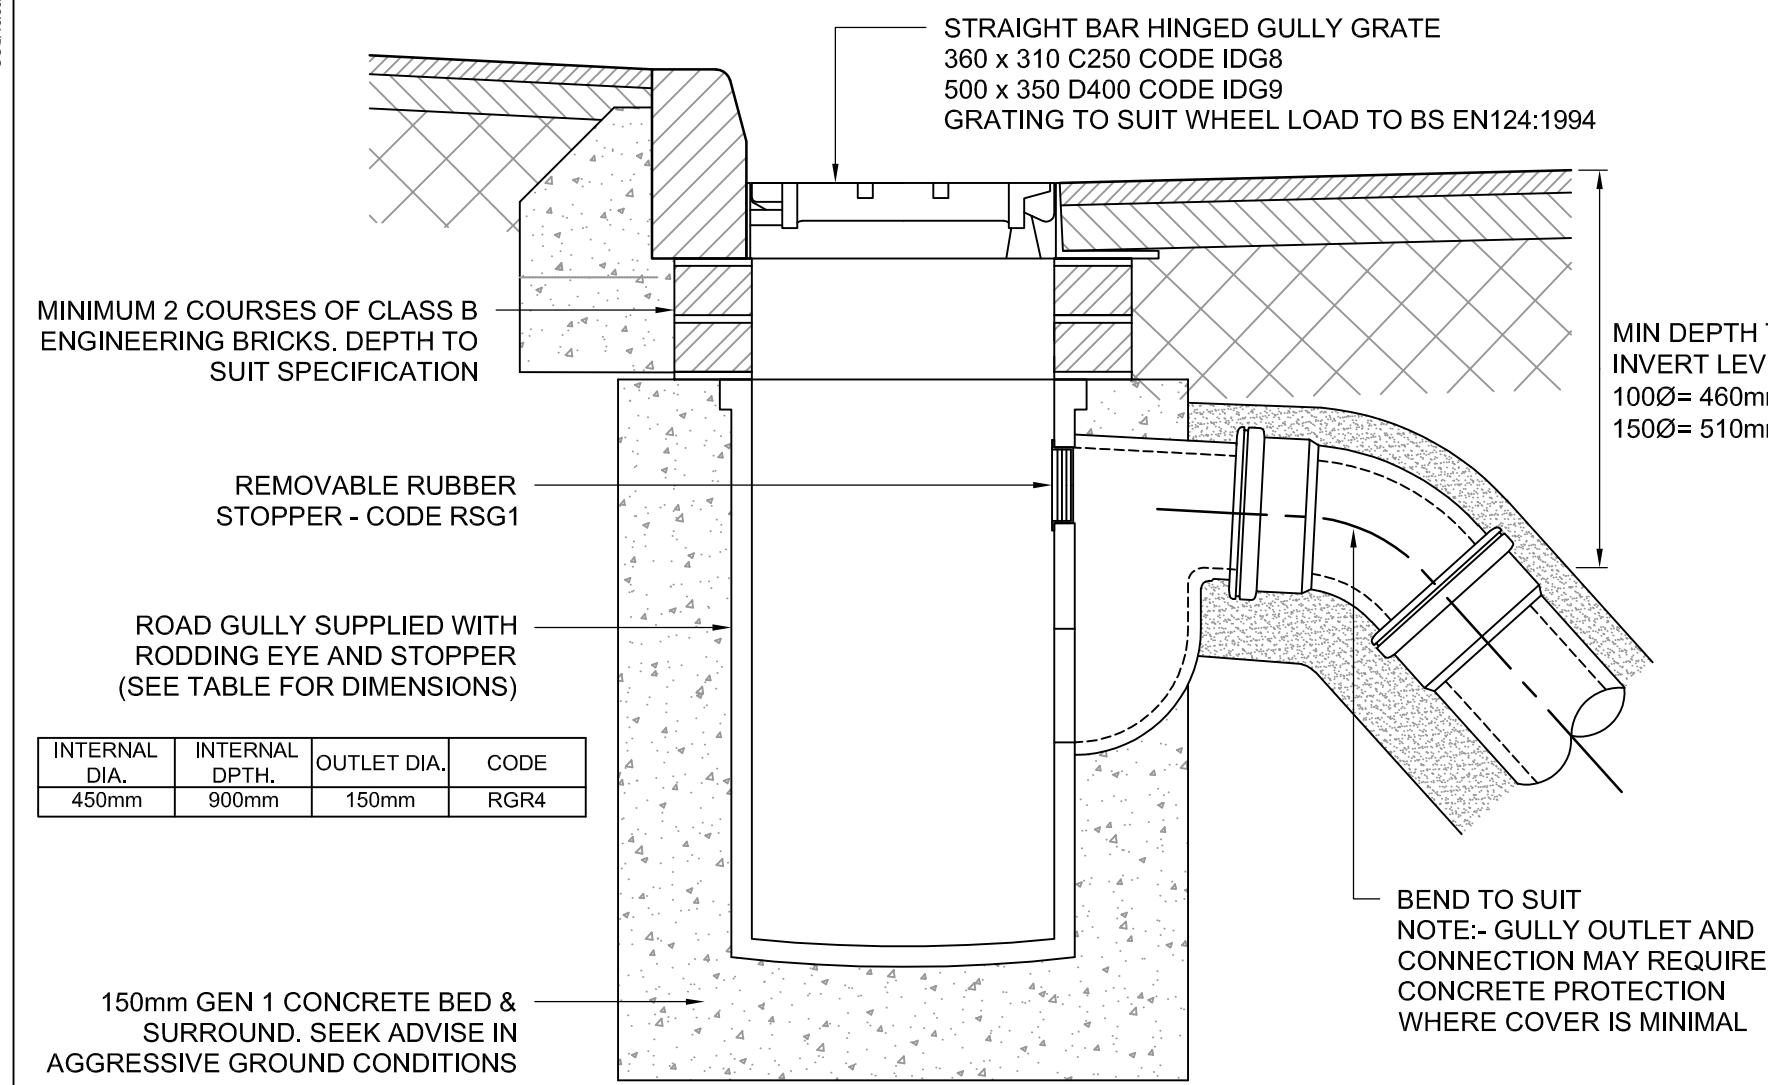


GULLY DETAIL BASED ON HEPWORTH SUPERSLEVE CLAY DRAINAGE ROAD GULLY
DETAIL. FOR FURTHER DETAILS REFER TO MANUFACTURERS RECOMMENDATIONS.

SHOULD AN ALTERNATIVE GULLY WISH TO BE SPECIFIED THEN IT IS THE
RESPONSIBILITY OF THE SPECIFIER TO ENSURE THAT THE ALTERNATIVE IS
COMPARABLE IN TERMS OF DETAIL AND PERFORMANCE REQUIREMENTS. PROPOSALS
SHOULD BE SUBMITTED WHERE APPLICABLE TO THE DESIGNER FOR APPROVAL.

DETAIL RG: ROAD GULLY


SCALE 1:10

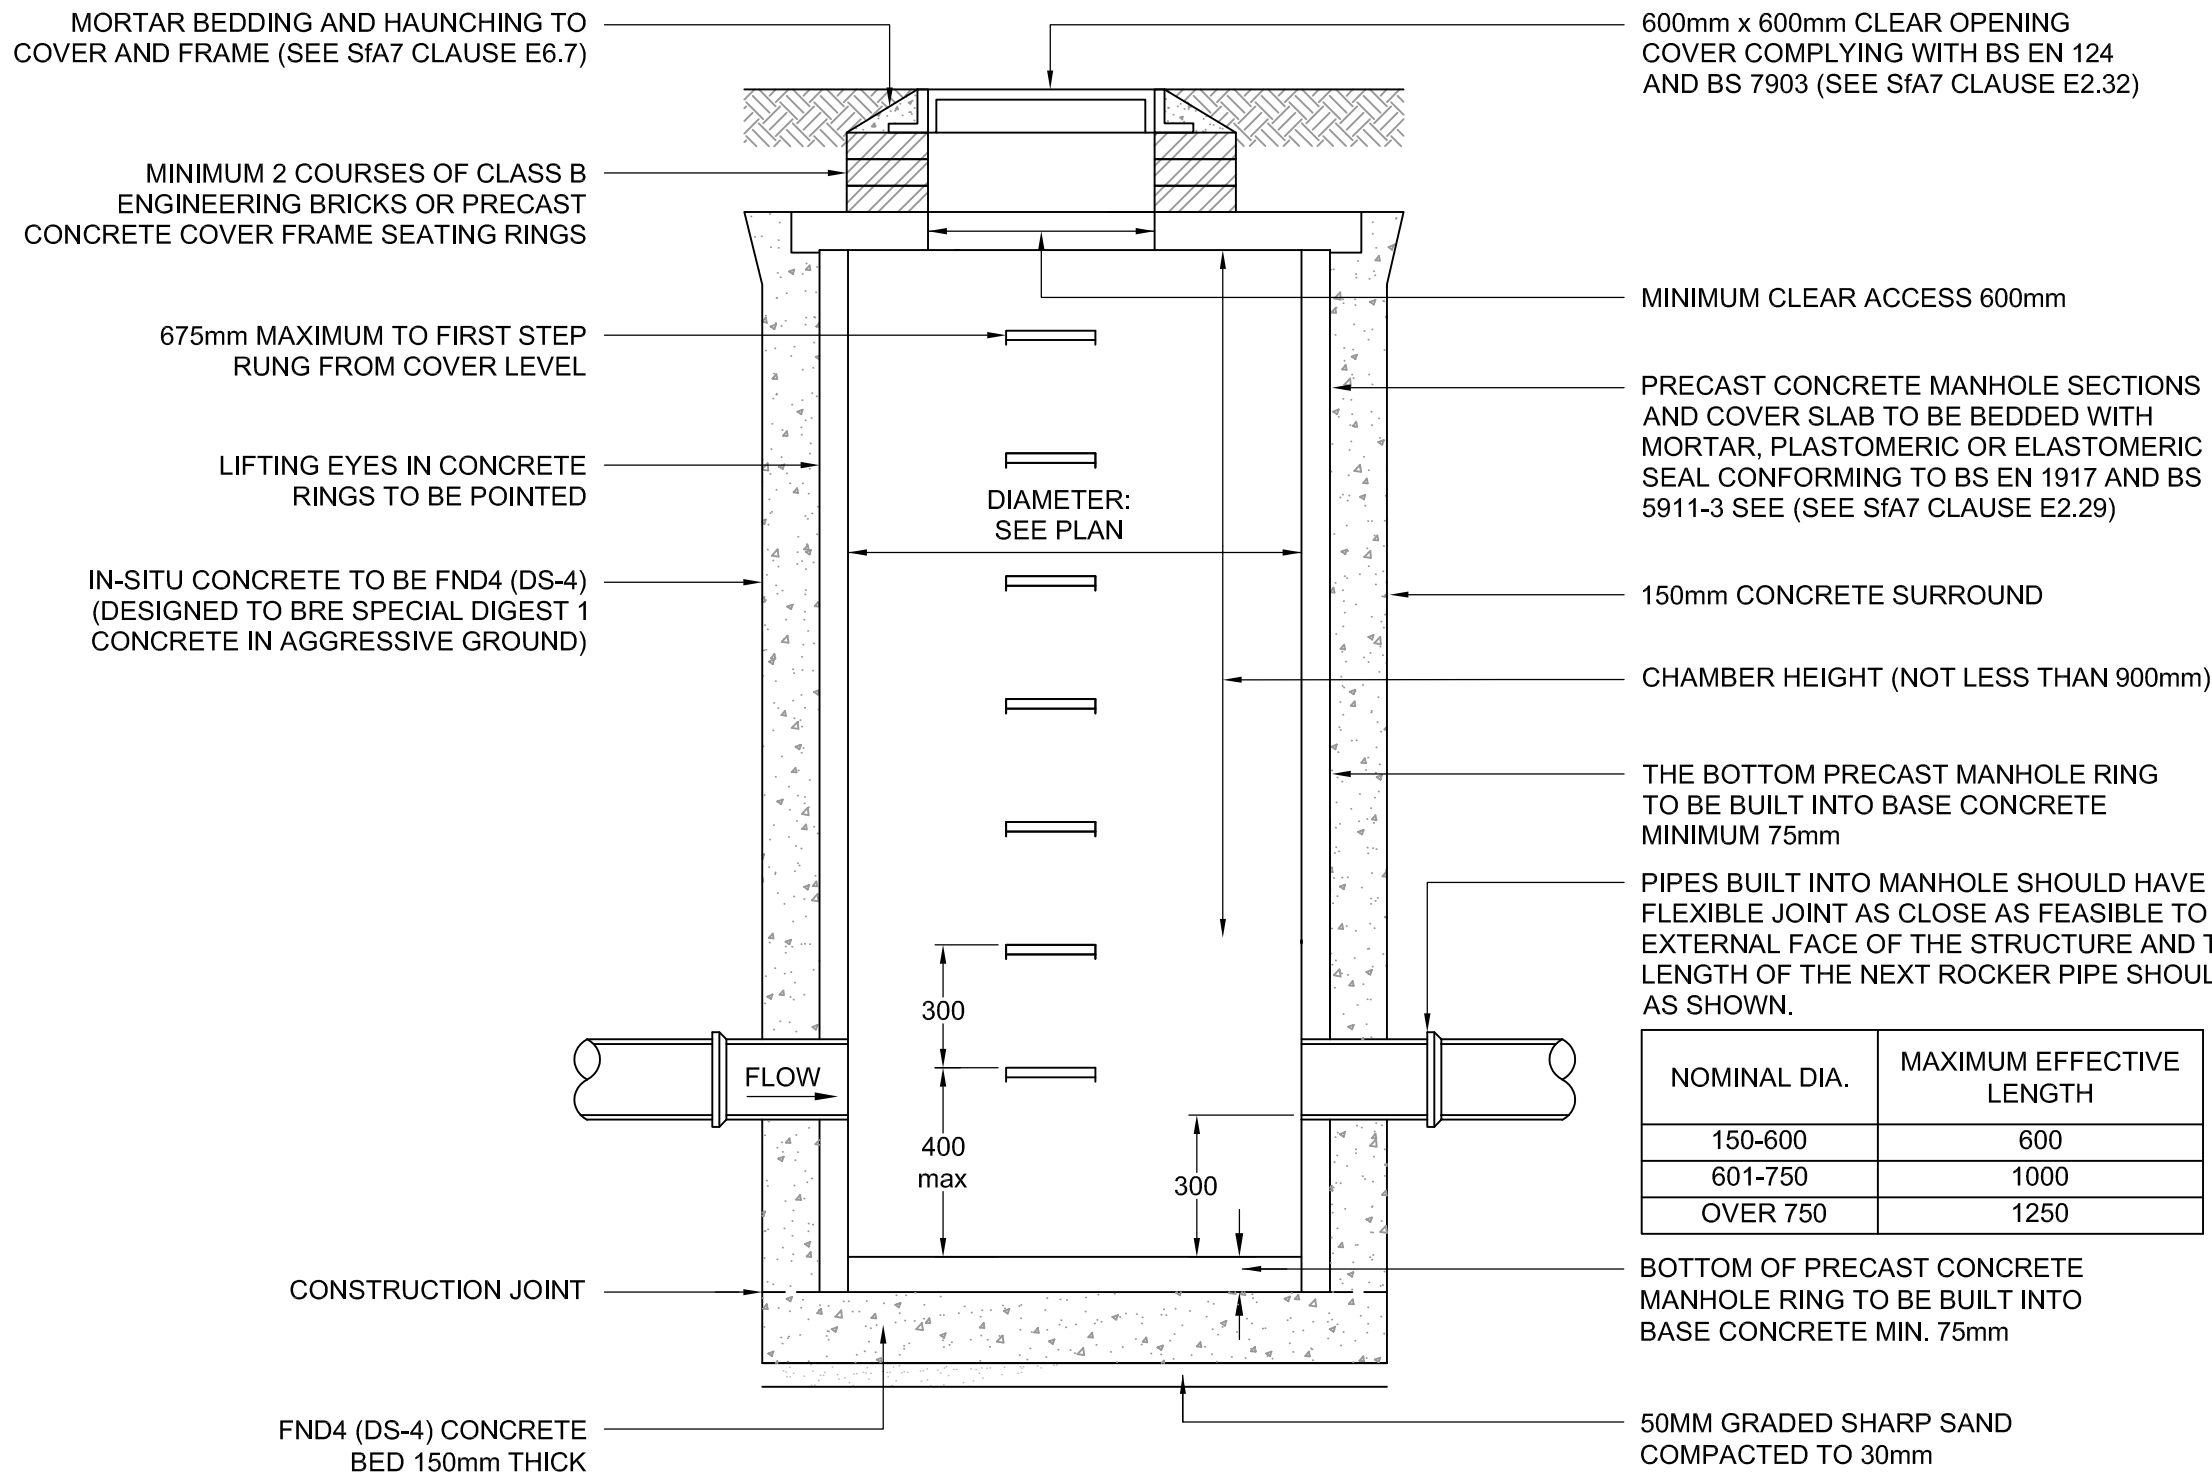

TYPICAL CATCHPIT DETAIL

SCALE 1:20

MAXIMUM DEPTH FROM COVER LEVEL TO SOFFIT OF PIPE 3.0m

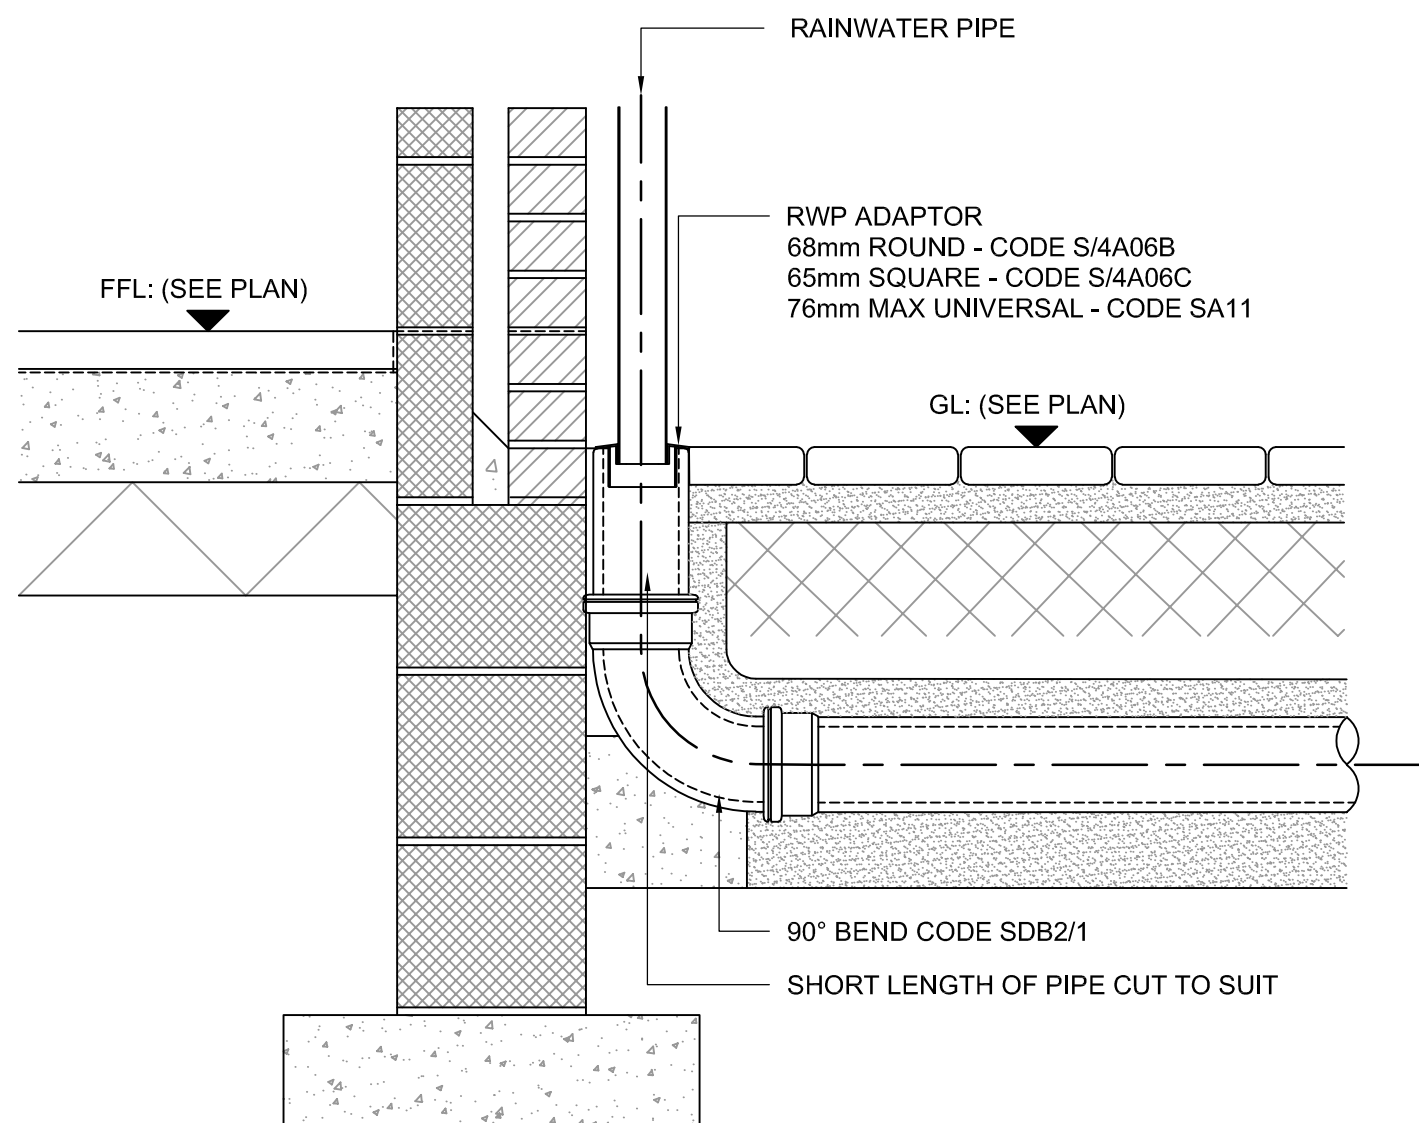


TYPICAL EXTERNAL RAINWATER PIPE 01 & 01A

SCALE 1:10


1.0 BLOCK PAVEMENTS: THE CHANNEL MUST BE
SUPPORTED Laterally AND THEREFORE BLOCKS
MUST BE RESTRAINED FROM MOVEMENT BY
BEDDING SECURELY. E.G. BY USING AN EPOXY OR
POLYMER MODIFIED MORTAR FOR BED AND
PERPENDICULAR JOINTS. (FOR EXAMPLE RONAFIX
MORTAR MIX C OR SIMILAR; MANUFACTURER
ADVICE MAY BE REQUIRED.

2.0 JOINT SEALANT: WHERE ACO DRAIN CHANNEL
JOINTS AND FITTINGS ARE TO BE SEALED (WHERE
USED IN FOUL WATER APPLICATIONS OR WHERE
IMPERMEABILITY IS REQUIRED, FOR EXAMPLE)
CONTACT A SEALANT SPECIALIST FOR GUIDANCE
ON THE MOST APPROPRIATE SEALING COMPOUND
TO USE.

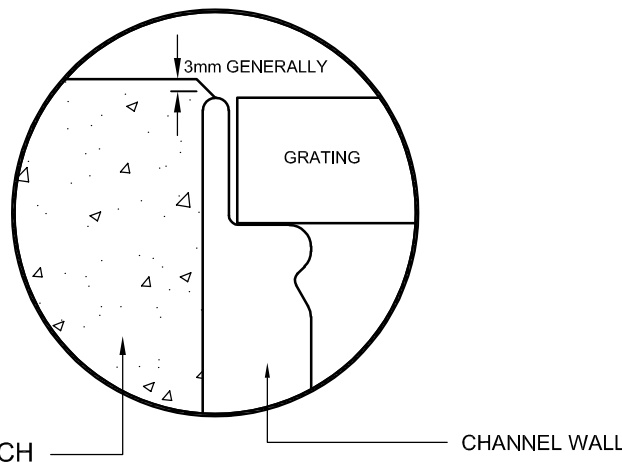


PAVEMENT OR HAUNCH
(CONSTRUCTION VARIES)

DETAIL A

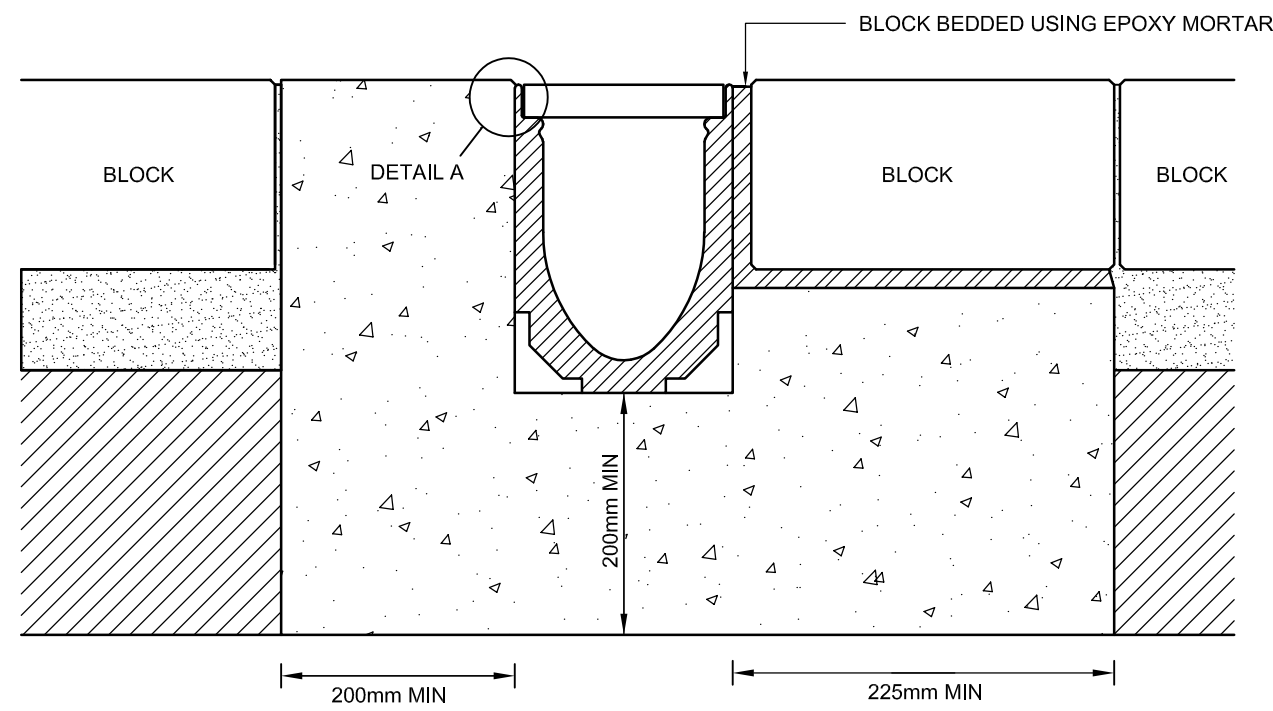


ACO MULTIDRAIN CHANNEL INSTALLATION FOR LOAD CLASS D400
(BLOCK PAVING)

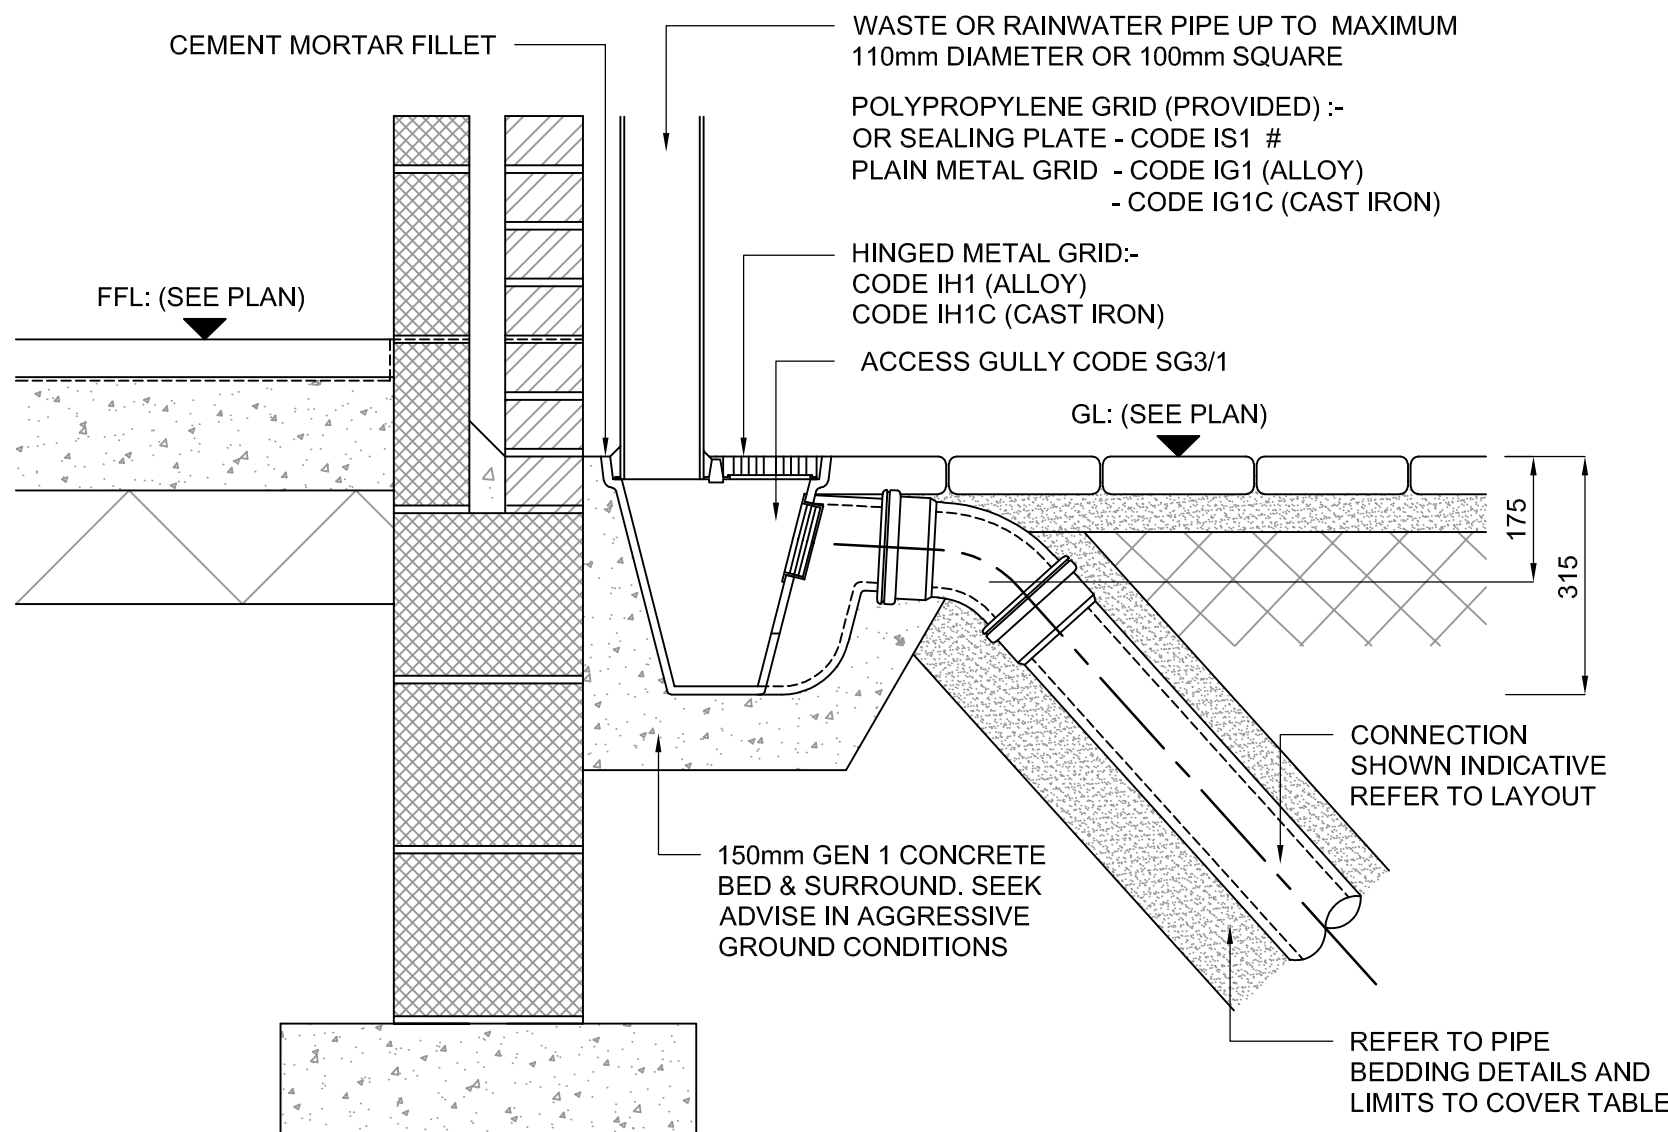


DETAIL AG: ACCESS GULLY

SCALE 1:10

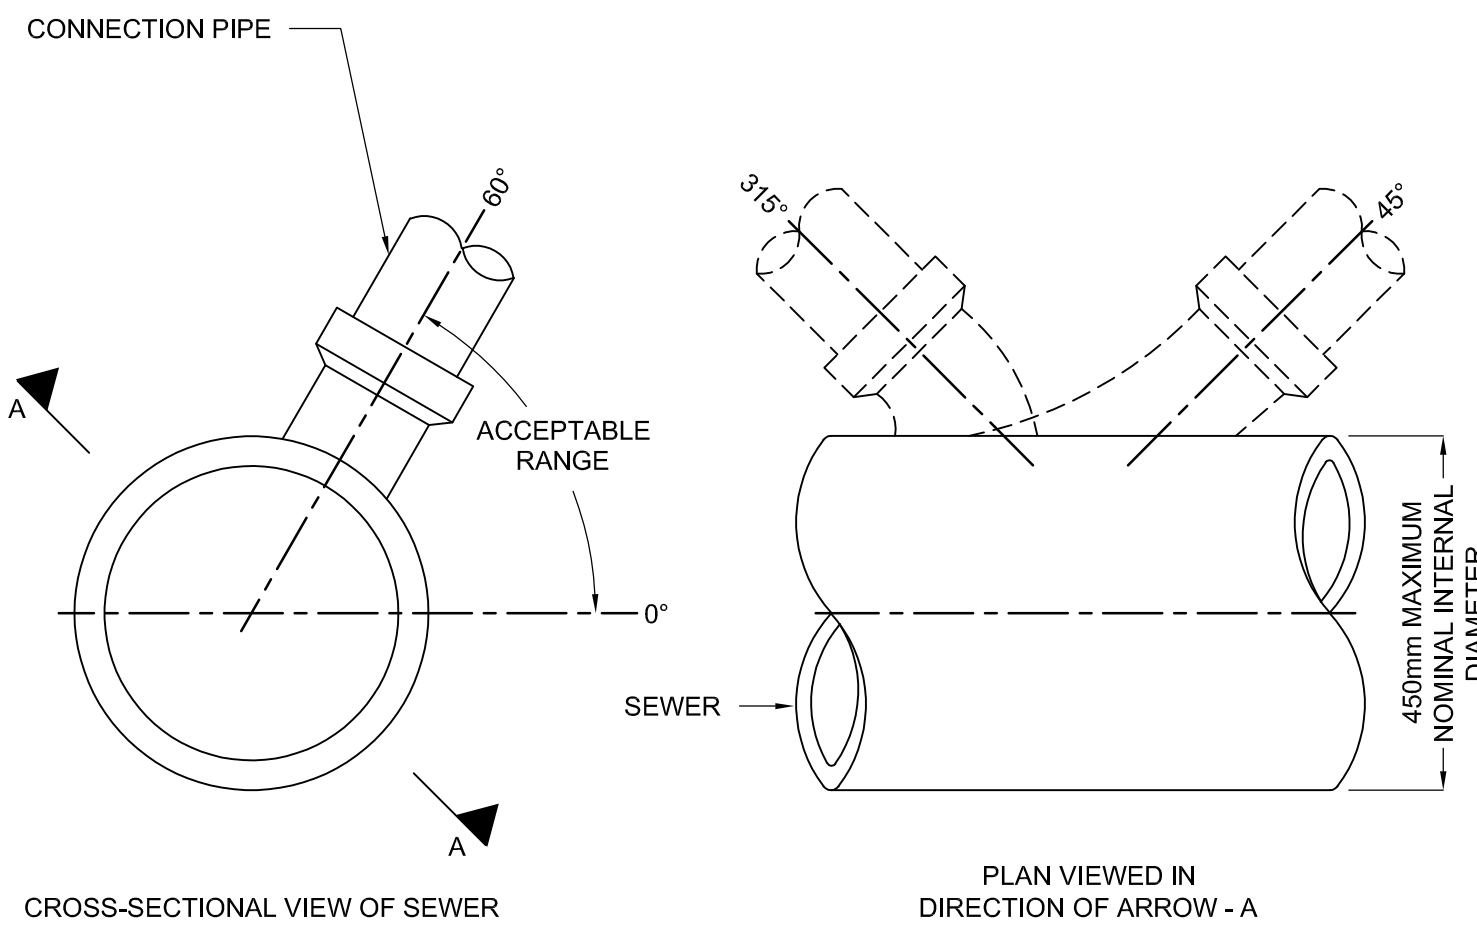

CONNECTIONS TO SEWER

SCALE 1:20

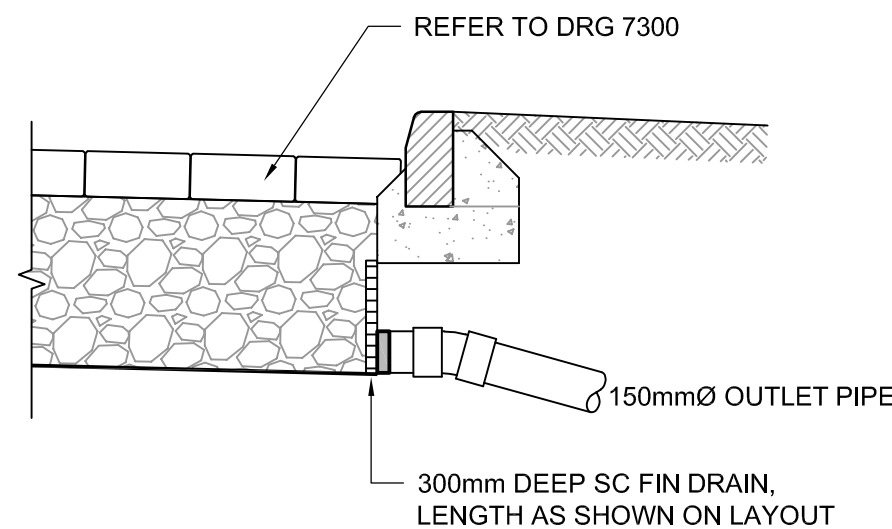

TYPICAL FIN DRAIN OUTLET DETAIL

SCALE 1:20

KEY PLAN

NOTES

- All dimensions are to be checked on site before the commencement of works. Any discrepancies are to be reported to the Architect & Engineer for verification. Figured dimensions only are to be taken from this drawing.
- The DWG file is issued for the purposes of coordination only and do not represent formal drawing issue and are not to be reprinted in any form. Formal issue of drawings is via DWF, Adobe PDF files and/or hard copies and their associated information issue sheets.
- Note that all care has been taken with the export of DWG files and their content, but we recommend that you make due dimensional checks before using any DWG file information. Any errors found are to be reported to Hydrock immediately.

C04	AS BUILT ISSUE					
	O.DAVIS	22.07.21	D.GALLIMORE	22.07.21	D.GALLIMORE	22.07.21
C03	HEALTH AND SAFETY FILE ISSUE					
	J.SHIMMIN	11.06.21	D.GALLIMORE	11.06.21	M. GRIFFIN	11.06.21
C02	AS BUILT ISSUE					
	J.SHIMMIN	NYI	D.GALLIMORE	NYI	M. GRIFFIN	NYI
C01	ISSUED FOR CONSTRUCTION					
	D. GALLIMORE	24/07/20	D.GALLIMORE	24/07/20	M. GRIFFIN	24/07/20
P05	ISSUED FOR CONTRACT					
	D. GALLIMORE	04/05/20	D.GALLIMORE	04/05/20	M. GRIFFIN	04/05/20
P04	ISSUED FOR CONTRACT					
	R.HUNT	13/03/20	D.GALLIMORE	13/03/20	M. GRIFFIN	13/03/20
P03	REVISED FOLLOWING COMMENTS (AS CLOUDED)					
	D. GALLIMORE	15/11/19	M. GRIFFIN	15/11/19	M. GRIFFIN	15/11/19
P02	REVISED FOLLOWING COMMENTS (AS CLOUDED)					
	D. GALLIMORE	06/11/19	M. GRIFFIN	06/11/19	M. GRIFFIN	06/11/19
P01	TENDER ISSUE					
	R.HUNT	11/10/19	D.GALLIMORE	11/10/19	M.GRIFFIN	11/10/19
REV	REVISION NOTES/COMMENTS					
	DRAWN BY	DATE	CHECKED BY	DATE	APPROVED BY	DATE

Merchants' House North
Wapping Road
Bristol
BS1 4RW
t: +44 (0)117 945 9225
e: bristolcentral@hydrock.com

CLIENT		
LANDLINK ESTATES		
PROJECT		
SALTBOX BOGNOR REGIS		
TITLE		
DRAINAGE DETAILS SHEET 3		
HYDROCK PROJECT NO. C-13319-C		SCALE @ A1 AS SHOWN
STATUS DESCRIPTION AS BUILT ISSUE		STATUS A
DRAWING NO. (PROJECT CODE-ORIGINATOR-ZONE-LEVEL-TYPE-ROLE-NUMBER) SAL-HYD-00-ZZ-DR-C-7102		REVISION C04