

LEGEND - KERB TYPES

HB2

HALF BATTERED KERB (TYPE HB2: 125mm UPSTAND)

SP

SPLAY KERB (TYPE SP: 125mm UPSTAND)

BNF

BULLNOSED KERB (TYPE BN: LAID FLUSH)

BN 6mm

BULLNOSED KERB (TYPE BN: 6mm UPSTAND)

BN 25mm

BULLNOSED KERB (TYPE BN: 25mm UPSTAND)

CS2

CHANNEL SQUARE KERB (TYPE CS2: LAID FLUSH)

EF

FLAT TOP EDGING KERB (TYPE EF: LAID FLUSH)

TK

TRANSITION KERB (TYPE TK: UPSTAND KERB TO DROPPED KERB)

DK

DROPPER KERB (TYPE DK: UPSTAND KERB TO DROPPED KERB)

LEGEND - SURFACE TYPES

TARMAC:

TYPE A1: ASPHALT PAVING CONSTRUCTION -
• PEDESTRIAN LOADING ONLY

TYPE A4: ASPHALT PAVING CONSTRUCTION -
• FREQUENT HGV AND COMMERCIAL VEHICLES

GRASSCRETE:

TYPE G1: GRASSCRETE CONSTRUCTION -
• CARS, LIGHT VEHICLES AND OCCASIONAL HGV'S

REFER TO DRAWING SAL-HYD-PH1-ZZ-C-DR-7300 FOR DETAILS

LEGEND - LEVELS AND GRADIENTS

+ 00.000

PROPOSED SPOT LEVEL

+ (00.00)


EXISTING SPOT LEVEL

1:100

PROPOSED GRADIENT

(1:100)

EXISTING GRADIENT

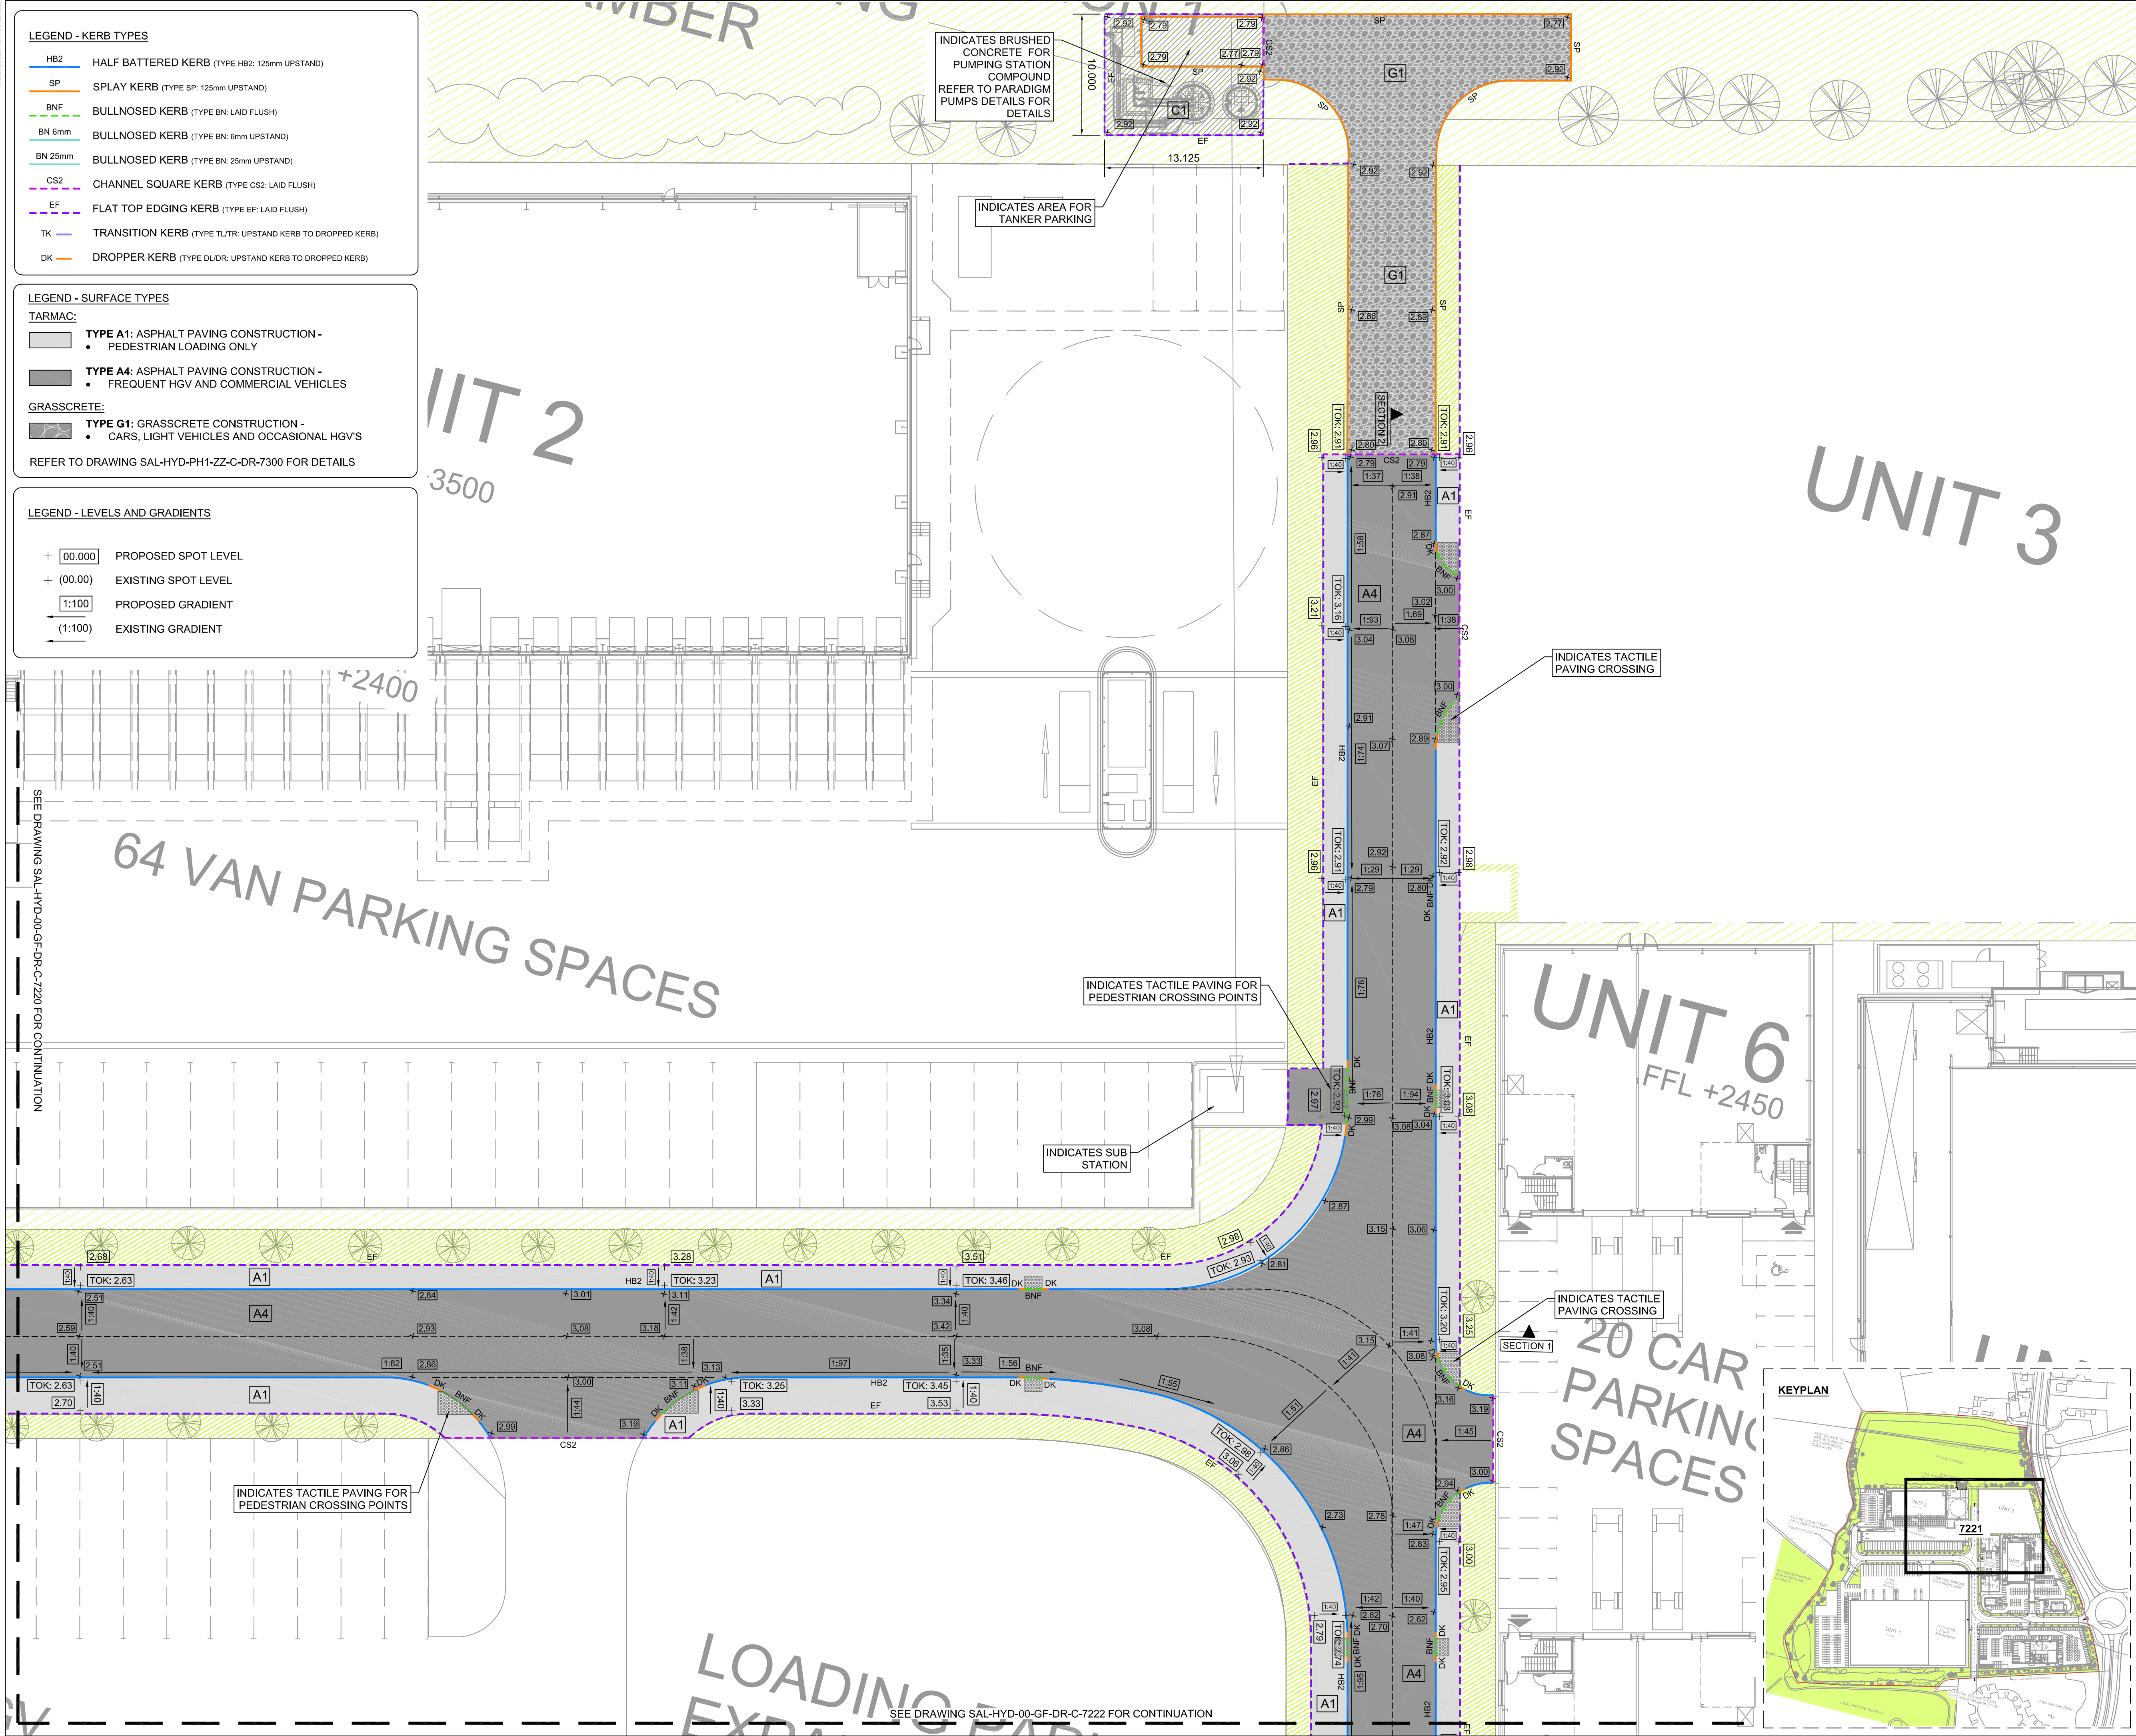

- NOTES
1.

All dimensions are to be checked on site before the commencement of works. Any discrepancies are to be reported to the Architect & Engineer for verification. Figured dimensions only are to be taken from this drawing.
2.

The DWG file is issued for the purposes of coordination only and do not represent formal drawing issue and are not to be reprinted in any form. Formal issue of drawings is via DWG, Adobe PDF files and/or hard copies and their associated information issue sheets.
3.

Note that all care has been taken with the export of DWG files and their content, but we recommend that you make due dimensional checks before using any DWG file information. Any errors found are to be reported to Hydrock immediately.
4.

All levels are shown in metres above Ordnance Datum (m AOD).
5.

In the event of any contradiction between this drawing and the specification, then the contractor shall seek clarification from the engineer before proceeding.
6.

Refer to landscape architects drawings for extent of external surfaces and kerbing.
7.

The works on site affect statutory undertakers apparatus, where the contractor is required to verify the location and depth of all such apparatus prior to commencement of work and to take any precautions necessary when working in the vicinity of apparatus.

AS BUILT ISSUE					
C08	O.DAVIS	22.07.21	D.GALLIMORE	22.07.21	D.GALLIMORE
CONSTRUCTION ISSUE					
C07	J.SHIMMIN	28/06/21	D.GALLIMORE	28/06/21	M. GRIFFIN
HEALTH AND SAFETY FILE ISSUE					
C06	J.SHIMMIN	11/06/21	D.GALLIMORE	11/06/21	M. GRIFFIN
PUMP STATION ARRANGEMENT REVISED FOLLOWING LATEST PARADIGM REQUIREMENTS					
C05	D. GALLIMORE	26/03/21	D.GALLIMORE	26/03/21	M. GRIFFIN
LEVELS AMENDED - PEDESTRIAN TACTILE PAVING POINTS ADDED (AS CLOUDED)					
C04	D. GALLIMORE	16/12/20	D.GALLIMORE	16/12/20	M. GRIFFIN
DROP KERB CROSSINGS AND TACTILE PAVING ADDED					
C03	D. GALLIMORE	13/10/20	D.GALLIMORE	13/10/20	M. GRIFFIN
LEVELS AMENDED AND CAMBER LEVELS ADDED					
C02	D. GALLIMORE	11/08/20	D.GALLIMORE	11/08/20	M. GRIFFIN
ISSUED FOR CONSTRUCTION					
C01	D. GALLIMORE	24/07/20	D.GALLIMORE	24/07/20	M. GRIFFIN
ISSUED FOR CONTRACT					
P03	R.HUNT	13/03/20	D.GALLIMORE	13/03/20	M. GRIFFIN
REVISED AS CLOUDED					
P02	D. GALLIMORE	13/12/19	M. GRIFFIN	13/12/19	M. GRIFFIN
REVISION NOTES/COMMENTS					
DRAWN BY	DATE	CHECKED BY	DATE	APPROVED BY	DATE

Hydrock

Merchants' House North
Wapping Road
Bristol
BS1 4RW
t: +44 (0)117 945 9225
e: bristolcentral@hydrock.com

CLIENT	LANDLINK ESTATES
PROJECT	SALTBOX BOGNOR REGIS
TITLE	ACCESS ROAD EXTERNAL WORKS SHEET 2
HYDROCK PROJECT NO.	C-13319-C
SCALE @ A1	1:250
STATUS DESCRIPTION	AS BUILT ISSUE
DRAWING NO. (PROJECT CODE-ORIGINATOR-ZONE-LEVEL-TYPE-ROLE-NUMBER)	SAL-HYD-PH1-ZZ-DR-C-7221
STATUS	A1
REVISION	C08