


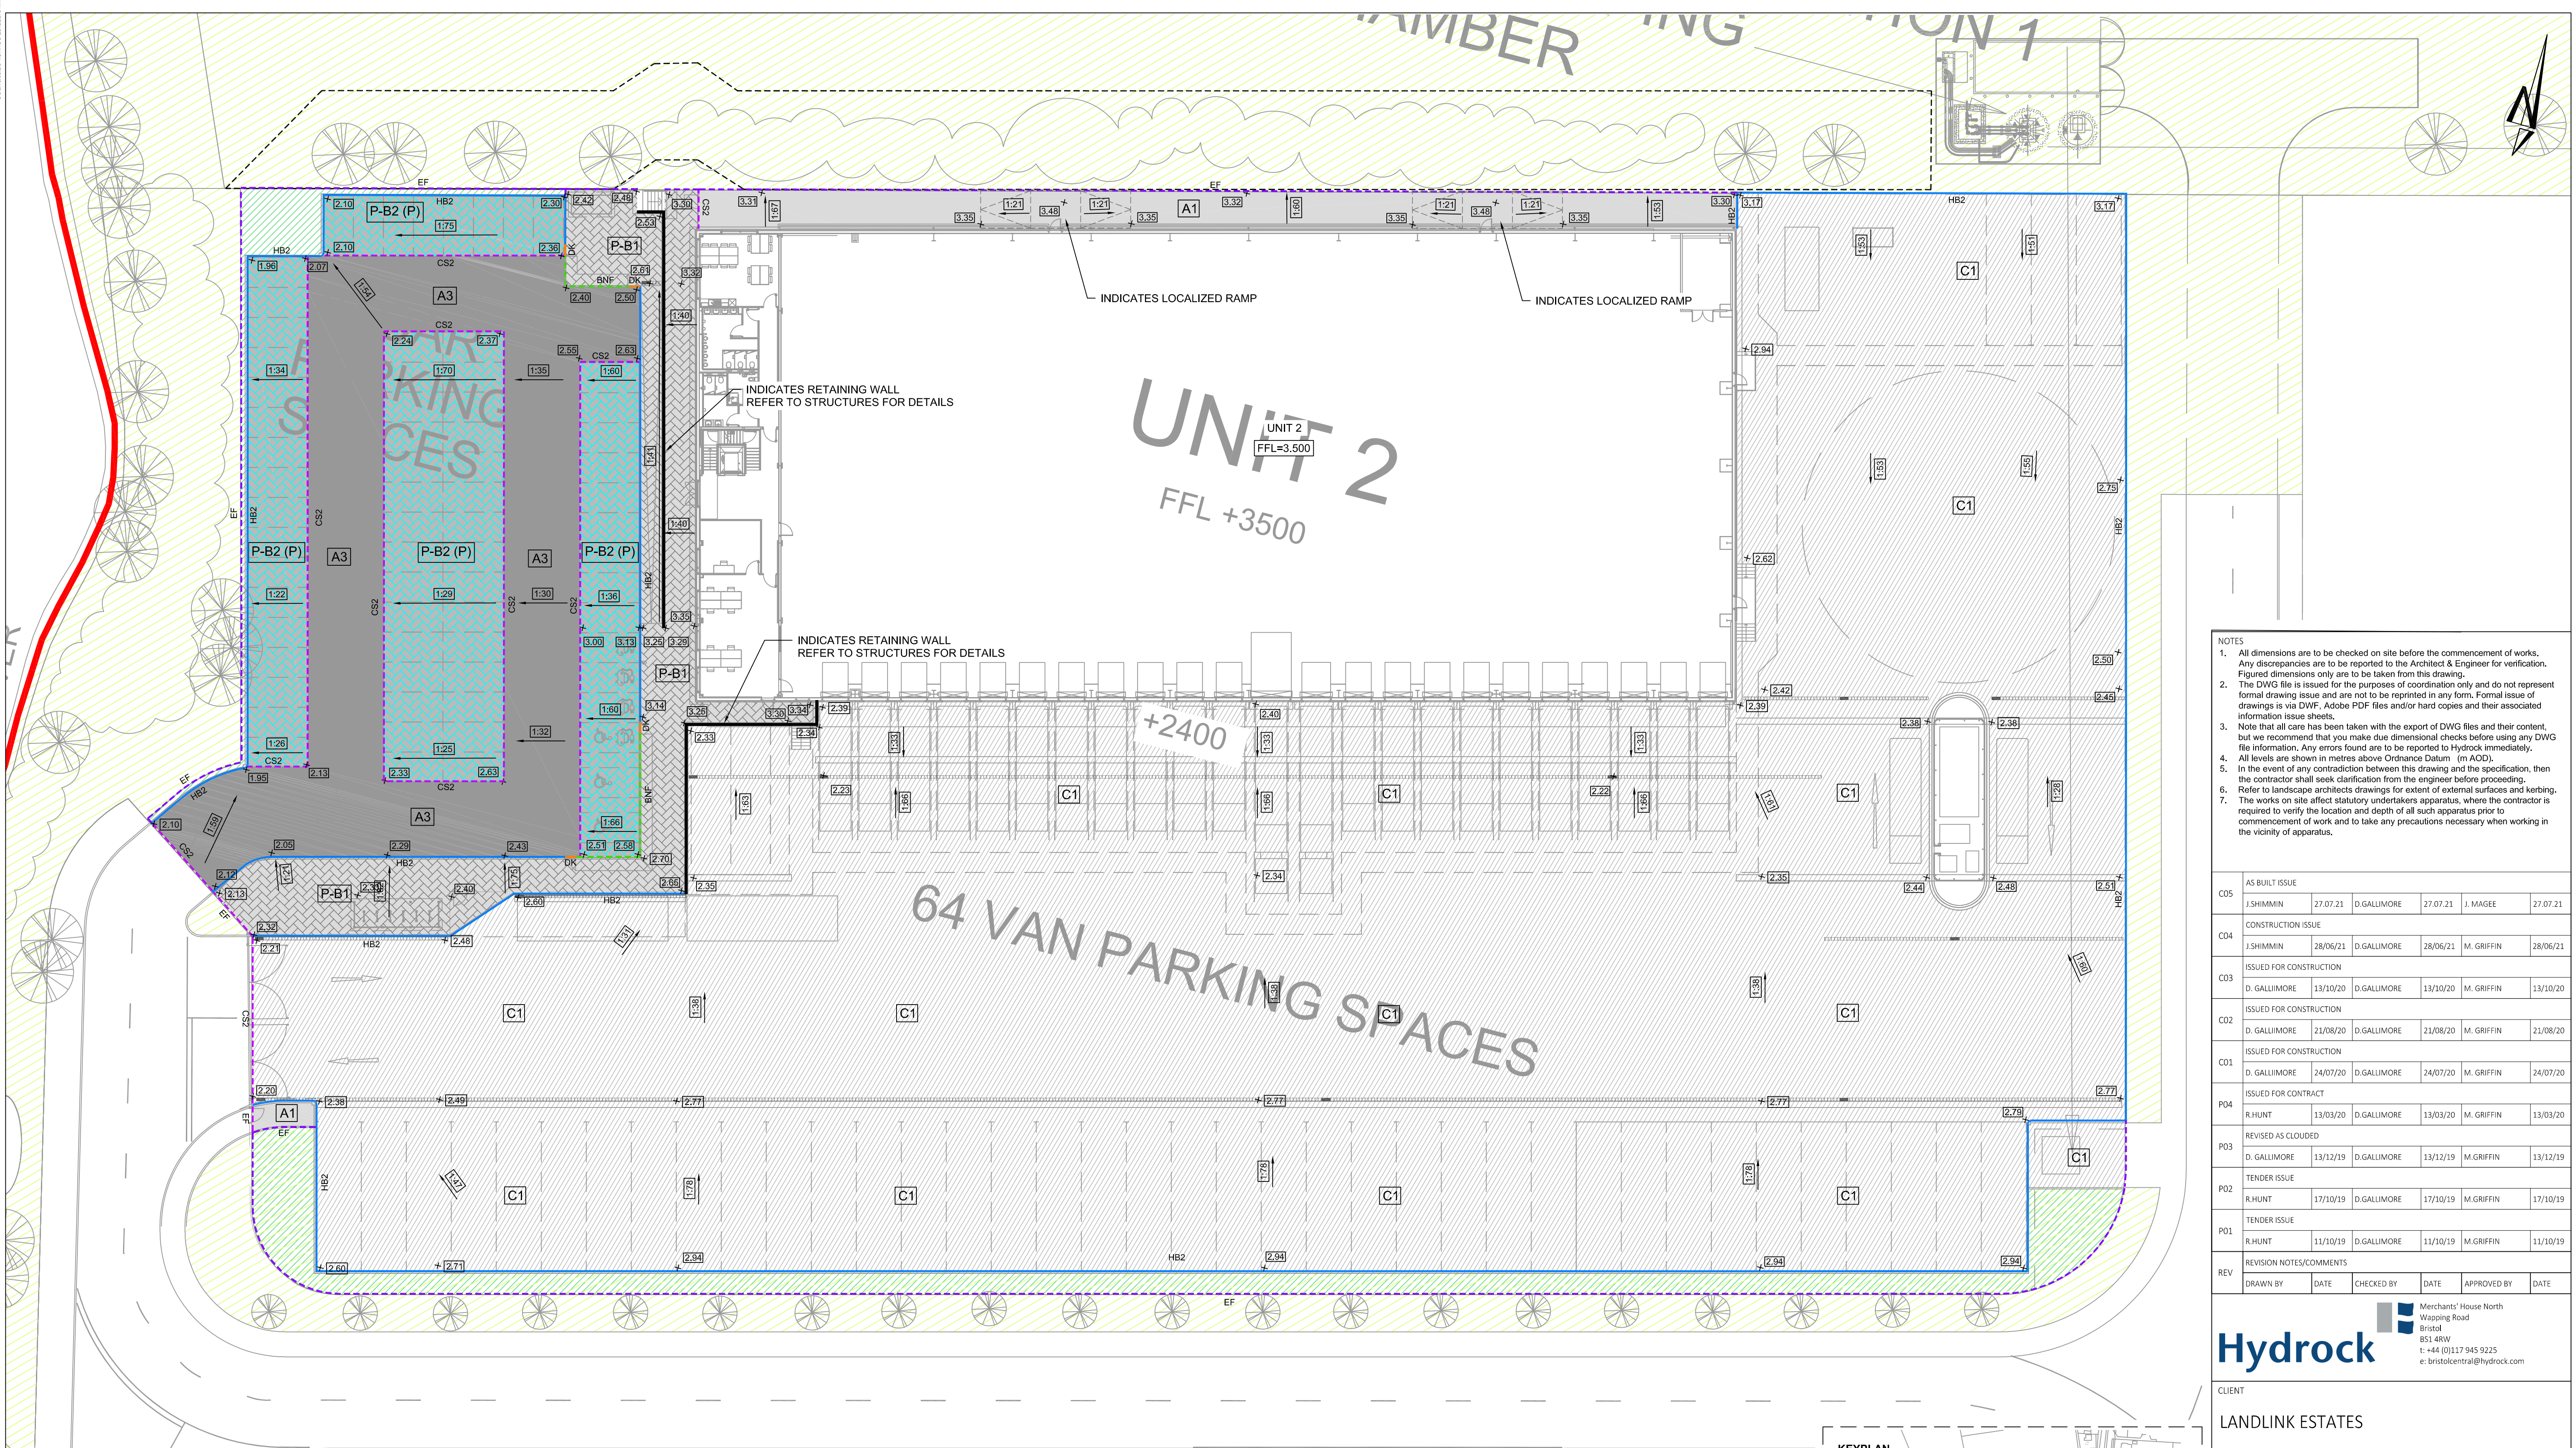

- NOTES
1. All dimensions are to be checked on site before the commencement of works. Any discrepancies are to be reported to the Architect & Engineer for verification. Figured dimensions only are to be taken from this drawing.
 2. The DWG file is issued for the purposes of coordination only and do not represent formal drawing issue and are not to be reprinted in any form. Formal issue of drawings is via DWG, Adobe PDF files and/or hard copies and their associated information issue sheets.
 3. Note that all care has been taken with the export of DWG files and their content, but we recommend that you make due dimensional checks before using any DWG file information. Any errors found are to be reported to Hydrock immediately.
 4. All levels are shown in metres above Ordnance Datum (m AOD).
 5. In the event of any contradiction between this drawing and the specification, then the contractor shall seek clarification from the engineer before proceeding.
 6. Refer to landscape architects drawings for extent of external surfaces and kerbing.
 7. The works on site affect statutory undertakers apparatus, where the contractor is required to verify the location and depth of all such apparatus prior to commencement of work and to take any precautions necessary when working in the vicinity of apparatus.

AS BUILT ISSUE						
C05	J.SHIMMIN	27.07.21	D.GALLIMORE	27.07.21	J. MAGEE	27.07.21
CONSTRUCTION ISSUE						
C04	J.SHIMMIN	28/06/21	D.GALLIMORE	28/06/21	M. GRIFFIN	28/06/21
ISSUED FOR CONSTRUCTION						
C03	D. GALLIMORE	13/10/20	D.GALLIMORE	13/10/20	M. GRIFFIN	13/10/20
ISSUED FOR CONSTRUCTION						
C02	D. GALLIMORE	21/08/20	D.GALLIMORE	21/08/20	M. GRIFFIN	21/08/20
ISSUED FOR CONSTRUCTION						
C01	D. GALLIMORE	24/07/20	D.GALLIMORE	24/07/20	M. GRIFFIN	24/07/20
ISSUED FOR CONTRACT						
P04	R.HUNT	13/03/20	D.GALLIMORE	13/03/20	M. GRIFFIN	13/03/20
REVISED AS CLOUDED						
P03	D. GALLIMORE	13/12/19	D.GALLIMORE	13/12/19	M.GRIFFIN	13/12/19
TENDER ISSUE						
P02	R.HUNT	17/10/19	D.GALLIMORE	17/10/19	M.GRIFFIN	17/10/19
TENDER ISSUE						
P01	R.HUNT	11/10/19	D.GALLIMORE	11/10/19	M.GRIFFIN	11/10/19
REVISION NOTES/COMMENTS						
REV	DRAWN BY	DATE	CHECKED BY	DATE	APPROVED BY	DATE

Merchants' House North
Wapping Road
Bristol
BS1 4RW
t: +44 (0)117 945 9225
e: bristolcentral@hydrock.com

CLIENT		LANDLINK ESTATES	
PROJECT		SALTBOX BOGNOR REGIS	
TITLE		UNIT 2 EXTERNAL WORKS	
HYDROCK PROJECT NO.		SCALE @ A1	
C-13319-C		1:250	
STATUS DESCRIPTION		STATUS	
AS BUILT ISSUE		A	
DRAWING NO. (PROJECT CODE-ORIGINATOR-ZONE-LEVEL-TYPE-ROLE-NUMBER)		REVISION	
SAL-HYD-PH1-ZZ-DR-C-7210		C05	

- LEGEND - SURFACE TYPES
- TARMAC:
- TYPE A1: ASPHALT PAVING CONSTRUCTION - PEDESTRIAN LOADING ONLY
 - TYPE A3: ASPHALT PAVING CONSTRUCTION - CARS, LIGHT VEHICLES & OCCASIONAL HGVS
- CONCRETE:
- TYPE C1: CONCRETE
- POROUS BLOCK:
- TYPE P-B2 (P): POROUS BLOCK PAVING CONSTRUCTION - CARS, LIGHT VEHICLES, NO COMMERCIAL VEHICLES
- BLOCK:
- TYPE P-B1: BLOCK PAVING CONSTRUCTION - PEDESTRIAN LOADING ONLY

- LEGEND - KERB TYPES
- HB2 HALF BATTERED KERB (TYPE HB2: 125mm UPSTAND)
 - SP SPLAY KERB (TYPE SP: 125mm UPSTAND)
 - BNF BULLNOSED KERB (TYPE BN: LAID FLUSH)
 - BN 6mm BULLNOSED KERB (TYPE BN: 6mm UPSTAND)
 - BN 25mm BULLNOSED KERB (TYPE BN: 25mm UPSTAND)
 - CS2 CHANNEL SQUARE KERB (TYPE CS2: LAID FLUSH)
 - EF FLAT TOP EDGING KERB (TYPE EF: LAID FLUSH)
 - TK TRANSITION KERB (TYPE TK/TR: UPSTAND KERB TO DROPPED KERB)
 - DK DROPPER KERB (TYPE DK/DR: UPSTAND KERB TO DROPPED KERB)

- LEGEND - LEVELS AND GRADIENTS
- + 00.000 PROPOSED SPOT LEVEL
 - + (00.00) EXISTING SPOT LEVEL
 - 1:100 PROPOSED GRADIENT
 - (1:100) EXISTING GRADIENT

