


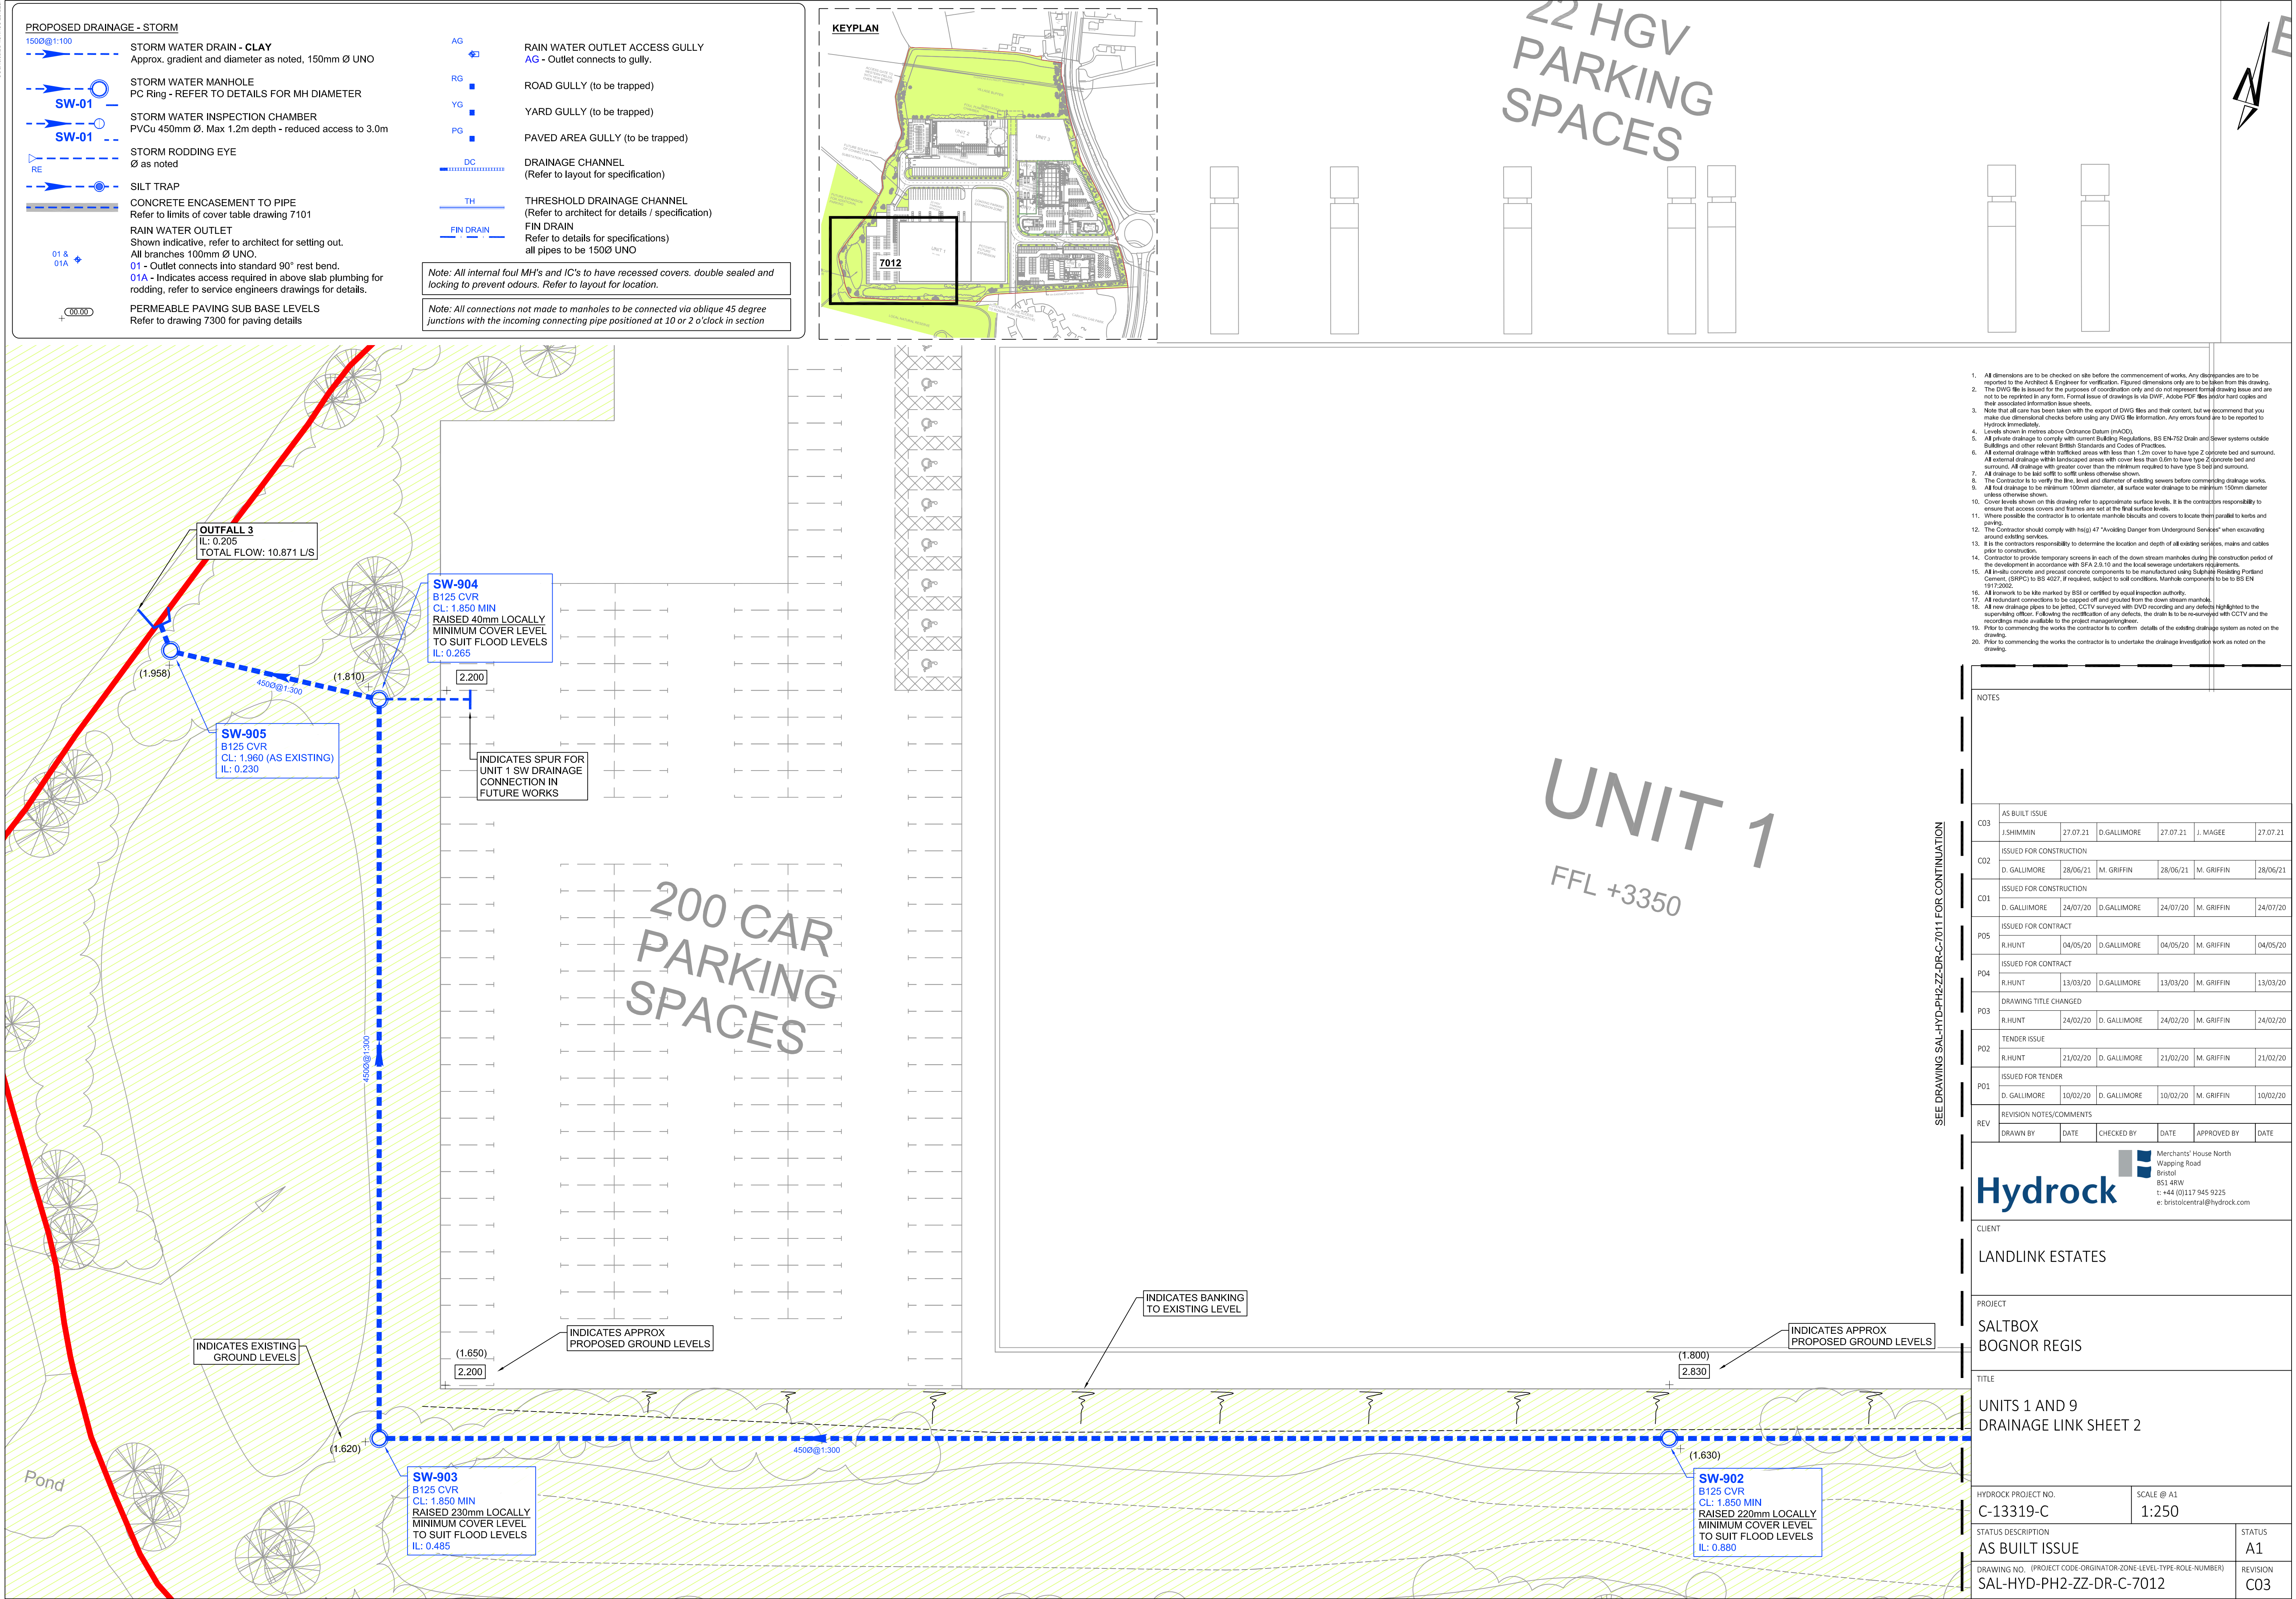

SEE DRAWING SAL-HYD-PH2-ZZ-DR-C-7011 FOR CONTINUATION

NOTES					
AS BUILT ISSUE					
CD3	J.SHIMMIN	27.07.21	D.GALLIMORE	27.07.21	J. MAGEE 27.07.21
ISSUED FOR CONSTRUCTION					
CD2	D. GALLIMORE	28/06/21	M. GRIFFIN	28/06/21	M. GRIFFIN 28/06/21
ISSUED FOR CONSTRUCTION					
CD1	D. GALLIMORE	24/07/20	D.GALLIMORE	24/07/20	M. GRIFFIN 24/07/20
ISSUED FOR CONTRACT					
PO5	R.HUNT	04/05/20	D.GALLIMORE	04/05/20	M. GRIFFIN 04/05/20
ISSUED FOR CONTRACT					
PO4	R.HUNT	13/03/20	D.GALLIMORE	13/03/20	M. GRIFFIN 13/03/20
DRAWING TITLE CHANGED					
PO3	R.HUNT	24/02/20	D. GALLIMORE	24/02/20	M. GRIFFIN 24/02/20
TENDER ISSUE					
PO2	R.HUNT	21/02/20	D. GALLIMORE	21/02/20	M. GRIFFIN 21/02/20
ISSUED FOR TENDER					
PO1	D. GALLIMORE	10/02/20	D. GALLIMORE	10/02/20	M. GRIFFIN 10/02/20
REVISION NOTES/COMMENTS					
REV	DRAWN BY	DATE	CHECKED BY	DATE	APPROVED BY DATE
Hydrock Merchants' House North Wapping Road Bristol BS1 4RW t: +44 (0)117 945 9225 e: bristolcentral@hydrock.com					
CLIENT					
LANDLINK ESTATES					
PROJECT					
SALTBOX BOGNOR REGIS					
TITLE					
UNITS 1 AND 9 DRAINAGE LINK SHEET 2					
HYDROCK PROJECT NO. C-13319-C				SCALE @ A1 1:250	
STATUS DESCRIPTION AS BUILT ISSUE					STATUS A1
DRAWING NO. (PROJECT CODE-ORIGINATOR-ZONE-LEVEL-TYPE-ROLE-NUMBER) SAL-HYD-PH2-ZZ-DR-C-7012					REVISION C03